




"AS BUILT"
STORM LINE A & B ONLY
4.21.11

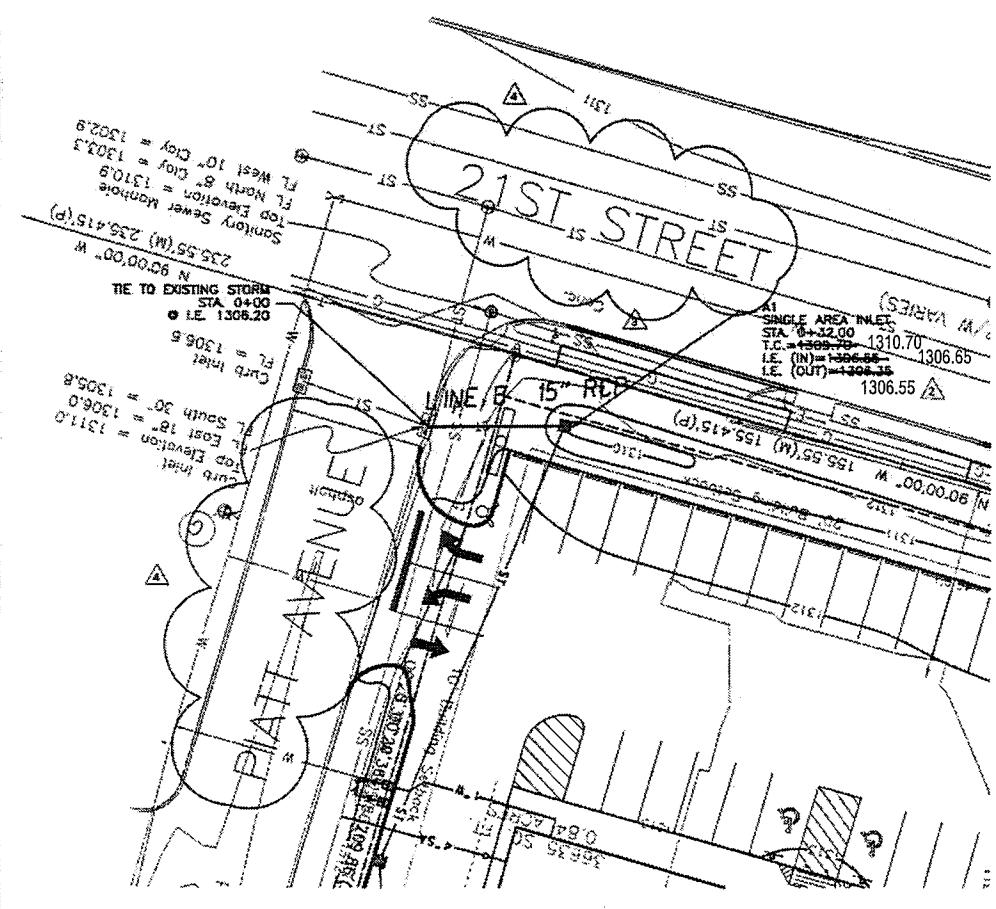

CITY COMMENTS	
12.09.10	
AS BUILT	4.21.11

APPROVED AS NOTED
BY CITY ENGINEER OF WICHITA

NOTE TO CONTRACTORS
Inspection and testing for this project is to be provided by a Licensed Consulting Engineering Firm under contract with the Owner/Developer. Said inspection is to be in accordance with the City of Wichita standard construction engineering practices and certified by a Licensed Professional Engineer. No work shall be performed in dedicated easements or public right-of-way by the Contractor without such inspection and shall not be commenced without written authorization by the City Engineer. All Construction and Materials shall comply with the City of Wichita Specifications and Standards (as the most available in the City Engineer's Office).

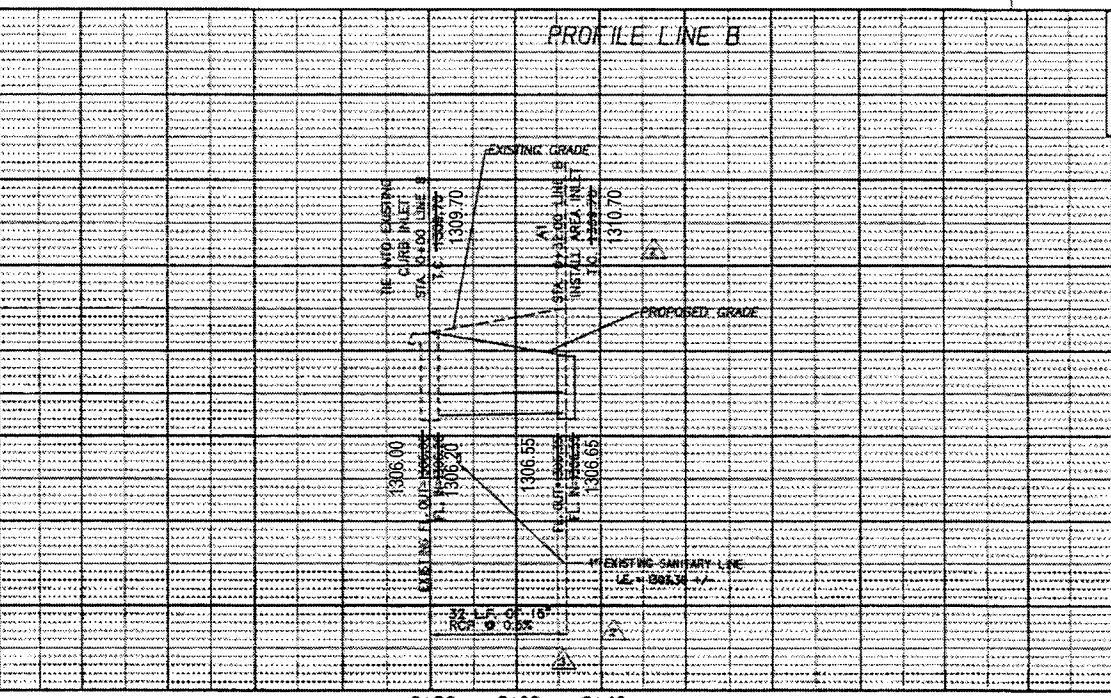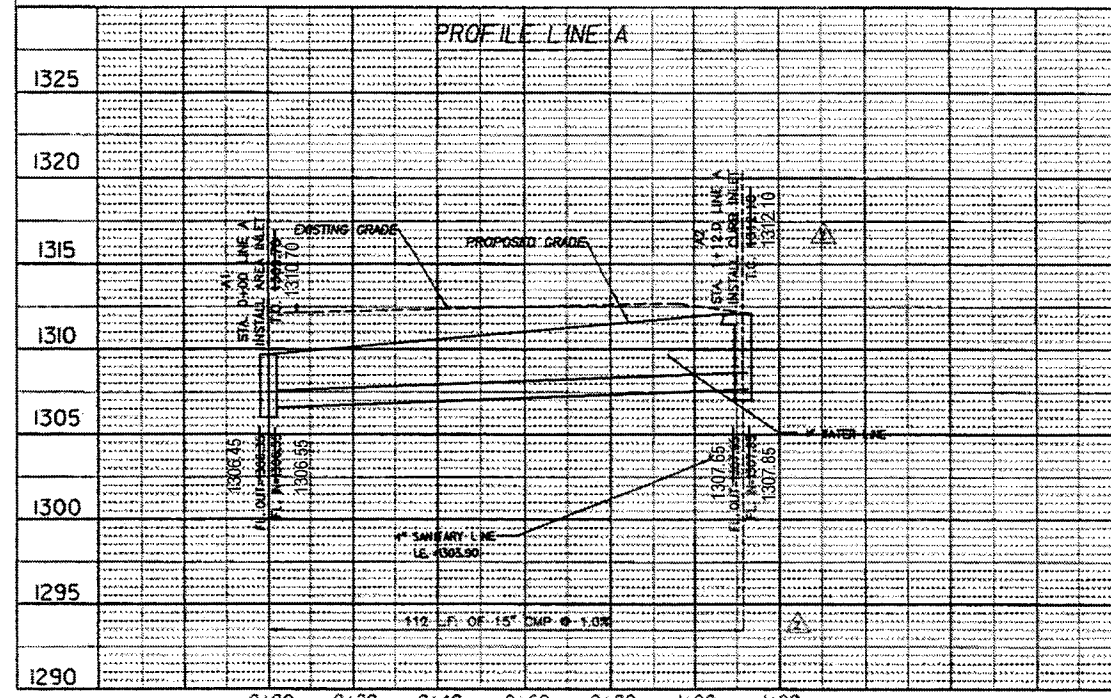

SCALE:
HORIZ. - 1"=20'
VERT. - 1"=5'



ARCHITECTURE
PLANNING
ENGINEERING
GRAPHICS

185 BROADWAY
4TH FLOOR
NASHVILLE, TN 37203
(615) 254-8176
(615) 254-3141
www.mjmerck.com



MICHAEL DUANE HUNKLER
REG.# 15263



CIVIL ENGINEER
GRESHAM SMITH AND PARTNERS
511 Union Street
1400 Nashville City Center
Nashville, Tennessee 37219
Phone: (615) 770-8100
CSP #127761.27



GET REALTY CORPORATION
200 Normal Drive Suite 116
Nashville, TN 37207
615-252-1879
Fax: 615-252-1816
www.dollargeneral.com

DOLLAR GENERAL

STORE #:
WICHITA,
KS
E. 21st St. N

07.26.10
MJM XXXXX

12.09.10	CITY COMMENTS
11.05.10	CITY COMMENTS
11.23.10	CITY COMMENTS

STORM LINE A & B
PLAN & PROFILE

C5.1

SHEET DATE LOCATION OWNER CONSULTANT SEAL