



Sanitary Sewer Improvements
In the alley between Market & Broadway,
from south of Central to 3rd Street

OCA 620577 / 468-84729

Dondlinger Construction - Contractor
J. Terhune - City of Wichita, Field Project Engineer
S. Cody - City of Wichita, Inspector
Stub
As-built
Release Date:
pdf: APRosas 8/10/2011

Project
Location
(YMCA)

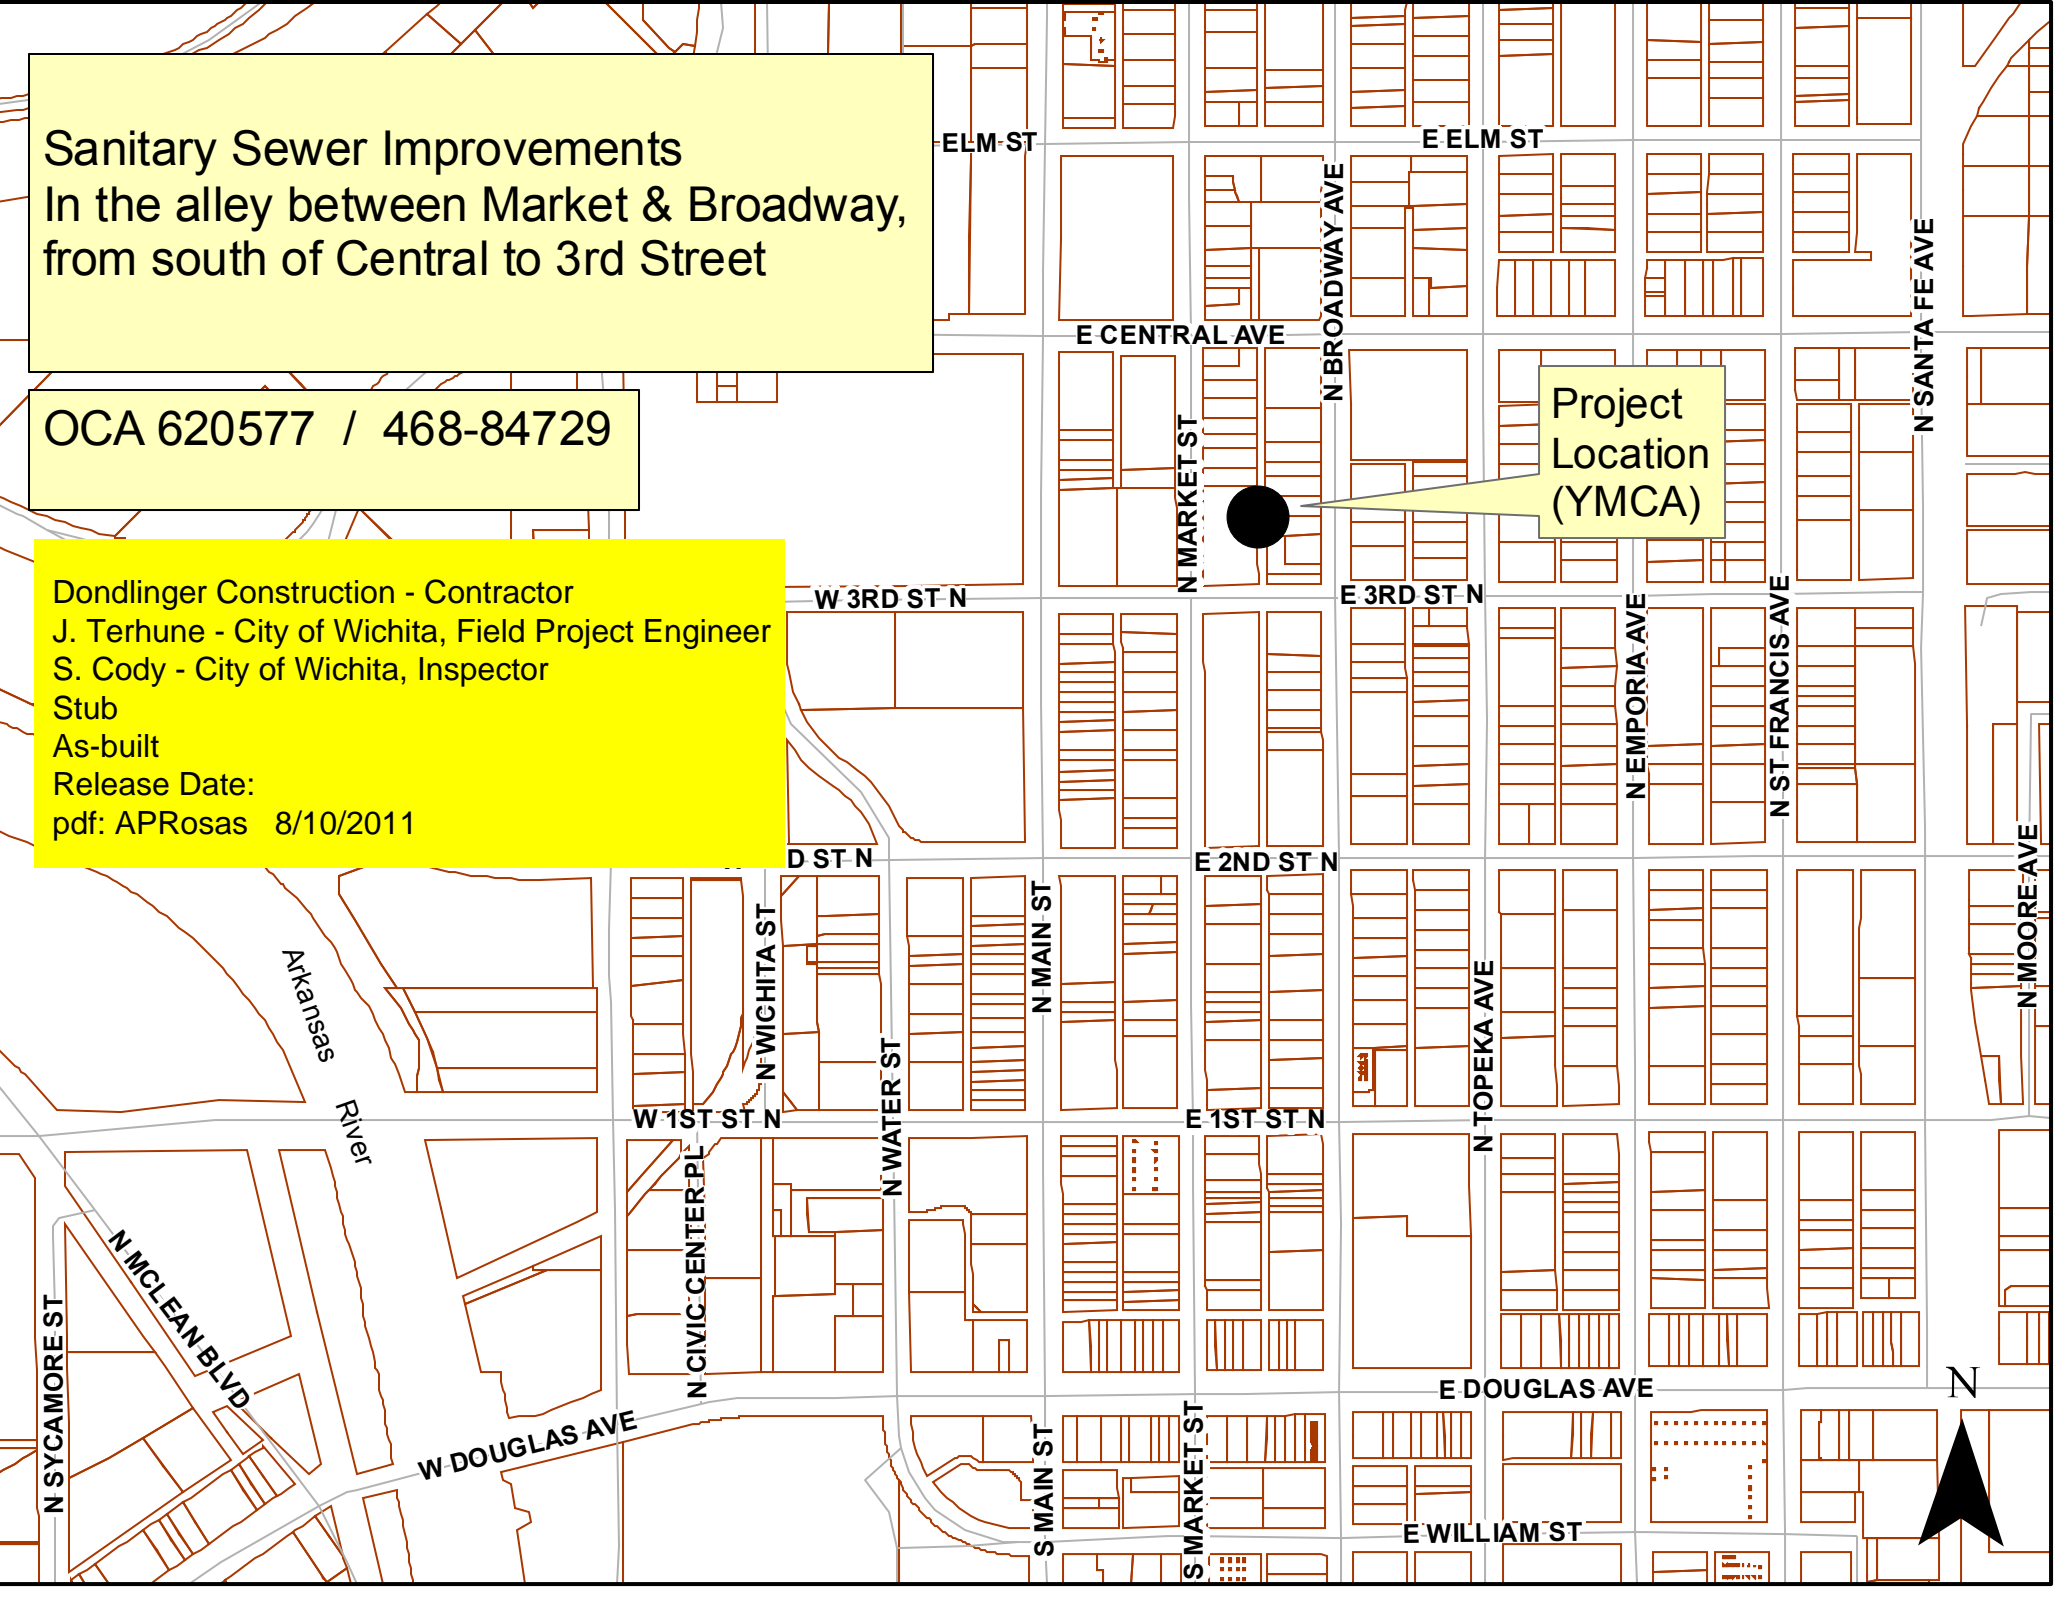

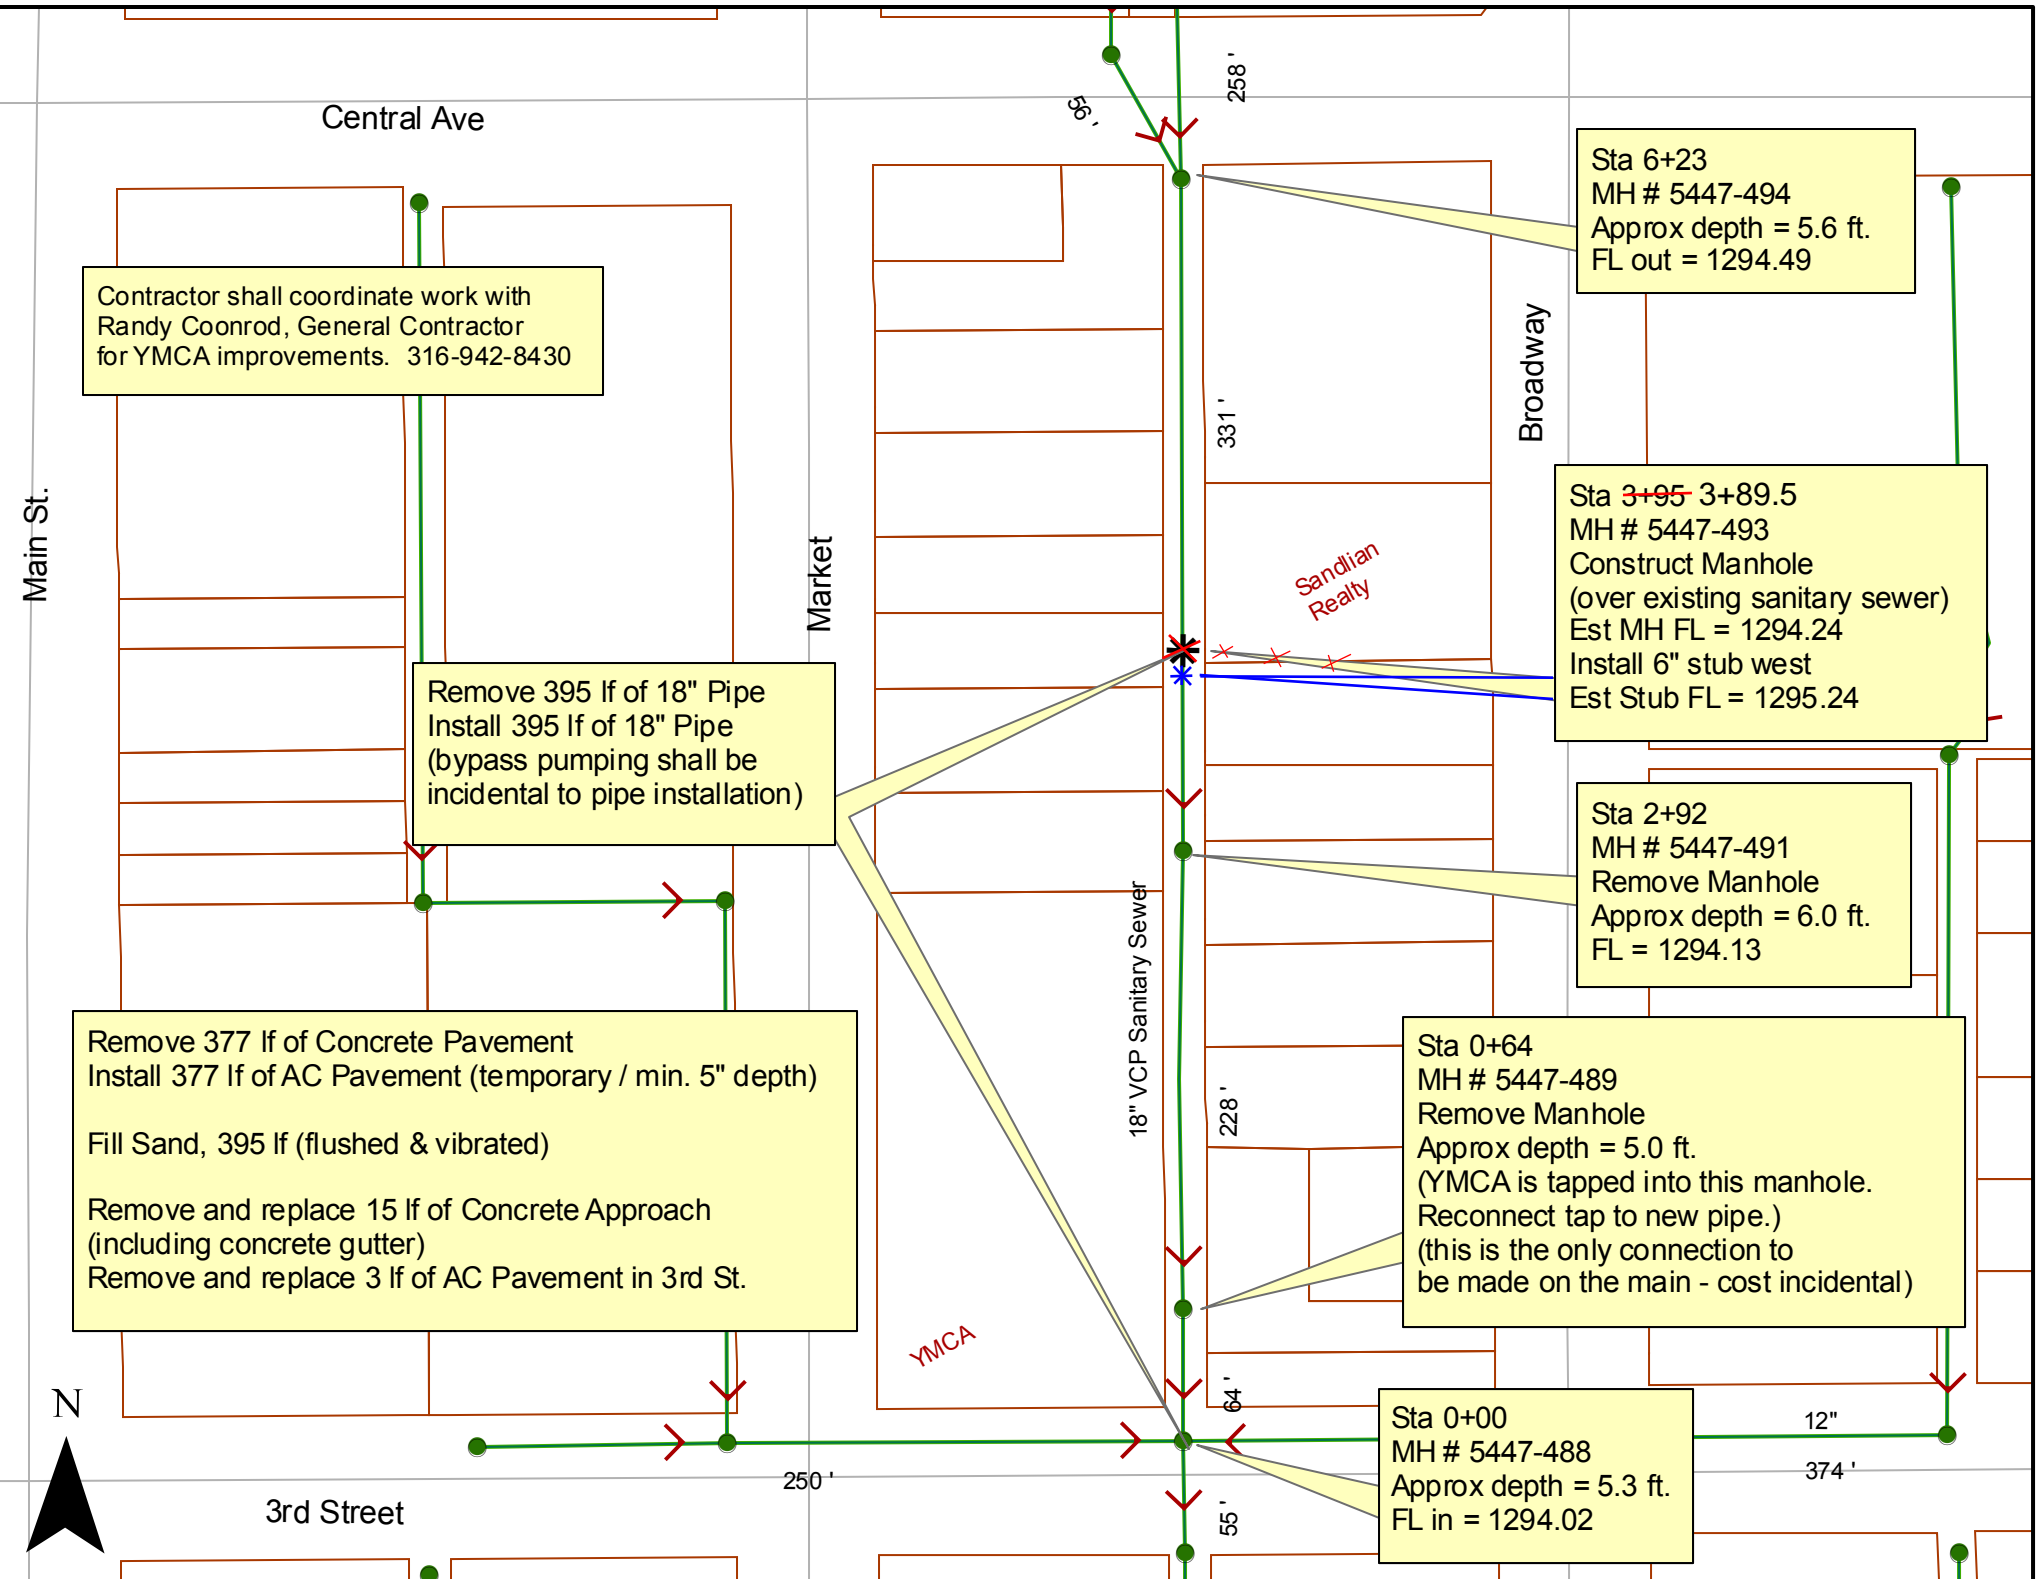

Contractor shall coordinate work with Randy Coonrod, General Contractor for YMCA improvements. 316-942-8430

Remove 395 lf of 18" Pipe
Install 395 lf of 18" Pipe
(bypass pumping shall be incidental to pipe installation)

Remove 377 lf of Concrete Pavement
Install 377 lf of AC Pavement (temporary / min. 5" depth)

Fill Sand, 395 lf (flushed & vibrated)

Remove and replace 15 lf of Concrete Approach (including concrete gutter)
Remove and replace 3 lf of AC Pavement in 3rd St.

Sta 6+23
MH # 5447-494
Approx depth = 5.6 ft.
FL out = 1294.49

Sta ~~3+95~~ 3+89.5
MH # 5447-493
Construct Manhole (over existing sanitary sewer)
Est MH FL = 1294.24
Install 6" stub west
Est Stub FL = 1295.24

Sta 2+92
MH # 5447-491
Remove Manhole
Approx depth = 6.0 ft.
FL = 1294.13

Sta 0+64
MH # 5447-489
Remove Manhole
Approx depth = 5.0 ft.
(YMCA is tapped into this manhole. Reconnect tap to new pipe.)
(this is the only connection to be made on the main - cost incidental)

Sta 0+00
MH # 5447-488
Approx depth = 5.3 ft.
FL in = 1294.02

