

BENCHMARK'S


Cross on South West Corner of Lot 25 Block H, The Fairmont Addition.

Elev. = 204.61 (City Datum)


1" Cut on Curb at North East Entrance to Church of the Magdalen 2nd Addition.

Elev. = 190.48 (City Datum)



Contractor to verify depth & location of existing utilities prior to construction.

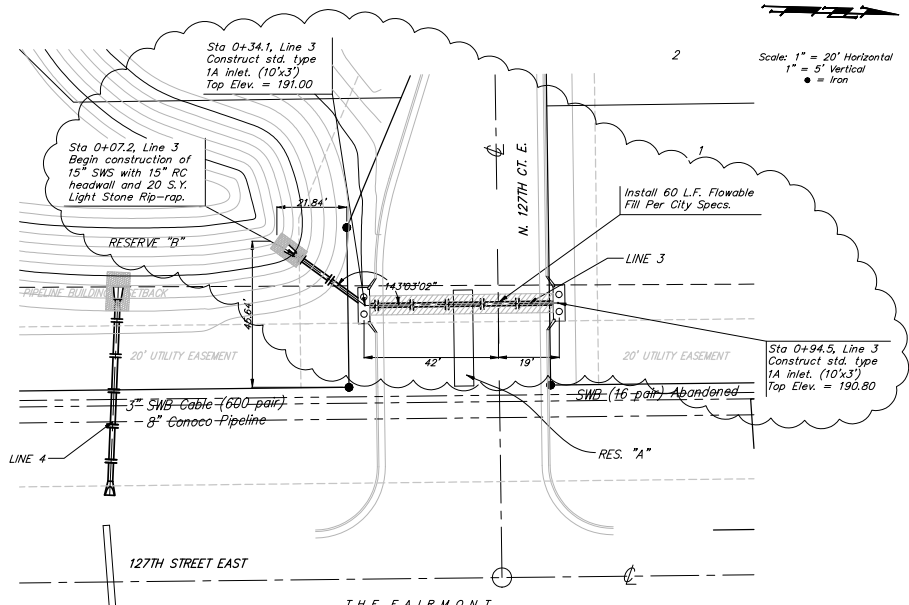

Scale: 1" = 20' Horizontal
1" = 5' Vertical
● = Iron

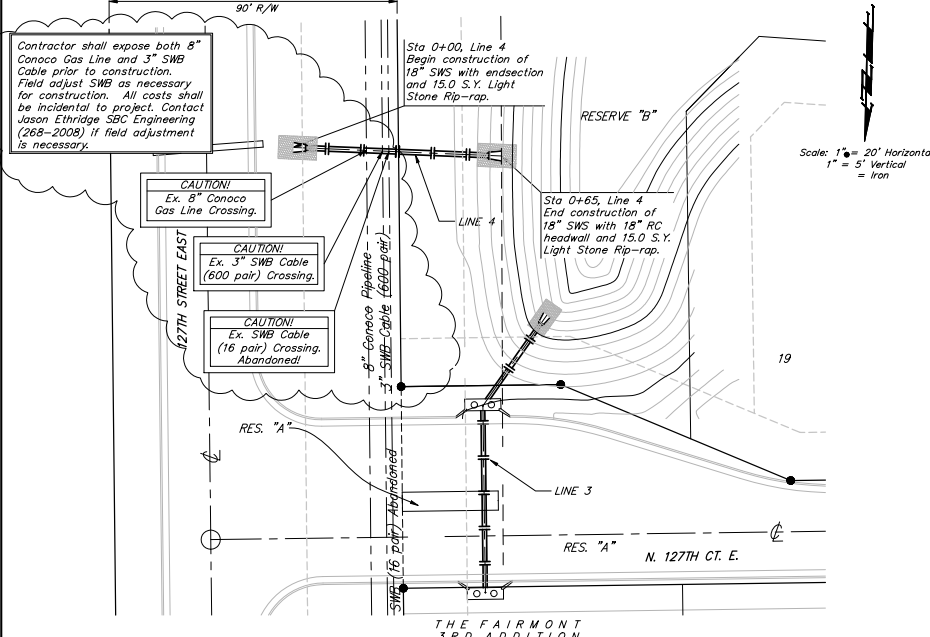

Scale: 1" = 20' Horizontal
1" = 5' Vertical
● = Iron

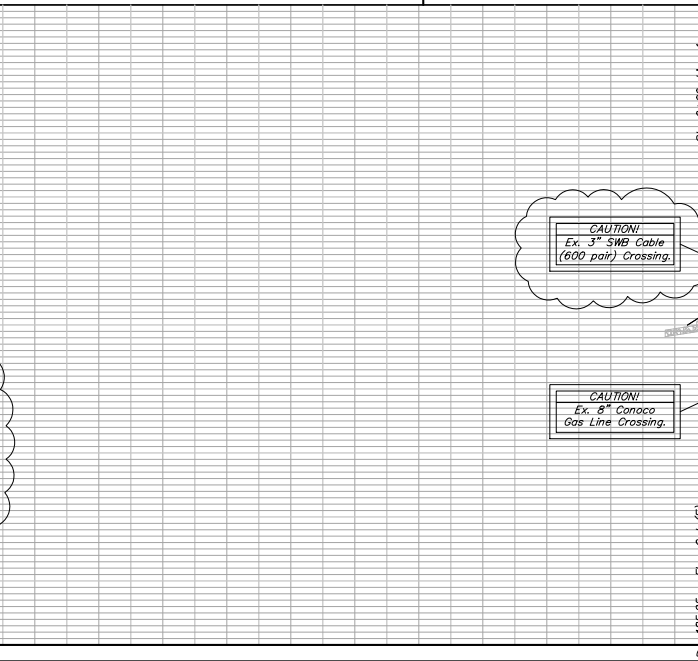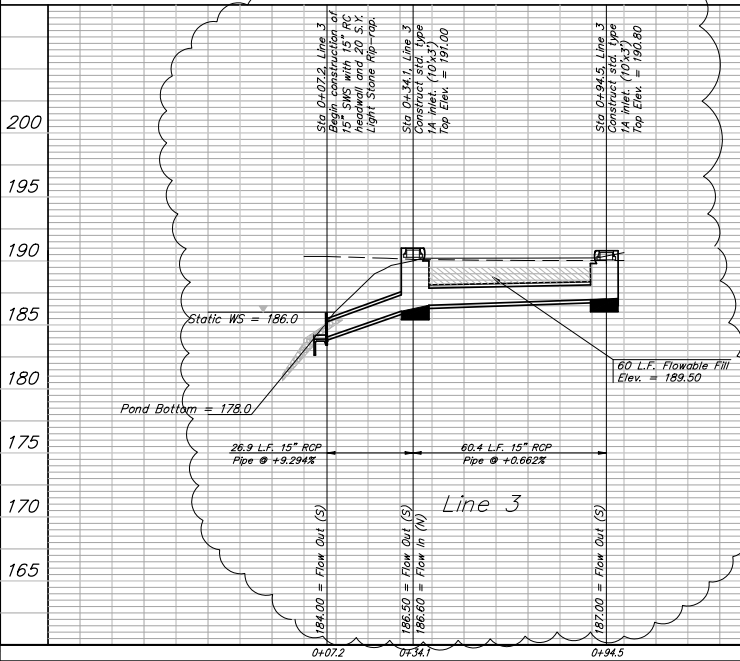

		The Fairmont 3rd LINE 3, 4 STORM WATER SEWER	
		<small>Baughman Company, P.A. SURVEYING, PLANNING & LANDSCAPE ARCHITECTURE</small>	
<small>PROJECT NUMBER</small> 46845936	<small>DESIGN</small> ATD	<small>DRAWN</small> DSM	<small>DATE</small> 01/05
<small>DATE</small> 02/07/05	<small>APPROVED</small> ATD	<small>SCALE</small> NOTED	<small>SHEET</small> 11 OF 20
<small>6/eng/line 3stormwater</small>		<small>04-11-1017</small>	