
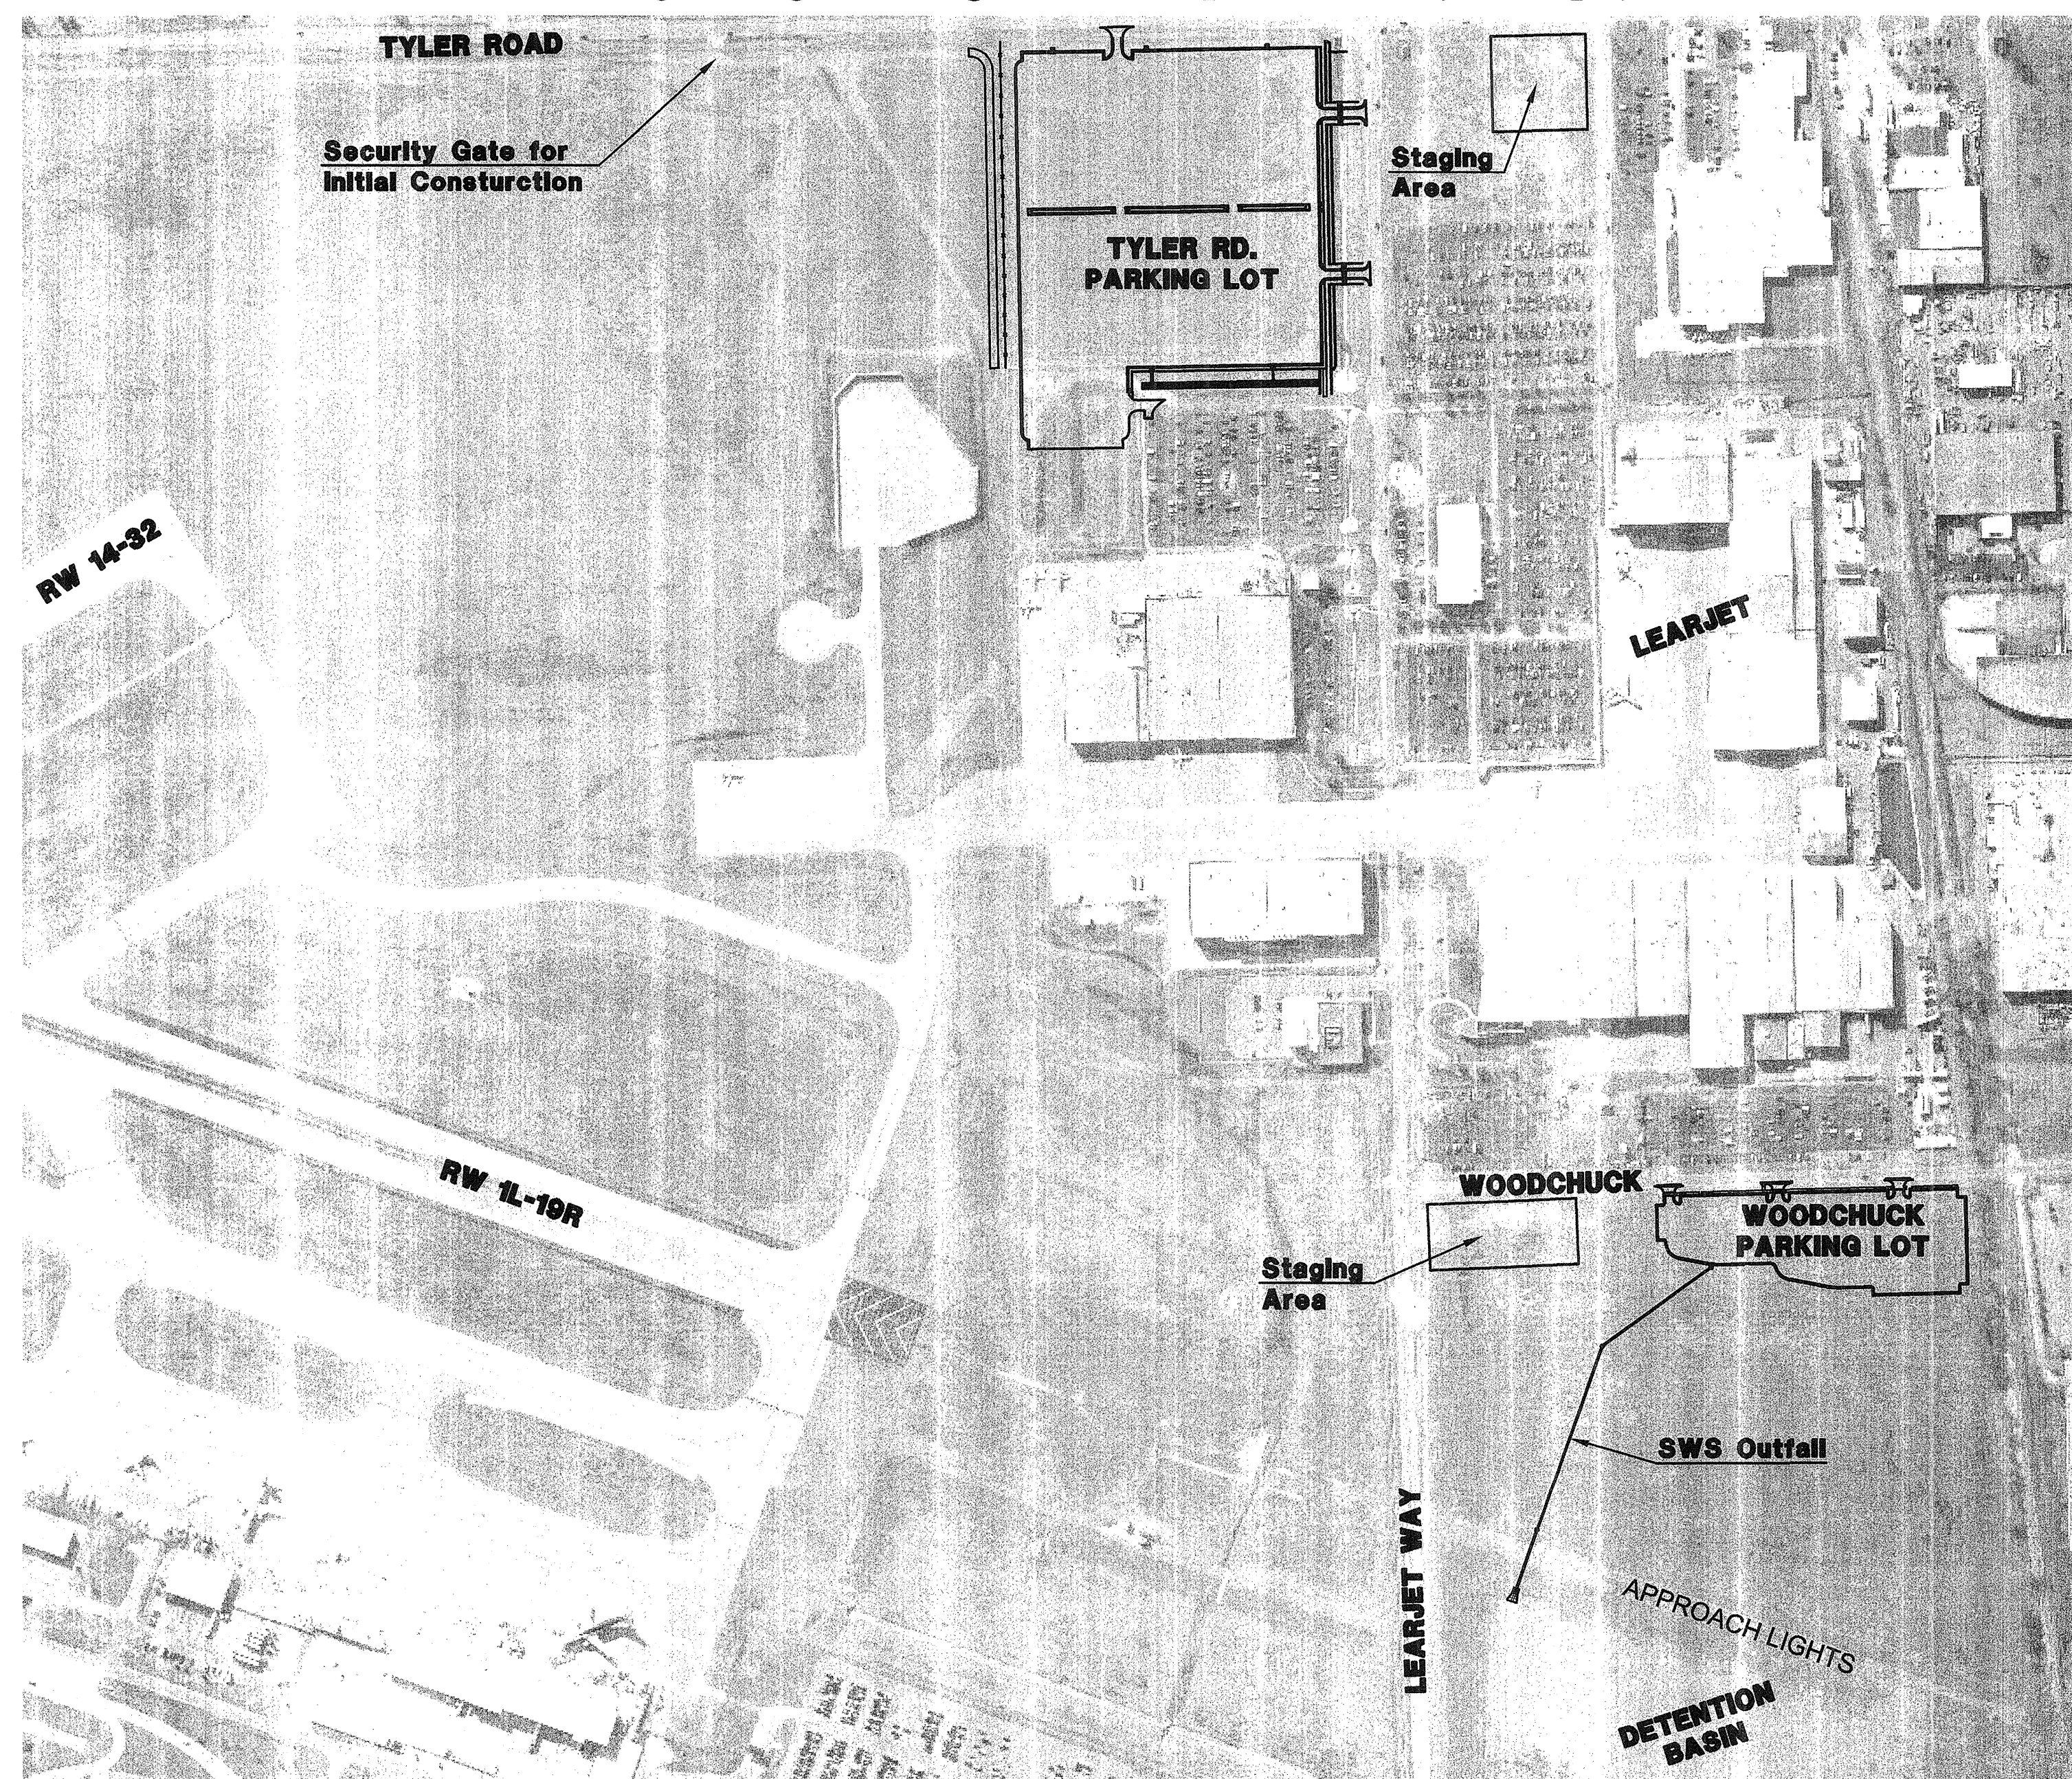


THE WICHITA AIRPORT AUTHORITY WICHITA, KANSAS

MID-CONTINENT AIRPORT

PLANS FOR LEARJET PARKING LOTS CITY OF WICHITA PROJECT NO. 451-422 EDA PROJECT NO. 05-01-05254 PRIVATE PROJECT NO. 0078PPD (607861)

AS BUILTS	
Cc: 7/26/2012 Nowak Construction Co., LLC.	Project Inspector: Larry Gann  <small>516 S. Market Wichita, KS 67202 (316)964-0242</small>



**GRADING
PAVING
PAVEMENT MARKING
LIGHTING**

*CITY OF WICHITA PPD PRIVATE PROJECT
APPROVED AS NOTED
BY CITY ENGINEER OF WICHITA*


Engineering Julianne Kallman 7-24-12
 Stormwater [Signature]

NOTE TO CONTRACTORS

Inspection and testing for this project are to be provided by a Licensed Consulting Engineering Firm under contract with the Contractor. Said inspection to be in accordance with the City of Wichita standard construction engineering practices and certified by a Licensed Professional Engineer. No work shall be performed in dedicated easements or public right-of-way by the Contractor without such inspection, nor shall any work be commenced without written authorization by the City Engineer.

JANUARY, 2012

Served 02-22-2012 3:19:12 PM by: CLM
 File: 20111118A\05A\05A.dwg (User: jgann) 11/30/11 11:39:12 AM - 0300 - 016

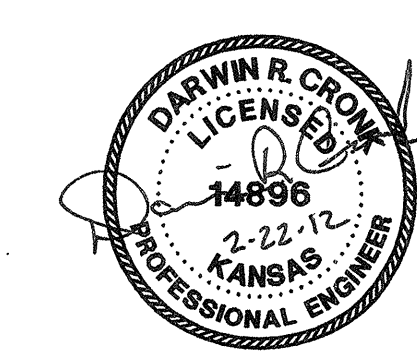

HOWARD HELMER

THE WICHITA AIRPORT AUTHORITY MID-CONTINENT AIRPORT TITLE SHEET LEARJET PARKING LOTS	 Professional Engineering Consultants, P.A. <small>303 S. TOPEKA • WICHITA, KANSAS 67202 316-262-2691 • FAX 316-262-3003</small>
Date JANUARY 2012	Job No. 11394-004