


PLAN	CHECKED	CHECKED
BY	DATE	

PROFILE	CHECKED	CHECKED
BY	DATE	

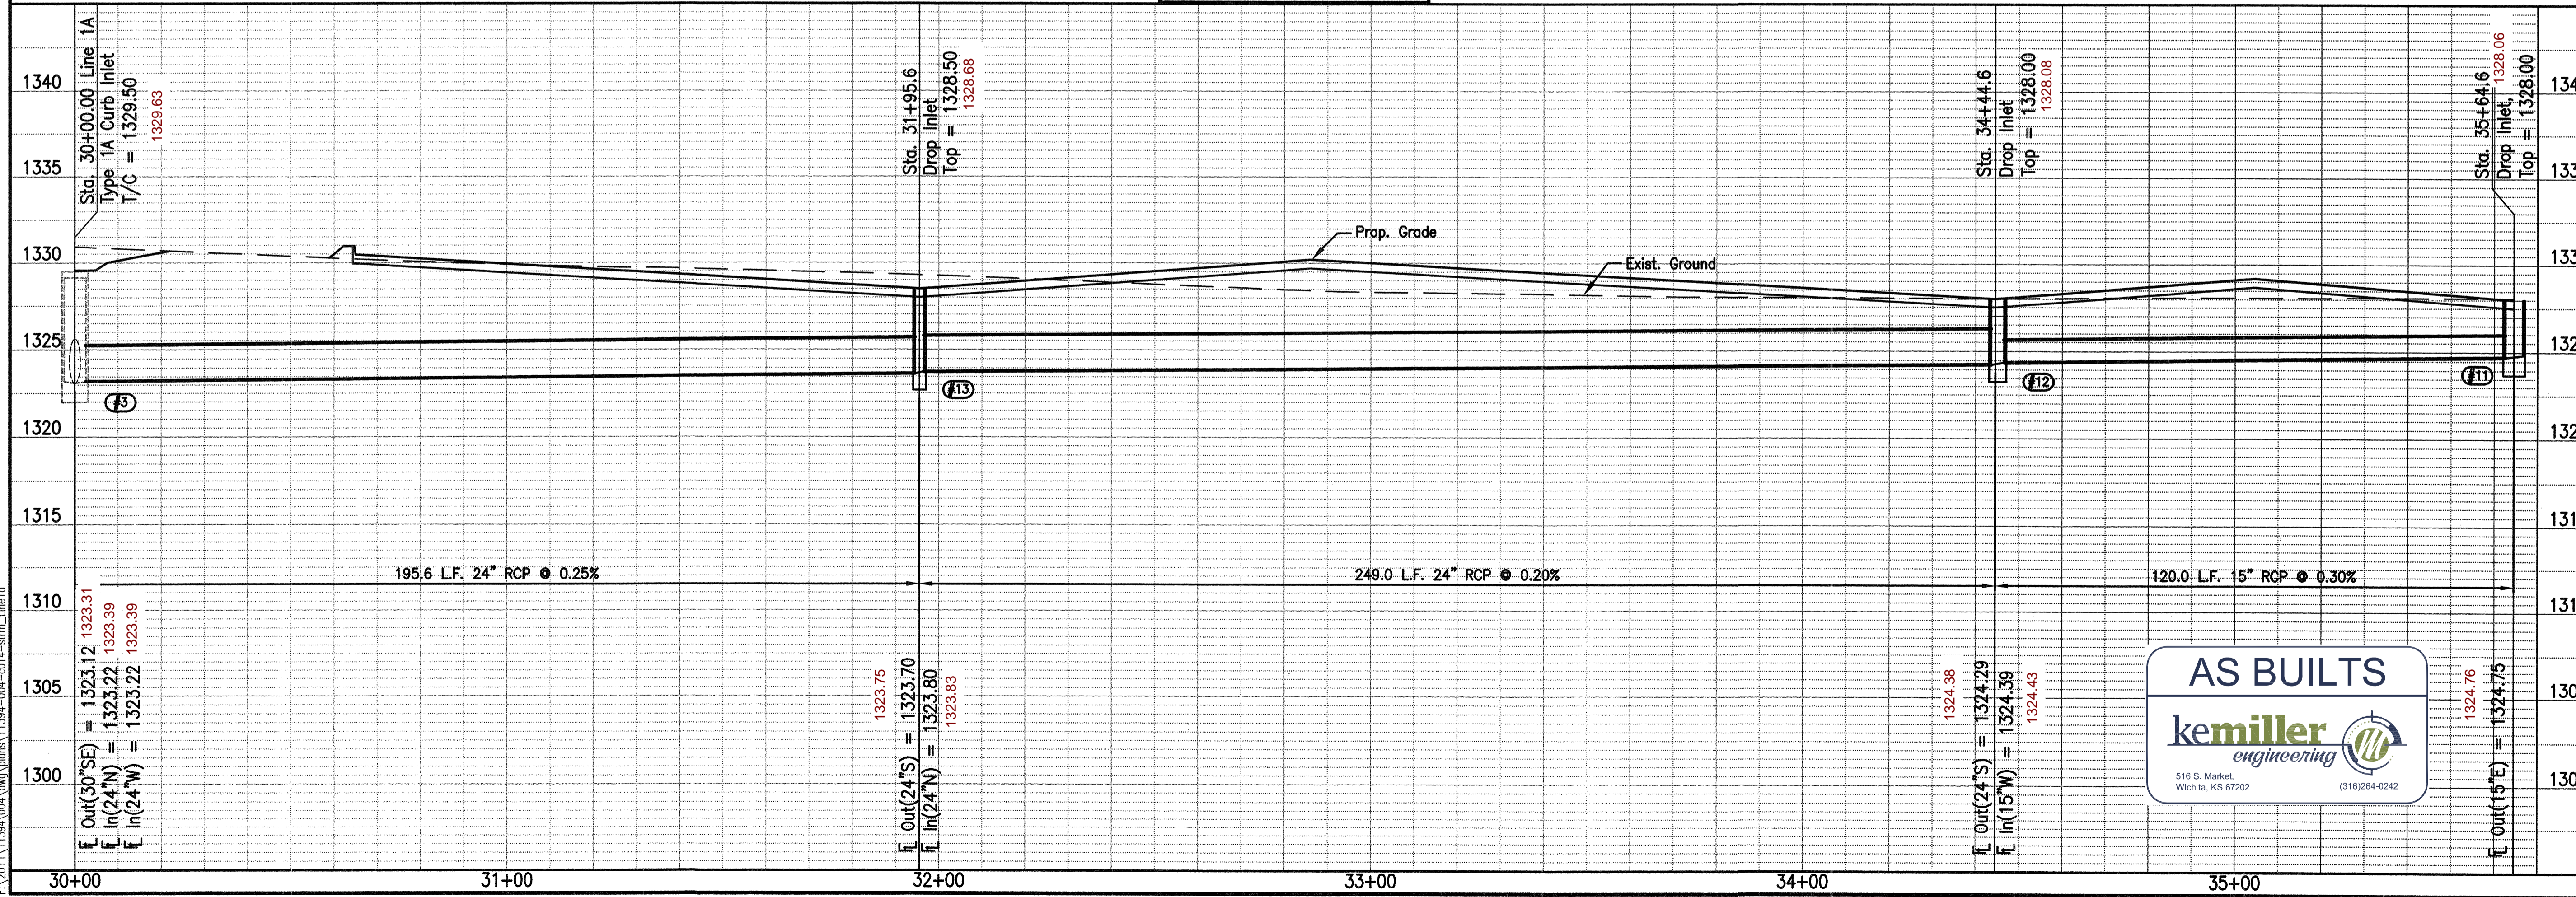

THE WICHITA AIRPORT AUTHORITY
MID-CONTINENT AIRPORT
STORM SEWER LINE 1A
LEASJET PARKING LOTS

Professional Engineering Consultants, P.A.
303 S. TOPEKA • WICHITA, KANSAS 67202
316-262-2691 • FAX 316-262-3003

AS BUILTS

516 S. Market,
Wichita, KS 67202
(316)264-0242

Designed By DAR
Drawn By DUL

Job No. 11394-004
Date Oct. 2011

Sheet of --

Saved 01-13-2012 11:46:55 AM by DMS
Plot Scale 1:0' 02'-22'-2012 11:11:44 AM by DJEF L. McDONALD
P:\2011\11394\004\Drawings\11394-004-C014-Stm_Line.rvt