
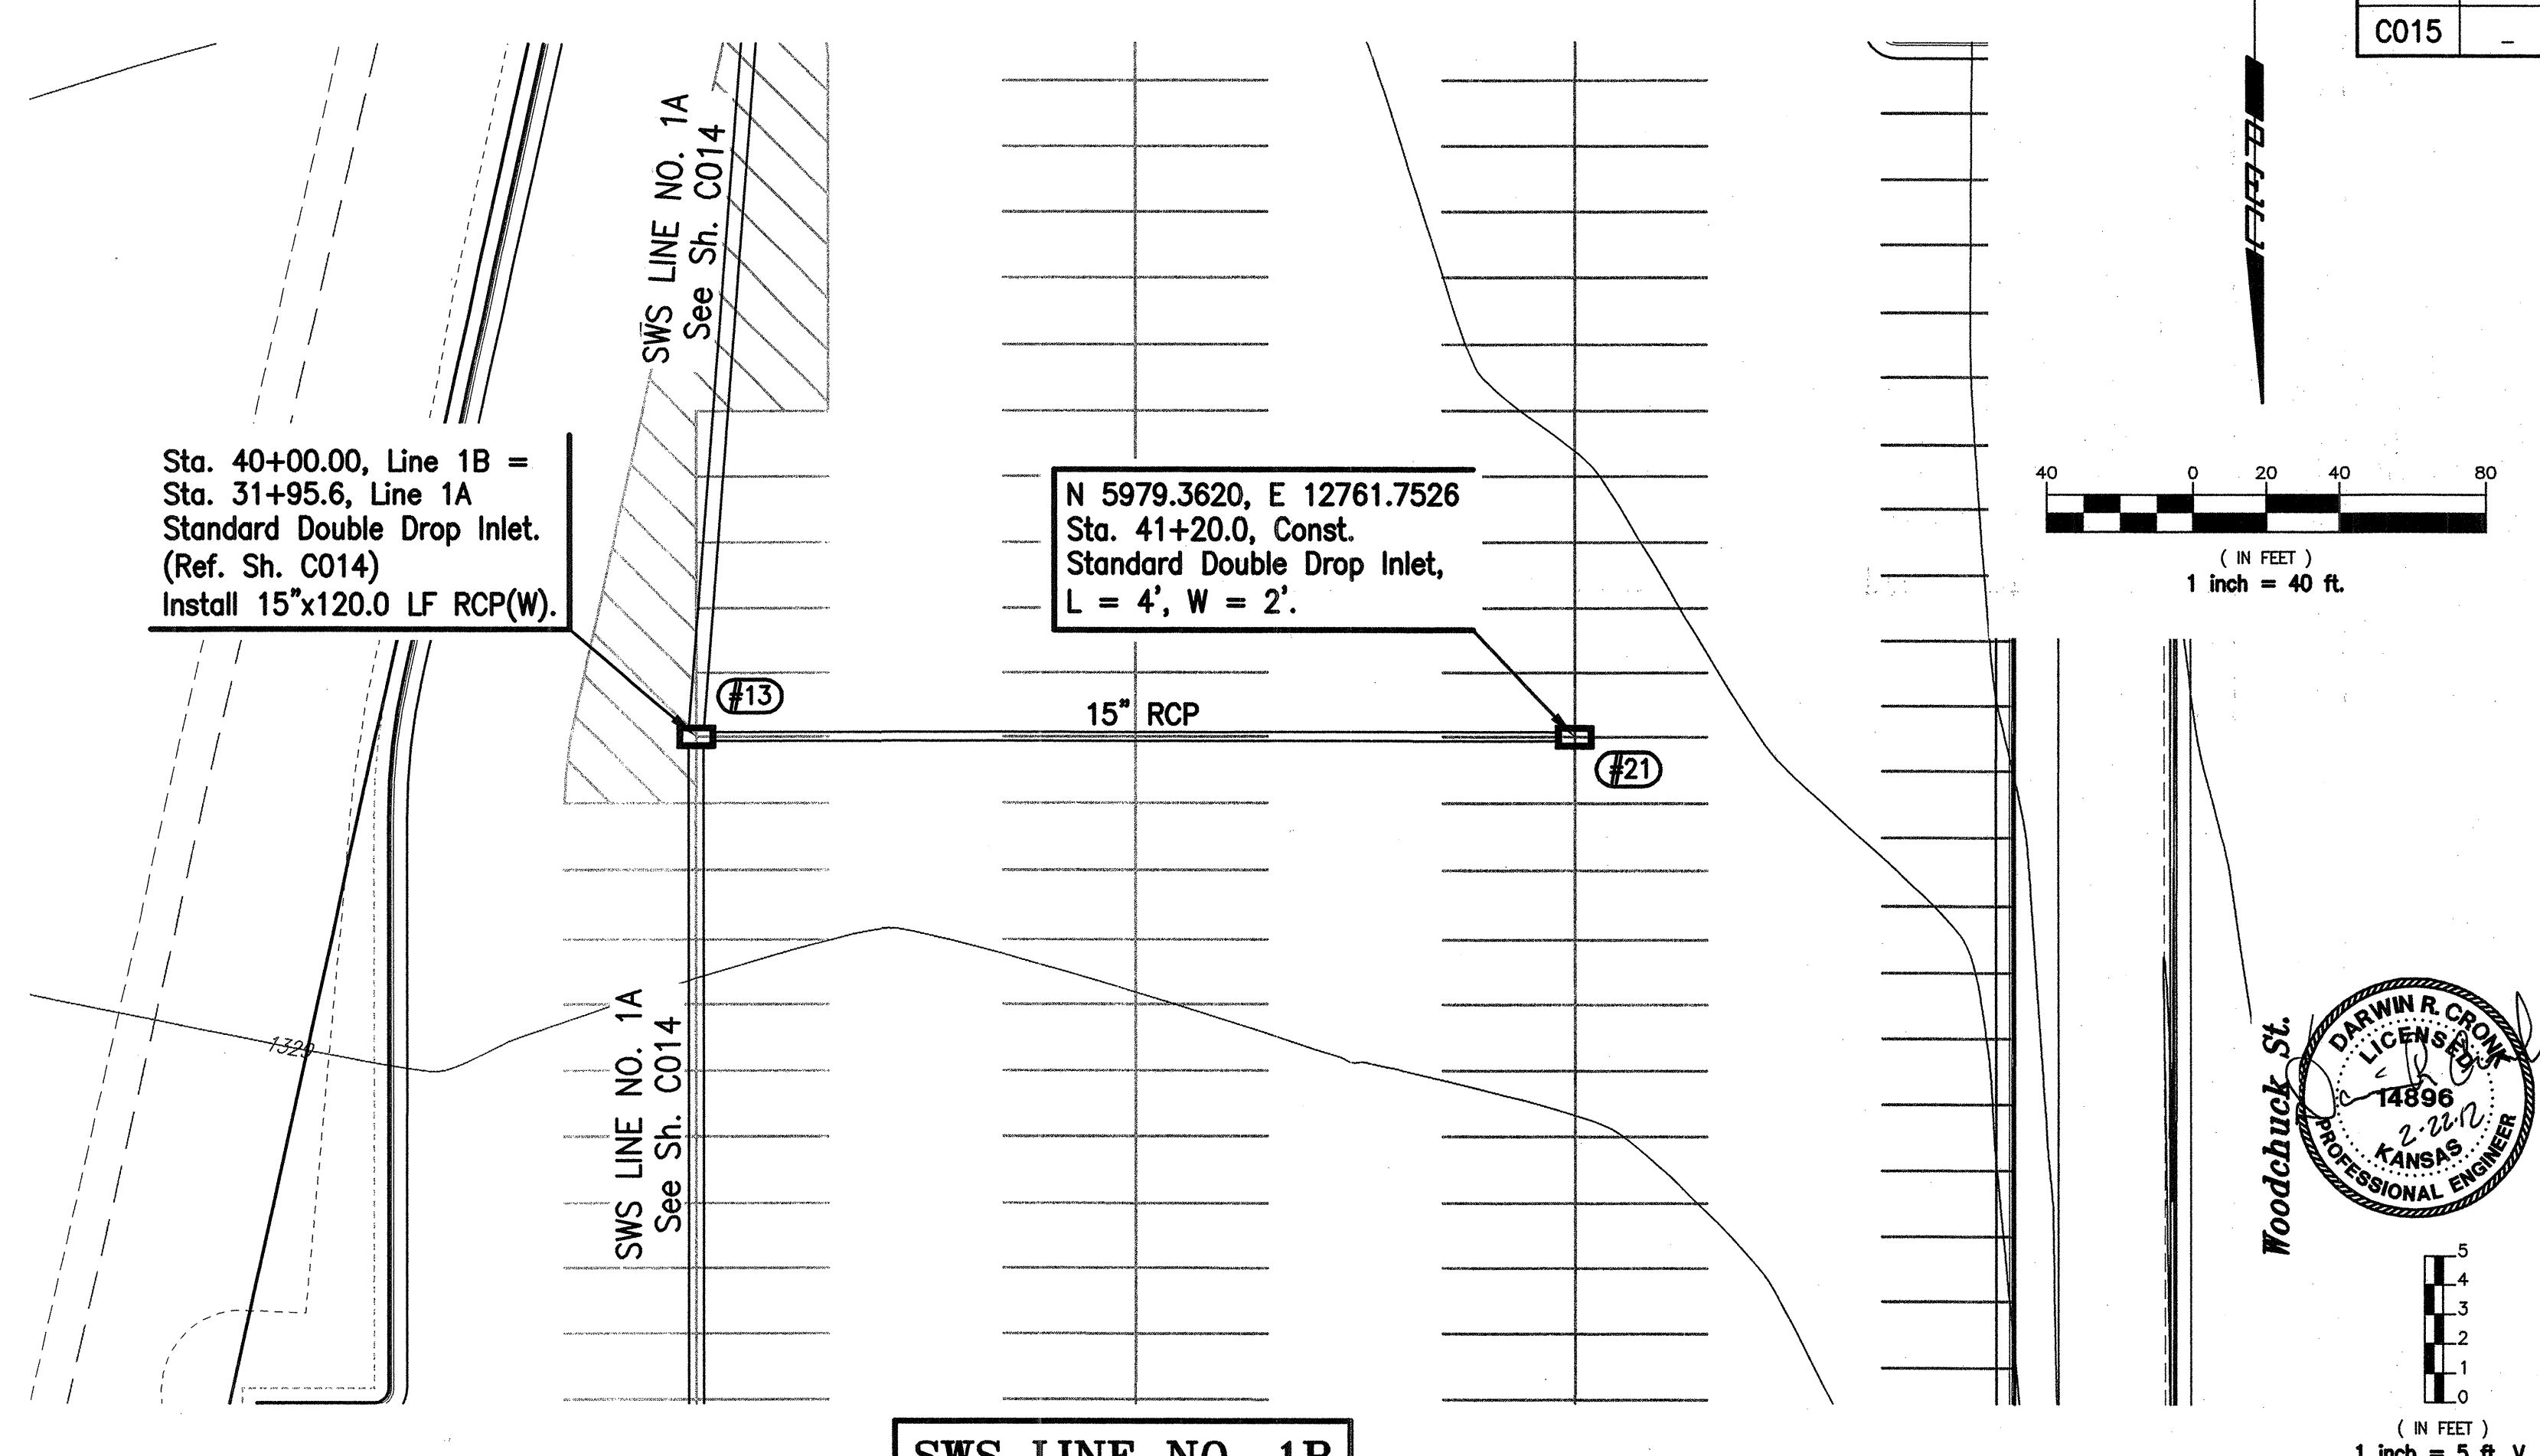


PLAN	CHECKED	DATE
	CHECKED	

PROFILE	CHECKED	DATE
	CHECKED	

Saved 01-13-2012 11:54:45 AM by DMS
 Plot Scale 1:1 02-29-2012 11:05:39 AM by GUYE L. McDONALD
 P:\2011\1394-004\DWG\1394-004-015-stm.dwg

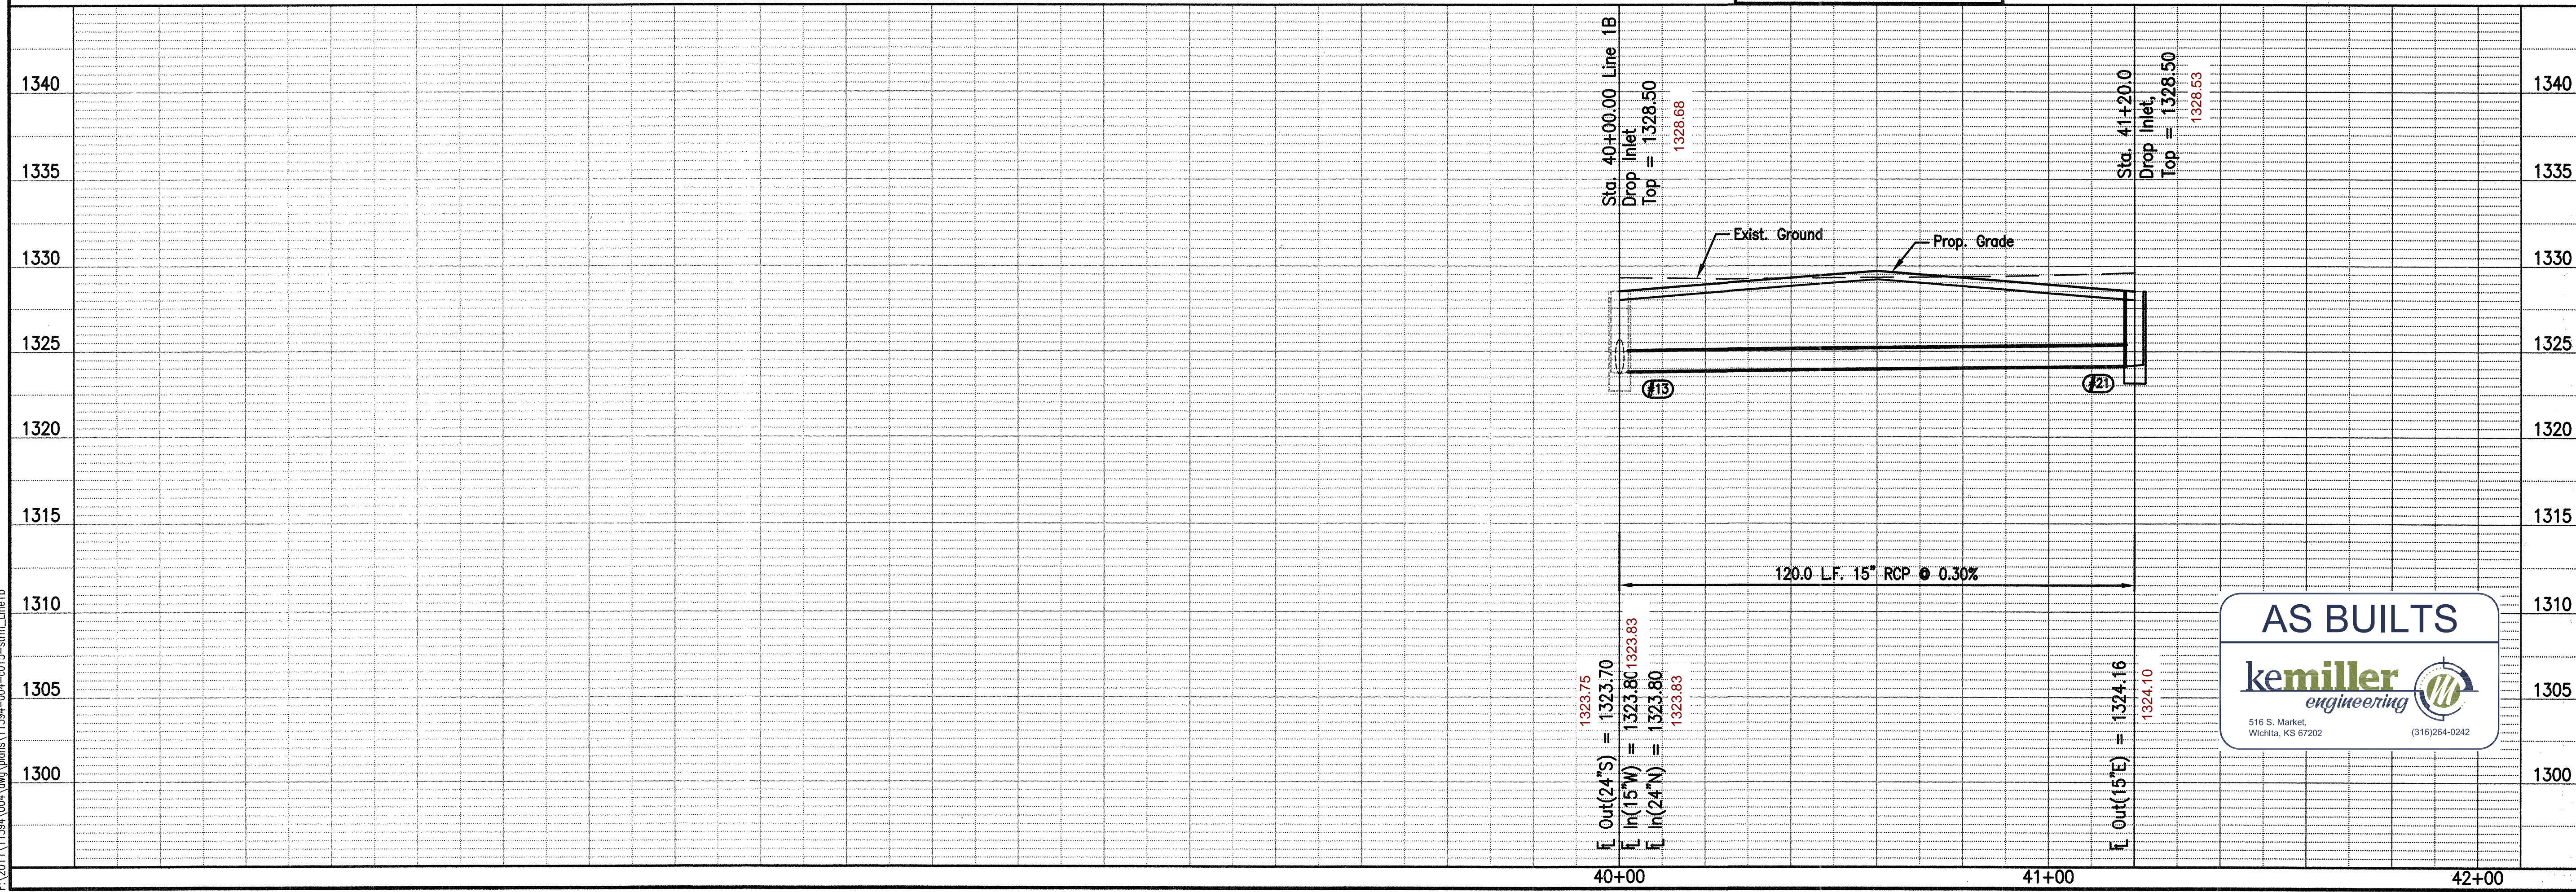


THE WICHITA AIRPORT AUTHORITY
 MID-CONTINENT AIRPORT
STORM SEWER LINE 1B

Professional Engineering Consultants, P.A.
 303 S. TOPEKA • WICHITA, KANSAS 67202
 316-262-2691 • FAX 316-262-3003

AS BUILTS

Job No. 11394-004
 Date Oct. 2011

Designed By DLR
 Drawn By DML

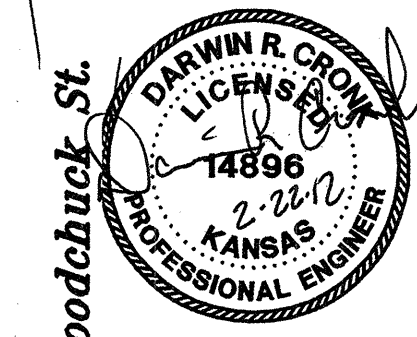

Woodchuck St.