
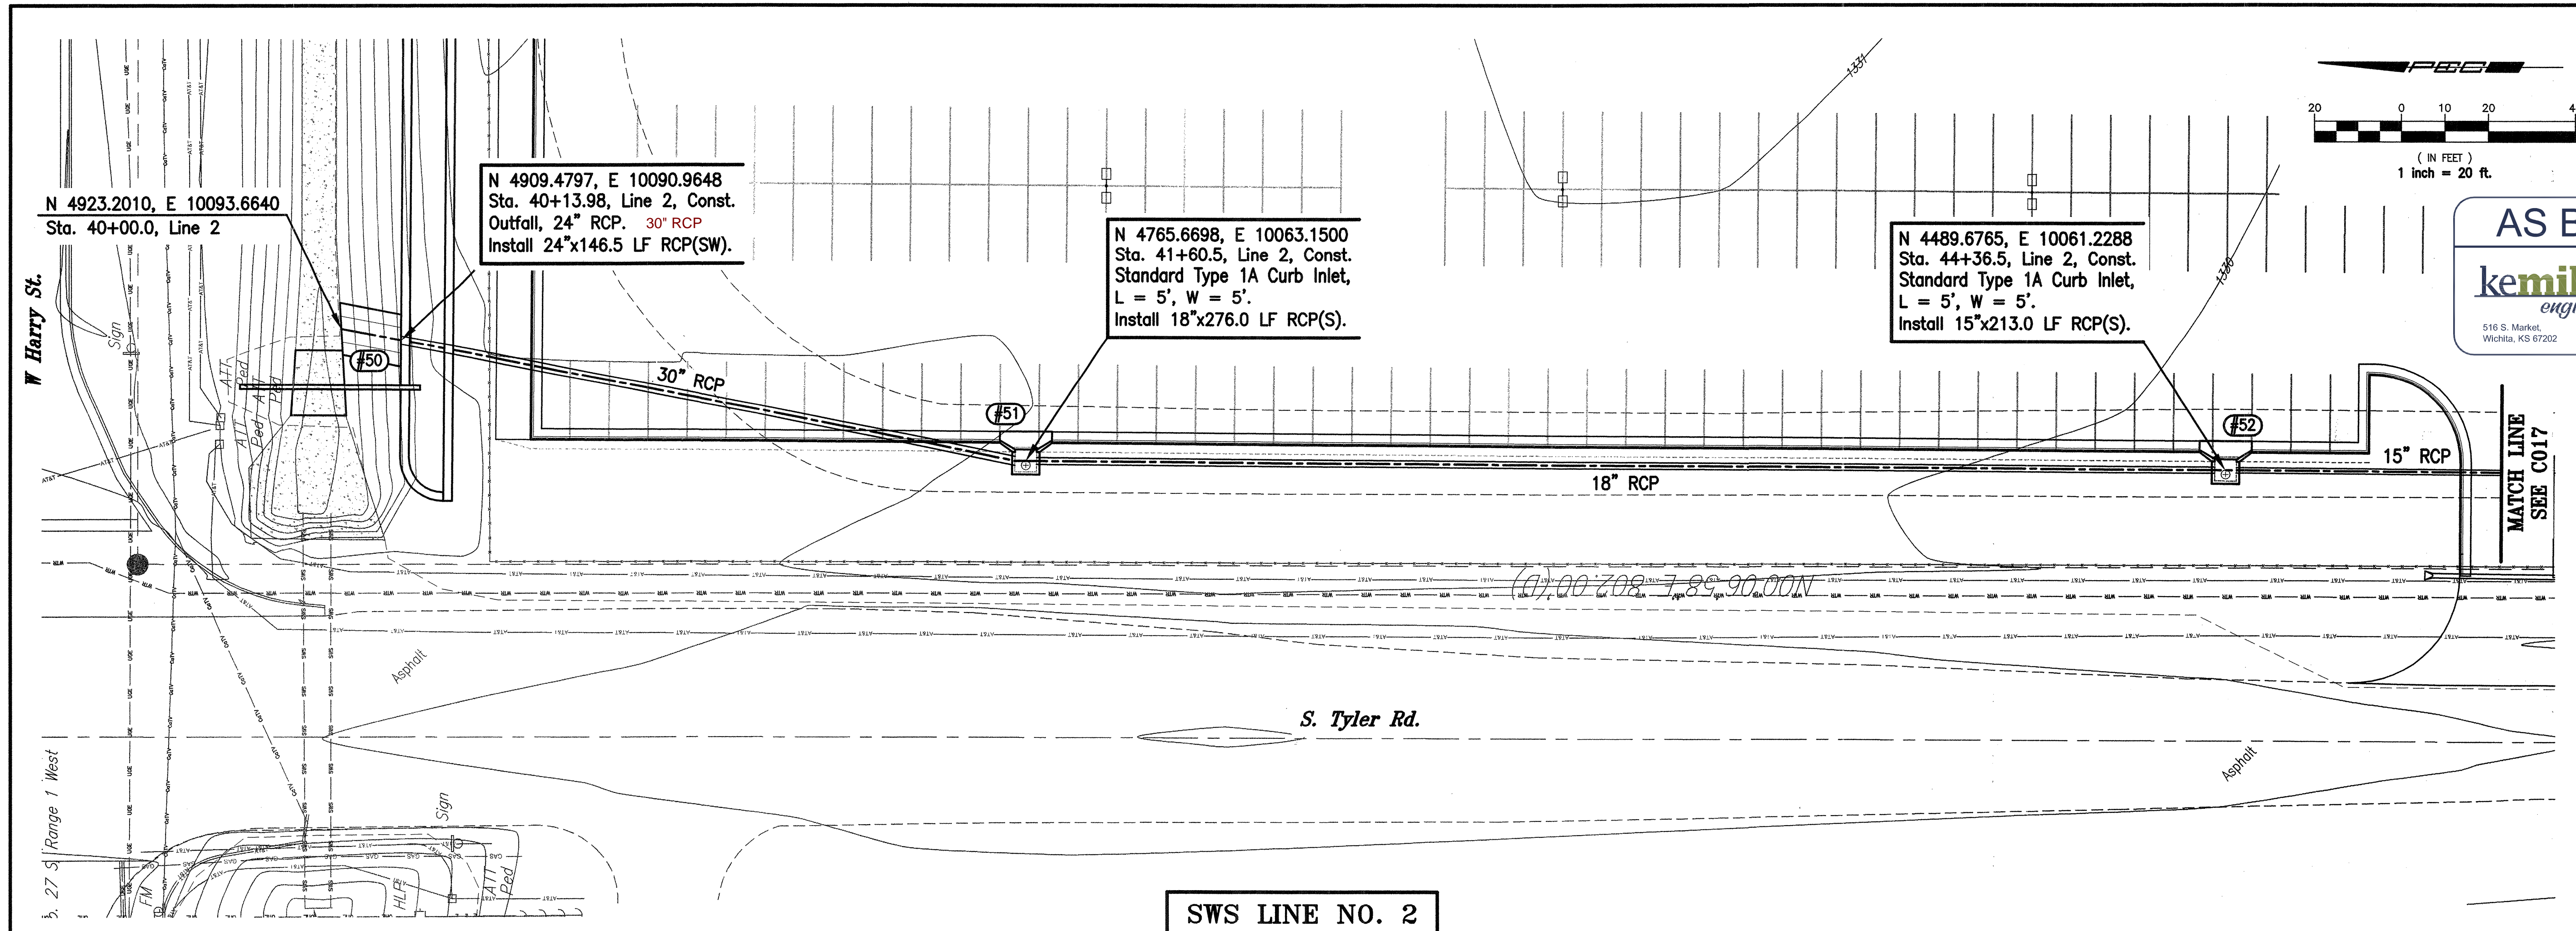
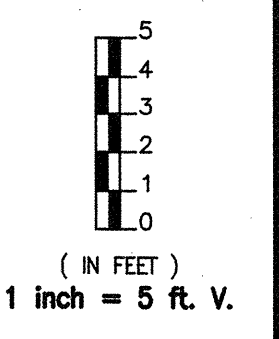


AS BUILTS


kemiller engineering

516 S. Market
Wichita, KS 67202
(316)264-0242

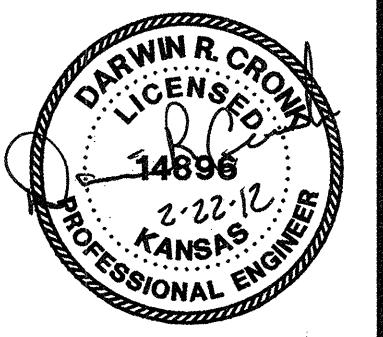

PLAN	CHECKED	CHECKED
BY	DATE	

PROFILE	CHECKED	CHECKED
BY	DATE	

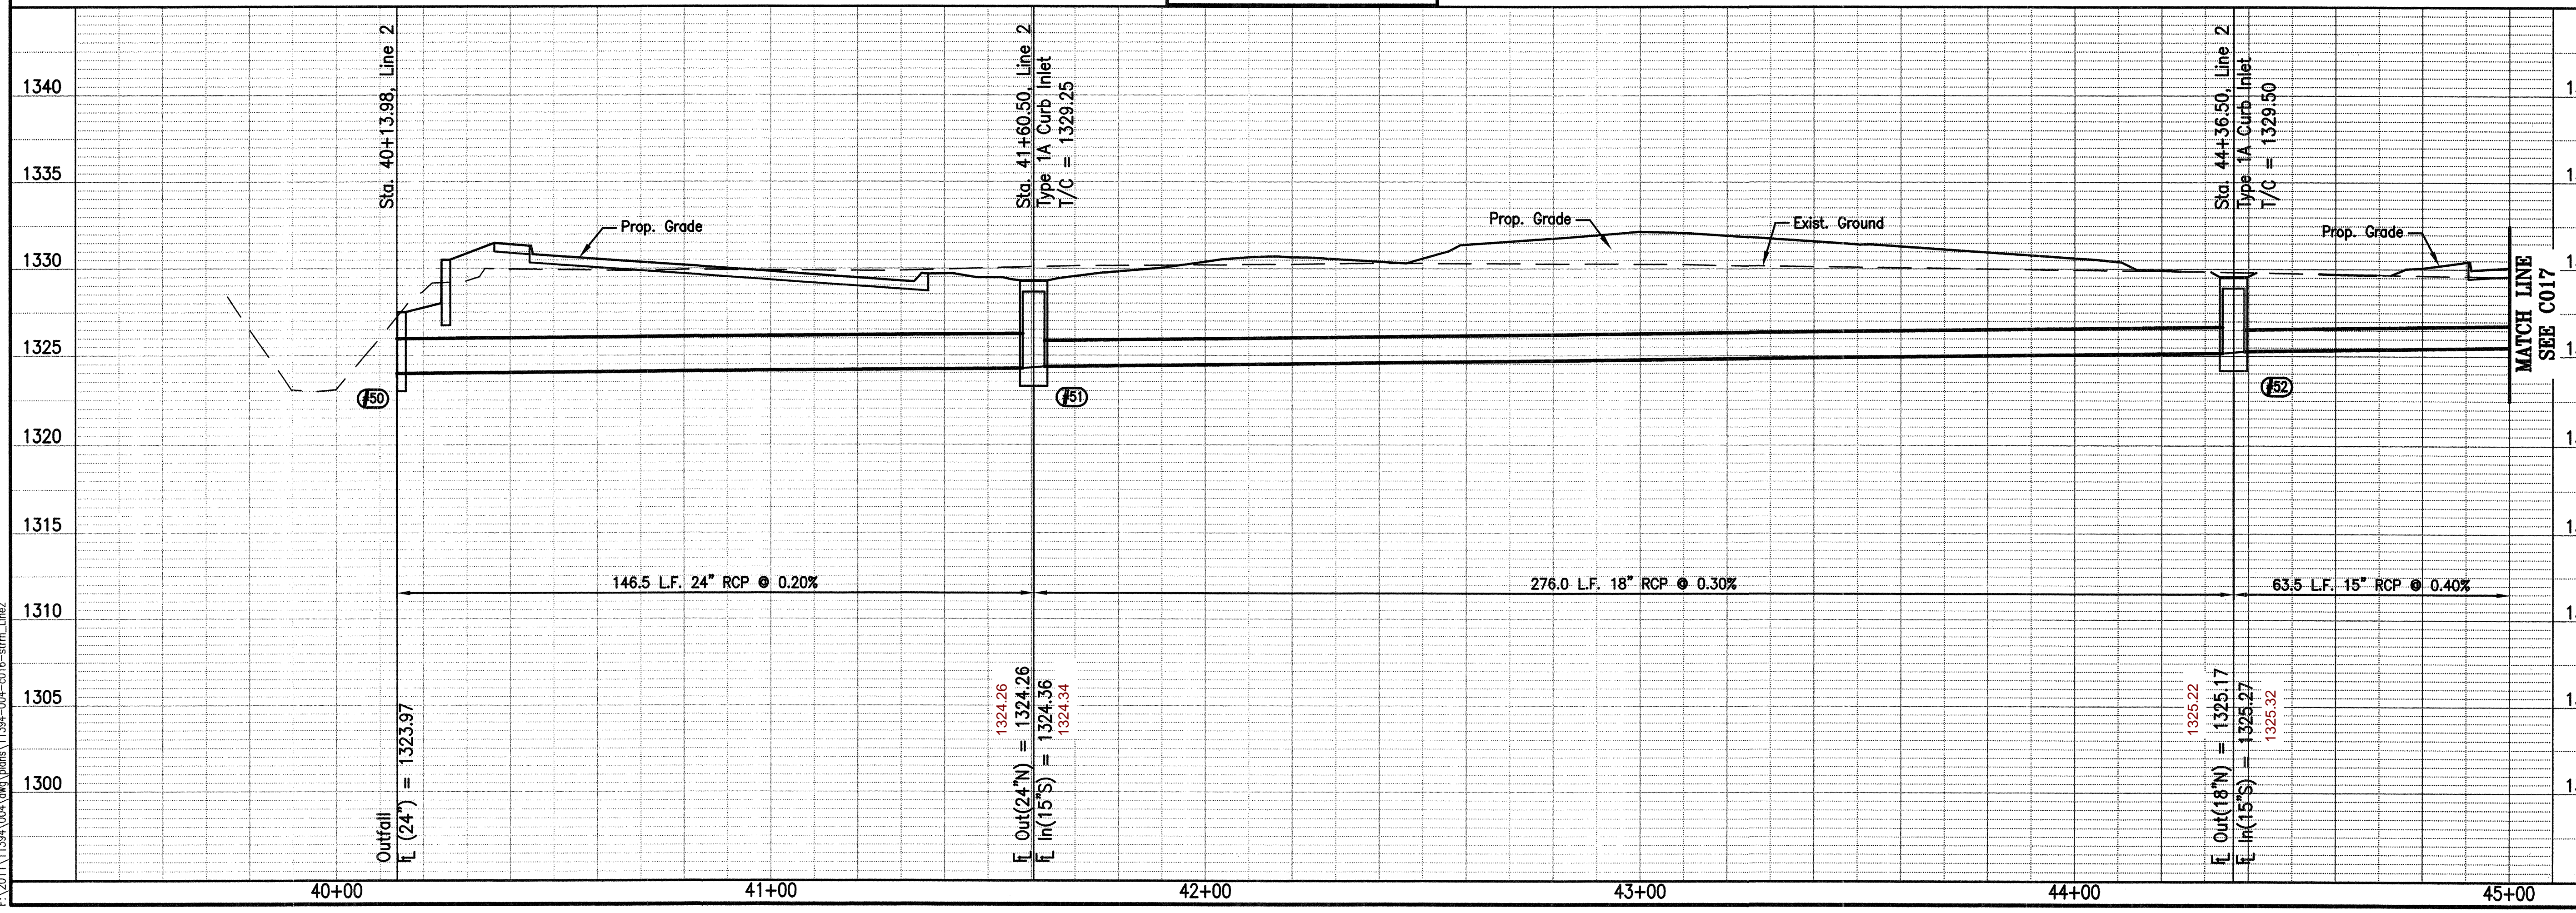

THE WICHITA AIRPORT AUTHORITY
MID-CONTINENT AIRPORT
STORM SEWER LINE 2

Professional Engineering Consultants, P.A.
303 S. TOPICKA • WICHITA, KANSAS 67202
316-262-2691 • FAX 316-262-3003

Job No. 11394-004
Date Oct. 2011

Designed By DLR
Drawn By DJL

Saved 01-13-2012 11:56:09 AM by DNS
Plot Scale 1:1 02-22-2012 11:05:16 AM by GJFE L.MCDONALD
C:\2011\1394\004\dwg\11394-004-stm-line2