

Sanitary Sewer To Serve Midland Baptist Church 2nd Addition Lot 1, Block A

City of Wichita Private Project Number: 2135 PPS (607861)

Gary Janzen, P.E., Interim City Engineer
August 2012

Benchmark

Benchmark
"u" Chiseled on north rim of sanitary sewer manhole.
Elev. = 1337.10 (NGVD 29)

Index


Title/Plan/Profile Sheet	1
Copy of Plat	2
Manhole, Frame, & Cover Details	Available On Request
BMP Erosion Details	Available On Request

Legal Description

Lot 1, Block A, Midland Baptist Church 2nd Addition, Sedgwick County, Kansas

General Notes


- Contractor will be required to provide notice to utility companies a minimum of forty-eight (48) hours prior to any excavation, as follows:
Kansas One-Call 687-2470
The Contractor must notify the following in case of an emergency:
Cox Communications 262-4270
Kansas Gas Service Company 1-888-482-4950
Westar Energy (Electric) 383-8650
Black Hills Energy (Gas) 1-800-303-0357
AT&T 268-2245
City of Wichita Water Dept. (Water) 268-4563
City of Wichita Sewer Maint. (SS) 268-4024
City of Wichita Storm Sewer Maint. 268-4090
City of Wichita Traffic Maint. 268-4034
- All disturbed R/W areas not intended for pavement or sidewalk construction shall be seeded with Kansas Premium Fescue Blend at a rate of 8 lb./1000 Sq. Ft., fertilized with a 16-20-6 ratio at a rate of 4 lb./1000 Sq. Ft., and mulched with Prairie Hay at a rate of 92 lb./1000 Sq. Ft. Mulch shall be "patted" with forks or punched into soil to reduce loss due to wind.
- Contractor shall furnish the inspector with a copy of the manufacturer's certification for any pipe used on this project after completion of pipe installation. The engineer will not certify the project to the city until pipe certification has been received.
- All sewer lines and appurtenances shall be installed in accordance with the most recent edition of City of Wichita, Kansas Standard Specifications for the Construction of City Projects.
- Rubble from the removal of miscellaneous structures and excess excavation which is to be wasted shall be disposed of on sites to be provided by the Contractor. These sites shall be approved by the Engineer as to suitability, appearance and site location. Locations that, in the opinion of the Engineer, will leave an unsightly appearance will not be approved. All disposal sites must be approved by the Kansas Department of Health and Environment. Material either stockpiled or disposed of in a flood plain would require a Kansas State Board of Agriculture permit. Any material dumped in waters of the United States or wetlands is subject to U.S. Corps. of Engineers permitting regulations. Any material buried or stockpiled beyond approved construction limits would require additional archaeological investigations unless buried in a previously approved borrow location.
- Contractor shall not start work on the project until the project inspector is assigned to the project and is present on the site. Contractor shall not start on the project until all necessary bonds and permits have been obtained. Bonds may include but are not limited to Statutory, Performance & Maintenance Any work done without inspection will be required to be uncovered for inspection.
- Utility service lines, poles, valve boxes, meters, at cetera are to be adjusted as necessary by others prior to construction unless the plans specifically call for their adjustment by the Contractor or unless the plans specifically identify a utility to be adjusted by its owner during construction. Existing utilities and their location, as shown on the plans represent the best information obtainable for design and shall be field verified. The contractor will be required to work around existing utilities within the right-of-way which do not conflict with proposed construction.

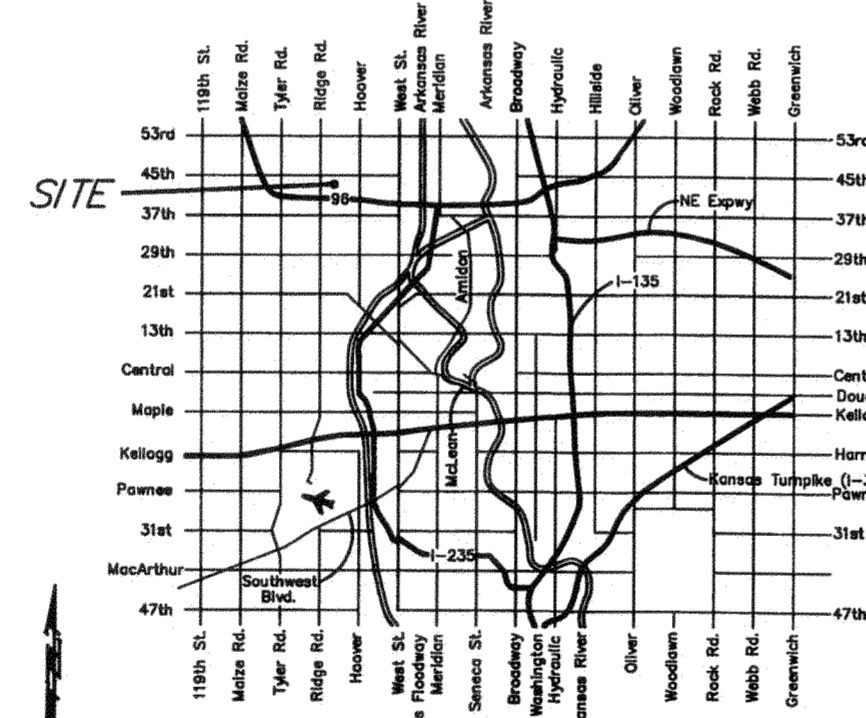

VICINITY MAP

APPROVED AS NOTED
BY CITY ENGINEER OF WICHITA
Sanitary Sewers *Julian Kallman* 8-13-12
NOTE TO CONTRACTORS
Installation, inspection and testing for this project is to be provided by a Licensed Consulting Engineering Firm under contract with the Owner/Developer. Said inspection to be in accordance with the City of Wichita standard construction engineering practices and certified by a Licensed Professional Engineer. No work shall be performed in dedicated easements or public right-of-way by the Contractor without such inspection nor shall any work be commenced without written authorization by the City Engineer. All Construction and Materials shall comply with the City of Wichita Specifications and Standards (on file and available in the City Engineer's Office).

45TH ST. NORTH

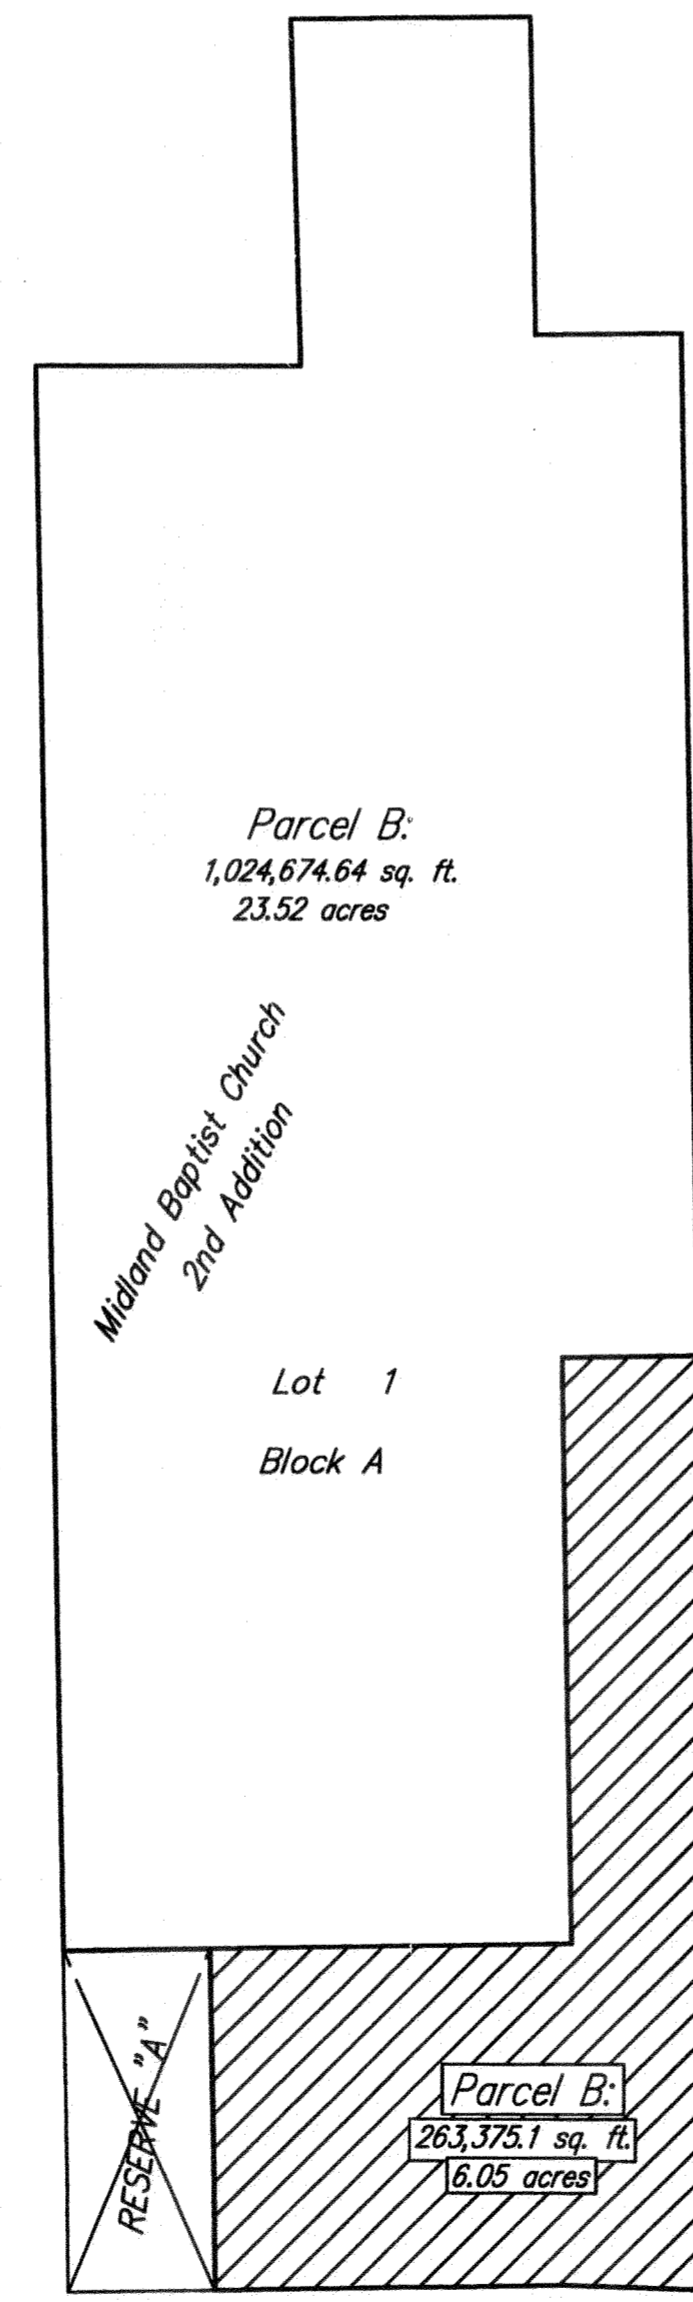

HIGHWAY K-96
(DEED BOOK 1388, PAGE 557)

Benefit District

CAUTION! VERIFY!
AT&T, Cable, & Electric
Line Crossings. Depths
Unknown.

Sta. 0+00, Begin Line 1
Core Existing Manhole.
Extend 8" Sanitary Sewer West.


Sta. 0+35.0, End Line 1
Construct Shallow 4" Dia. Manhole.
Top = 1335.30.
6" Stub At Angle Shown.

Stub
Released Date: 11/20/2012
T. Mason - City of Wichita, Inspector
: APRosas 9/21/2012

Contractor To Use Extreme Caution
When Excavating Near Utility Lines.
Contractor To Hand Dig To Expose All
Utility Lines Prior To Construction.
Verify Depth To Determine Conflict If Any.

Contractor Shall Follow All Applicable
Best Management Practices (BMP)
For Erosion Control.

AS-BUILT
SEPTEMBER 10TH, 2012
CONTRACTOR: CK CONTRACTING
SUPERINTENDENT: TERRY HENRY
INSPECTING FIRM: RUGGLES & BOHM PA
INSPECTORS: TONY YOUNG & DAKOTA ZIMMERMAN

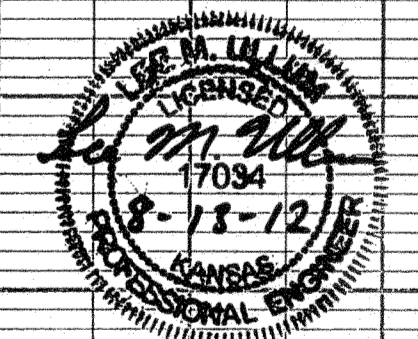

Baughman		Sanitary Sewer To Serve Midland Baptist Church Addition Lot 1, Block A	
Baughman Company, P.A. 315 Ellis St., Wichita, KS 67211 P 316-262-7271 F 316-262-0149 ENGINEERING SURVEYING PLANNING LANDSCAPE ARCHITECTURE			
PROJECT NUMBER	DESIGN	DRAWN	
	LU	LU	
	APPROVED	DATE	
	LU	08/2012	
	SCALE	Noted	
	SHEET		
1 OF 2			
Midland Baptist PPS		12-07-E780	

