



**SANITARY SEWER PLANS FOR
FOX RIDGE ADDITION
PHASE 11**

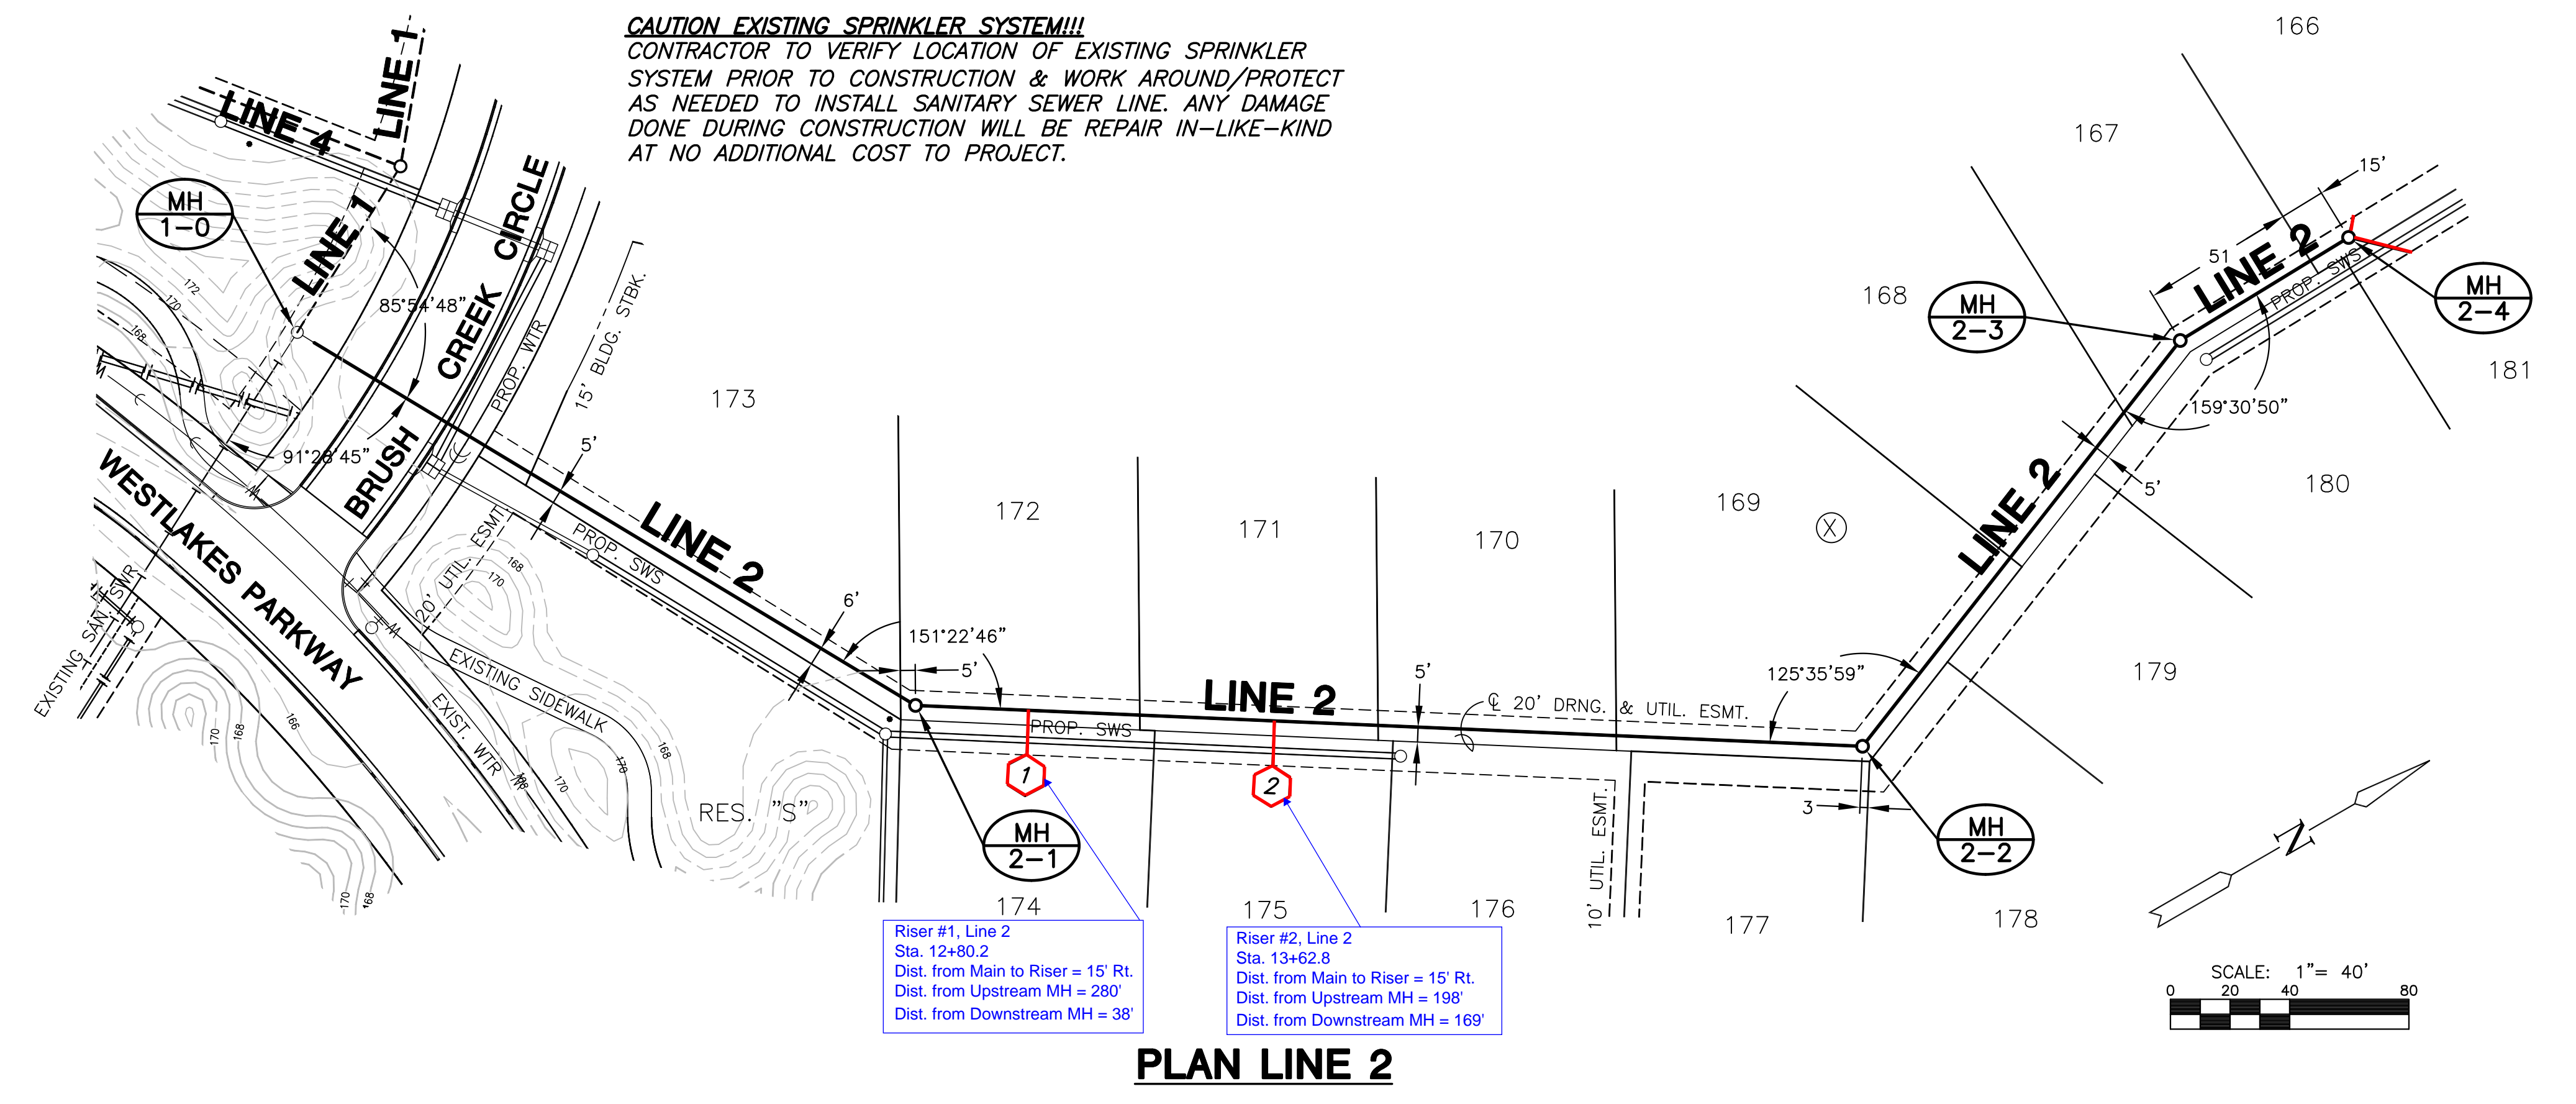

PLAN LINE 2

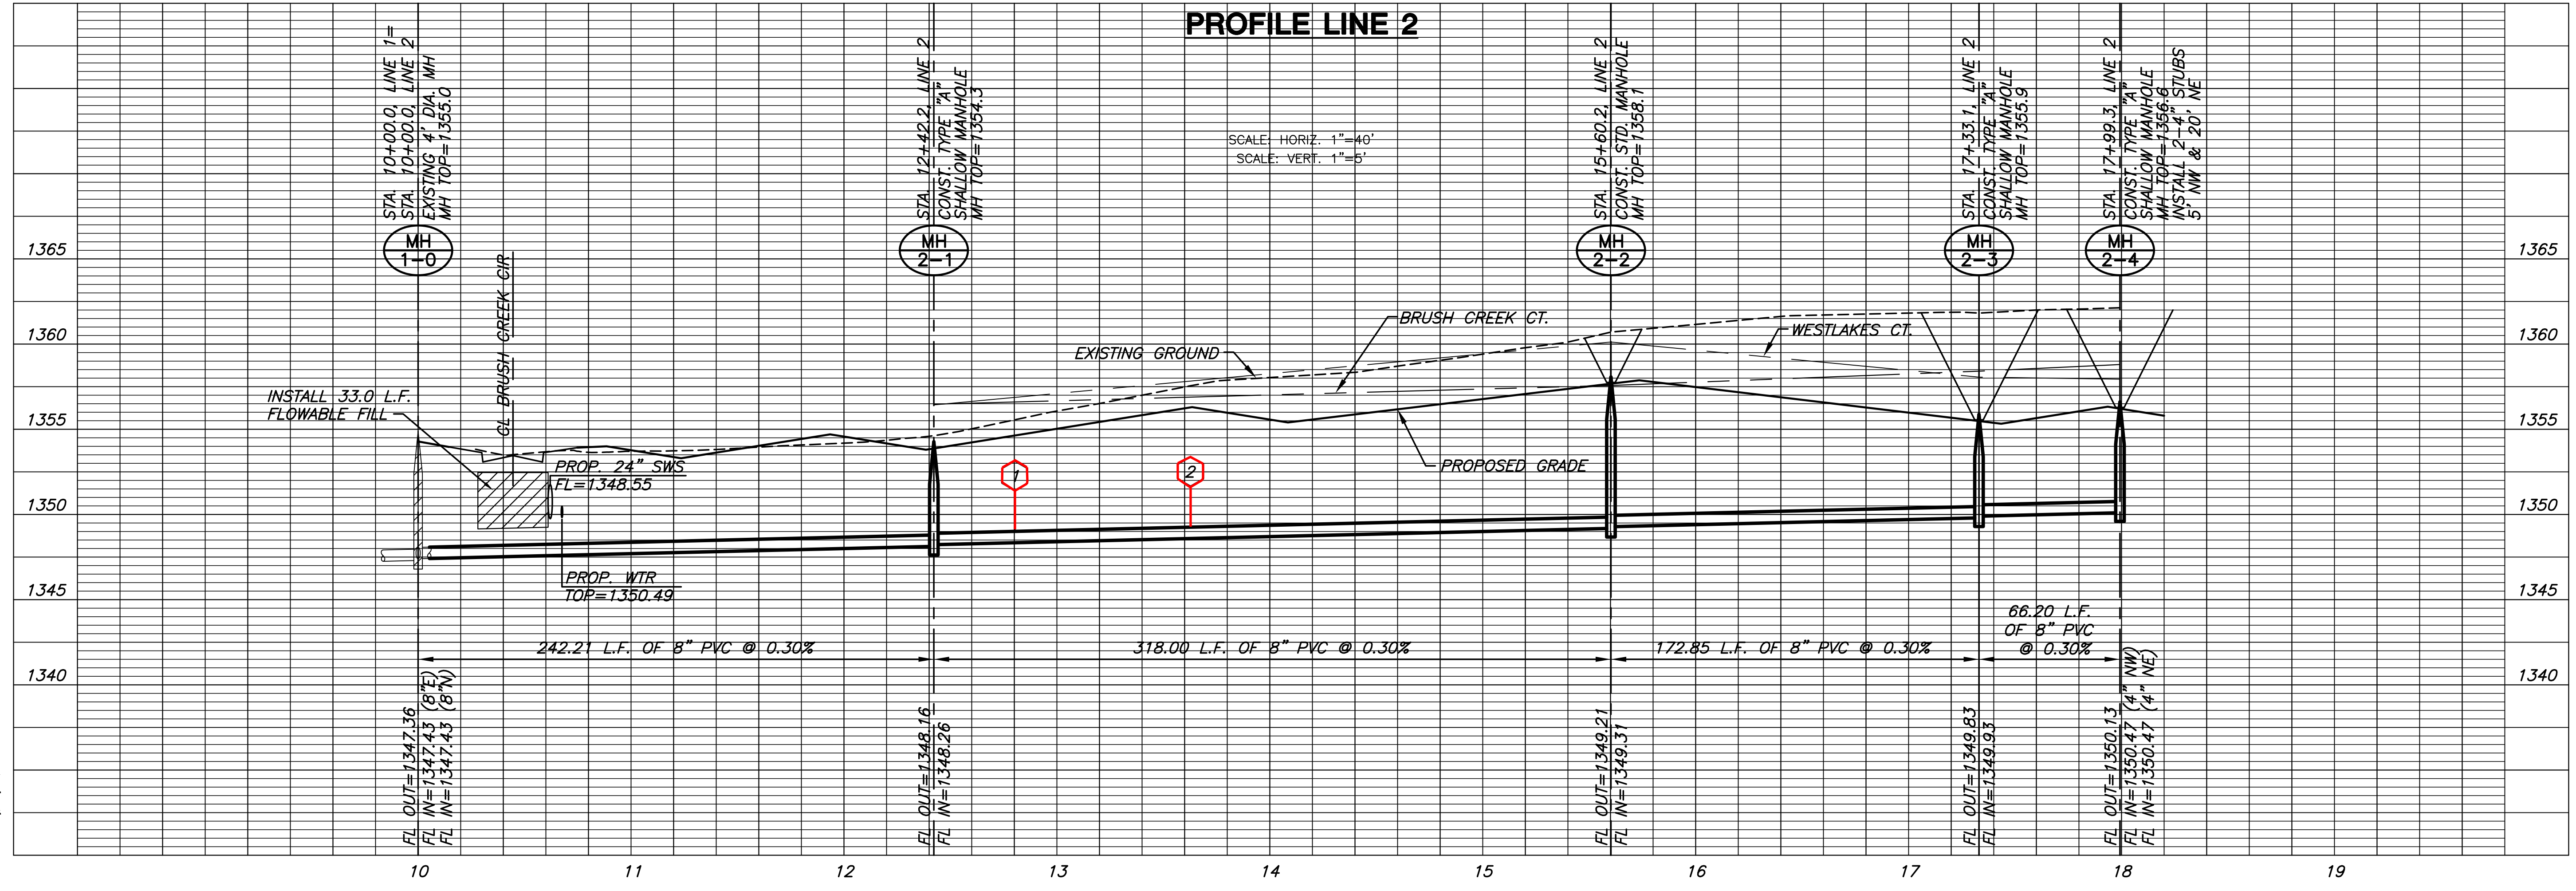

PROFILE LINE 2

PLOTTED: Wednesday, July 20, 2011 @ 11:20AM

G:\CIVIL\99118\DWG\SAW\PH11\99118_LB2.DWG

LINE 2
SHEET TITLE
468-83647
PROJECT NUMBER

DFL / JWC / GJA
DESIGNED / DRAWN / CHECKED

ISSUED
July 2011
REVISED

SHEET NO.
6 of 15