


**CAUTION EXISTING SPRINKLER SYSTEM!!!**  
CONTRACTOR TO VERIFY LOCATION OF EXISTING SPRINKLER SYSTEM PRIOR TO CONSTRUCTION & WORK AROUND/PROTECT AS NEEDED TO INSTALL SANITARY SEWER LINE. ANY DAMAGE DONE DURING CONSTRUCTION WILL BE REPAIR IN-LIKE-KIND AT NO ADDITIONAL COST TO PROJECT.

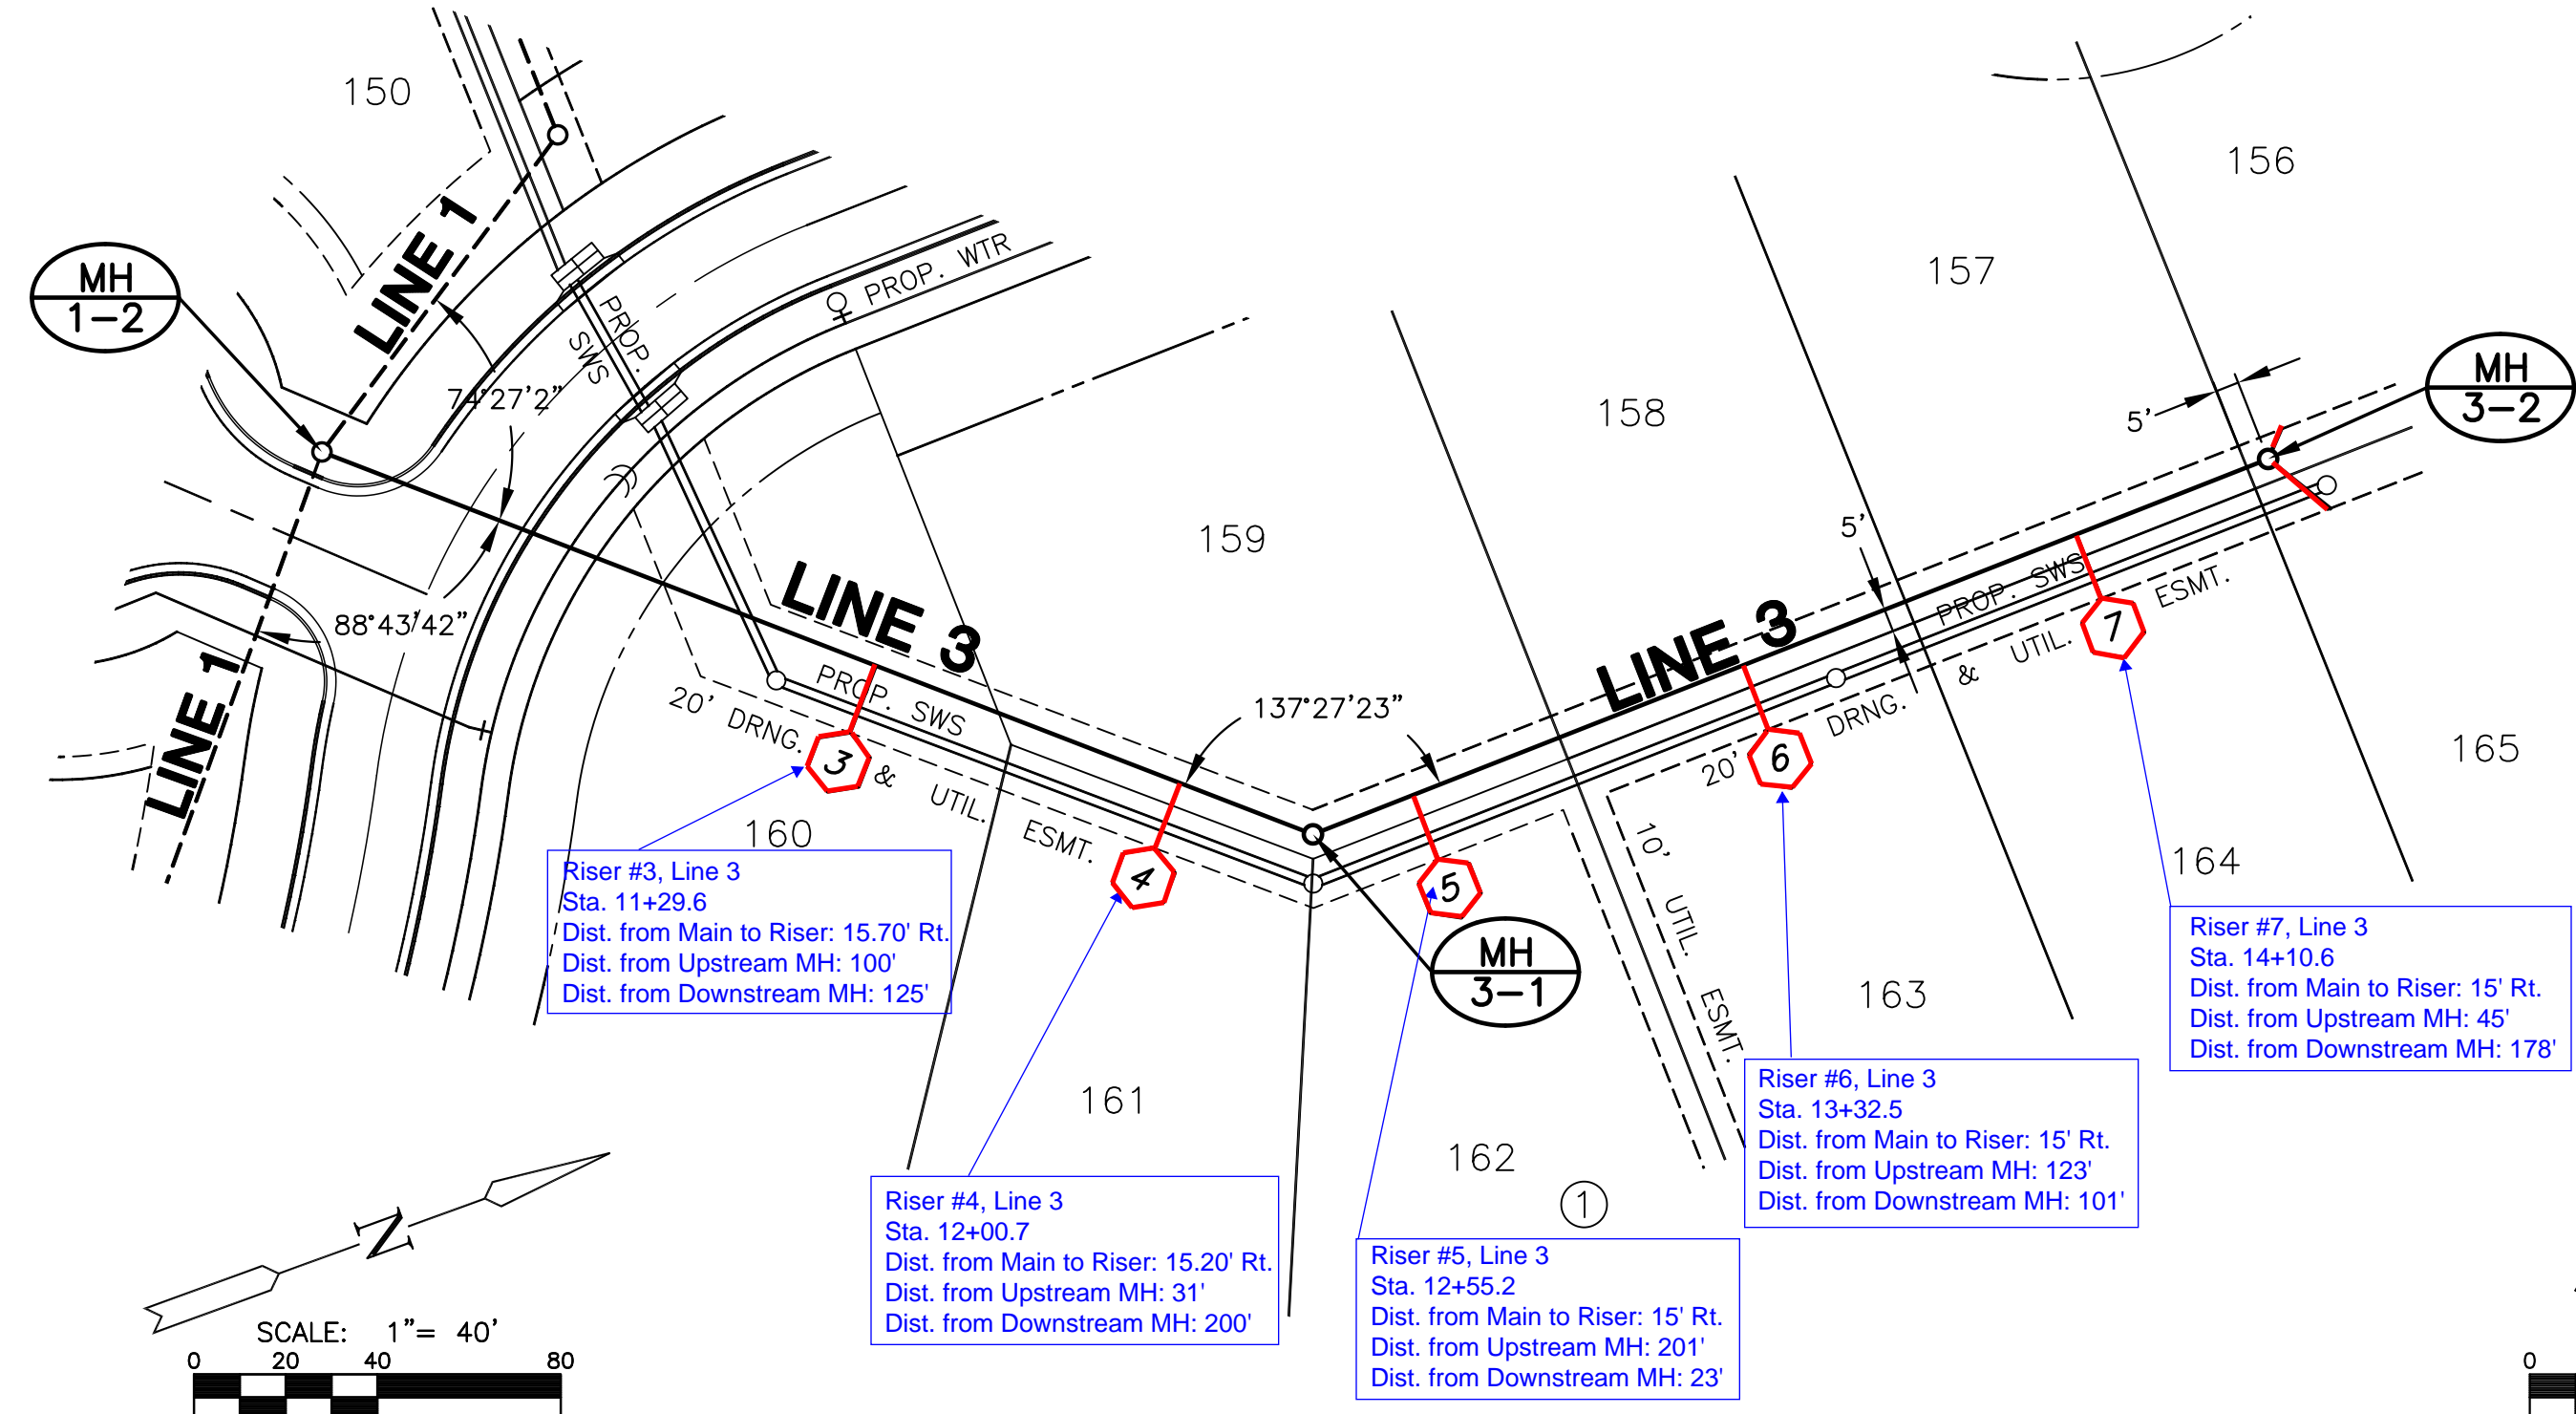






Riser #3, Line 3  
Sta. 11+29.6  
Dist. from Main to Riser: 15.70' Rt.  
Dist. from Upstream MH: 100'  
Dist. from Downstream MH: 125'

Riser #4, Line 3  
Sta. 12+00.7  
Dist. from Main to Riser: 15.20' Rt.  
Dist. from Upstream MH: 31'  
Dist. from Downstream MH: 200'

Riser #5, Line 3  
Sta. 12+55.2  
Dist. from Main to Riser: 15' Rt.  
Dist. from Upstream MH: 201'  
Dist. from Downstream MH: 23'

Riser #6, Line 3  
Sta. 13+32.5  
Dist. from Main to Riser: 15' Rt.  
Dist. from Upstream MH: 123'  
Dist. from Downstream MH: 101'

Riser #7, Line 3  
Sta. 14+10.6  
Dist. from Main to Riser: 15' Rt.  
Dist. from Upstream MH: 45'  
Dist. from Downstream MH: 178'

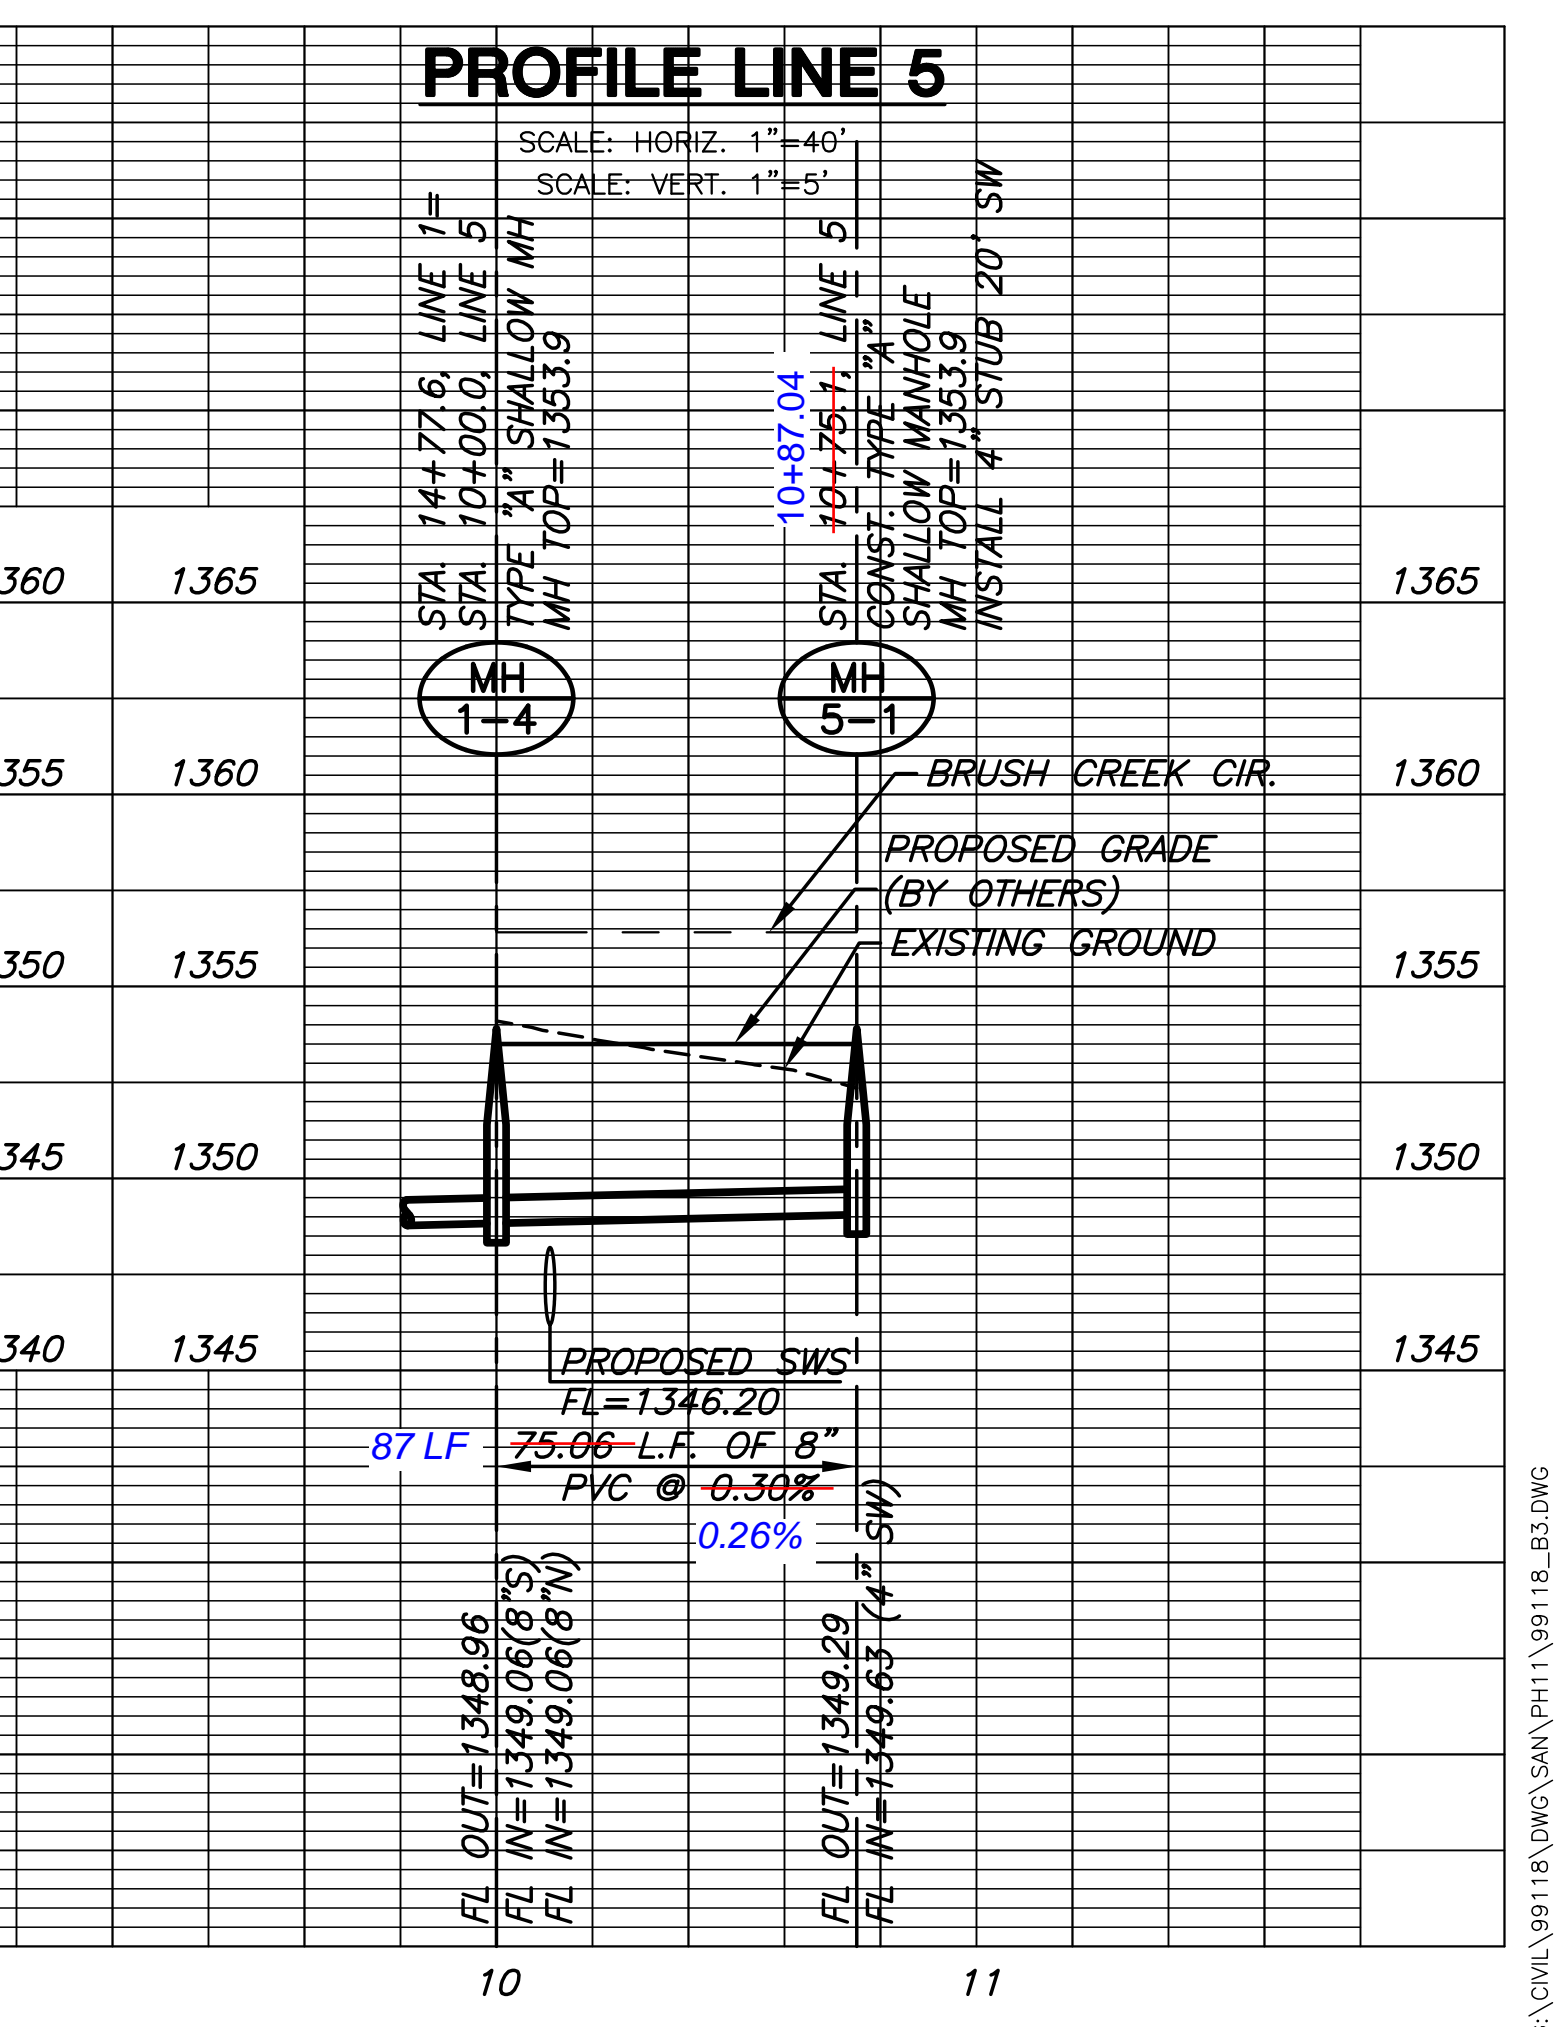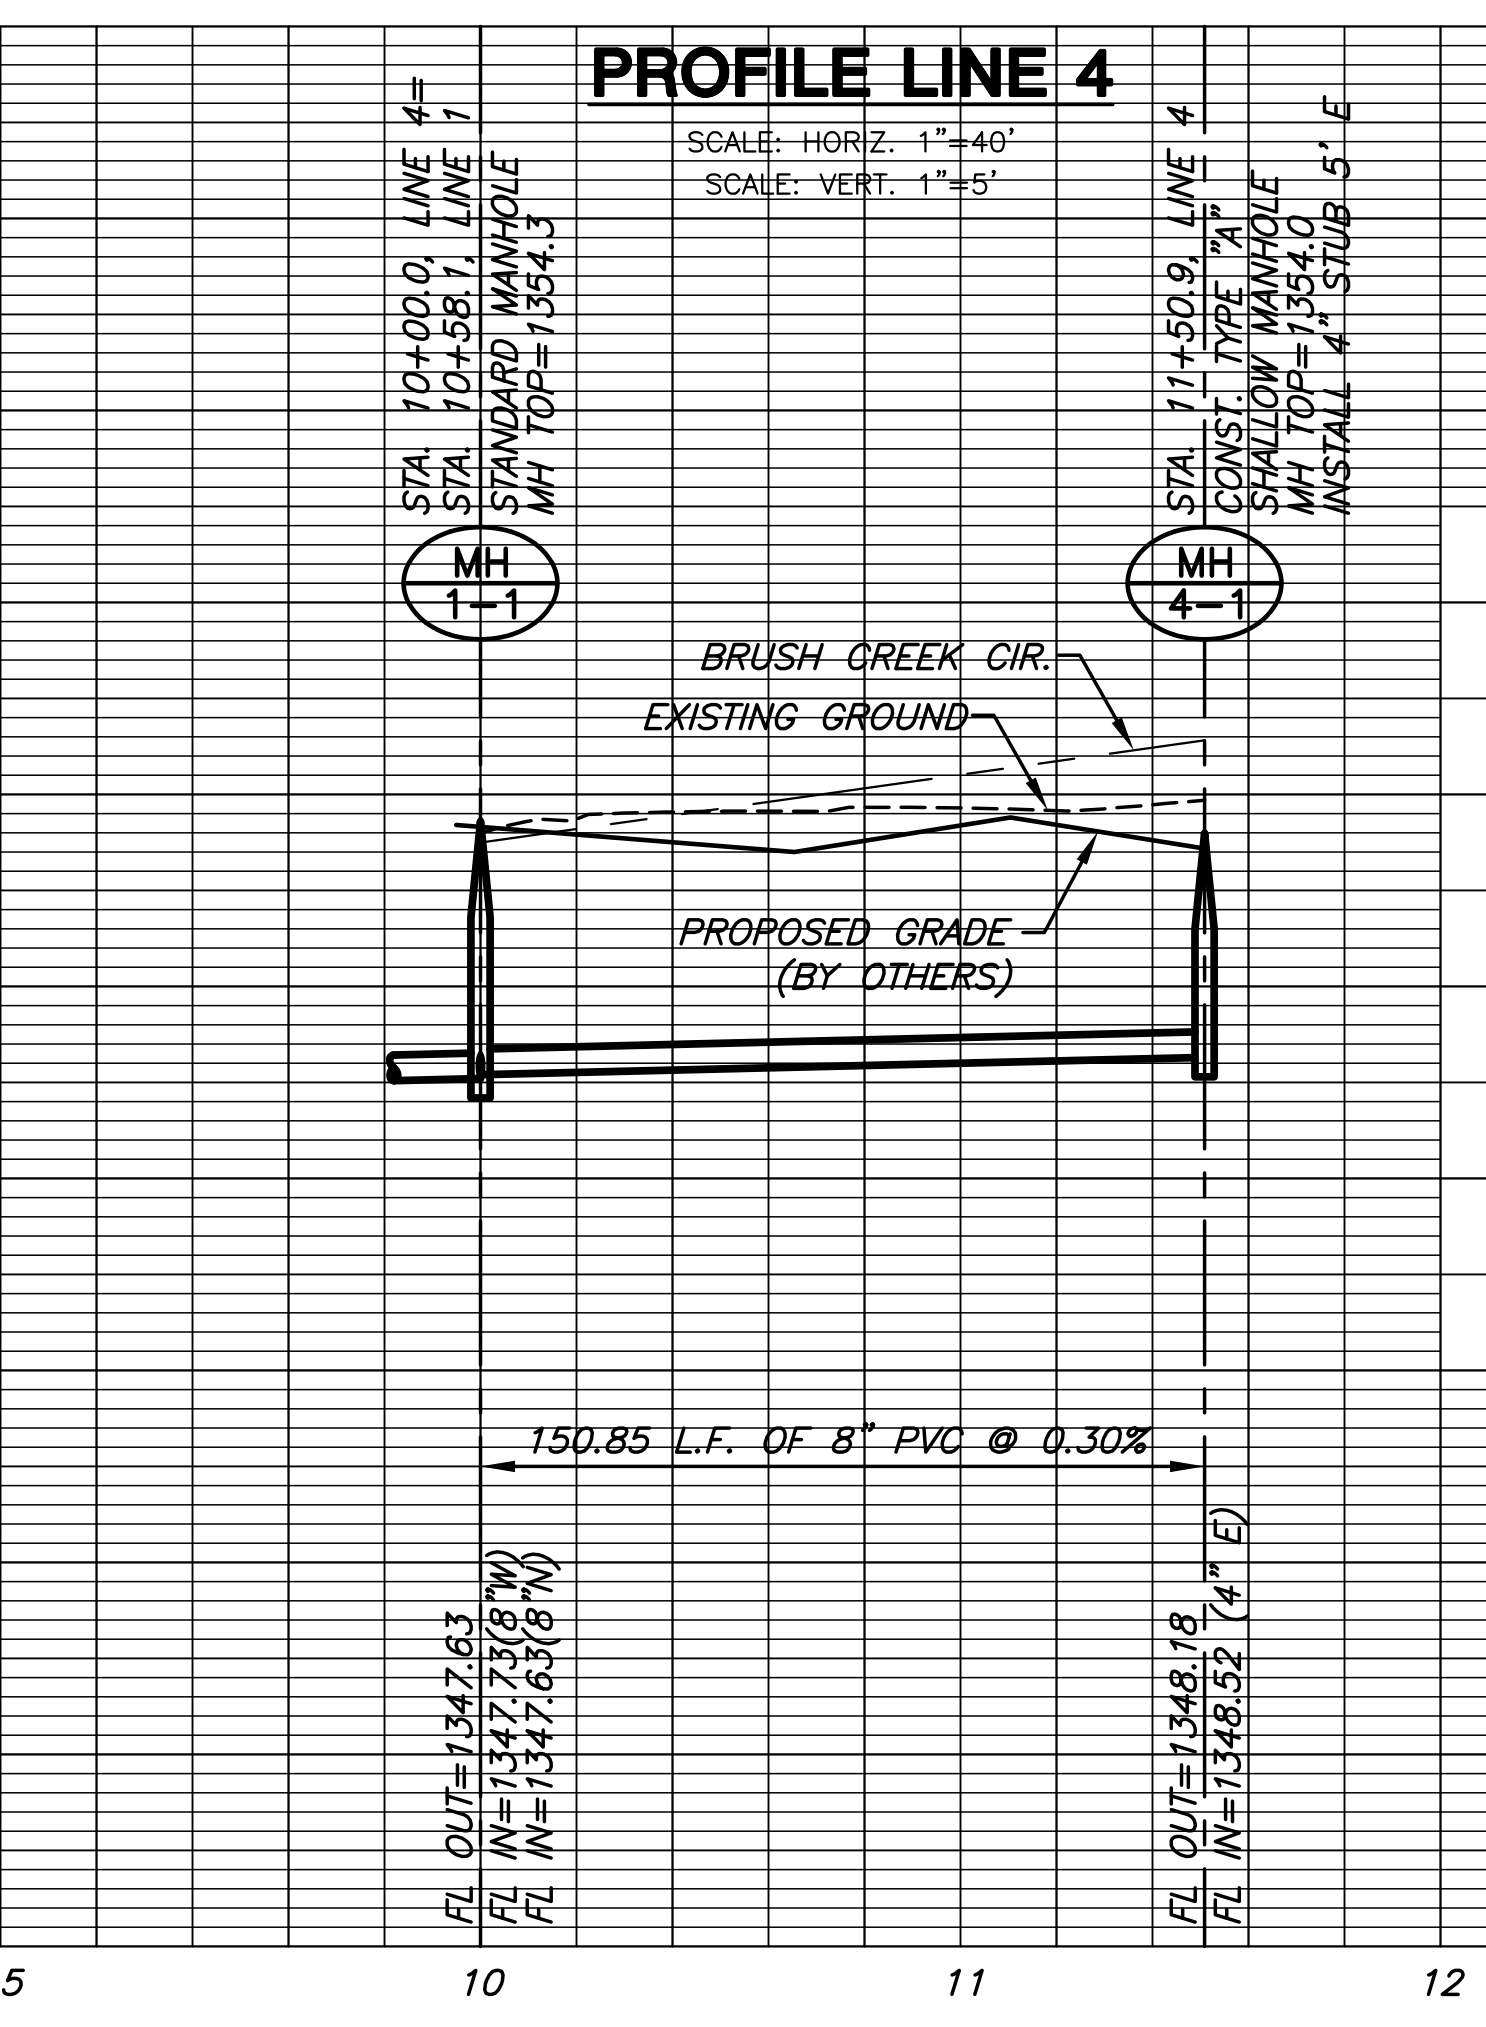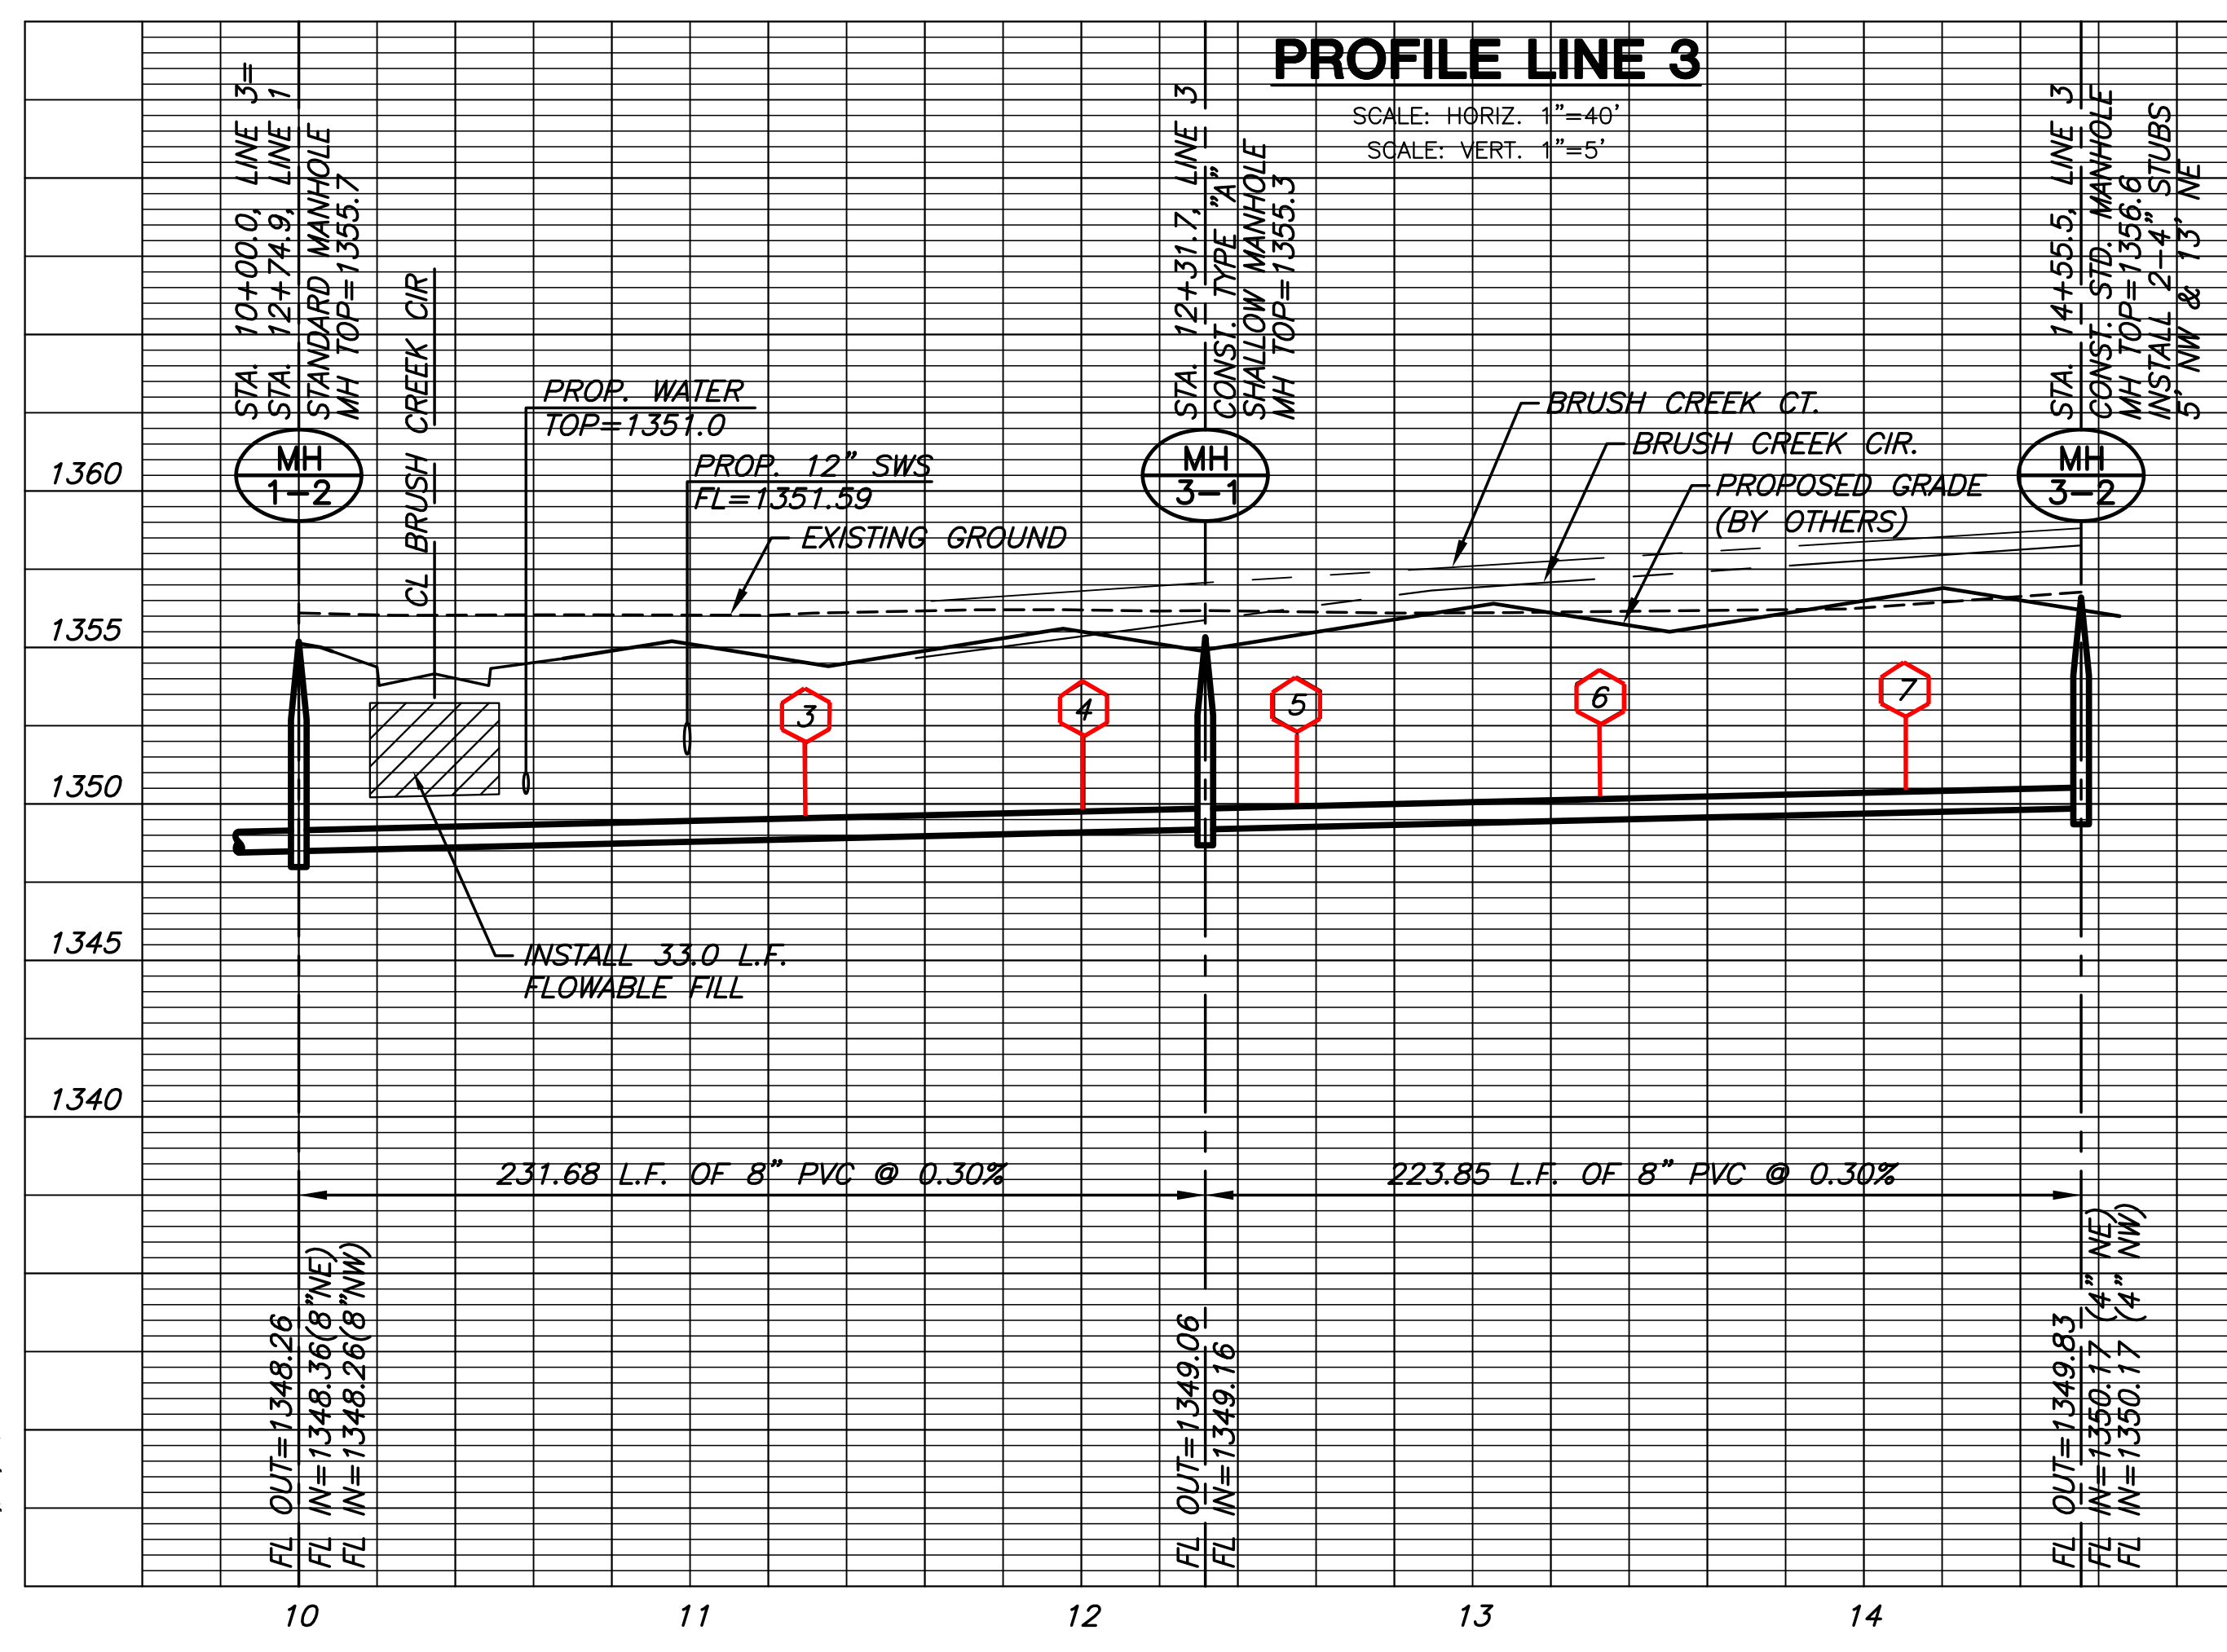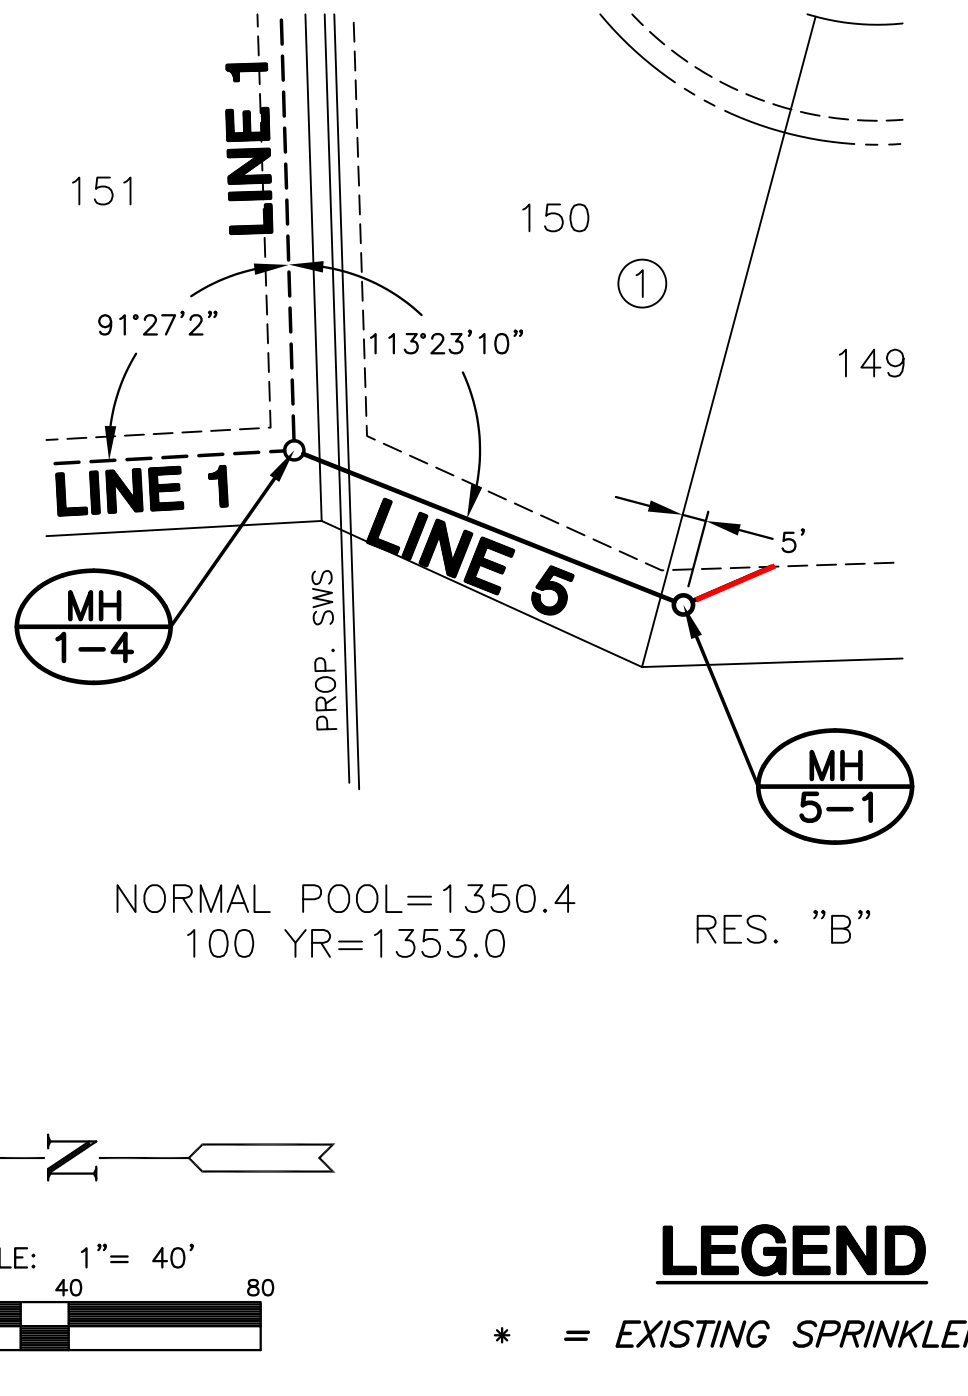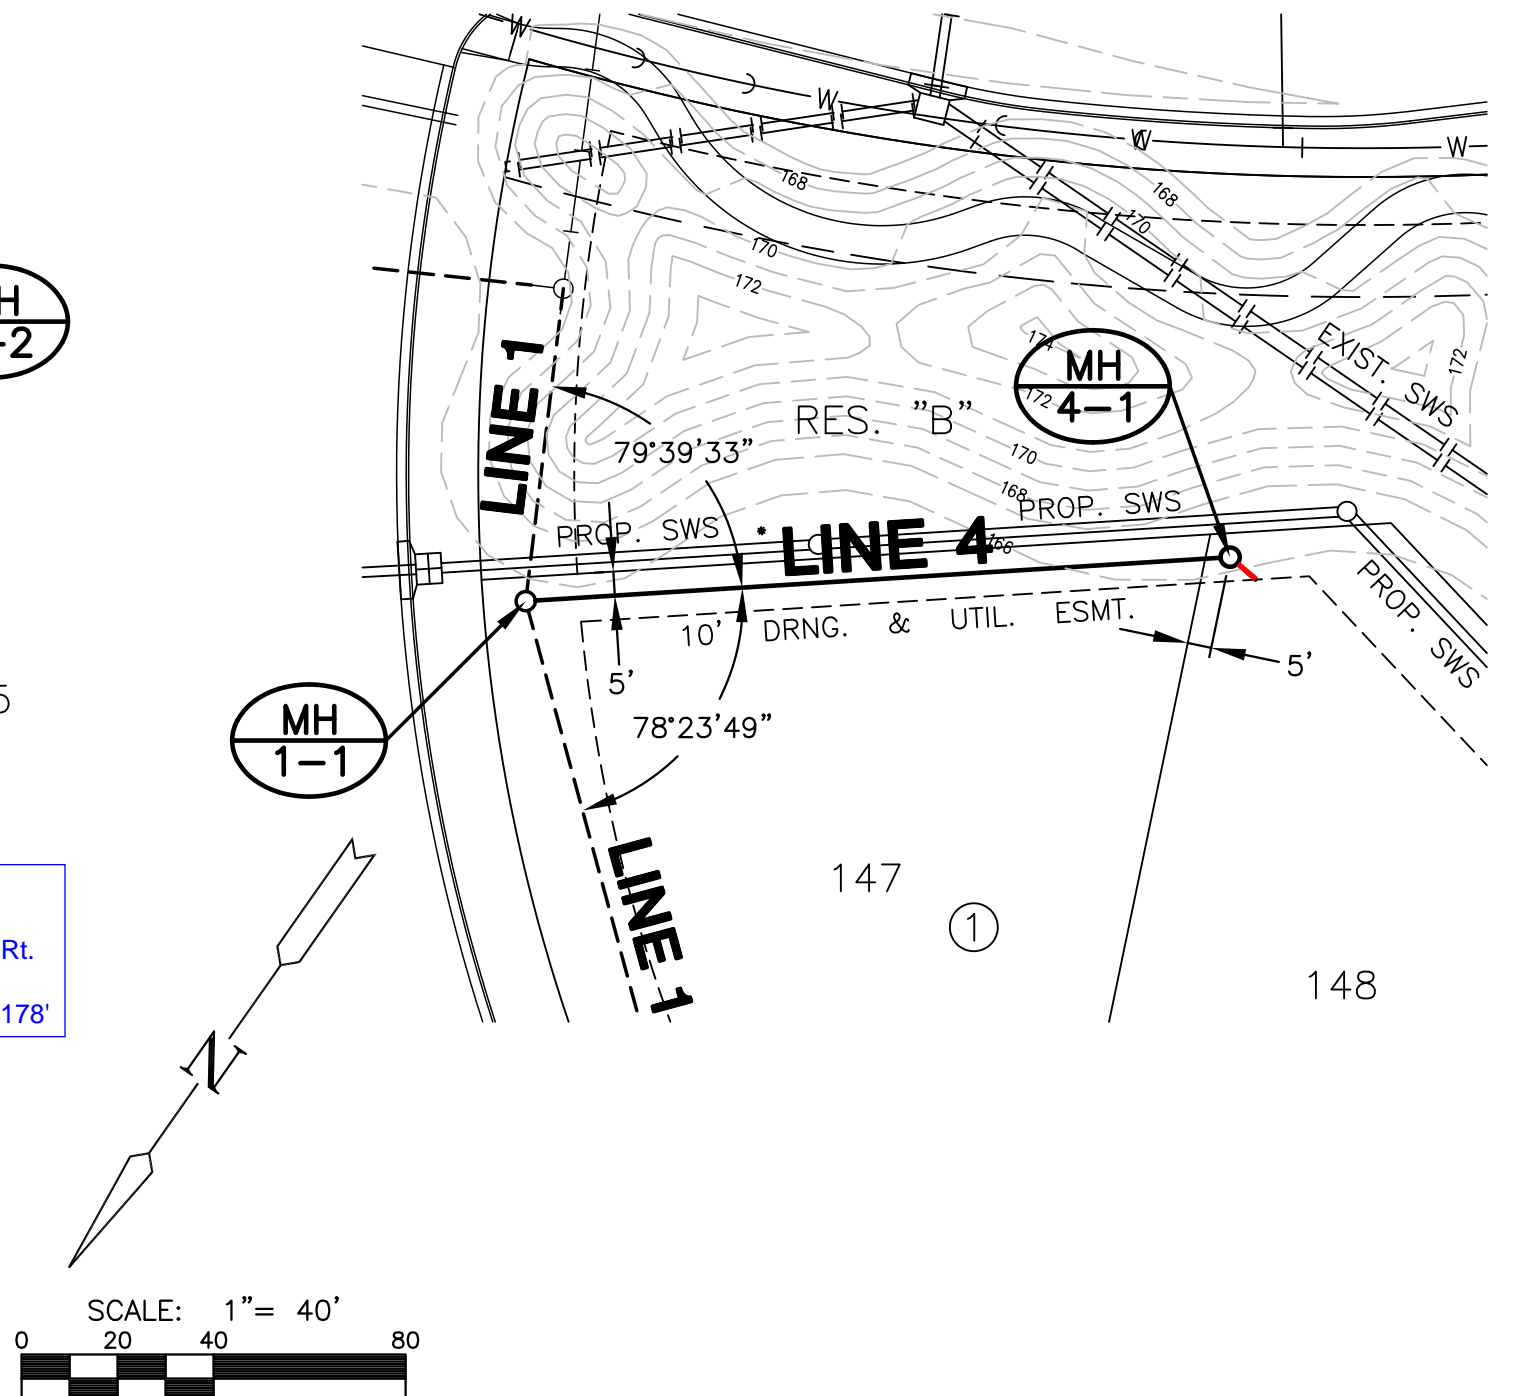

**SANITARY SEWER PLANS FOR  
FOX RIDGE ADDITION  
PHASE 11**

**LINES 3, 4, & 5**  
SHEET TITLE  
468-83647  
PROJECT NUMBER

DFL / JWC / GJA  
DESIGNED / DRAWN / CHECKED

ISSUED  
July 2011  
REVISED

SHEET NO.  
7 of 15