



SEE REVISED SHEET

**CAUTION EXISTING SPRINKLER SYSTEM!!!**  
CONTRACTOR TO VERIFY LOCATION OF EXISTING SPRINKLER SYSTEM PRIOR TO CONSTRUCTION & WORK AROUND/PROTECT AS NEEDED TO INSTALL SANITARY SEWER LINE. ANY DAMAGE DONE DURING CONSTRUCTION WILL BE REPAIR IN-LIKE-KIND AT NO ADDITIONAL COST TO PROJECT.

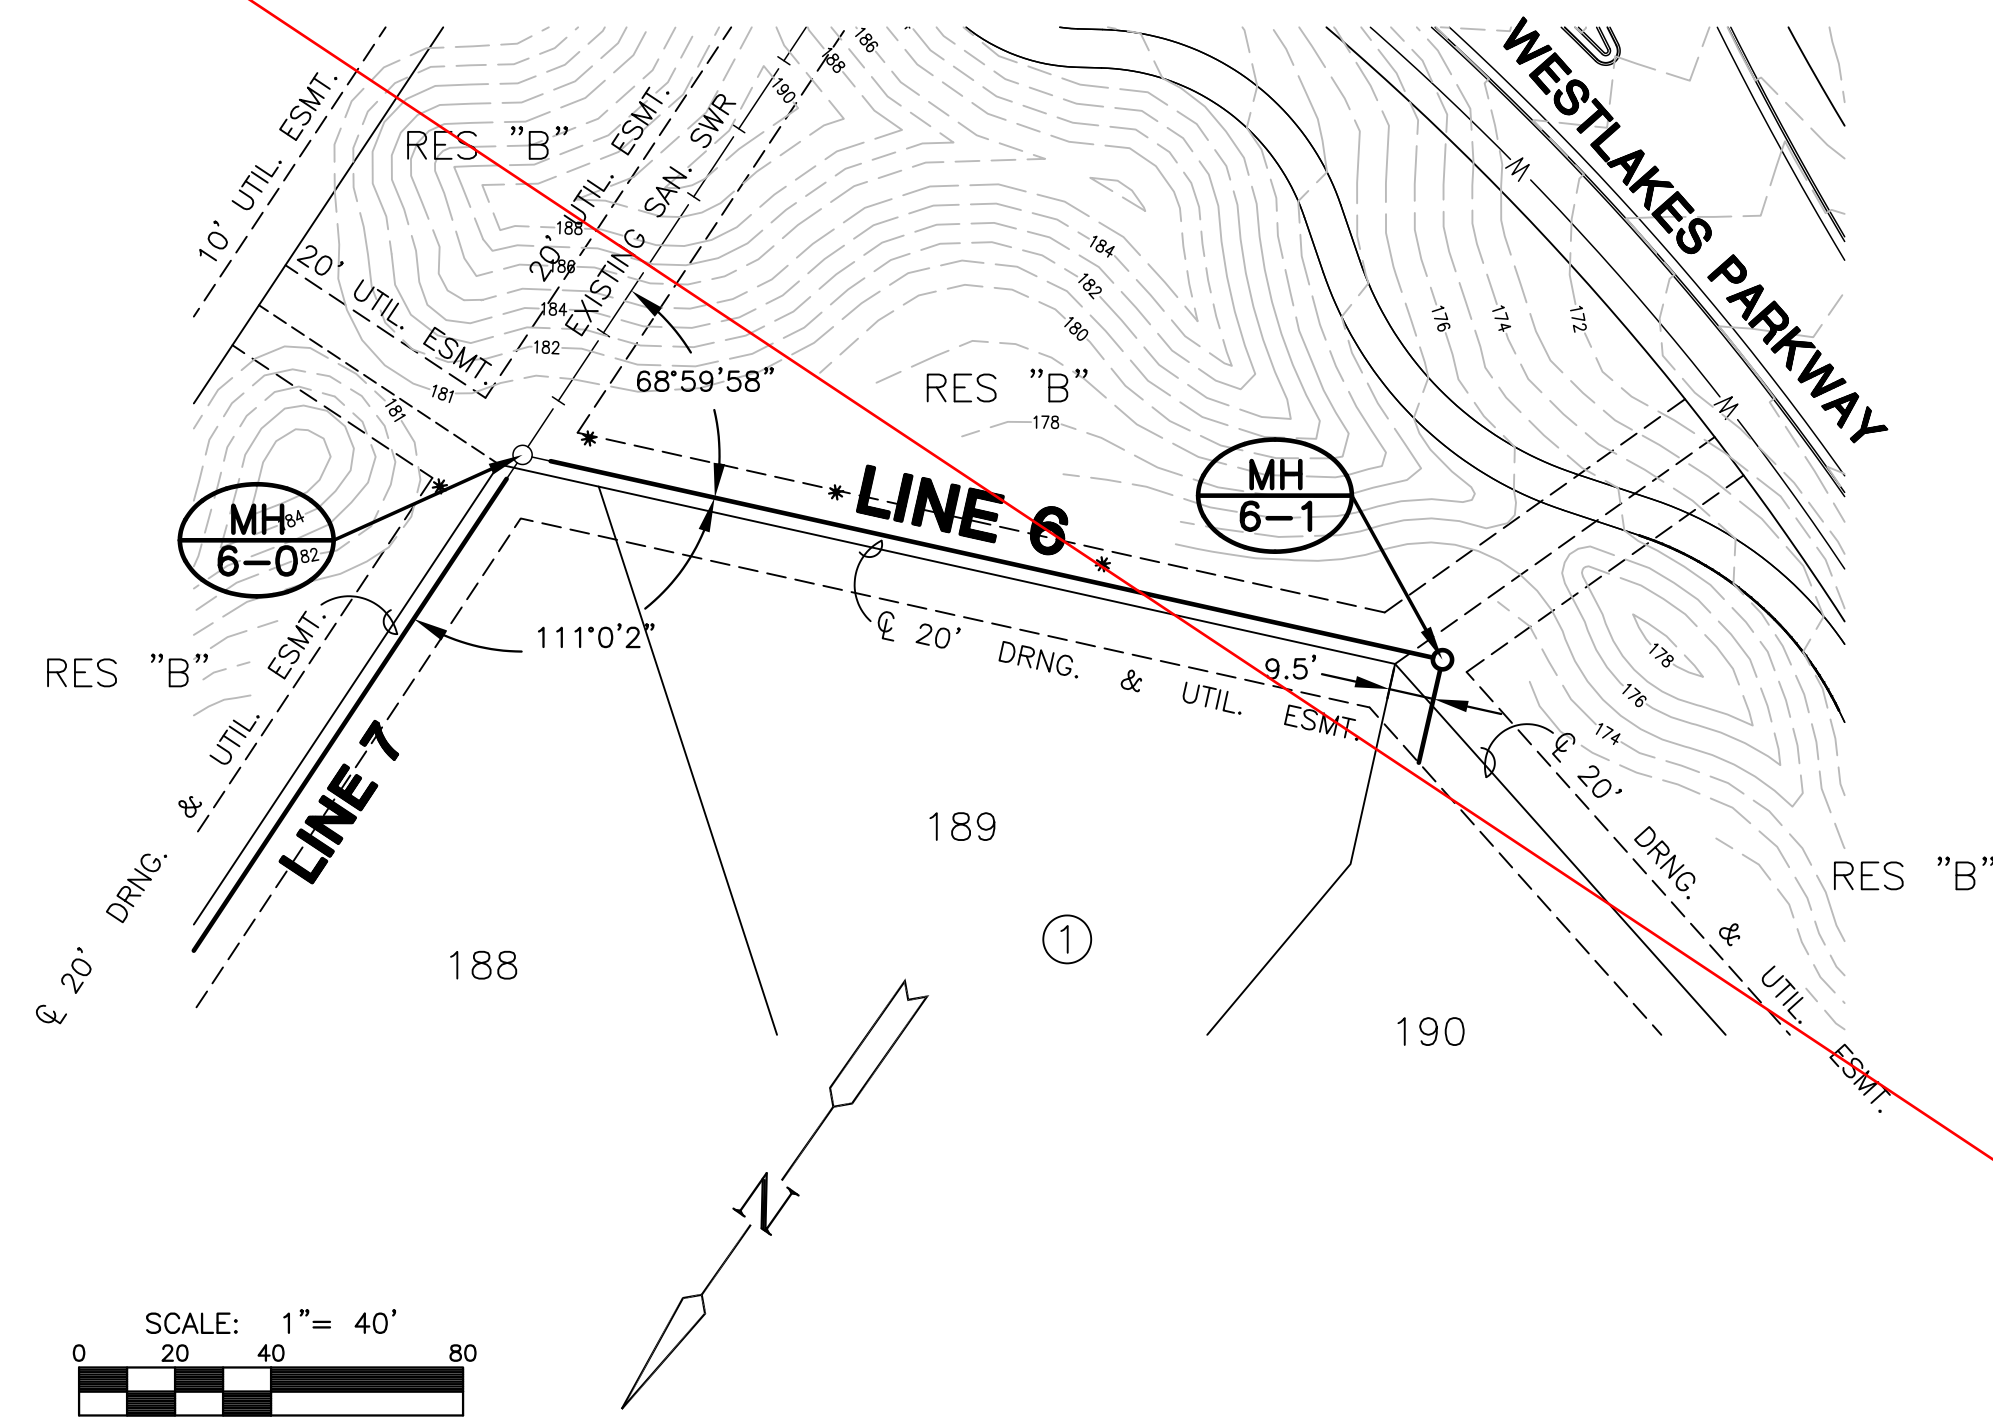

PLAN LINE 6

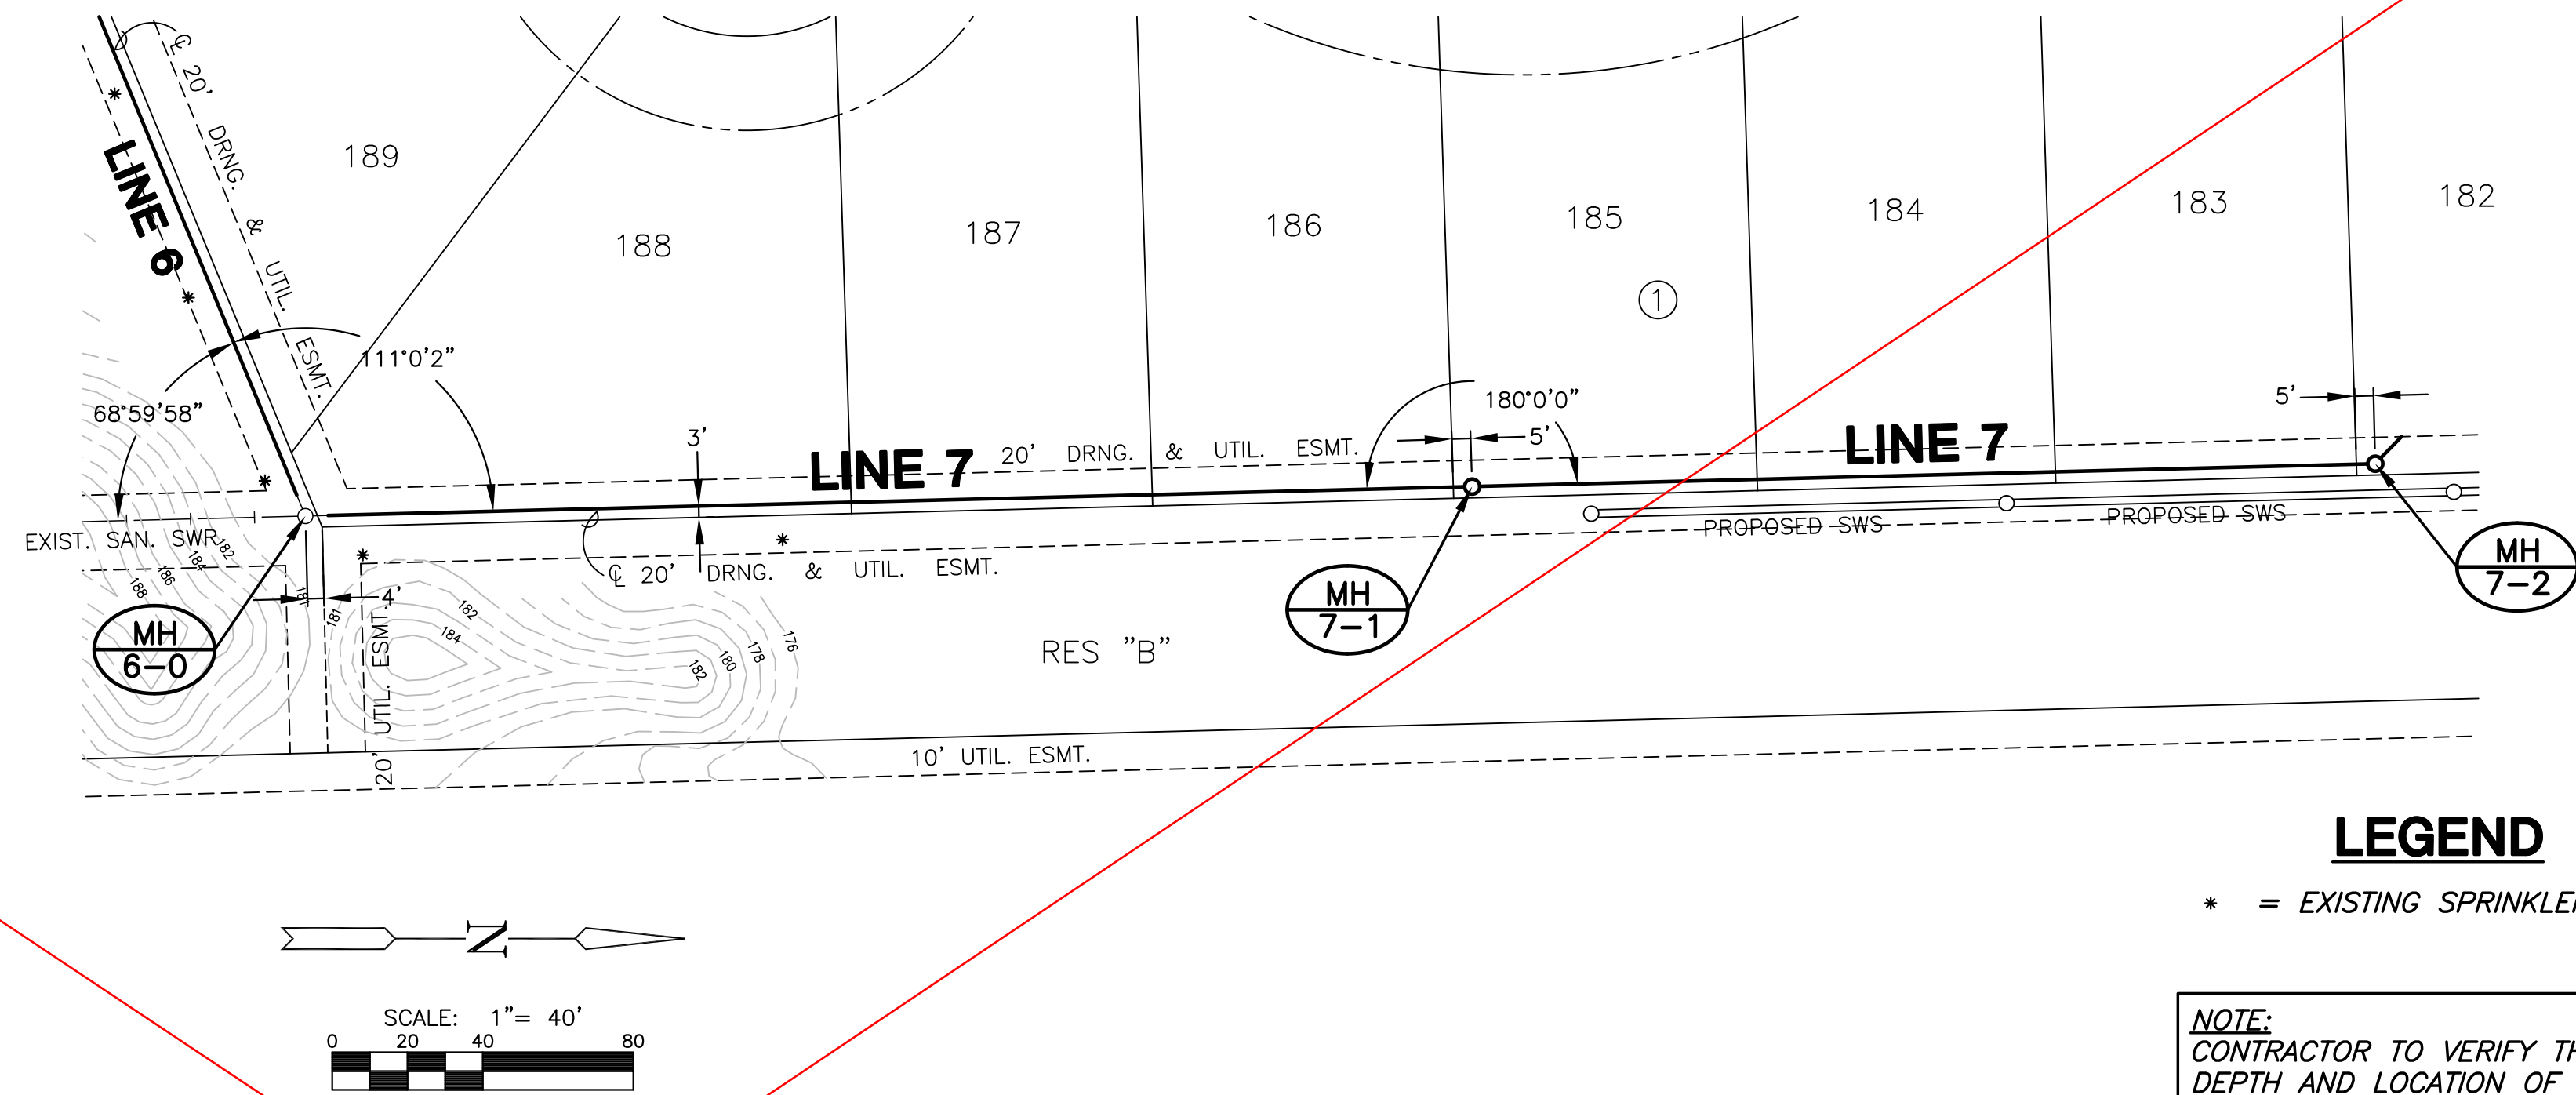


PLAN LINE 7

**LEGEND**

\* = EXISTING SPRINKLER HEAD

**NOTE:**  
CONTRACTOR TO VERIFY THE DEPTH AND LOCATION OF EXISTING UTILITIES PRIOR TO CONSTRUCTION.

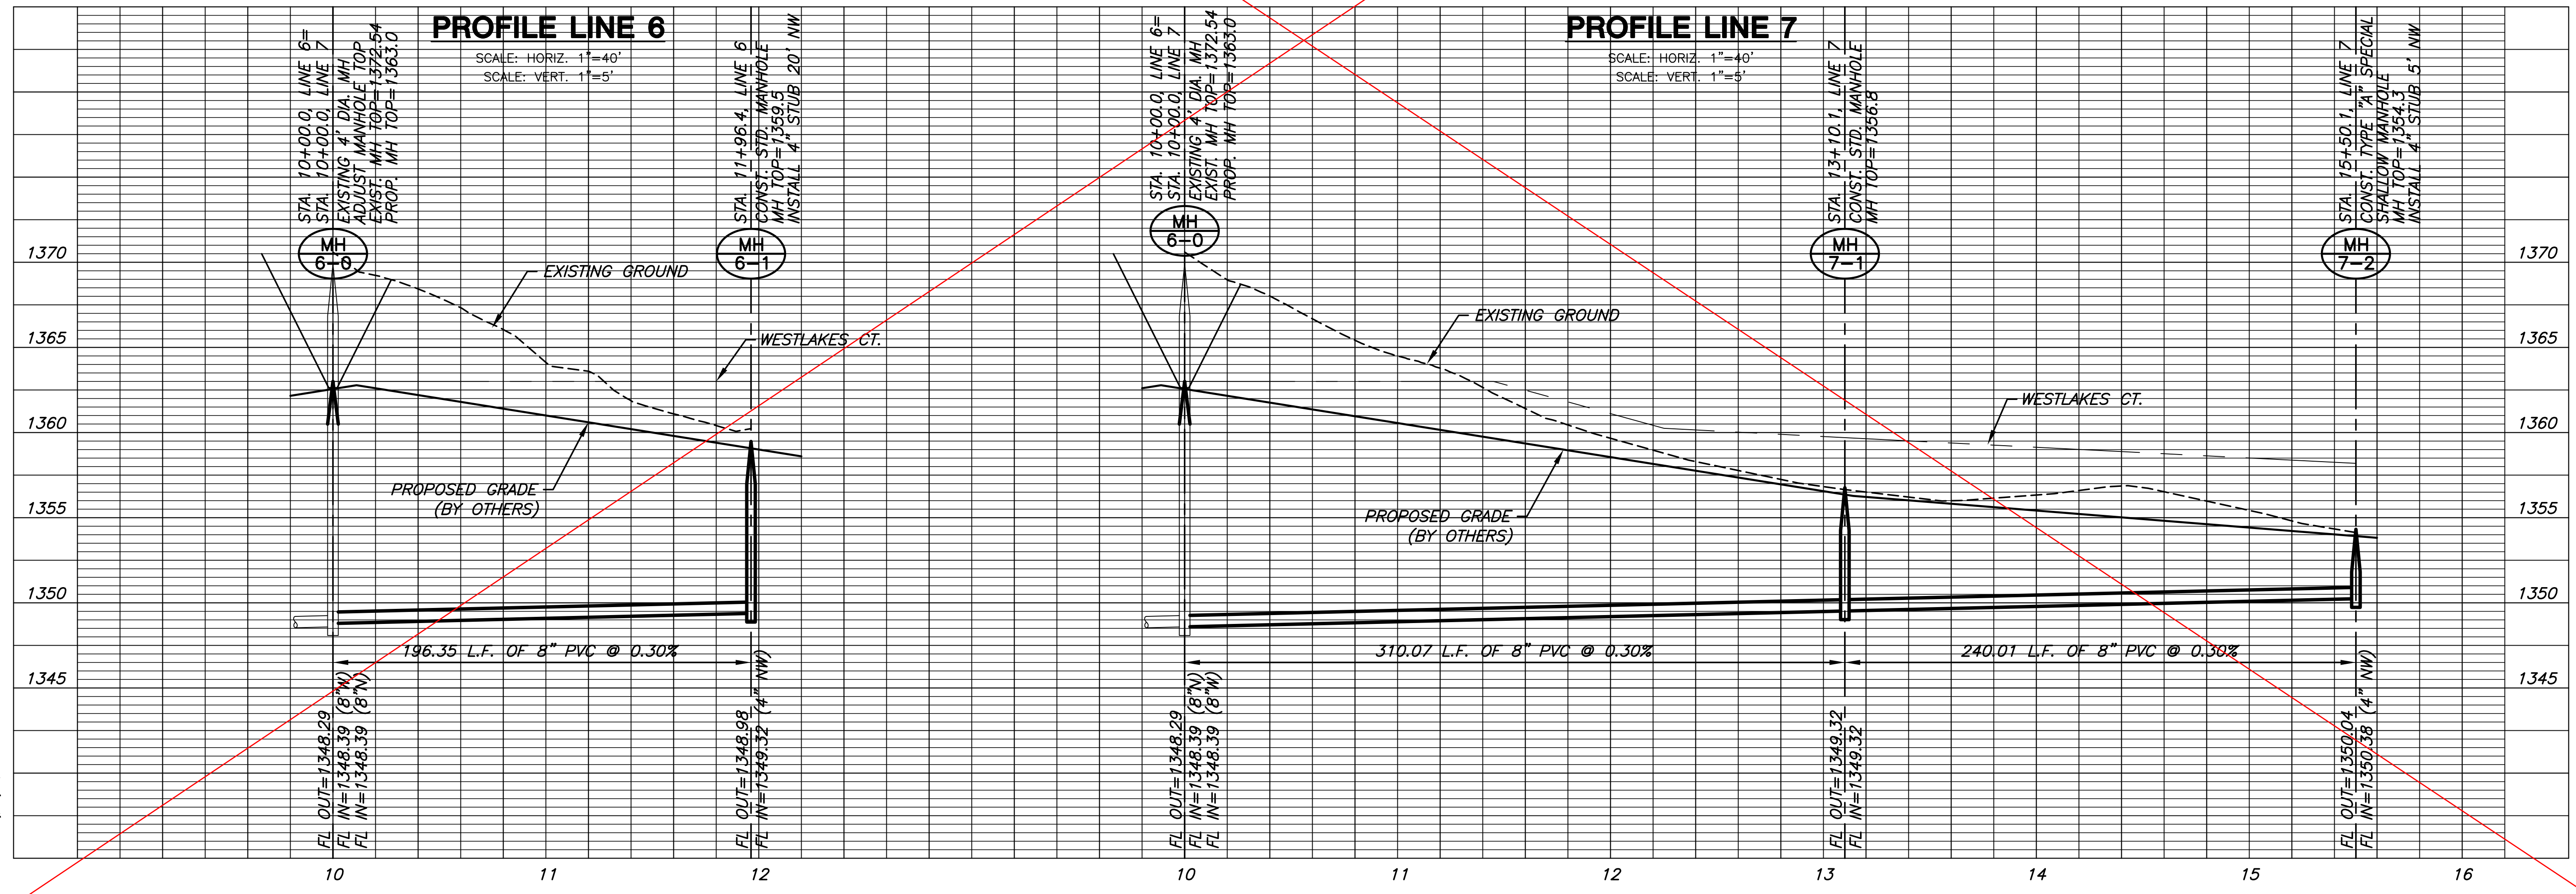

PROFILE LINE 6

PROFILE LINE 7

SANITARY SEWER PLANS FOR  
**FOX RIDGE ADDITION**  
PHASE 11

**LINES 6 & 7**  
SHEET TITLE  
468-83647  
PROJECT NUMBER

DFL / JWC / GJA  
DESIGNED / DRAWN / CHECKED

ISSUED July 2011  
REVISED

SHEET NO.  
8 of 15

PLOTTED: Wednesday, July 20, 2011 @ 11:21 AM

S:\CIVIL\99118\DWG\SAW\PH11\99118\_B4.DWG