

**SANITARY SEWER PLANS FOR
LATERAL 59, MAIN 24, WAR INDUSTRIES SEWER
TO SERVE REMINGTON PLACE ADDITION**

LINE 1
SHEET TITLE
1201010125
PROJECT NUMBER


SPE | BKS | BLB
DESIGNED | DRAWN | CHECKED

ISSUED
August 2012
REVISED


SHEET NO.
3 of 9

NOTE:
CONSTRUCTION ENTRANCE
LOCATION TO BE DETERMINED BY
INSPECTOR PRIOR TO
CONSTRUCTION ACTIVITIES.

NOTE:
CONTRACTOR TO VERIFY THE
DEPTH AND LOCATION OF EXISTING
UTILITIES PRIOR TO CONSTRUCTION.

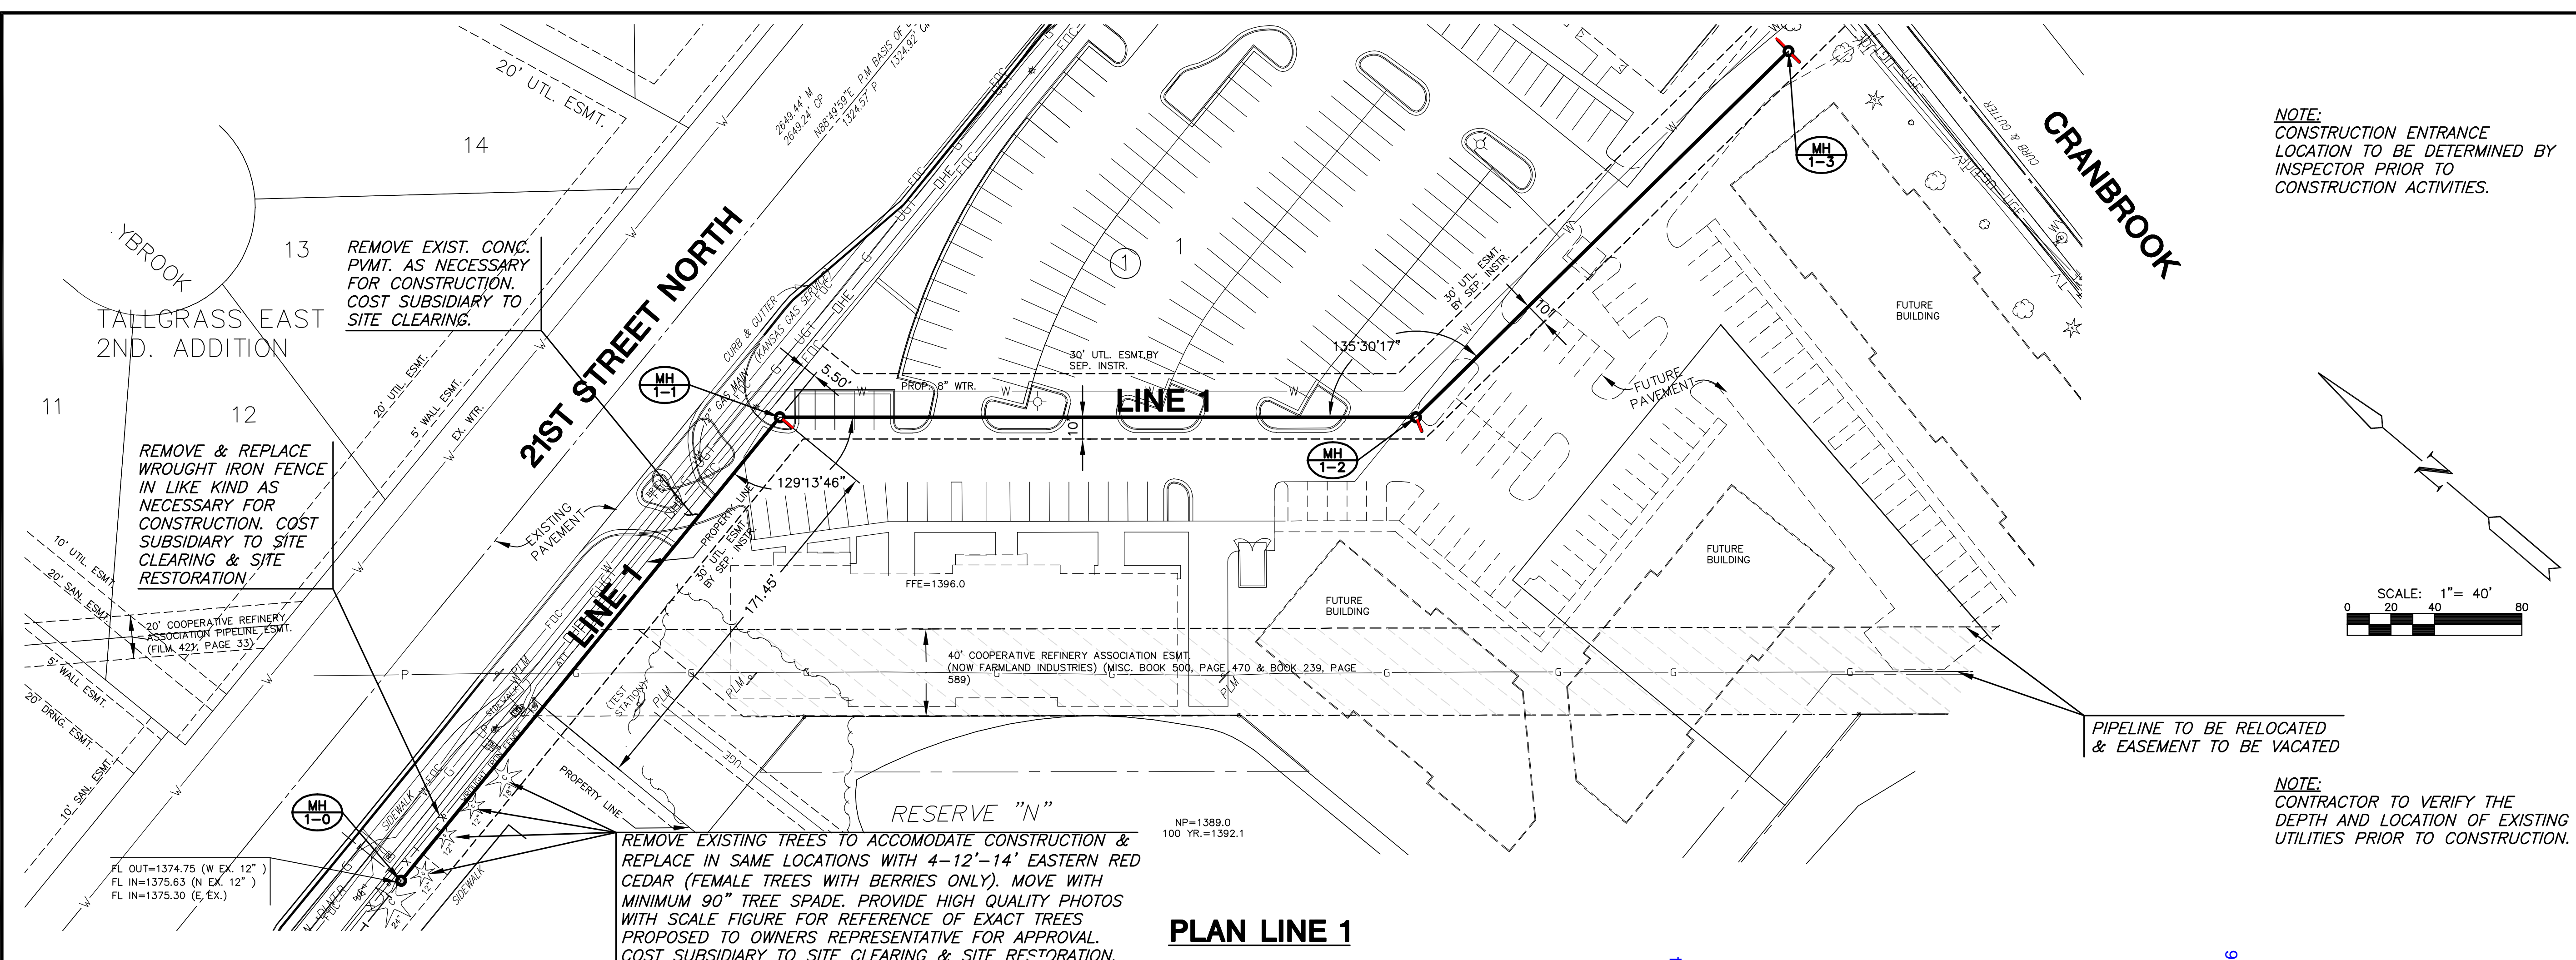

PLAN LINE 1

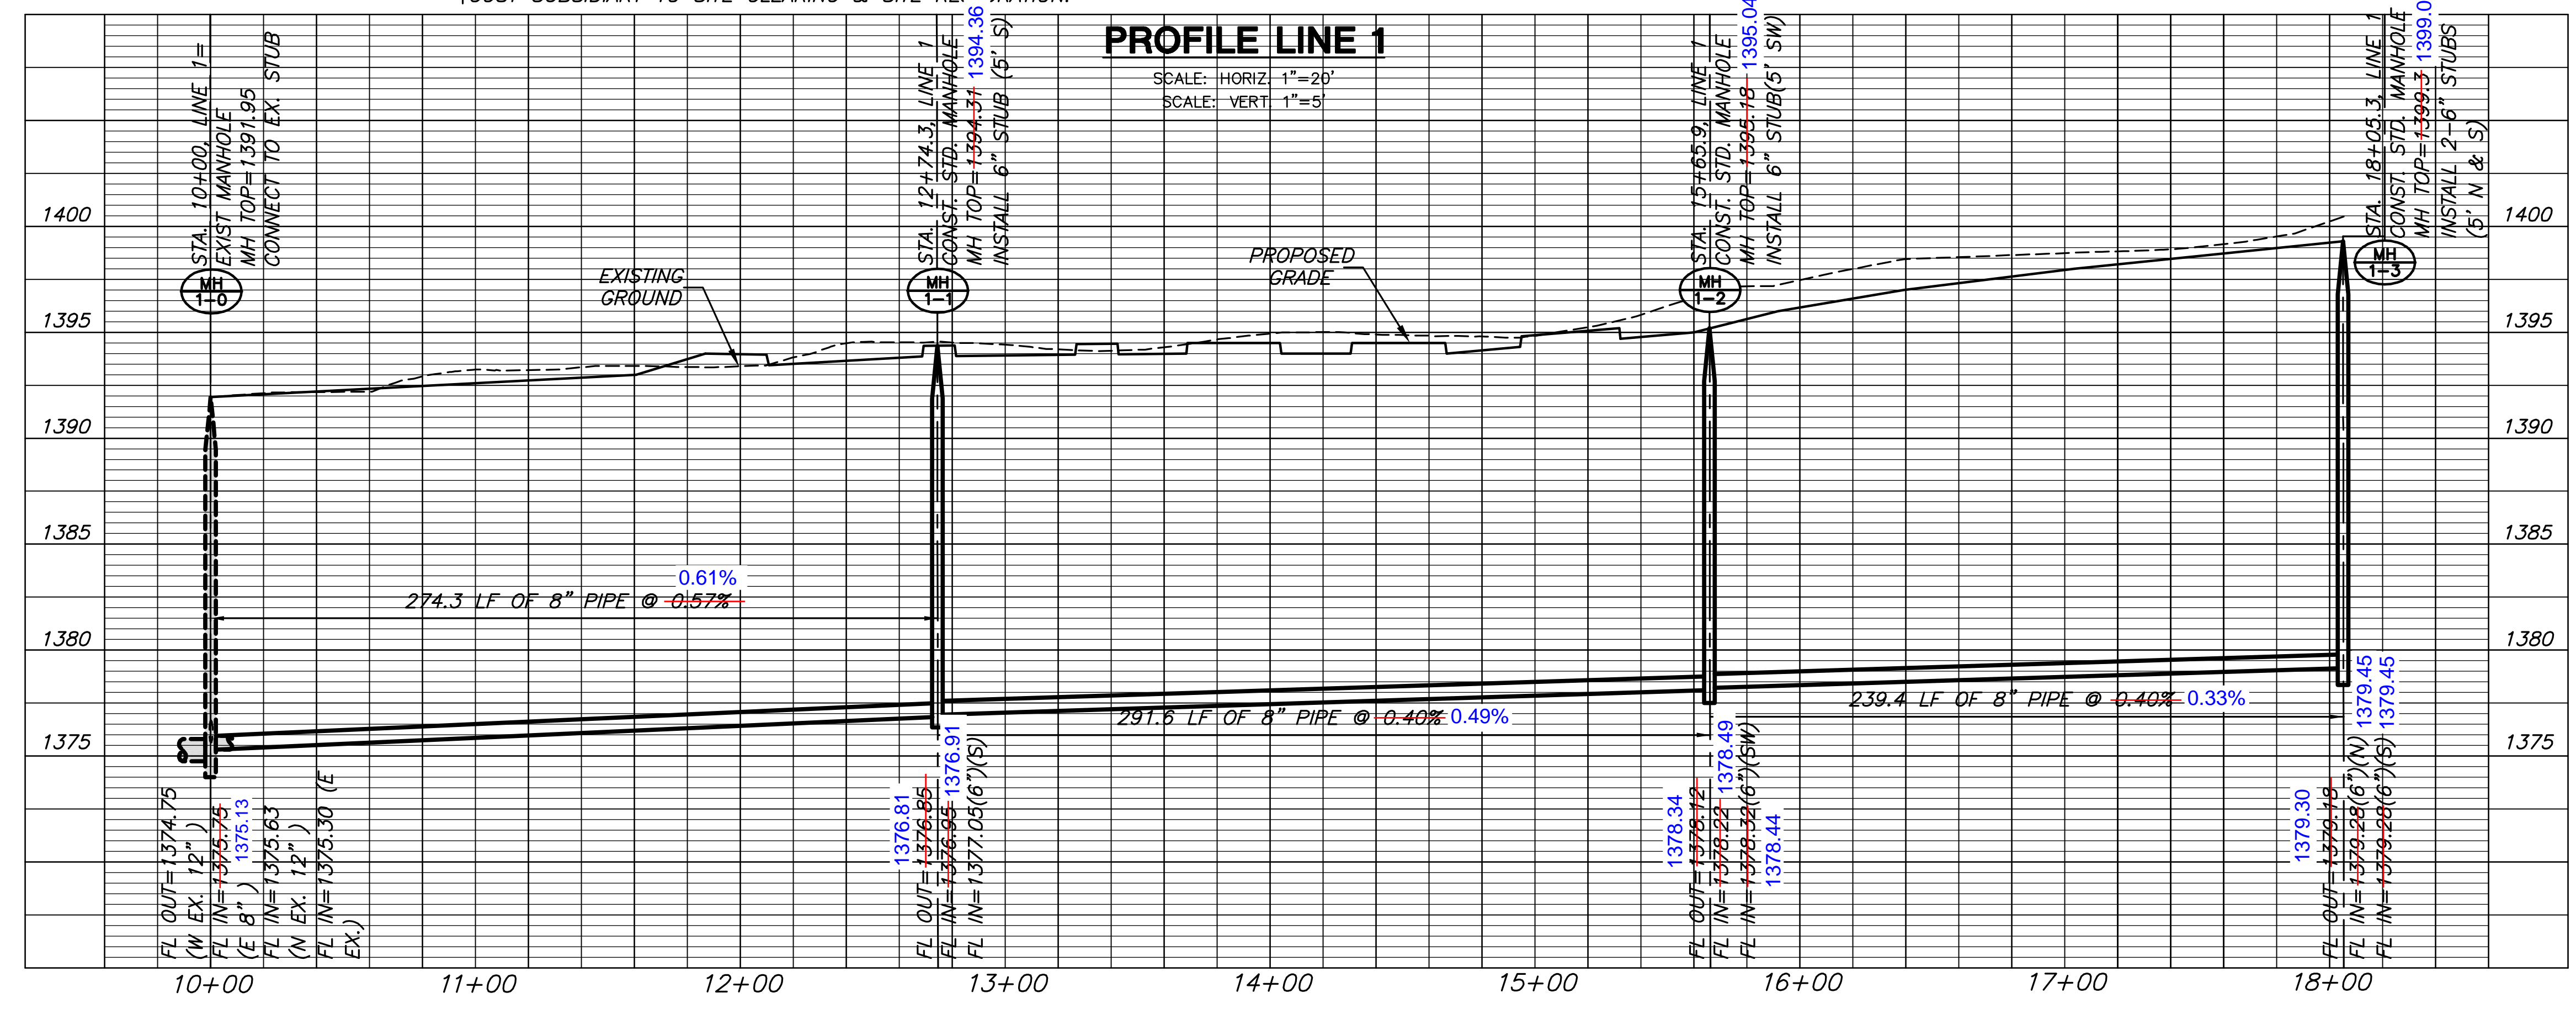

PROFILE LINE 1

PLOTED: Tuesday, August 07, 2012 @ 12:35PM

J:\PROJECTS\2012\1201010125_OCCIDENTAL_CRANBROOK\3-CIVIL\CAD\SAN\LINE_1_PP.DWG