


SANITARY SEWER MODIFICATIONS IN 1ST AND 2ND STREET - BETWEEN THE ALLEYS WEST AND EAST OF ST. FRANCIS AVENUE

CITY OF WICHITA PROJECT NO. 468-84776
OCA NO. 620576


CITY OF WICHITA, KANSAS
JAMES L. ARMOUR, P.E. - CITY ENGINEER

Cornejo/Dondlinger - Contractors
J. Westhoff - City of Wichita, Field Project Engineer
Z. Regnier - City of Wichita, Inspector
As-built
Released Date: 7/30/2012
pdf: APRosas 8/29/2012

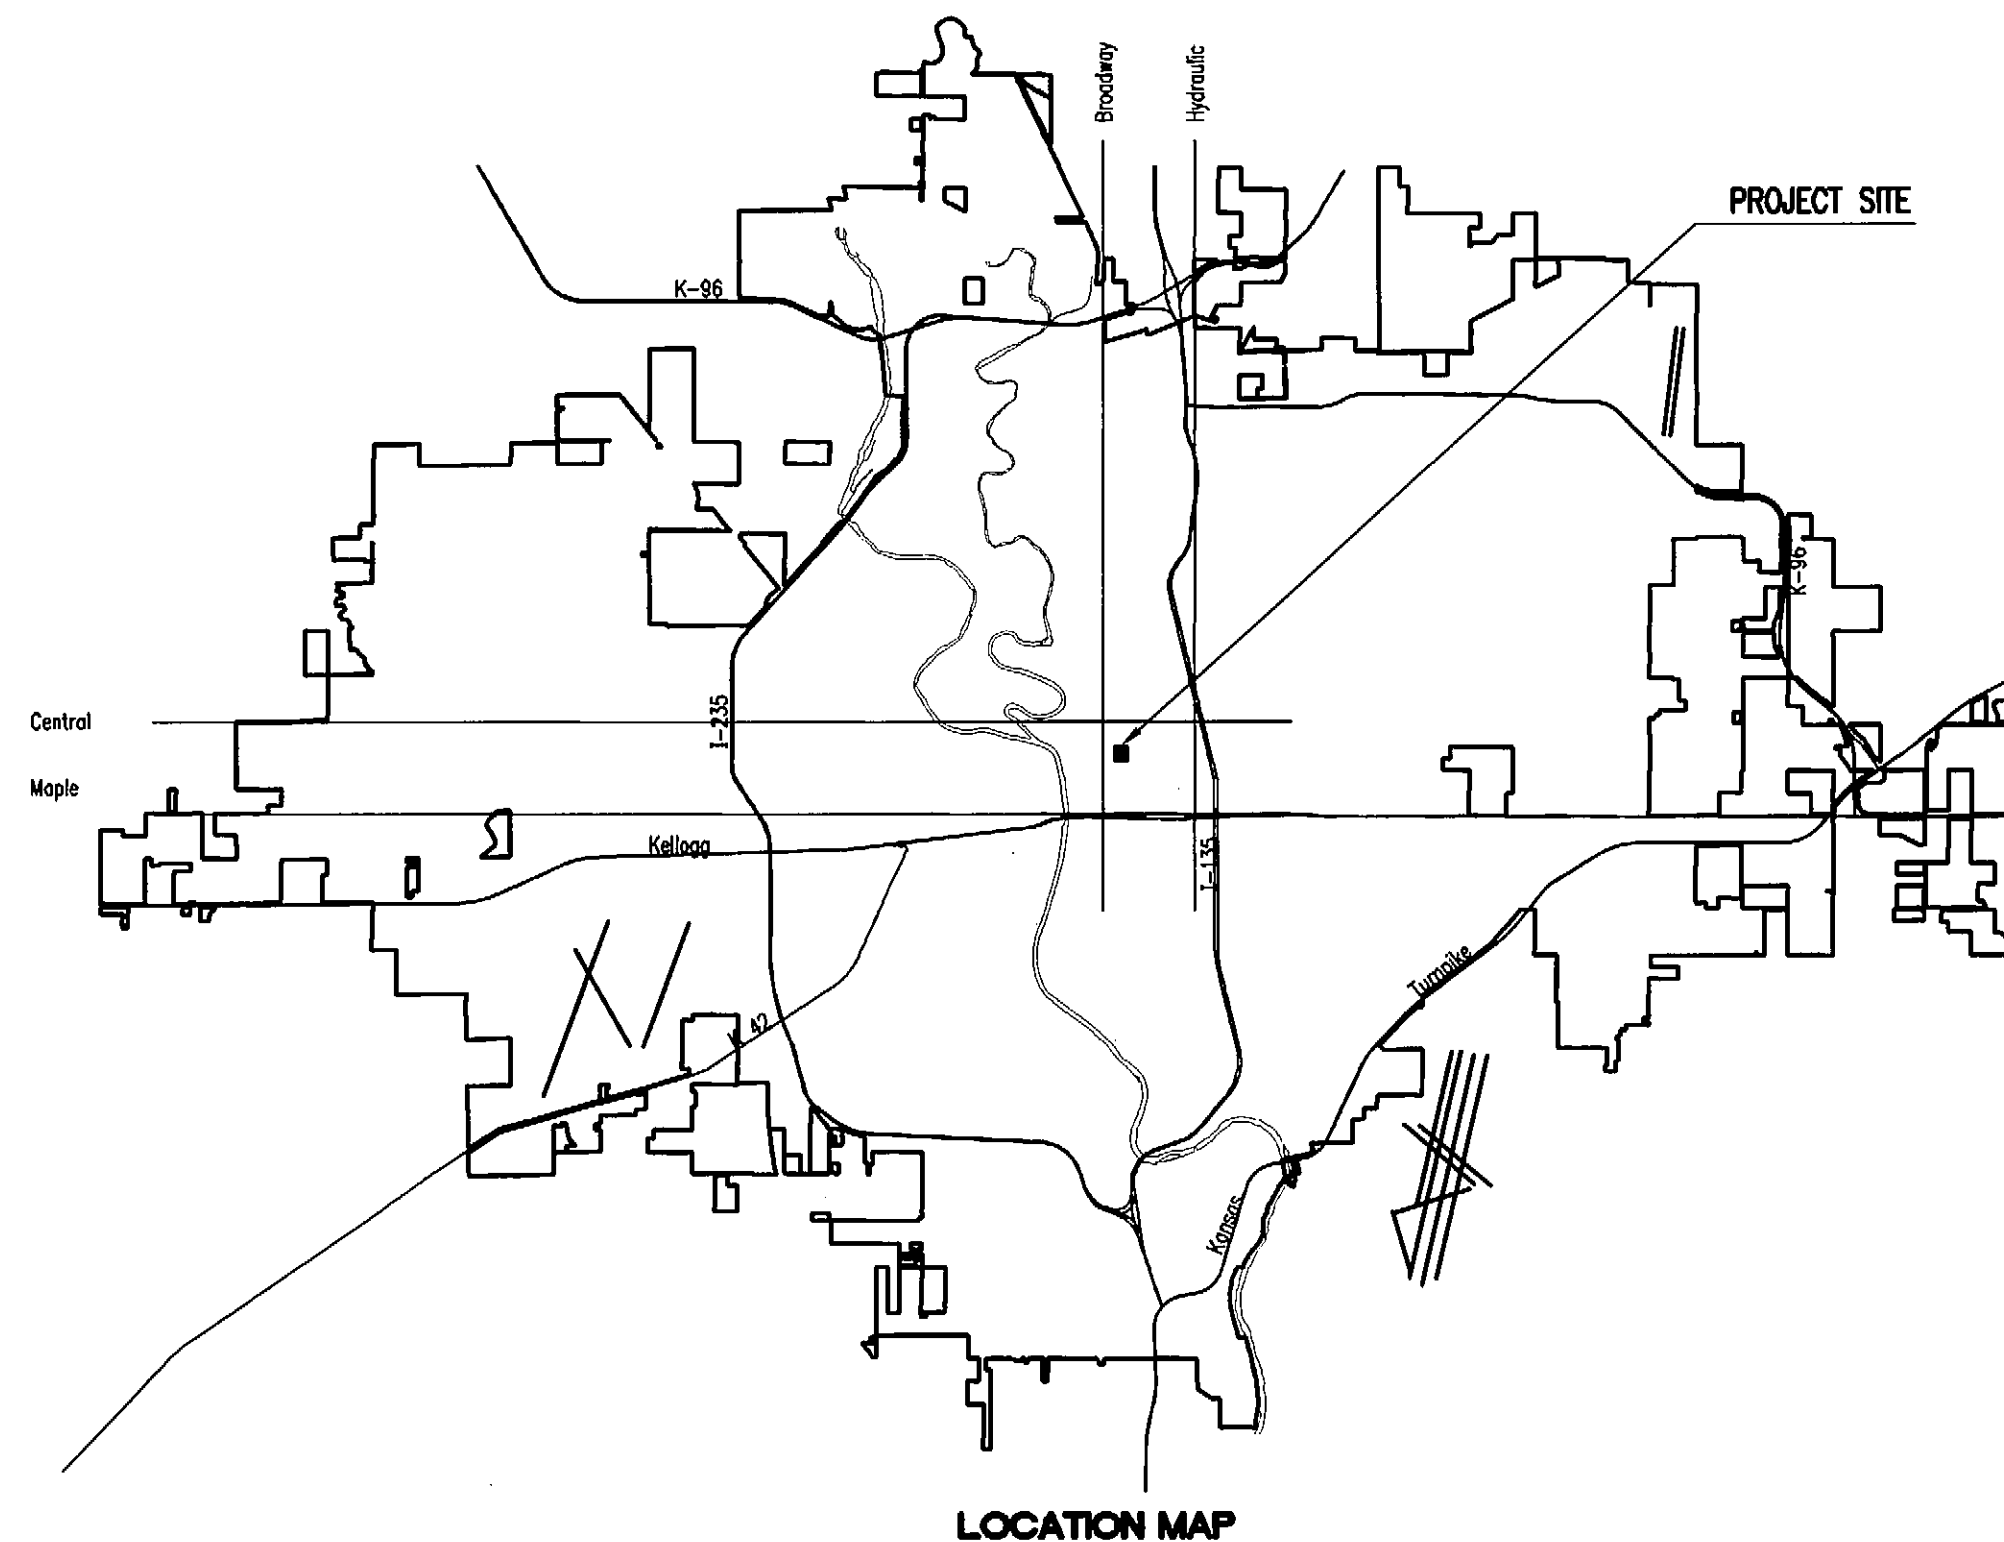

INDEX OF SHEETS

SHEET NO. SS1	TITLE SHEET
SHEET NO. SS2	KEY MAP AND GENERAL NOTES
SHEET NO. SS3-SS4	PLAN/PROFILE
SHEET NO. SS5	STANDARD TYPE 'P' MANHOLE DETAILS
SHEET NO. SS6	FRAME AND COVER DETAILS

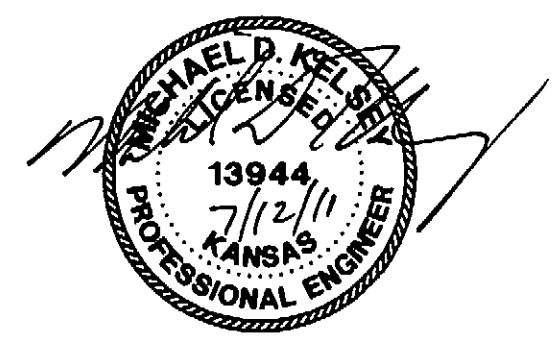

JULY 2011

PLANS PREPARED BY
PROFESSIONAL ENGINEERING CONSULTANTS, P.A.
ENGINEERS
WICHITA, KANSAS