

SITE 8

W BURTON AVE

W BURTON AVE

S ELIZABETH AVE

S FERN AVE

W MAPLE ST

443

431

006

497


495

394

391

003

001

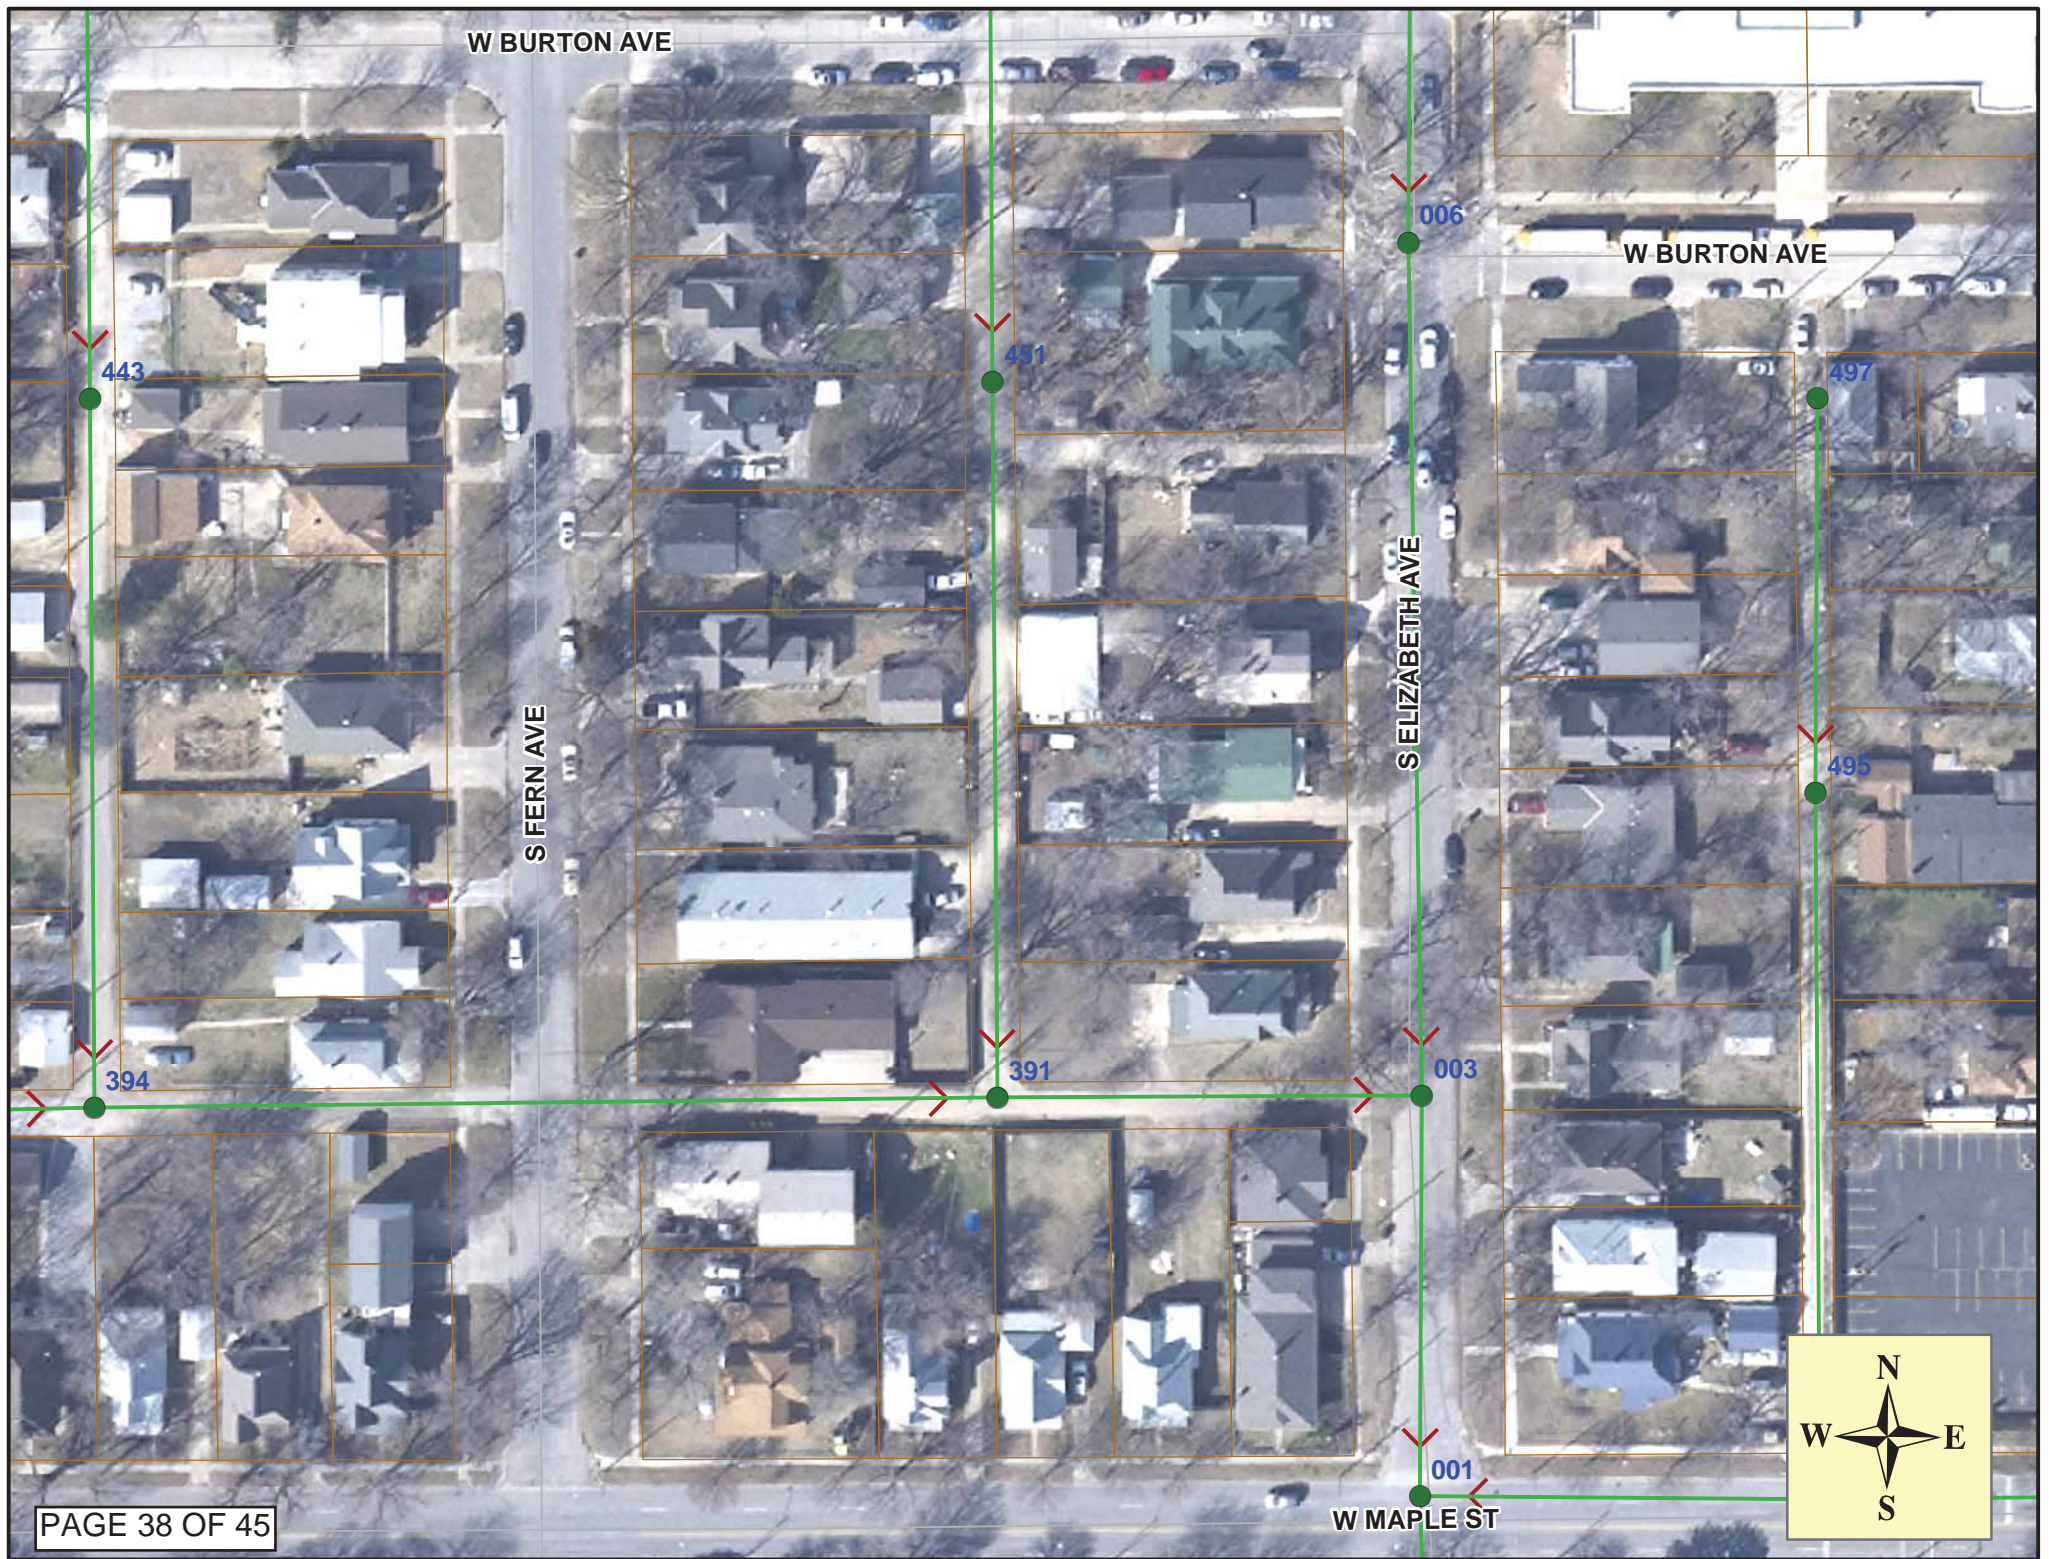

Video Inspection Master Report

9/27/2013

7:53 AM

US Structure: 5347-451 305 S ELIZABETH Date Insp: 7/1/2013 Basin: C07G
 DS Structure: 5347-391 236 S FERN AVE Dir Televised: Upstream To Downstream

Project No. : B-057 Dia: 8 Material: VCP Length: 303.3 DVD #0792 Overall Cond: Very Poor

Obs. VTR

#	Counter	Distance	Location	Description					
1		0.0	US Manhole		5347-451				
2		2.7	Break-In-Connection	Roots	2	0.004	2	4	0.004
3		3.0	Quad 2 / L-Rt	Crack-Horizontal	2	0.002	2	0	0.002
4		7.0	Wye Service	Roots	3	0.008	5	8	0.008
5		23.6	Quad 2 / L-Rt	Broken Pipe	5	0.060	100	0	0.060
6		25.9		Broken Pipe	4	0.030	78	0	0.030
7		29.6		Sealed Off Wye East	1	0.000	0	0	0.000
8		32.3		Sealed Off Wye West	1	0.000	0	0	0.000
9		50.0		Sealed Off Wye East	1	0.000	0	0	0.000
10		50.9		Crack-Radial	2	0.002	2	0	0.002
11		53.9	Lower Right	Broken Pipe	4	0.030	78	0	0.030
12		57.7	Wye Service	Roots	2	0.004	2	4	0.004
13		75.2	Wye Service		1	0.000	0	0	0.000
14		82.9	Wye Service		1	0.000	0	0	0.000
15		100.5		Sealed Off Wye East	1	0.000	0	0	0.000
16		105.5		Sealed Off Wye West	1	0.000	0	0	0.000
17		108.1	Wye Service		1	0.000	0	0	0.000
18		111.9		Crack-Radial	2	0.002	2	0	0.002
19		113.9		Crack-Horizontal	3	0.004	5	0	0.004
20		121.7		Crack-Radial	2	0.002	2	0	0.002
21		125.1			3	0.000	0	0	0.000
22		125.7	Wye Service		4	0.000	60	0	0.000
23		131.0		Sealed Off Wye West	1	0.000	0	0	0.000
24		136.9		Crack-Horizontal	2	0.002	2	0	0.002
25		155.3	Wye Service		1	0.000	0	0	0.000
26		156.8	Wye Service		1	0.000	0	0	0.000
27		160.6		Broken Pipe	2	0.008	44	0	0.008
28		175.5		Crack-Radial	2	0.002	2	0	0.002
29		178.6		Broken Pipe	3	0.010	60	0	0.010
30		179.6		Sealed Off Wye East	1	0.000	0	0	0.000
31		181.9		Sealed Off Wye East	1	0.000	0	0	0.000
32		183.4		Broken Pipe	4	0.030	78	0	0.030
33		199.6		OH	1	0.000	0	0	0.000
34		204.6	Wye Service		1	0.000	0	0	0.000
35		207.5		Sealed Off Wye West	1	0.000	0	0	0.000
36		216.3		Crack-Horizontal	2	0.002	2	0	0.002
37		230.2		Sealed Off Wye East	1	0.000	0	0	0.000
38		233.2	Wye Service		1	0.000	0	0	0.000
39		252.0		Crack-Radial	2	0.002	2	0	0.002
40		255.2		Crack-Horizontal	2	0.002	2	0	0.002
41		255.7		Sealed Off Wye East	3	0.003	0	0	0.003
42		258.2		Sealed Off Wye West	1	0.000	0	0	0.000
43		260.3		Broken Pipe	2	0.008	44	0	0.008
44		281.2	Wye Service		1	0.000	0	0	0.000
45		284.0		Sealed Off Wye West	1				
46		297.1		Broken Pipe	3				
47		299.8	DS Manhole 5347-391		1				

The video was lost in the download from the field laptop to the office. The recommendation from field was a #4 priority open cut. - LML