



Lateral 2, Main 8, Cowskin Interceptor Sewer Sanitary Sewer Improvements to serve **THE WOODS ADDITION - PHASE 3** CITY OF WICHITA, KANSAS

Gary Janzen, P.E. City Engineer
Project Number
468-84130
OCA Number
744410

Dutton Construction - Contractor
J. Brand - City of Wichita, Field Project Engineer
T. Dvorak - City of Wichita, Inspector
As-built
Stubs & Risers
Release Date: 07/20/2016
pdf: 07/20/2016 apr

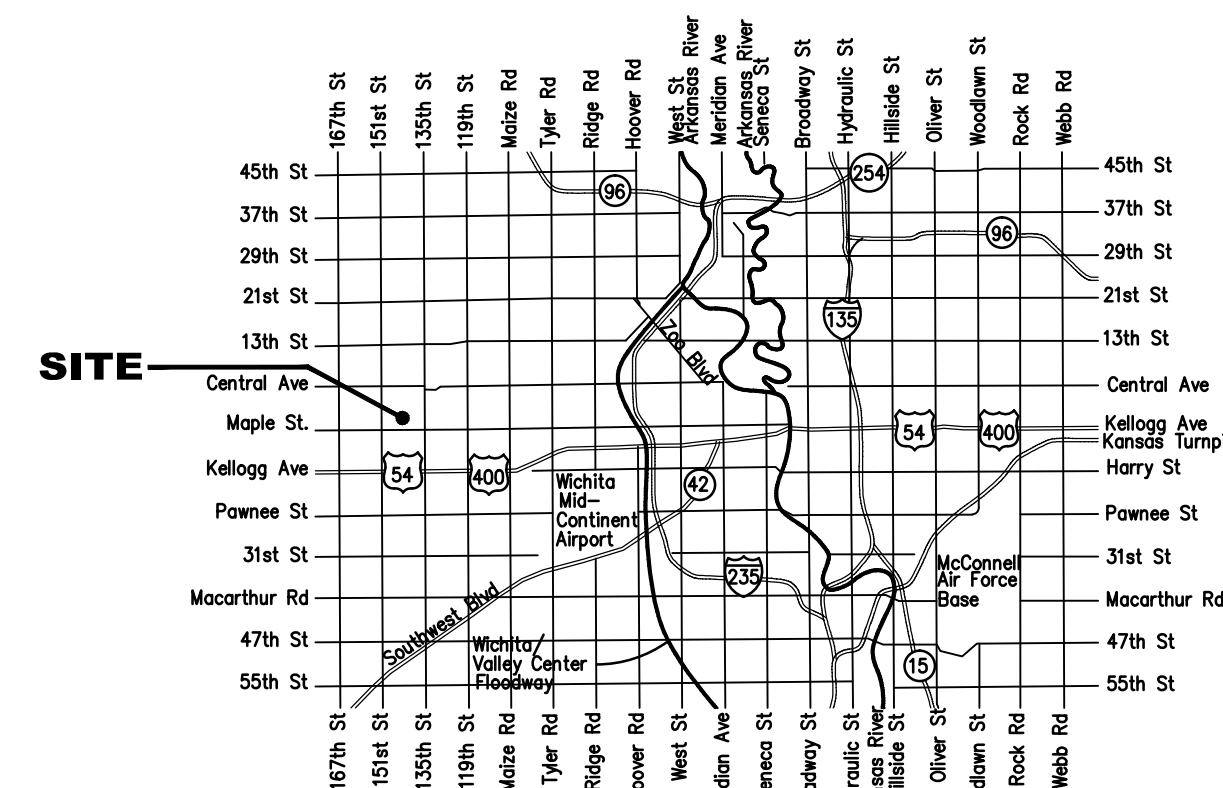

Vicinity Map

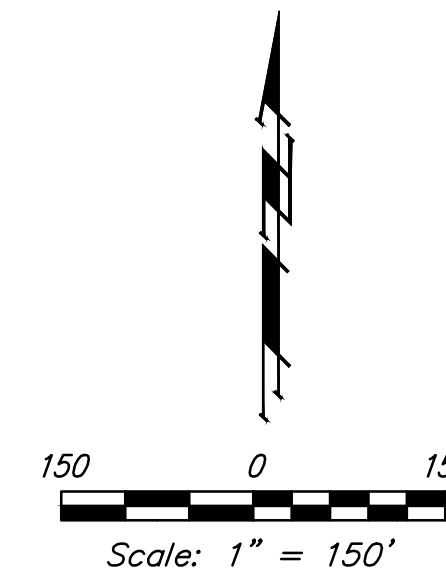

SHEET INDEX

Title Sheet	1
Line 1 & Line 2	2
Erosion Control Plan	3
Erosion Control BMP Details	4-8
Standard Manhole Detail	9
Ring & Cover Detail	10
Vertical Riser Detail	11
Coordinate Sheet	12
Copy of Plat	13

BENCHMARKS

BM #1 Square cut in top of curb adjacent to the SE corner of Lot 2, Block B, The Woods Addition
Elev. = 1381.25 NGVD29

BM #2 Square cut in top of curb NW end of median, Reserve "F"
The Woods Addition
Elev. = 1385.54 NGVD29

Pipeline Crossing Notes:

The Phillips 66 Pipeline, LLC contact is Gordon Stands at 316-821-2254.
The KPC Pipeline, LLC contact is Robert Clover at 913-522-7501.

- Contact both pipeline companies a minimum of two weeks prior to construction.
- Prior to any construction or vehicles/equipment crossing the pipeline, an on-site safety meeting with Phillips 66 Pipeline and KPC Pipeline will be required.
- At the meeting, crossing locations and requirements will be reviewed but general requirements are 5' of cover for temporary dirt crossings.
- The only vehicle/equipment crossing of the pipeline easement shall be at locations approved by the pipeline representatives.
- Contact pipeline representatives any time construction will occur within the pipeline easement.
- The orange safety fence shall be installed prior to any on-site construction. Remove and Replace immediately as necessary for construction.
- During pavement construction, pipeline cover will be reduced to minimal depths. A 12,000 lb. maximum weight for loaded equipment will be required during construction within the pipeline easement until final lift of asphalt is constructed.
- No vibratory equipment shall be used within pipeline easement.

- ## GENERAL NOTES:
- Contractor will be required to provide notice to utility companies a minimum of forty-eight (48) hours prior to any excavation, as follows:

Kansas One-Call 687-2470

The Contractor must notify the following in case of an emergency:

Cox Communications 262-4270
Kansas Gas Service 1-888-482-4950
Westar Energy 383-8650
Aquila Energy 1-800-303-0357
AT&T 268-2245
City of Wichita Water Dept. 268-4563
City of Wichita Sewer Maint. 268-4024
City of Wichita Storm Sewer Maint. 268-4090
City of Wichita Traffic Maint. 268-4034
Conoco Phillips Pipeline Co. 1-877-267-2290
Southern Star Pipeline Co. 529-6600
Kinder-Morgan Pipeline Co. 1-888-844-5658
 - Utility service lines, poles, valve boxes, meters, and etcetera are to be adjusted as necessary by others prior to construction unless the plans specifically call for their adjustment by the Contractor or unless the plans specifically identify a utility to be adjusted by its owner during construction. Existing utilities and their location, as shown on the plans, represent the best information obtainable for design. The Contractor will be required to work around existing utilities within the right-of-way which do not conflict with proposed construction.
 - Rubble from the removal of miscellaneous structures and excess excavation which is to be wasted shall be disposed of on sites to be provided by the Contractor. These sites shall be approved by the Engineer as to suitability, appearance and site location. Locations, in the opinion of the Engineer, that will leave an unsightly appearance will not be approved. All disposal sites must be approved by the Kansas Department of Health and Environment. Material either stockpiled or disposed of in a flood plain would require a Kansas State Board of Agriculture permit. Any material dumped in waters of the United States or wetlands is subject to U.S. Corps. of Engineers permitting regulations. Any material buried or stockpiled beyond approved construction limits would require additional archaeological investigations unless buried in a previously approved borrow location.
 - Trees and shrubs in public right-of-way which are in direct conflict with proposed new construction shall be removed by the Contractor with the Engineer's approval. Trees and shrubs which are not in direct conflict with proposed new construction shall be saved and protected from damage.
 - The Contractor shall give all property owners and/or tenants of developed property abutting the construction of this project a minimum of ten (10) days notice prior to start of construction.
 - The Contractor shall be responsible for preserving property irons. The Contractor will be required to re-establish any property irons which are damaged or destroyed by his construction operations. Such irons shall be re-established by a licensed land surveyor in accordance with state laws.
 - All existing and proposed erosion control measures including silt fencing, erosion control mat, straw bales, inlet barriers, and const. entrance shall be maintained throughout construction by the contractor and until project is accepted by the City of Wichita. The on-site engineer shall complete weekly reports on the status of erosion control measures. The contractor shall be required to comply with maintenance and/or replacement of erosion control measures as determined by the on-site engineer until project is accepted by City of Wichita. Maintenance and/or replacement of erosion control measures to be paid by L.S. bid item "Maintain Existing BMP's."
 - All excess excavation shall remain on-site and shall be stockpiled or spread at a location determined by the engineer.
 - The Contractor shall be responsible for maintaining continuous flow of sewage through construction. Contractor's proposed method for maintaining sewage flow shall be approved by the Engineer. Cost of maintaining flow of sewage through construction will not be paid for directly and this cost shall be considered as subsidiary to the other pay items of work.


All other areas disturbed by construction shall be seeded as follows: (Temporary Seeding):

Seed: Rye grass (PLS)--8 lbs./1000 Sq. Ft.

All costs associated with seeding shall be included in bid item "Seeding". All seeding operations shall conform to City of Wichita Standard Specifications.
 - The Developer for this project is Jay Russell and may be reached at (316) 722-2417.



BENEFIT DISTRICT

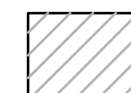

Baughman Company, P.A. 315 Ellis St. Wichita, KS 67211 P 316-262-7271 F 316-262-0148
ENGINEERING | SURVEYING | PLANNING | LANDSCAPE ARCHITECTURE