


DSNR: BER OPER: ILS SCALE: 1=1.00
Q: \2002\02662\000\29-5TYP 03-03-2003 04:32:19 pm

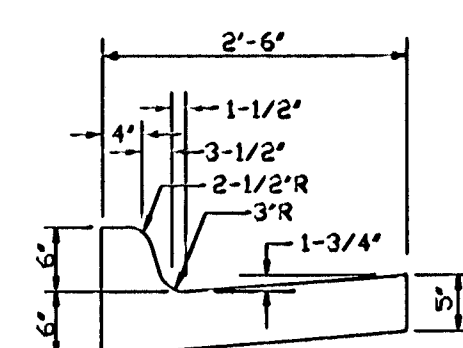

Technical drawing of a mechanical part with dimensions: 2'-6", 5", 2"R, 3"R, 6-5/8", 8", 1 1/2", and a Slope indicator.

Figure 1: Dimensions of the test specimen. The diagram shows a cross-section of a specimen with a total width of 12 inches and a total height of 2 inches. The top surface is composed of two segments: a horizontal segment of 11 7/16 inches and a sloped segment with a slope of 3/8 inches per foot. The sloped segment starts at a height of 1 1/2 inches from the bottom and ends at a height of 2 inches. The horizontal distance of the sloped segment is 9 1/16 inches. The bottom surface is horizontal and 12 inches wide. The thickness of the specimen is denoted as 't'.

	DISTANCE FROM CENTERLINE (LT. & RT.)										
	0'	2'	4'	6'	7'	8'	10'	12'	14'	14.5'	15.5'
A: Top of Curbs to Top of Surface Lift	0.13	0.18	0.24	0.30	0.33	0.36	0.43	0.49	—	—	—
B: Top of Curbs to Top of Upper Base Lift	0.30	0.35	0.41	0.47	0.50	0.53	0.60	0.66	—	—	—
C: Top of Curbs to Top of C.B. Subgrade	0.55	0.60	0.68	0.72	0.75	0.78	0.85	0.91	0.97	0.98	1.00

ROCK QUALITY SHALL CONFORM TO THE REQUIREMENTS SPECIFIED BY THE KDOT 1990 EDITION STANDARD SPECIFICATION SUBSECTION 1102 FOR DURABILITY CLASS I



Transverse construction joints shall be constructed in flexible base pavements at locations where pavement joints existing flexible base pavement as shown by the detail. All costs associated with the construction of the transverse joint shall be included in the bid price for Square Yards 5" ASPHALTIC CONCRETE (3" BITUMINOUS BASE).

FABRIC BASE REINFORCEMENT SHALL BE B X 1100 GEOGRID AS MANUFACTURED BY TENSAR CORPORATION OR APPROVED EQUAL. FABRIC BASE REINFORCEMENT SHALL BE INSTALLED IN ACCORDANCE WITH MANUFACTURER'S RECOMMENDATIONS.

ROCK BASE IS TO BE COMPACTED AND SMOOTHED WITH A STEEL FACED ROLLER PRIOR TO PLACEMENT OF ASPHALT. TACK COAT WILL NOT BE APPLIED TO ROCK BASE.

A TACK COAT OF EMULSIFIED ASPHALT (SC-1H OR CSS-1H) SHALL BE APPLIED AT AN APPROXIMATE RATE OF 0.05 GALLONS PER SQUARE YARD BETWEEN EACH LIFT OF ASPHALTIC MATERIAL.

BITUMINOUS BASE AND ASPHALTIC CONCRETE WEARING SURFACE SHALL BE PLACED WITH A LAYDOWN MACHINE HAVING AUTOMATIC CONTROLS FOR LINE AND GRADE.

CONSTRUCTION JOINTS IN EACH LIFT SHALL BE STAGGERED A MINIMUM DISTANCE OF ONE (1) FOOT FROM JOINTS IN PRECEDING LIFTS AND PLACED SO THAT A JOINT WILL BE CONSTRUCTED ON THE CENTERLINE OF THE TOP LIFT.

THE ASPHALTIC CONCRETE PAVEMENT BETWEEN THE
COMBINED CURB AND GUTTER SHALL BE PAID AS SQUARE
YARDS OF 5" ASPHALTIC CONCRETE (3" BITUMINOUS BASE.)

B. A. E. L. 24 NOV 03
RECORD DRAWING