


DSMR: BER OPER: ILS SCALE: 1"=20.00
Q:\2002\02662\000\LINDBERG 03-04-2003 11:14:38 am

WATER VALVE BOX ELEVATIONS			
STREET	STATION	OFFSET	EXISTING ELEVATION
LINDBERG	56+08.00	23.50' Lt.	208.8
LINDBERG	56+33.00	23.50' Lt.	208.7


SCALE: 1"=20'

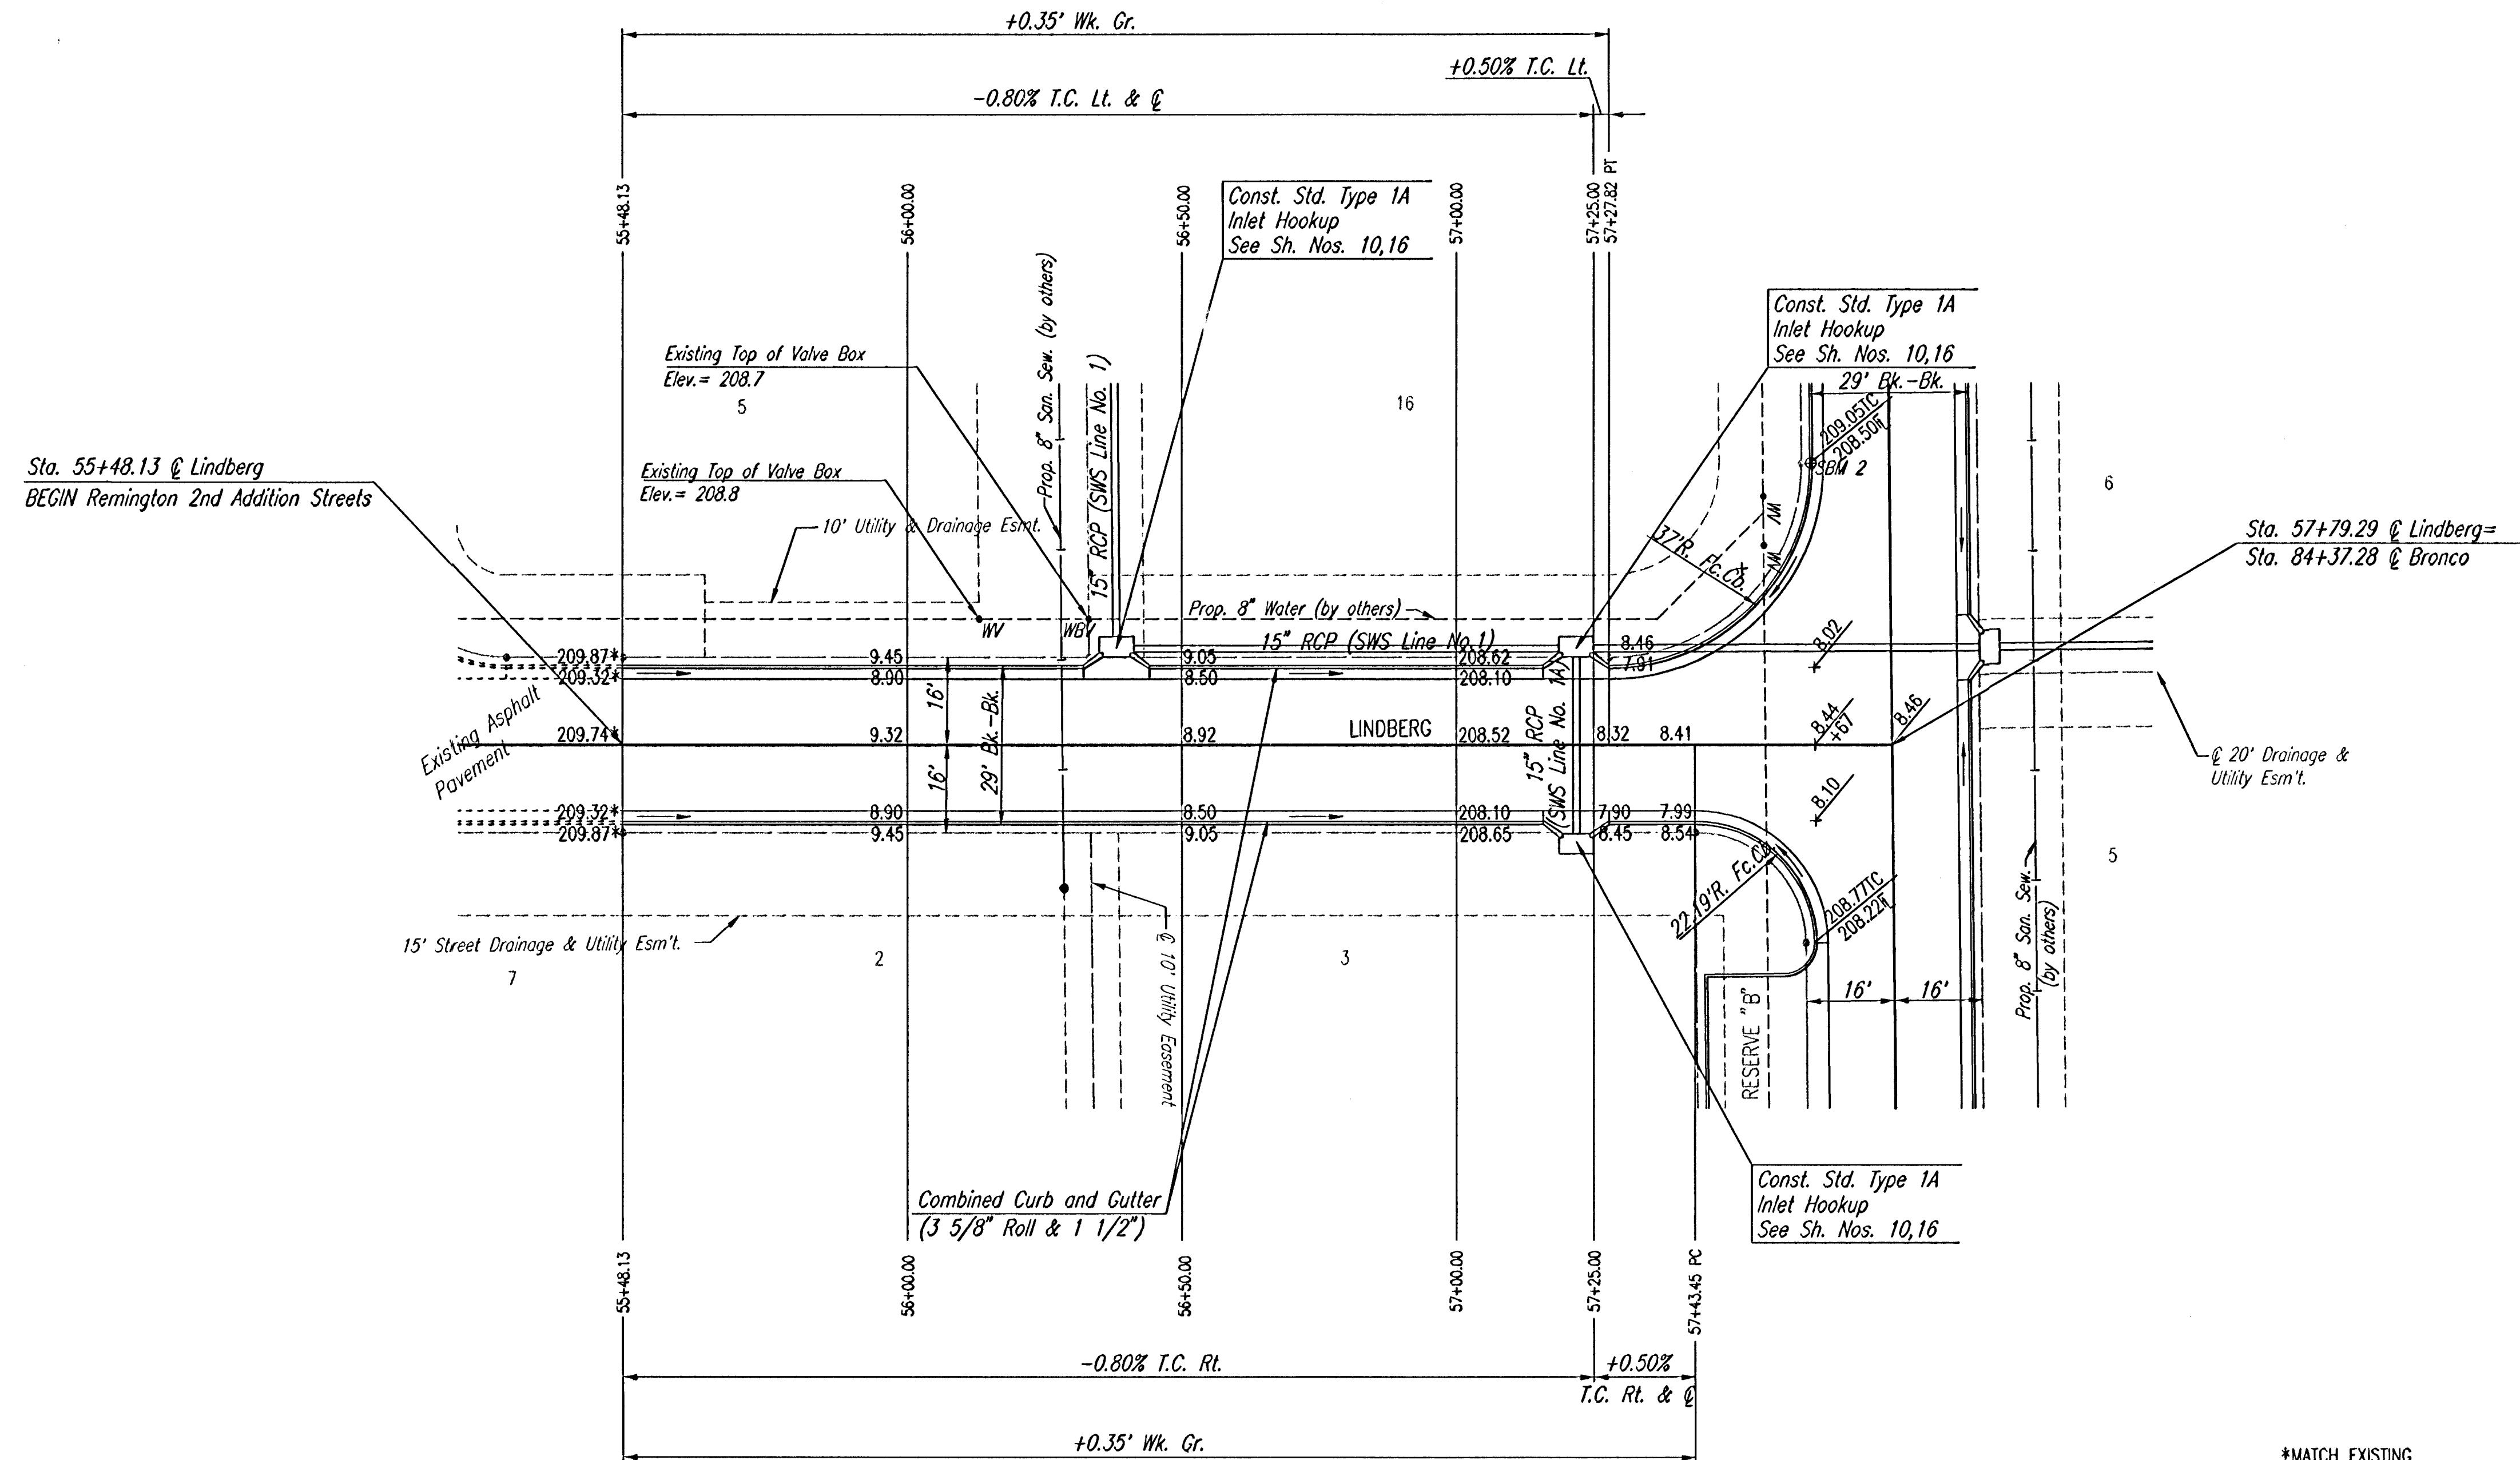

*MATCH EXISTING

Barbara E. Eshel 24 NOV 03
RECORD DRAWING

NOTE: THIS STREET TO BE CONSTRUCTED WITH ROLL-TYPE CURB. TOP OF CURB ELEVATIONS GIVEN ARE FOR FULL HEIGHT CURB.

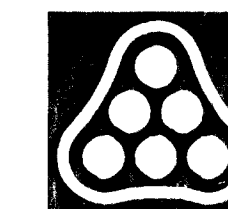

No.	Revision	By	Date
REMINGTON PLACE 2ND ADDITION NEIL D. CABLE P.E. - CITY ENGINEER LINDBERG STA. 55+48.13 TO STA. 57+79.29 CITY OF WICHITA PROJECT NO. 472-83678 Professional Engineering Consultants, P.A. 303 S. TOPEKA • WICHITA, KANSAS 67202 316-262-2691 • FAX 316-262-3003			
Designed by	BER, JJD	Job No.	35-02662
Drawn by	TL5	Date	January 2003
		Sh.	4 of 17