


PLAN	CHECKED	DATE

PROFILE	CHECKED	DATE

DSMR: BER OPER: ILS SCALE: 1"=20.00
Q:\2002\02662\000\SWS\LINE2 03-04-2003 11:09:41 am

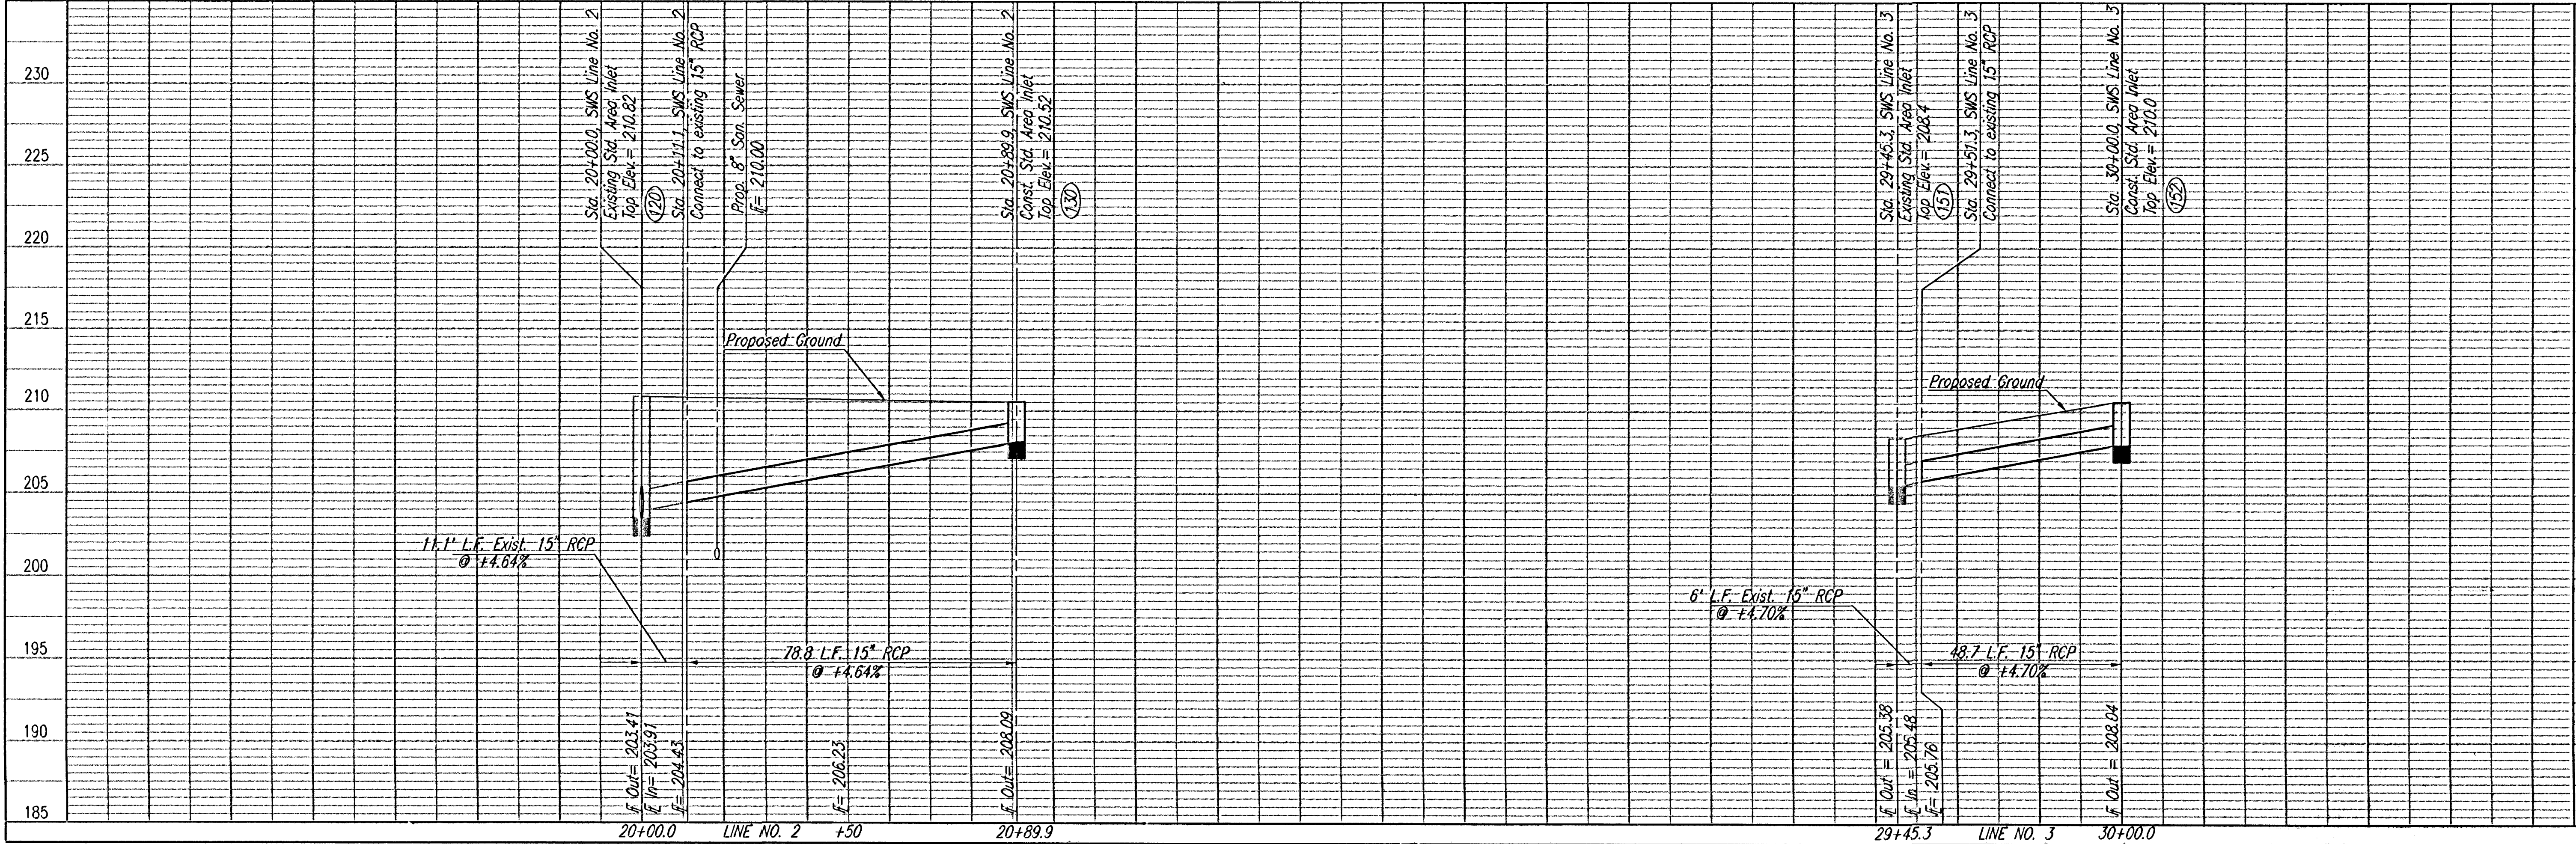

COORDINATE LIST		
POINT	NORTH	EAST
120	386,725.3230	2,370,760.5772
130	386,727.1106	2,370,850.4495
151	386,586.2963	2,370,959.1305
152	386,625.3543	2,370,997.4365

(152) = COORDINATE POINT NO.

RECORD DRAWING

Barbara K. Kohn 24 JAN 03

Professional Engineering Consultants, P.A.
303 S. TORREY - WICHITA, KANSAS 67202
316-262-2671 • FAX 316-262-2665

REMINGTON 2ND ADDITION
SWS LINE NO. 2
STA. 20+00.0 TO STA. 20+89.9
SWS LINE NO. 3
STA. 29+45.3 TO STA. 30+00.0
NEW 15\"/>

Designed By BER, WJD
Drawn By TLS

Job No. 35-02662
Date January 2003