


See sheet #37 and sheet 45A (Revised) for additional changes to Line 3

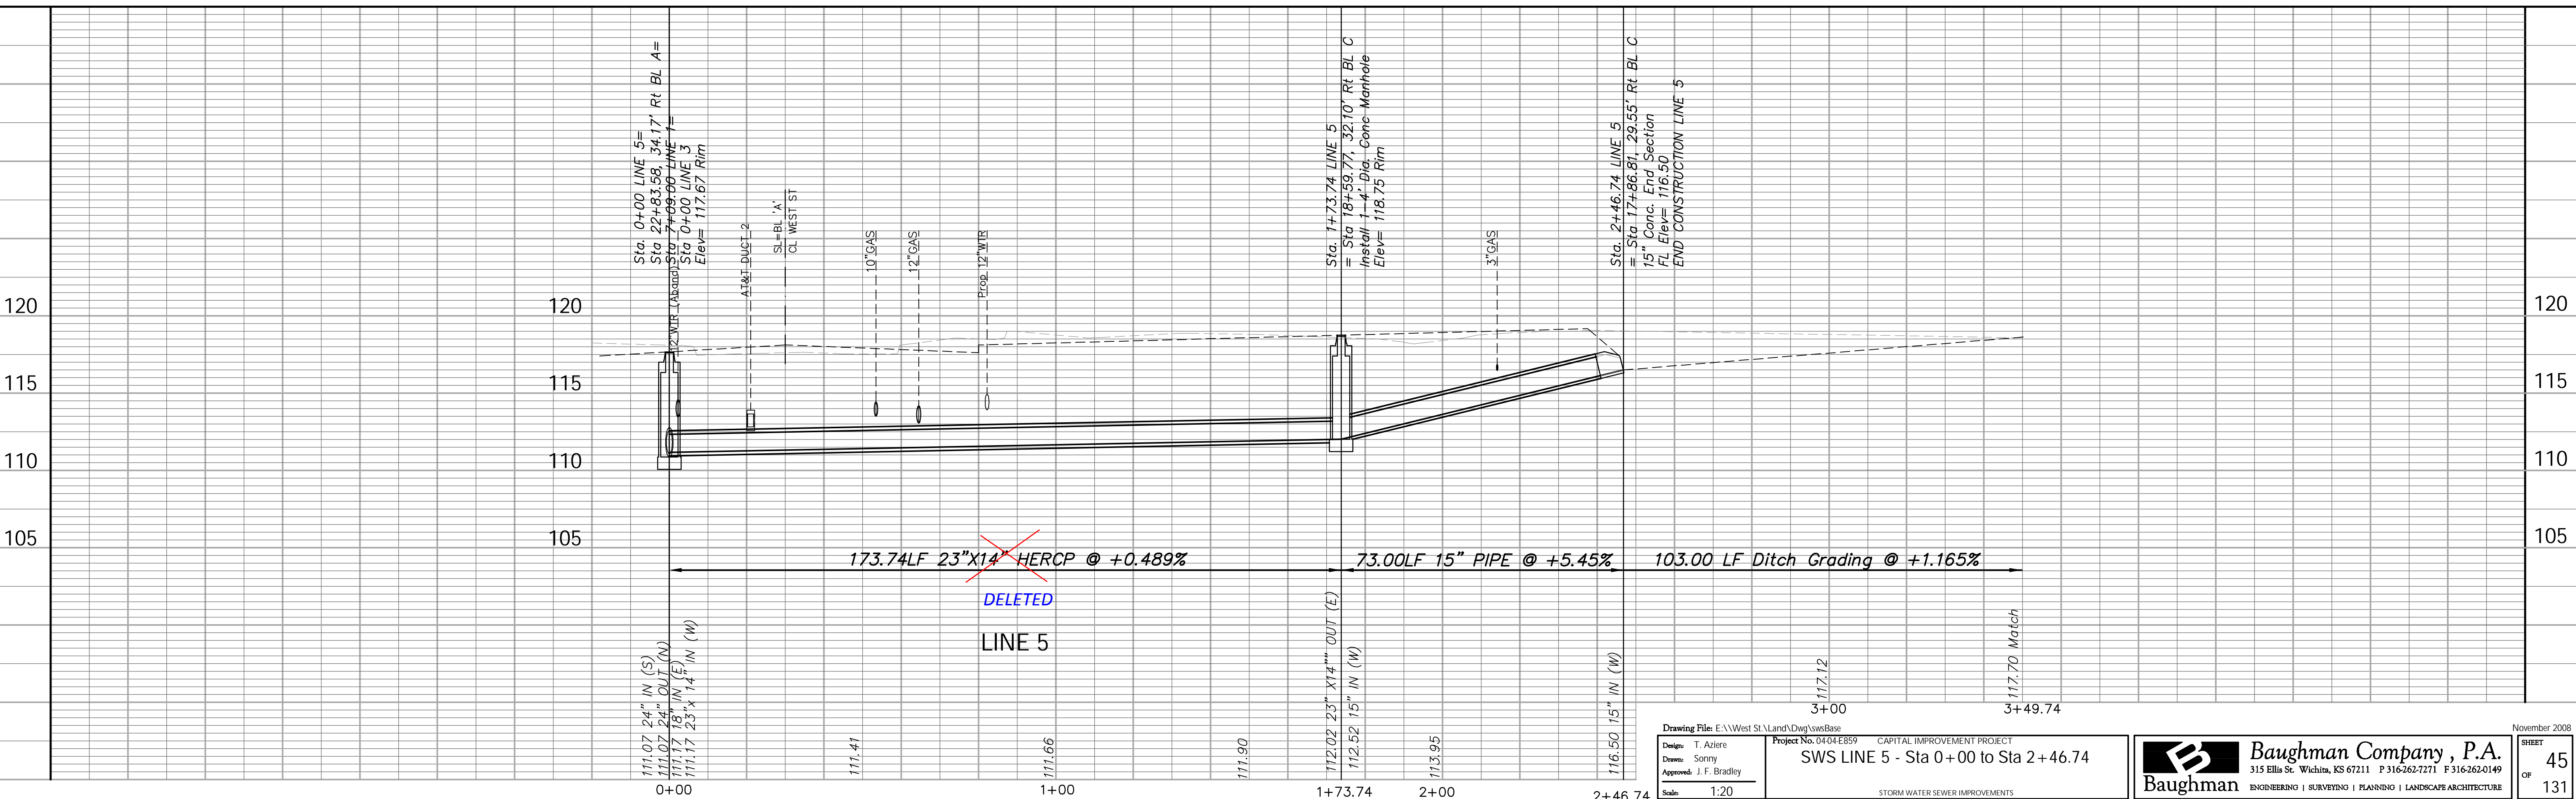

Drawing File: E:\West St.\Land\Draw\UseBase  
 Design: T. Aziere  
 Drawn: Sonny  
 Approved: J. F. Bradley  
 Scale: 1:20  
 Project No. 0404E859 CAPITAL IMPROVEMENT PROJECT  
 SWS LINE 5 - Sta 0+00 to Sta 2+46.74  
 STORM WATER SEWER IMPROVEMENTS