

STORM WATER DRAIN NO. 407

85097

TO SERVE TALLGRASS EAST COMMERCIAL 2ND ADDITION

OCA NO. 751550
CITY OF WICHITA PROJECT NO. 468-85097
CITY OF WICHITA, KANSAS
GARY JANZEN, P.E. - CITY ENGINEER

Dondlinger & Sons - Contractor
J. Wagner - City of Wichita, Field Project Engineer
G. Steinle - City of Wichita, Inspector
As-built
Completion Date: 2/8/2018

EARTHWORK


EXCAVATION 8,460 CU. YDS.
COMPACTED FILL 7,191 CU. YDS.

DEVELOPER CONTACT

MR. DAVID HAMBRICK
SLAWSON COMPANIES
727 N. WACO, SUITE 400
WICHITA, KANSAS 67203
(316) 263-3201

INDEX OF SHEETS

1. TITLE SHEET
2. KEY MAP AND GENERAL NOTES
- 3-4. GRADING PLANS
5. TYPICAL SECTIONS
6. STORM WATER SEWER NOS. 1 & 2
7. STORM WATER SEWER NOS. 3 & 4
8. STORM WATER SEWER NO. 5
9. SIDEWALK GEOMETRY PLAN
10. RETAINING WALL PLAN
11. PRECAST CONCRETE MANHOLE
12. REINFORCED CONCRETE MANHOLE
13. MANHOLE/INLET FRAME AND COVER
14. HEADWALL DETAILS-15", 18", AND 24" PIPE
15. 24" HEADWALL W/SOIL SAVER
16. RIPRAP AND MISCELLANEOUS DETAILS
17. SEEDING PLAN
18. EROSION CONTROL PLAN
- 19-21. EROSION CONTROL DETAILS
22. EXERCISE EQUIPMENT DETAILS
23. COPY OF PLAT

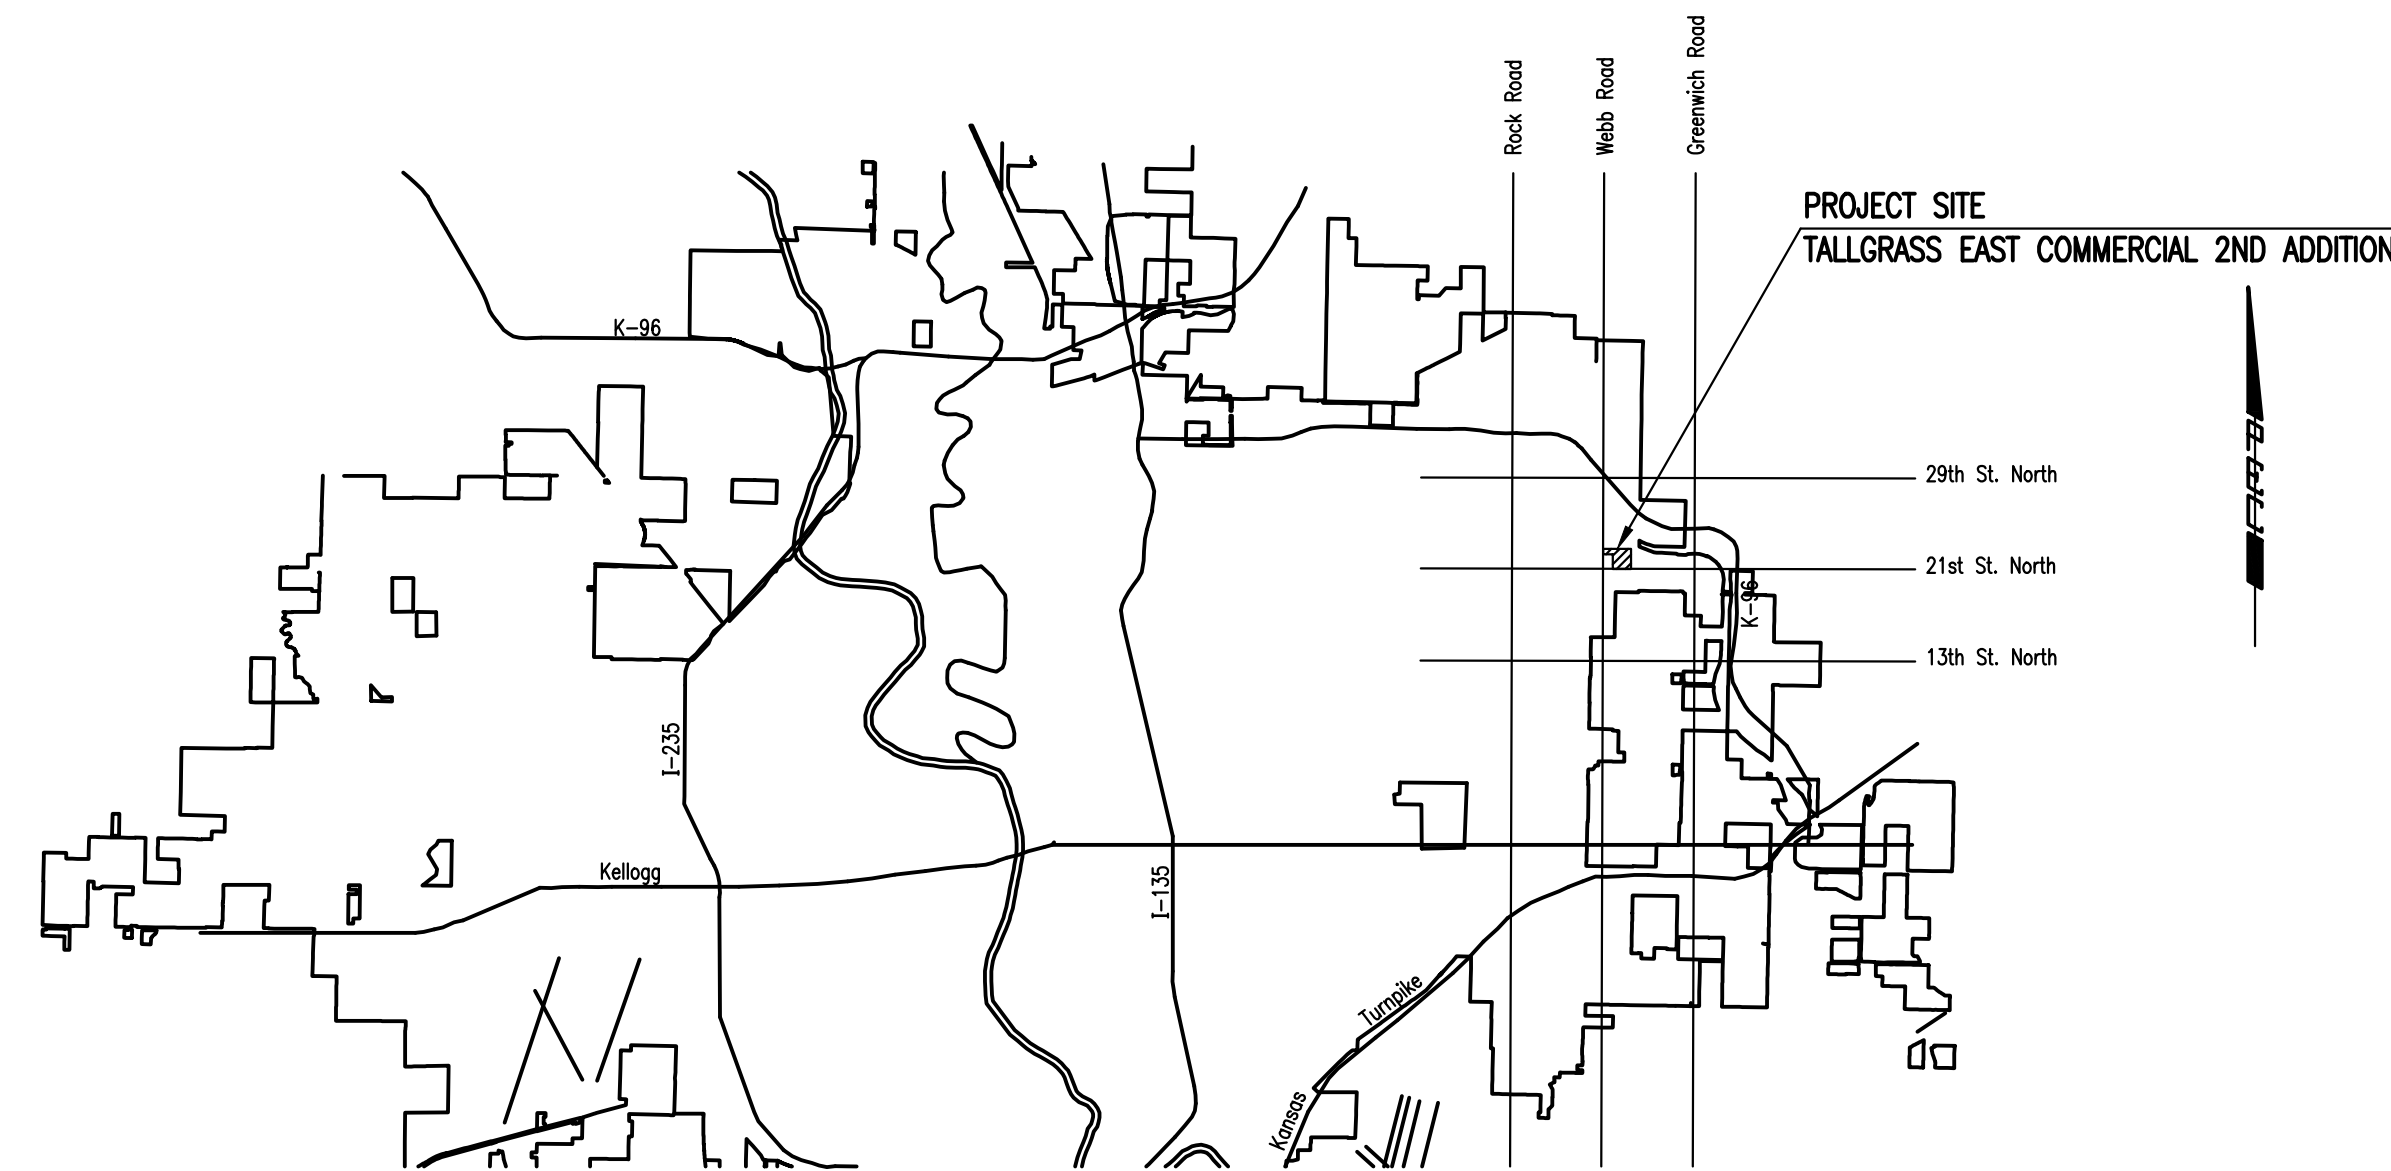

LOCATION MAP

CONSTRUCTION SCHEDULE/SEQUENCE

THE CONTRACTOR FOR THIS PROJECT SHALL COORDINATE THEIR EFFORTS SUCH THAT ANY NECESSARY SIMULTANEOUS PRIVATE PROJECT CONSTRUCTION CAN PROCEED CONCURRENTLY WITHOUT CAUSING UNDUE DELAYS SO CONSTRUCTION CAN BE COMPLETED WITHIN THE TIMEFRAME AS OUTLINED IN THE SPECIAL PROVISIONS.

DECEMBER 2016

PLANS PREPARED BY
PROFESSIONAL ENGINEERING CONSULTANTS, P.A.
ENGINEERS
WICHITA, KANSAS

