

448-89419


SCALE: 1:200 HORIZ.
1:20 VERT.

FHWA REGION NO.	STATE	PROJECT NUMBER	FISCAL YEAR	SHEET NUMBER	TOTAL SHEETS
7	KANSAS	87 N-0189-01	2001	103	105


Contractor: Utility Contractors
Inspector: A. Smith - C.O.W.
226 LF 12" PVC PIPE
35 LF 12" DICL PIPE
2- 12" Valve Assy.

AS BUILT
5/21/03
R. Loomis

DATE	BY	REFERENCES NOTED	REFERENCES CHECKED

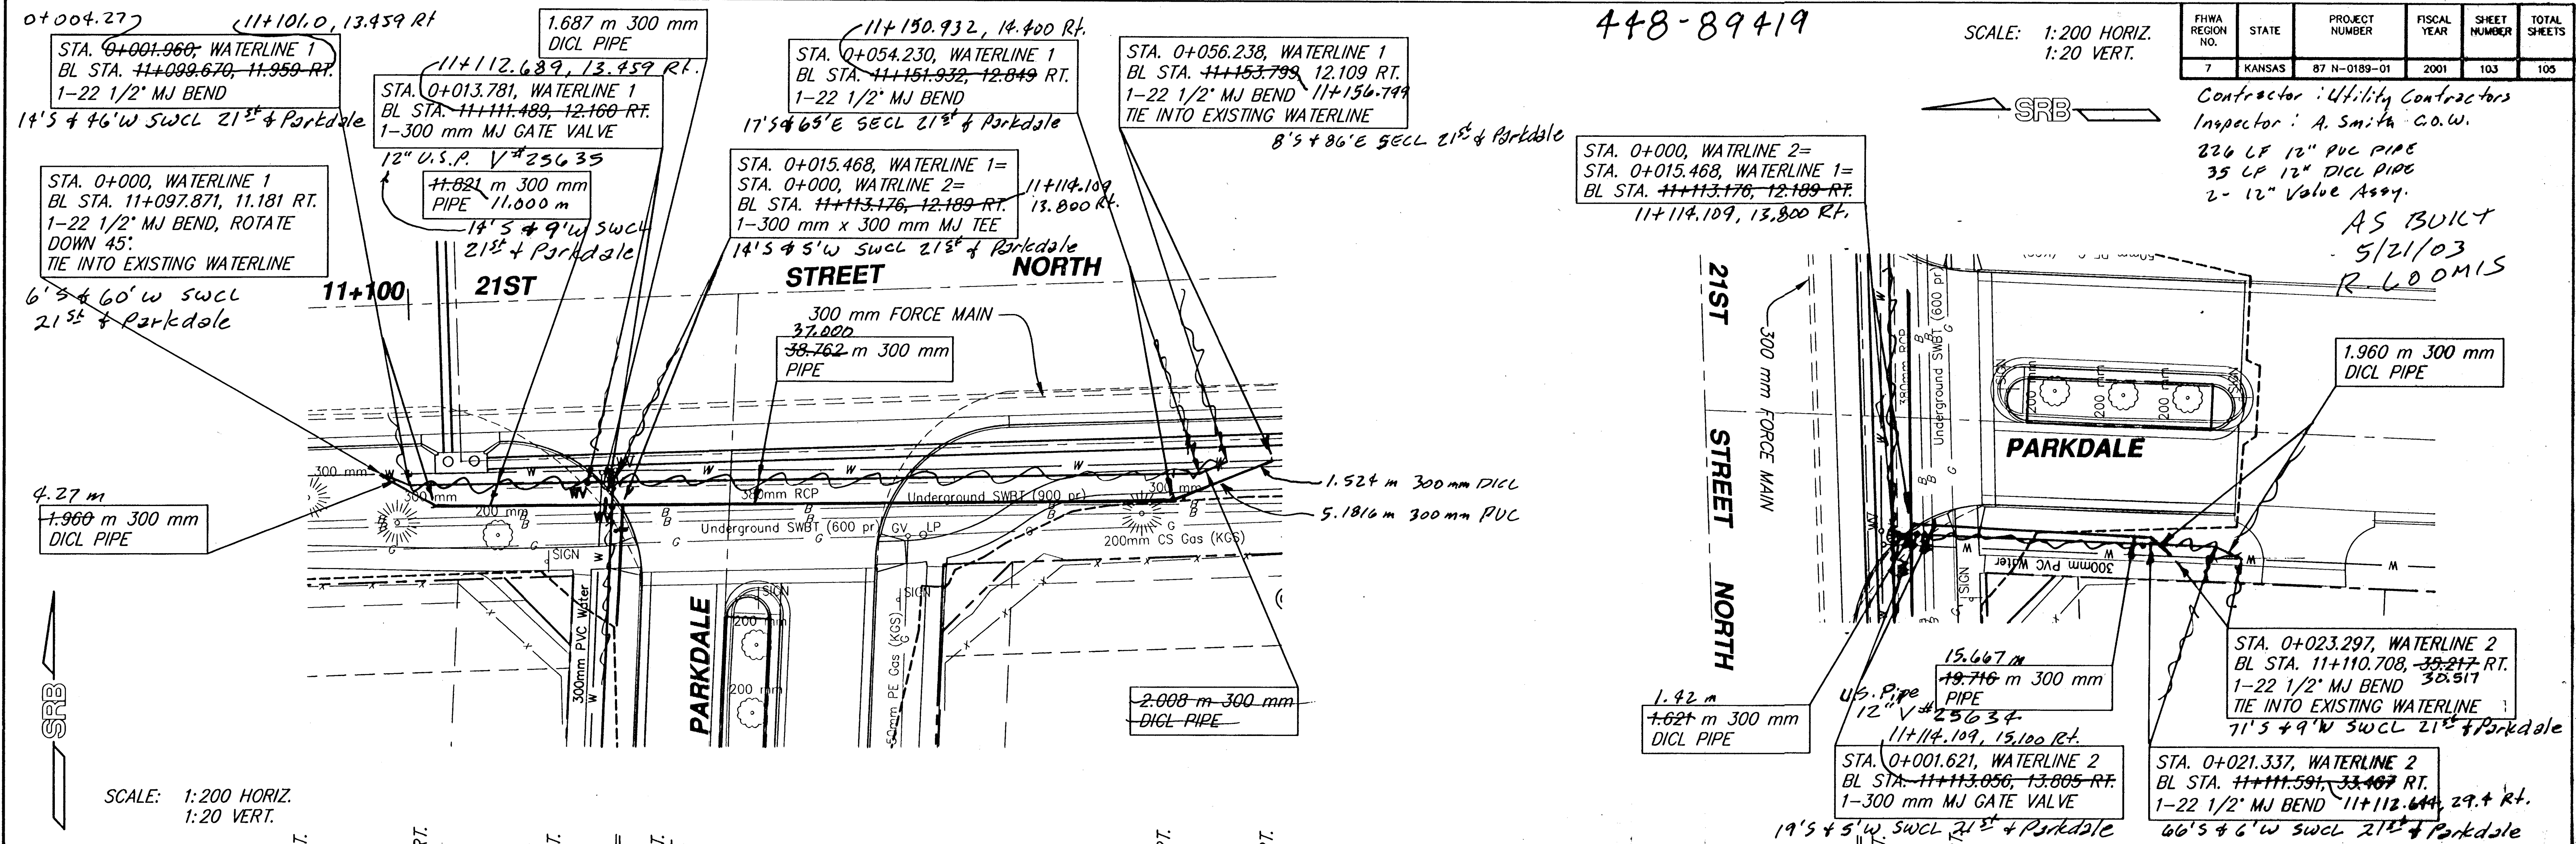

SCALE: 1:200 HORIZ.
1:20 VERT.

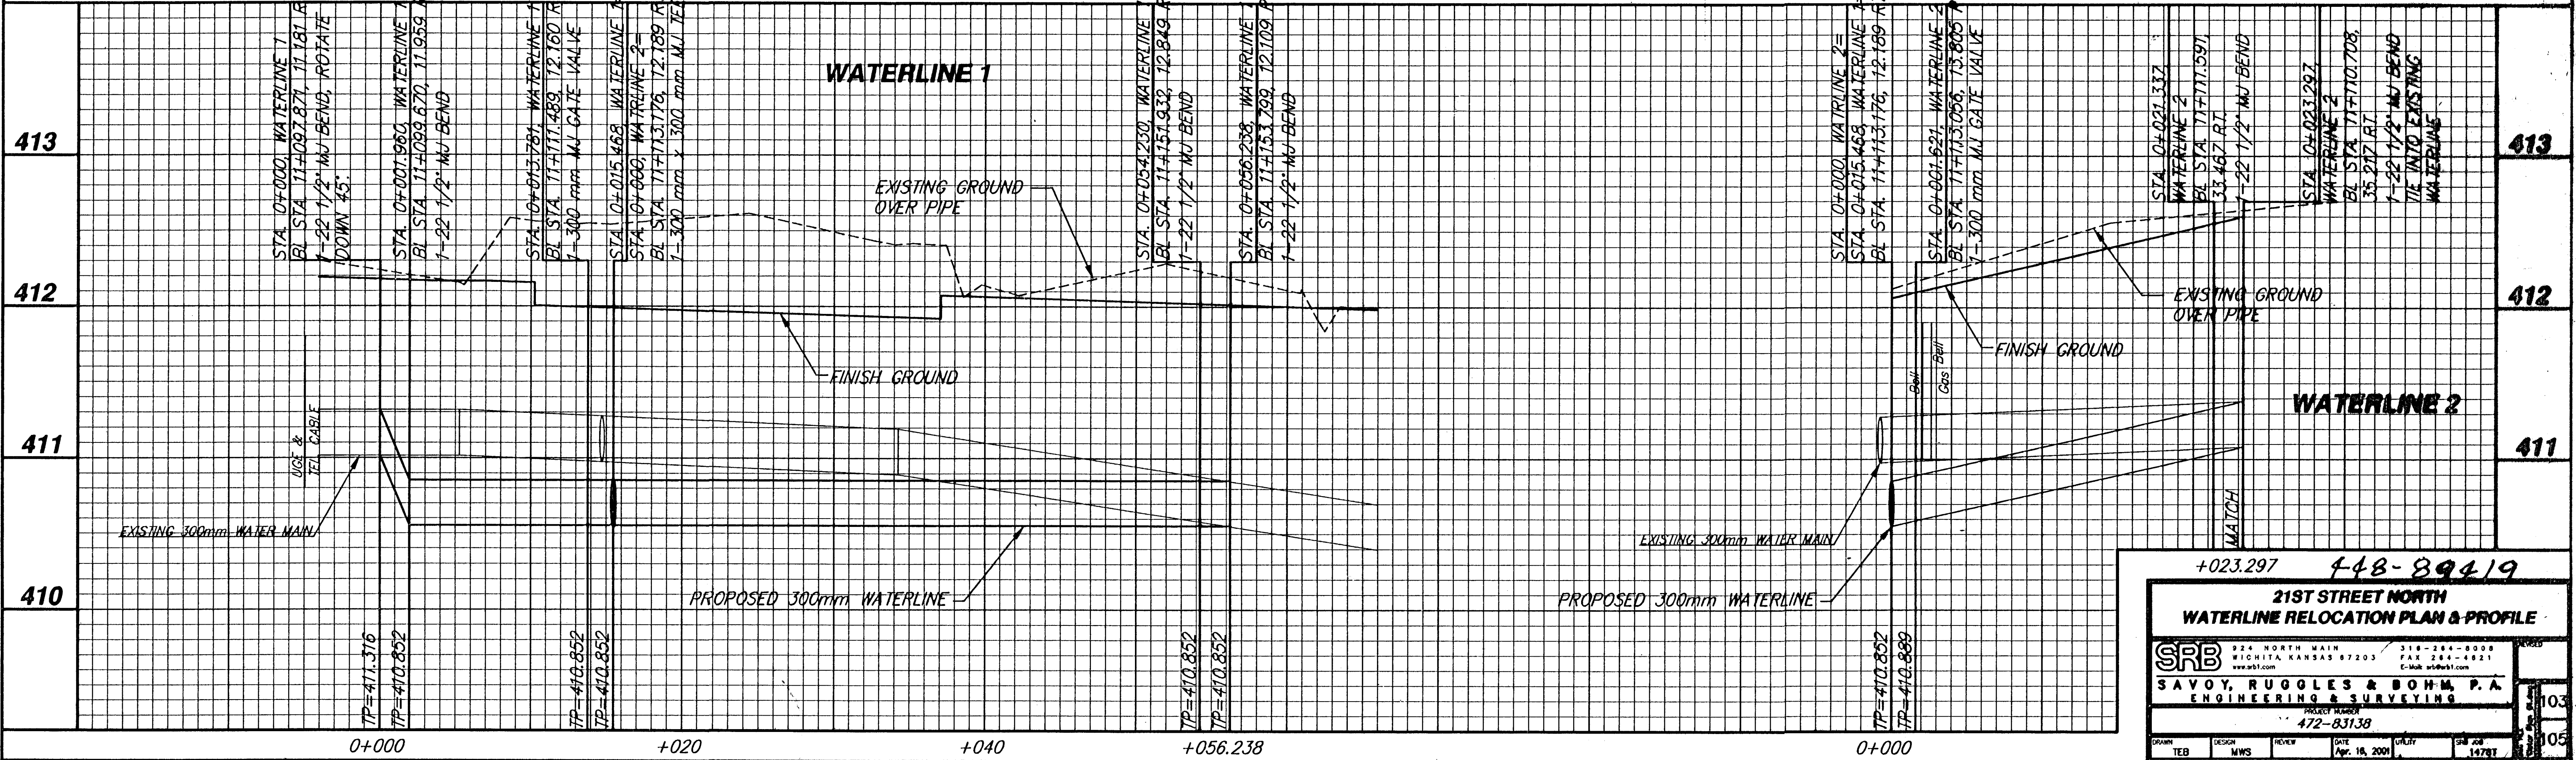

+023.297 **448-89419**

**21ST STREET NORTH
WATERLINE RELOCATION PLAN & PROFILE**

SRB 234 NORTH MAIN 316-264-8008
WICHITA, KANSAS 67203 FAX 264-4821
www.srb.com e-Mail: srbs@srb.com

SAVOY, RUGGLES & BOHM, P.A.
ENGINEERING & SURVEYING
PROJECT NUMBER: 472-83138
DATE: Apr. 18, 2001

DESIGN	REVIEW	CHECK	DATE	SCALE	SHEET NO.	TOTAL SHEETS
TEB	MWS		Apr. 18, 2001		103	105