


BENCHMARKS:

BM #1 - City of Wichita Bench Mark Disc, 42' North and 41' West of Centerlines Hydraulic and 55th St. South.
Sta. 63+56.1, 41' Lt.
Elev. = 76.19 (City Datum)

FHWA REGION NO.	STATE	PROJECT NO.	FISCAL YEAR	SHEET NO.	TOTAL SHEETS
7	KANSAS	87 N-0303-01	2003	25	143


End 55th Street Construction

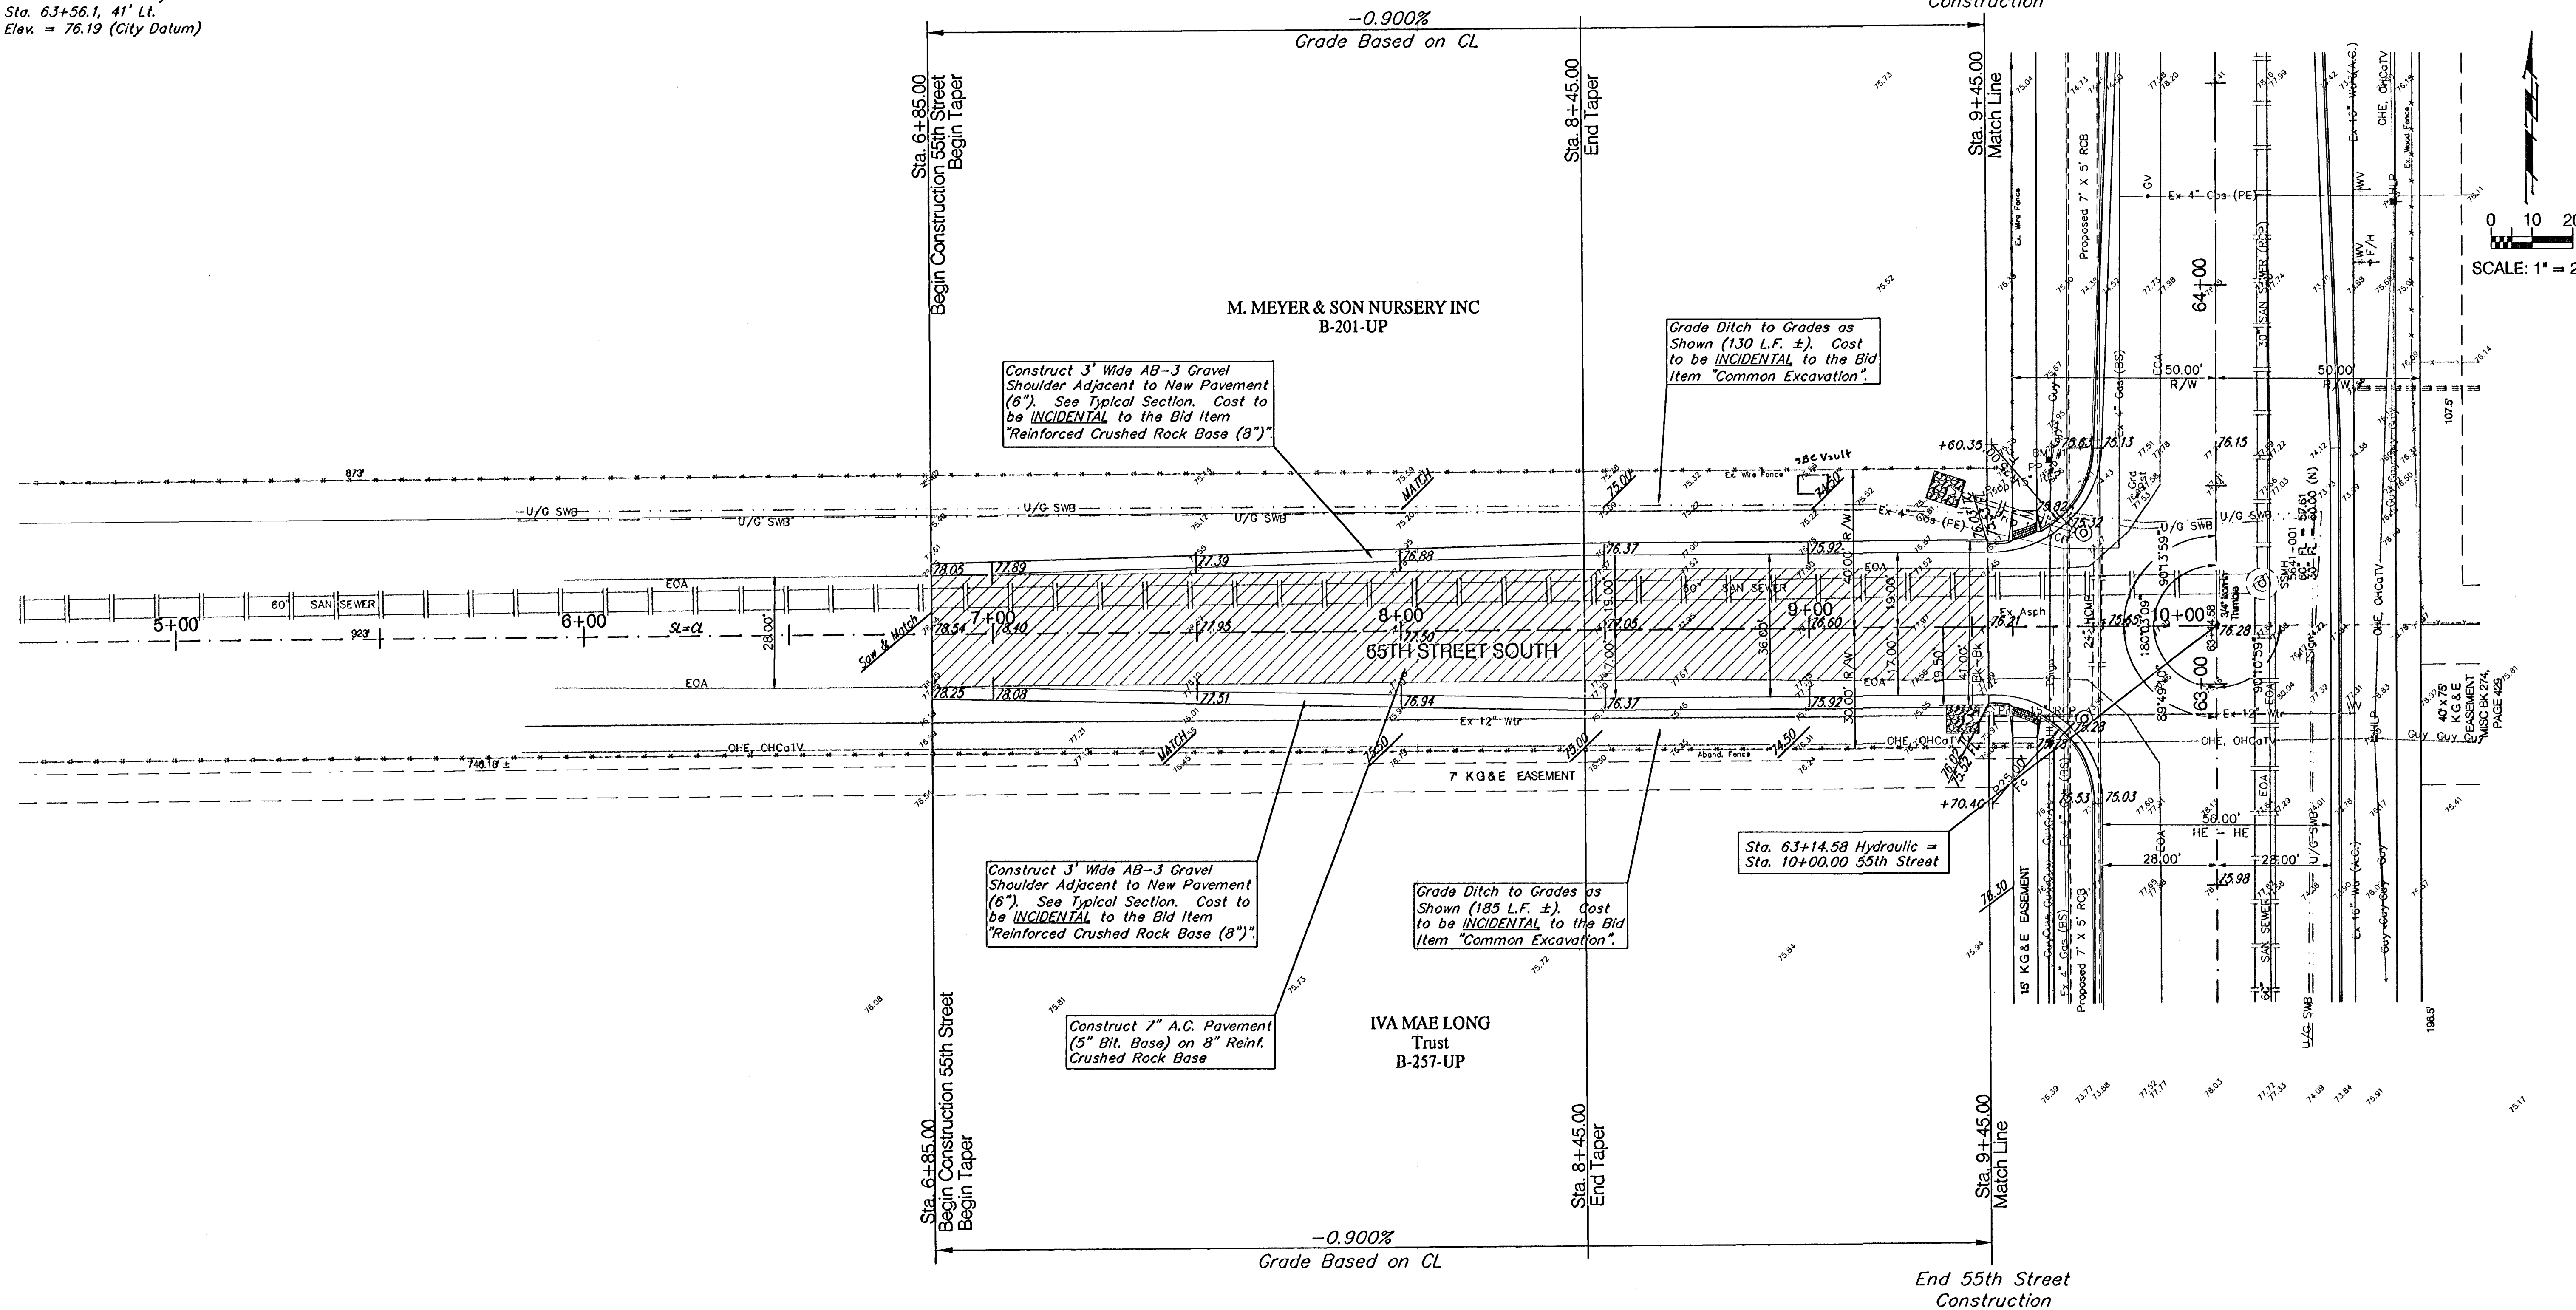

SCALE: 1" = 20'

Note:

Pavement, Sidewalks, and Etc. To Be Removed Are Indicated By:

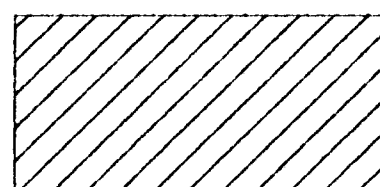

Note:

Trees/Shrubs to be removed are marked thus:



PROJECT NUMBER 472-83902	SHEET NAME PAV14	ENGINEERING DIRECTORY R:\Eng\Hydraulic_phs2\Pav
DESIGN JFB	DRAWN TCA	APPROVED JFB/KK
DATE Aug 03	SCALE 1"=20'	BAUGHMAN NO. 99-09-B451

STREET & SWS IMPROVEMENTS
PAVING PLAN

HYDRAULIC AVE PAVING - SOUTH OF 57th STREET SOUTH TO 47th STREET SOUTH

BAUGHMAN COMPANY, P.A.
ENGINEERING, SURVEYING, & PLANNING
319-282-7271 • 315 ELLIS • WICHITA, KANSAS 67211

SHEET
25
OF
143