

BENCHMARKS:  
BM #1: COW BM at the SW corner of  
Pawnee Ave. and Maize Road.  
Elev. = 135.15 (City Datum)


BM #2: "□" in top of curb on the  
north side of Yosemite, 65' east of  
Maize Road.  
Elev. = 143.67 (City Datum)

BM #3: COW BM at Shefford on the  
south side of Pawnee Ave.  
Elev. = 145.53 (City Datum)

P.V.I.  
Elev. = 147.86  
No V.C.

P.V.I.  
Elev. = 146.20  
27.74' V.C.

Scale: 1" = 20'  
• = Iron

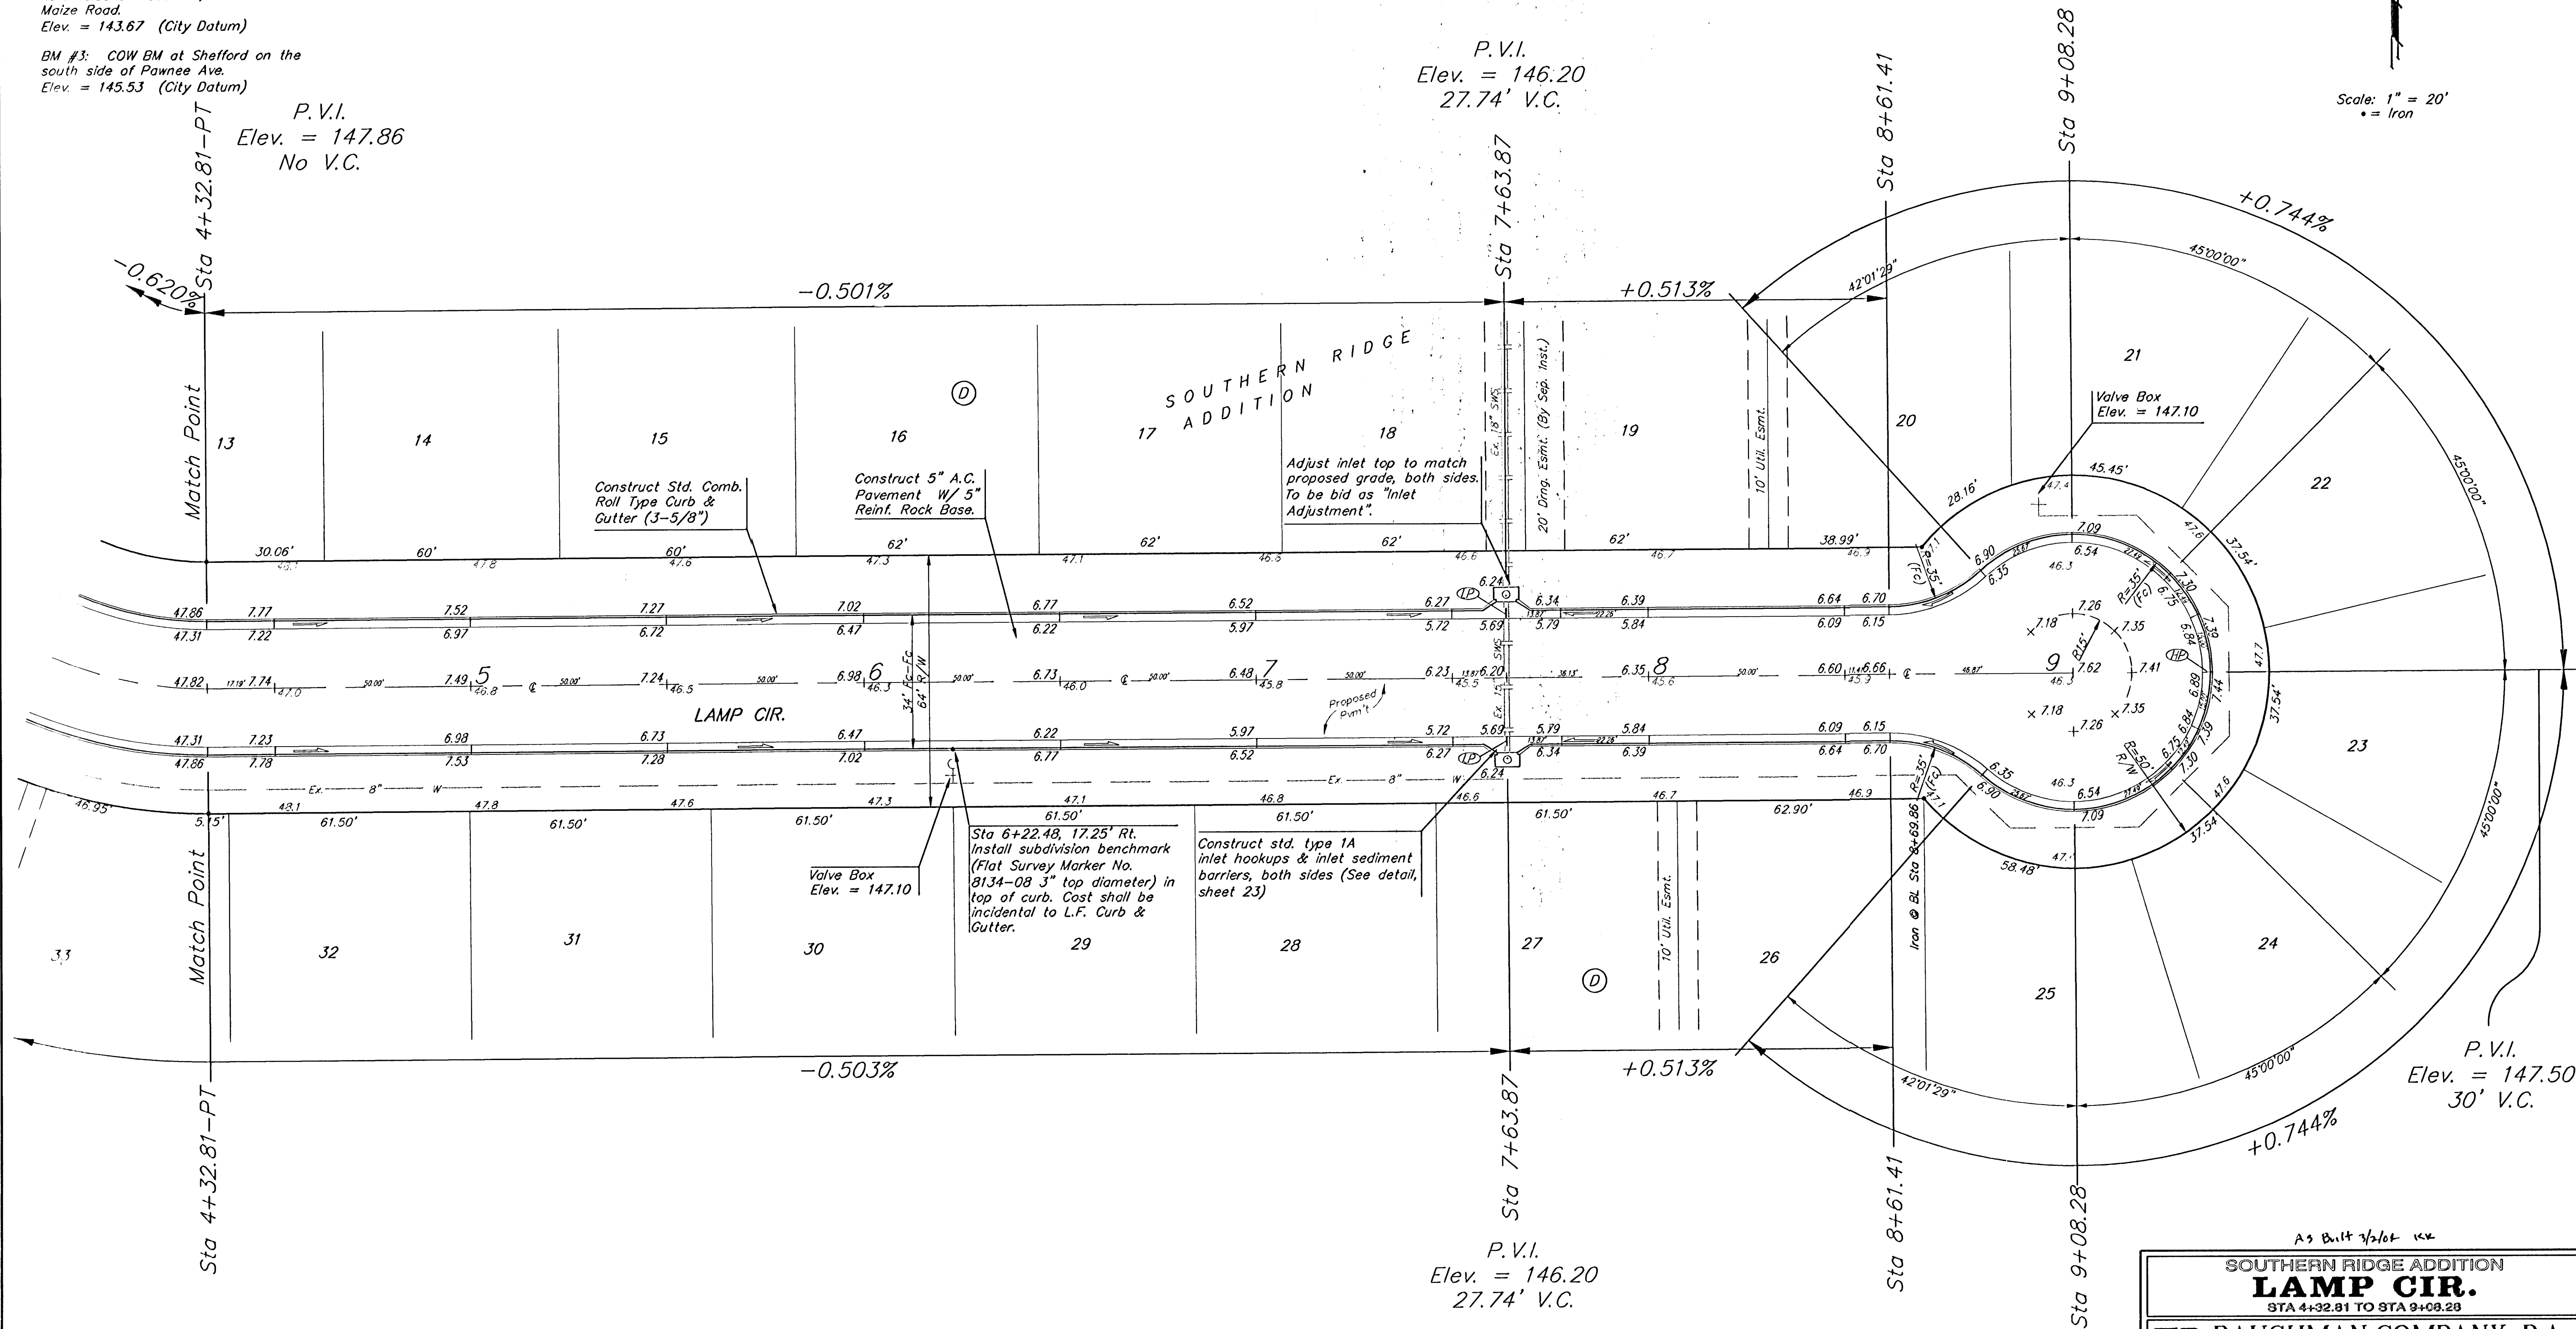

NOTE: ROLL TYPE CURB & GUTTER TO  
BE CONSTRUCTED ON THE  
PAVEMENT SHOWN ON THIS SHEET.  
TOP OF CURB ELEVATIONS ARE  
GIVEN FOR FULL HEIGHT CURB.

As Built 7/2/04 KKK

**SOUTHERN RIDGE ADDITION  
LAMP CIR.**  
STA 4+32.81 TO STA 9+08.28

**BAUGHMAN COMPANY P.A.**  
ENGINEERING, SURVEYING, & PLANNING  
316-262-7271 • 315 ELLIS • WICHITA, KANSAS 67211

PROJECT NUMBER  
**472-83881**

|               |              |          |               |                |                                       |
|---------------|--------------|----------|---------------|----------------|---------------------------------------|
| DESIGN<br>NBW | DRAWN<br>TMS | APPROVED | DATE<br>05/03 | SCALE<br>Noted | SHEET<br><b>19</b><br>OF<br><b>48</b> |
|---------------|--------------|----------|---------------|----------------|---------------------------------------|