



RR Spike in N. Face of PP in
N. R/W of Maple N. of Nineiron.
Elev. = 177.01 (City Datum)

"□" Cut center of north
Headwall of RCBC in N. R/W of
Maple 570' East of centerline
of City View.
Elev. = 187.91 (City Datum)

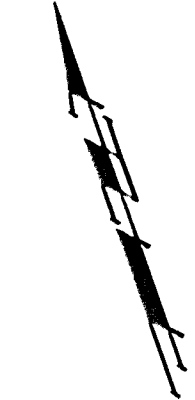

Scale: 1" = 20'
• = Iron

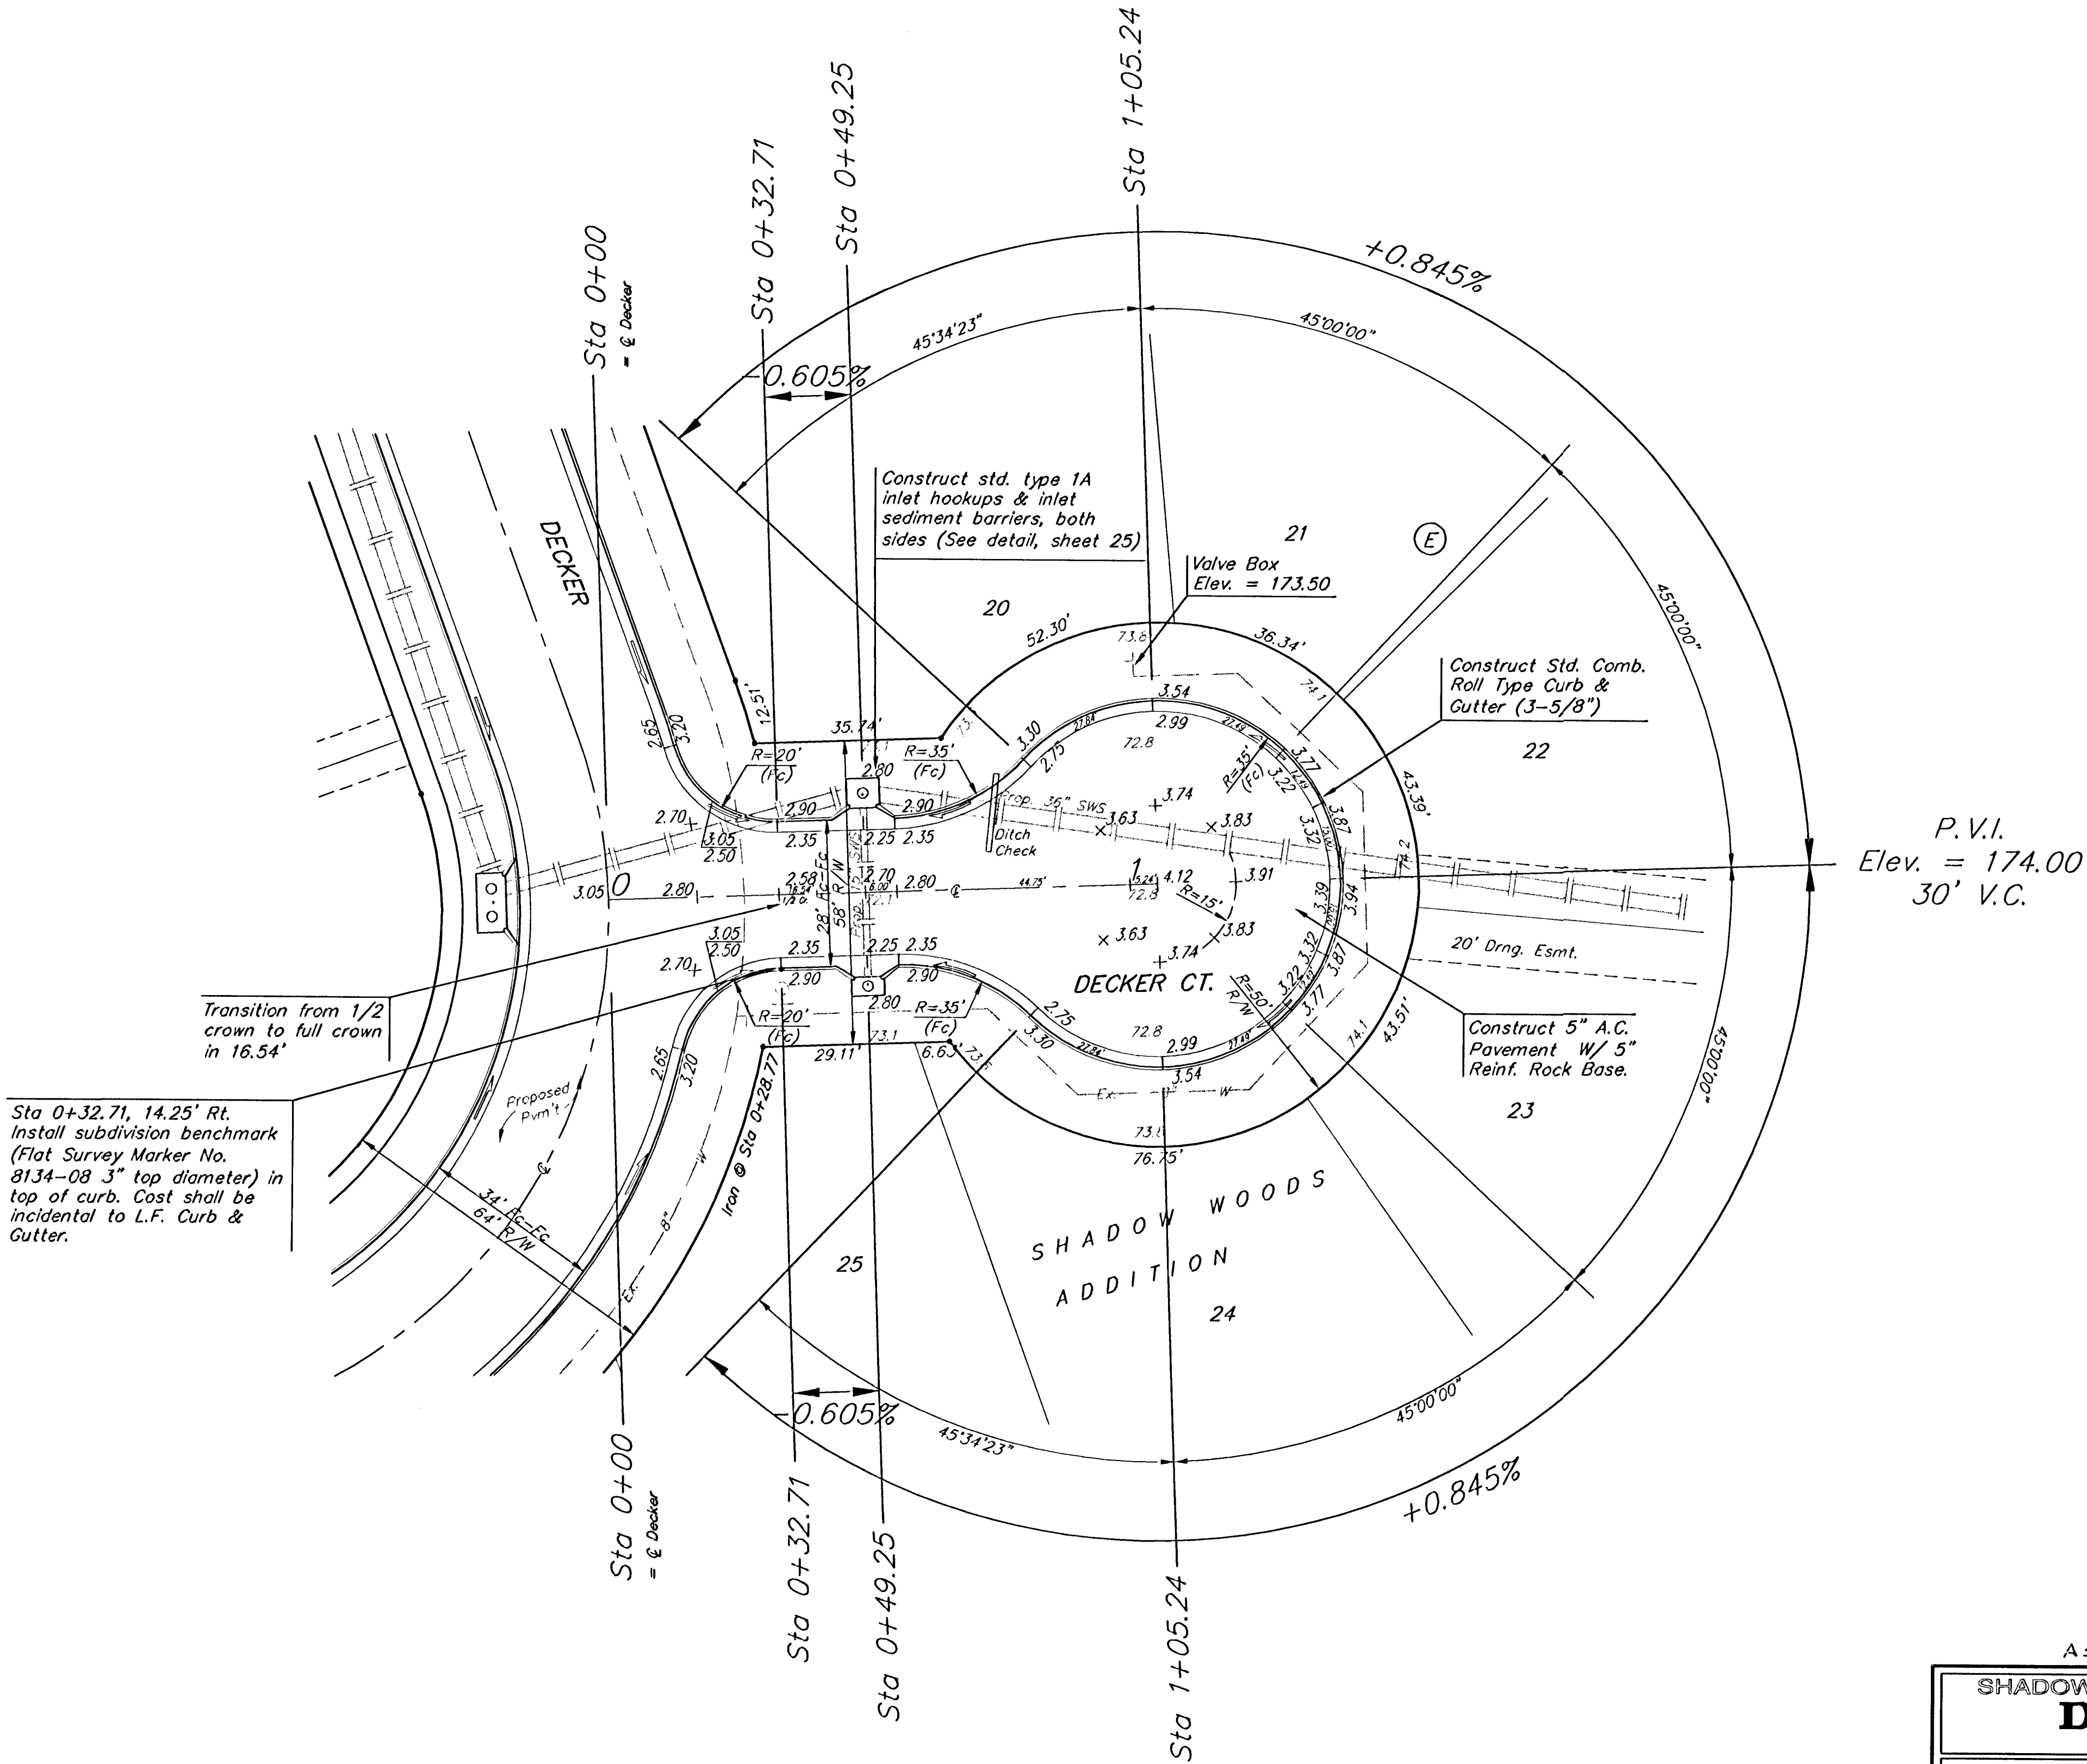

Sta 0+32.71, 14.25' Rt.
Install subdivision benchmark
(Flat Survey Marker No.
8134-08 3" top diameter) in
top of curb. Cost shall be
incidental to L.F. Curb &
Gutter.

NOTE: ROLL TYPE CURB & GUTTER TO
BE CONSTRUCTED ON THE
PAVEMENT SHOWN ON THIS SHEET.
TOP OF CURB ELEVATIONS ARE
GIVEN FOR FULL HEIGHT CURB.

As Built

SHADOW WOODS ADDITION - PHASE IA
DECKER CT.
STA 0+00 TO STA 1+05.24

BAUGHMAN COMPANY P.A.
ENGINEERING, SURVEYING, & PLANNING
315-262-7271 • 315 ELLIS • WICHITA, KANSAS 67211

PROJECT NUMBER
472-83721

DESIGN NSW	DRAWN TMS	APPROVED	DATE 05-28-03	SCALE Noted
---------------	--------------	----------	------------------	----------------

SHEET
12
OF
37