

INDEX OF SHEETS

- 1 - Cover Sheet
- 2 - Project Limits/Easement
- 3 - Tank Plan
- 4 - Details

BY	DATE
REFERENCE NOTED	REFERENCE CHECKED

STATE OF KANSAS
DEPARTMENT OF TRANSPORTATION



PLAN AND PROFILE OF PROPOSED
STATE HIGHWAY

CITY OF WICHITA
SEDGWICK COUNTY
US-54

F.H.W.A. REGION NO.	STATE	PROJECT NO.	YEAR	SHEET NO.	TOTAL SHEETS
7	KANSAS	54-87 K-8258-10	2005	1	4

Proj. No. 54-87 K-8258-10


UNDERGROUND STORAGE
TANK REMOVAL

Kellogg Avenue (US-54)
Rock Road Interchange, Part - 10
Mainline (Governour to Rock Road)
City of Wichita Project No. - 472-84450
O.C.A. No. - 702348

STA. 2+899.900 BEGIN
Proj. 54-87 K-8258-01 =
Sta. 2+899.900 On
Proj. 54-87 K-8259-01 =

Remove 3 Existing 10,000 Gallon
Underground Storage Tanks.

STA. 4+806.000 END
Proj. 54-87 K-8258-01

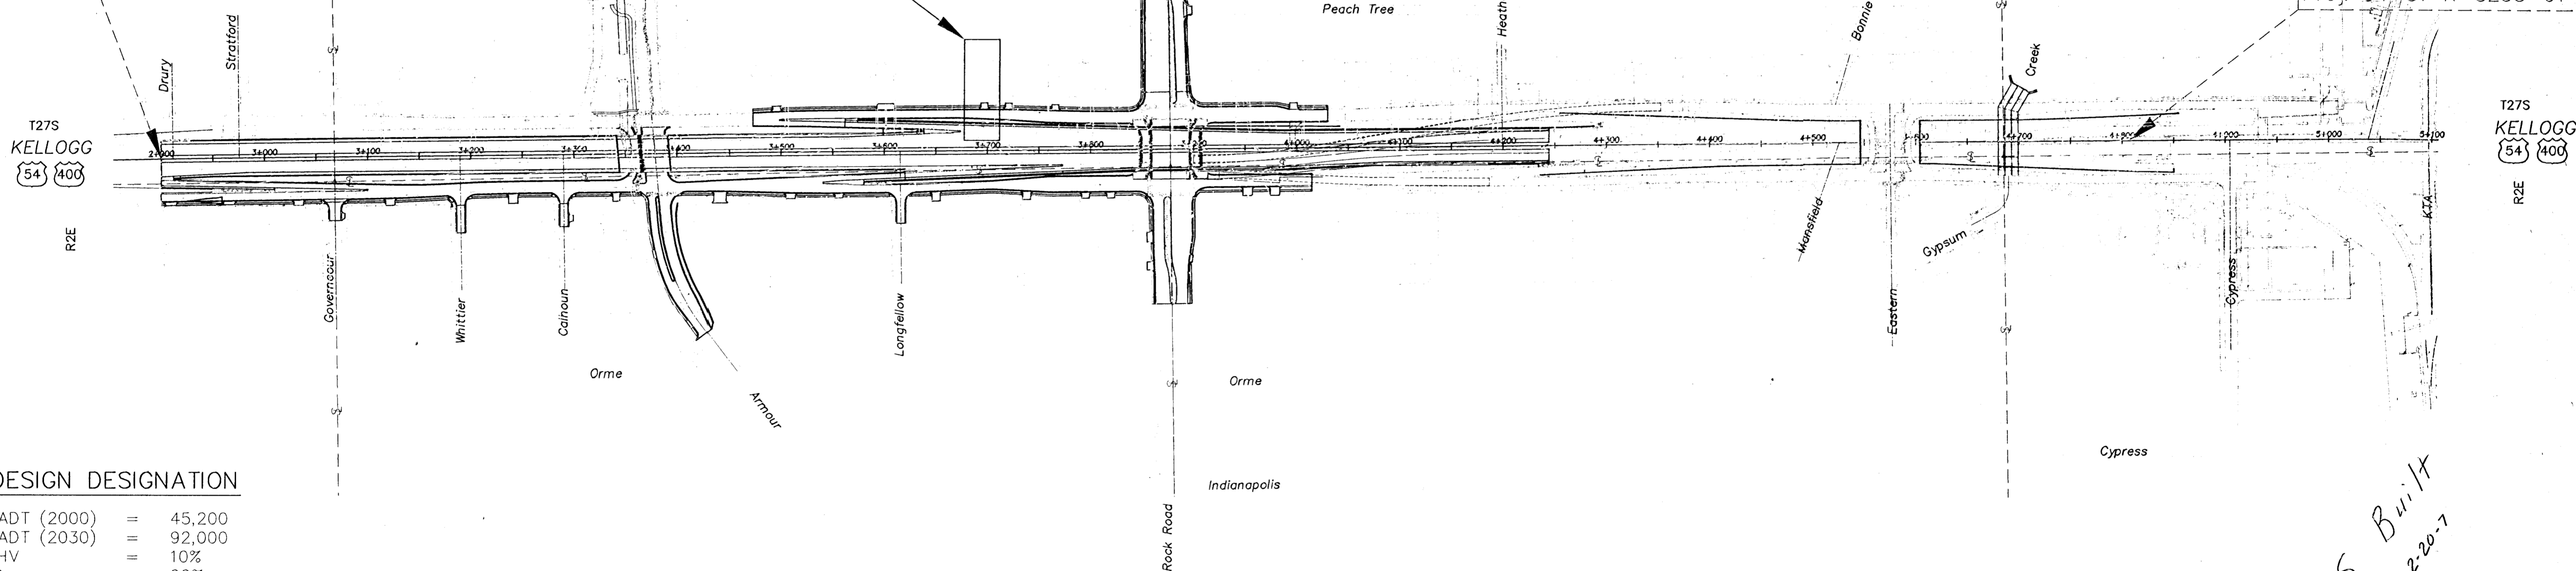

DESIGN DESIGNATION

AADT (2000)	=	45,200
AADT (2030)	=	92,000
DHV	=	10%
D	=	60%
T	=	18%
V	=	100 KPH
C of A	=	FULL
CLEAR ZONE	=	10 m

CONVENTIONAL SIGNS

COUNTY LINE	CENTER LINE OF PROJECT	
CITY LIMITS	TERRACE	
STATE OR NATIONAL LINE	CULVERTS	
TOWNSHIP, SECTION or GRANT LINE	DROP INLET & STORM SEWER	
PROPERTY LINE	ACCESS CONTROL	
HIGHWAY FENCE	POWER POLE	
EXISTING FENCE	TELEPHONE POLE	
GUARD FENCE	MARSH	
CONSTRUCTION LIMITS	HEDGE	
RIGHT OF WAY LINE	TREES	
TRAVELED WAY	PROFILE ELEVATION	
RAILROADS	STREAM or CREEK	


CITY OF WICHITA
Population 320,395

NOTE: REMOVAL OF THE UNDERGROUND STORAGE TANKS IS PART OF THE ROCK ROAD INTERCHANGE PROJECT EXTENDING FROM STA. 2+899.900 TO STA. 4+806.000.



All dimensions shown without a SI suffix are in millimeters. All elevations shown are in meters.

*AS Built
2-20-1*

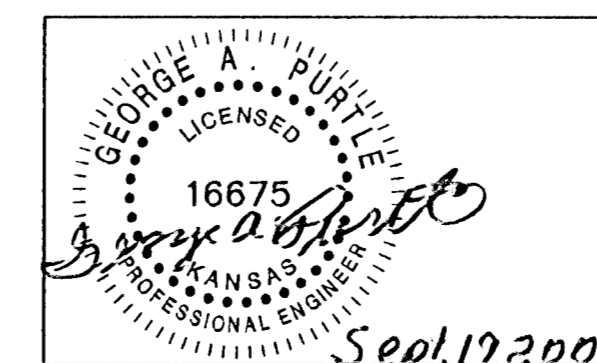

PLANS PREPARED BY:
CFS
Cook, Flatt & Strobel
ENGINEERS, P.A.

RECOM. FOR APPROVAL-DATE

JIM ARMOUR, P.E. CITY ENGINEER
CITY OF WICHITA, KANSAS