

GENERAL NOTES:

1. Contractor will be required to provide notice to utility companies a minimum of forty-eight (48) hours prior to any excavation, as follows:

- Kansas One-Call 687-2470
- The Contractor must notify the following in case of an emergency:
- Cox Communications 262-4270
 - Kansas Gas Service 1-888-482-4950
 - Westar Energy 383-8650
 - Aquila Energy 1-800-303-0357
 - AT&T 268-2245
 - City of Wichita Water Dept. 268-4563
 - City of Wichita Sewer Maint. 268-4024
 - City of Wichita Storm Sewer Maint. 268-4090
 - City of Wichita Traffic Maint. 268-4034
 - Conoco Phillips Pipeline Co. 1-877-267-2290
 - Southern Star Pipeline Co. 529-6600
 - Kinder-Morgan Pipeline Co. 1-888-844-5658

2. Utility service lines, poles, valve boxes, meters, and etcetera are to be adjusted as necessary by others prior to construction unless the plans specifically call for their adjustment by the Contractor or unless the plans specifically identify a utility to be adjusted by its owner during construction. Existing utilities and their location, as shown on the plans, represent the best information obtainable for design. The Contractor will be required to work around existing utilities within the right-of-way which do not conflict with proposed construction.

3. Rubble from the removal of miscellaneous structures and excess excavation which is to be wasted shall be disposed of on sites to be provided by the Contractor. These sites shall be approved by the Engineer as to suitability, appearance and site location. Locations, in the opinion of the Engineer, that will leave an unsightly appearance will not be approved. All disposal sites must be approved by the Kansas Department of Health and Environment. Material either stockpiled or disposed of in a flood plain would require a Kansas State Board of Agriculture permit. Any material dumped in waters of the United States or wetlands is subject to U.S. Corps of Engineers permitting regulations. Any material buried or stockpiled beyond approved construction limits would require additional archaeological investigations unless buried in a previously approved borrow location.

4. Trees and shrubs in public right-of-way which are in direct conflict with proposed new construction shall be removed by the Contractor with the Engineer's approval. Trees and shrubs which are not in direct conflict with proposed new construction shall be saved and protected from damage.

5. The Contractor shall give all property owners and/or tenants of developed property abutting the construction of this project a minimum of ten (10) days notice prior to start of construction.

6. The Contractor shall be responsible for preserving property irons. The Contractor will be required to re-establish any property irons which are damaged or destroyed by his construction operations. Such irons shall be re-established by a licensed land surveyor in accordance with state laws.

7. All existing and proposed erosion control measures including silt fencing, erosion control mat, straw bales, inlet barriers, and const. entrance shall be maintained throughout construction by the contractor and until project is accepted by the City of Wichita. The on-site engineer shall complete weekly reports on the status of erosion control measures. The contractor shall be required to comply with maintenance and/or replacement of erosion control measures as determined by the on-site engineer until project is accepted by City of Wichita. Maintenance and/or replacement of erosion control measures to be paid by L.S. bid item "Maintain Existing BMP's."

8. All excess excavation shall remain on-site and shall be stockpiled or spread at a location determined by the engineer.

9. All areas disturbed during construction shall be seeded as shown on sheet 11.

10. The Developer for this project is Ritchie Development (316) 684-7300

Storm Water Certification:

These construction plans were prepared in accordance with the current Storm Water Management Regulations as set forth in the City of Wichita's Storm Water Management Ordinance 16.32 and the policies/guidelines presented in the Wichita/Sedgwick County Storm Water Manual.

Disturbed Area = 90.0 ac.
Water Quality Treatment: Provided by ponds in Res. "H" and Res. "J".
Downstream Channel Protection: Provided by pond in Res. "H".

CONSTRUCTION SEQUENCE:

Sanitary sewer construction is currently progressing by Utility Solutions of Kansas (internal sewer) and by McCullough Excavation (Lift Station and Mains) with completion occurring from south to north. Grading, Water Line, and Storm Sewer construction will be allowed in the following areas and adjacent street rights-of-way immediately.

- 1) Reserve "J" pond excavation
 - 2) Lots 39, Blk A
 - 3) Lots 6-11, Blk B
 - 4) Lots 52-84, Blk E
 - 5) Reserve "H" pond excavation except near Lots 45-51, Blk E.
- As additional parts of the sanitary sewer project are completed, additional area will be available for Grading, Water Line, and Storm Sewer work. Bidding Contractors may contact Engineer for up-to-date schedule and phasing of the Sanitary Sewer project prior to bid letting.

SHEET INDEX

Title Sheet	1
SWS Line 1 & Line 2	2
SWS Line 3	3-4
SWS Line 4 & Line 5	5
SWS Line 6 & Line 7	6
Mass Grading Plan	7-9
Res. "H" Pond Plan	10
Res. "J" Pond Plan	11
Erosion Control BMP Details	12-16
Mass Grading Typical Section	17
Std. Type 1A Curb Inlet Detail	18
Precast Manhole Detail	19
Single/Double Drop Inlet Detail	20
Frame & Cover Detail	21
Inlet Manhole Detail	22
Coordinate Sheet	23-24
Copy of Plat	25-26



EARTH WORK TOTALS (Unadjusted)

Project Totals	C.Y. EXCAVATION	C.Y. FILL
	216,257	199,422

Earthwork Quantities reflect the best available topography. The Contractor shall satisfy himself with the earthwork quantities as bid for L.S. bid item "Grading, Mass" prior to bidding. No additional payments or change orders for earthwork will be accepted.


STORMWATER DRAIN #417 to serve BROOKFIELD ADDITION - PHASE I CITY OF WICHITA, KANSAS

Gary Janzen, P.E. City Engineer
Project Number 468 - 85177
OCA Number 751555

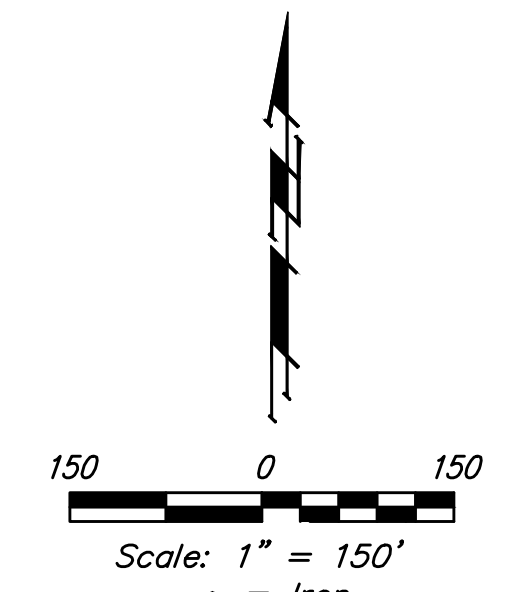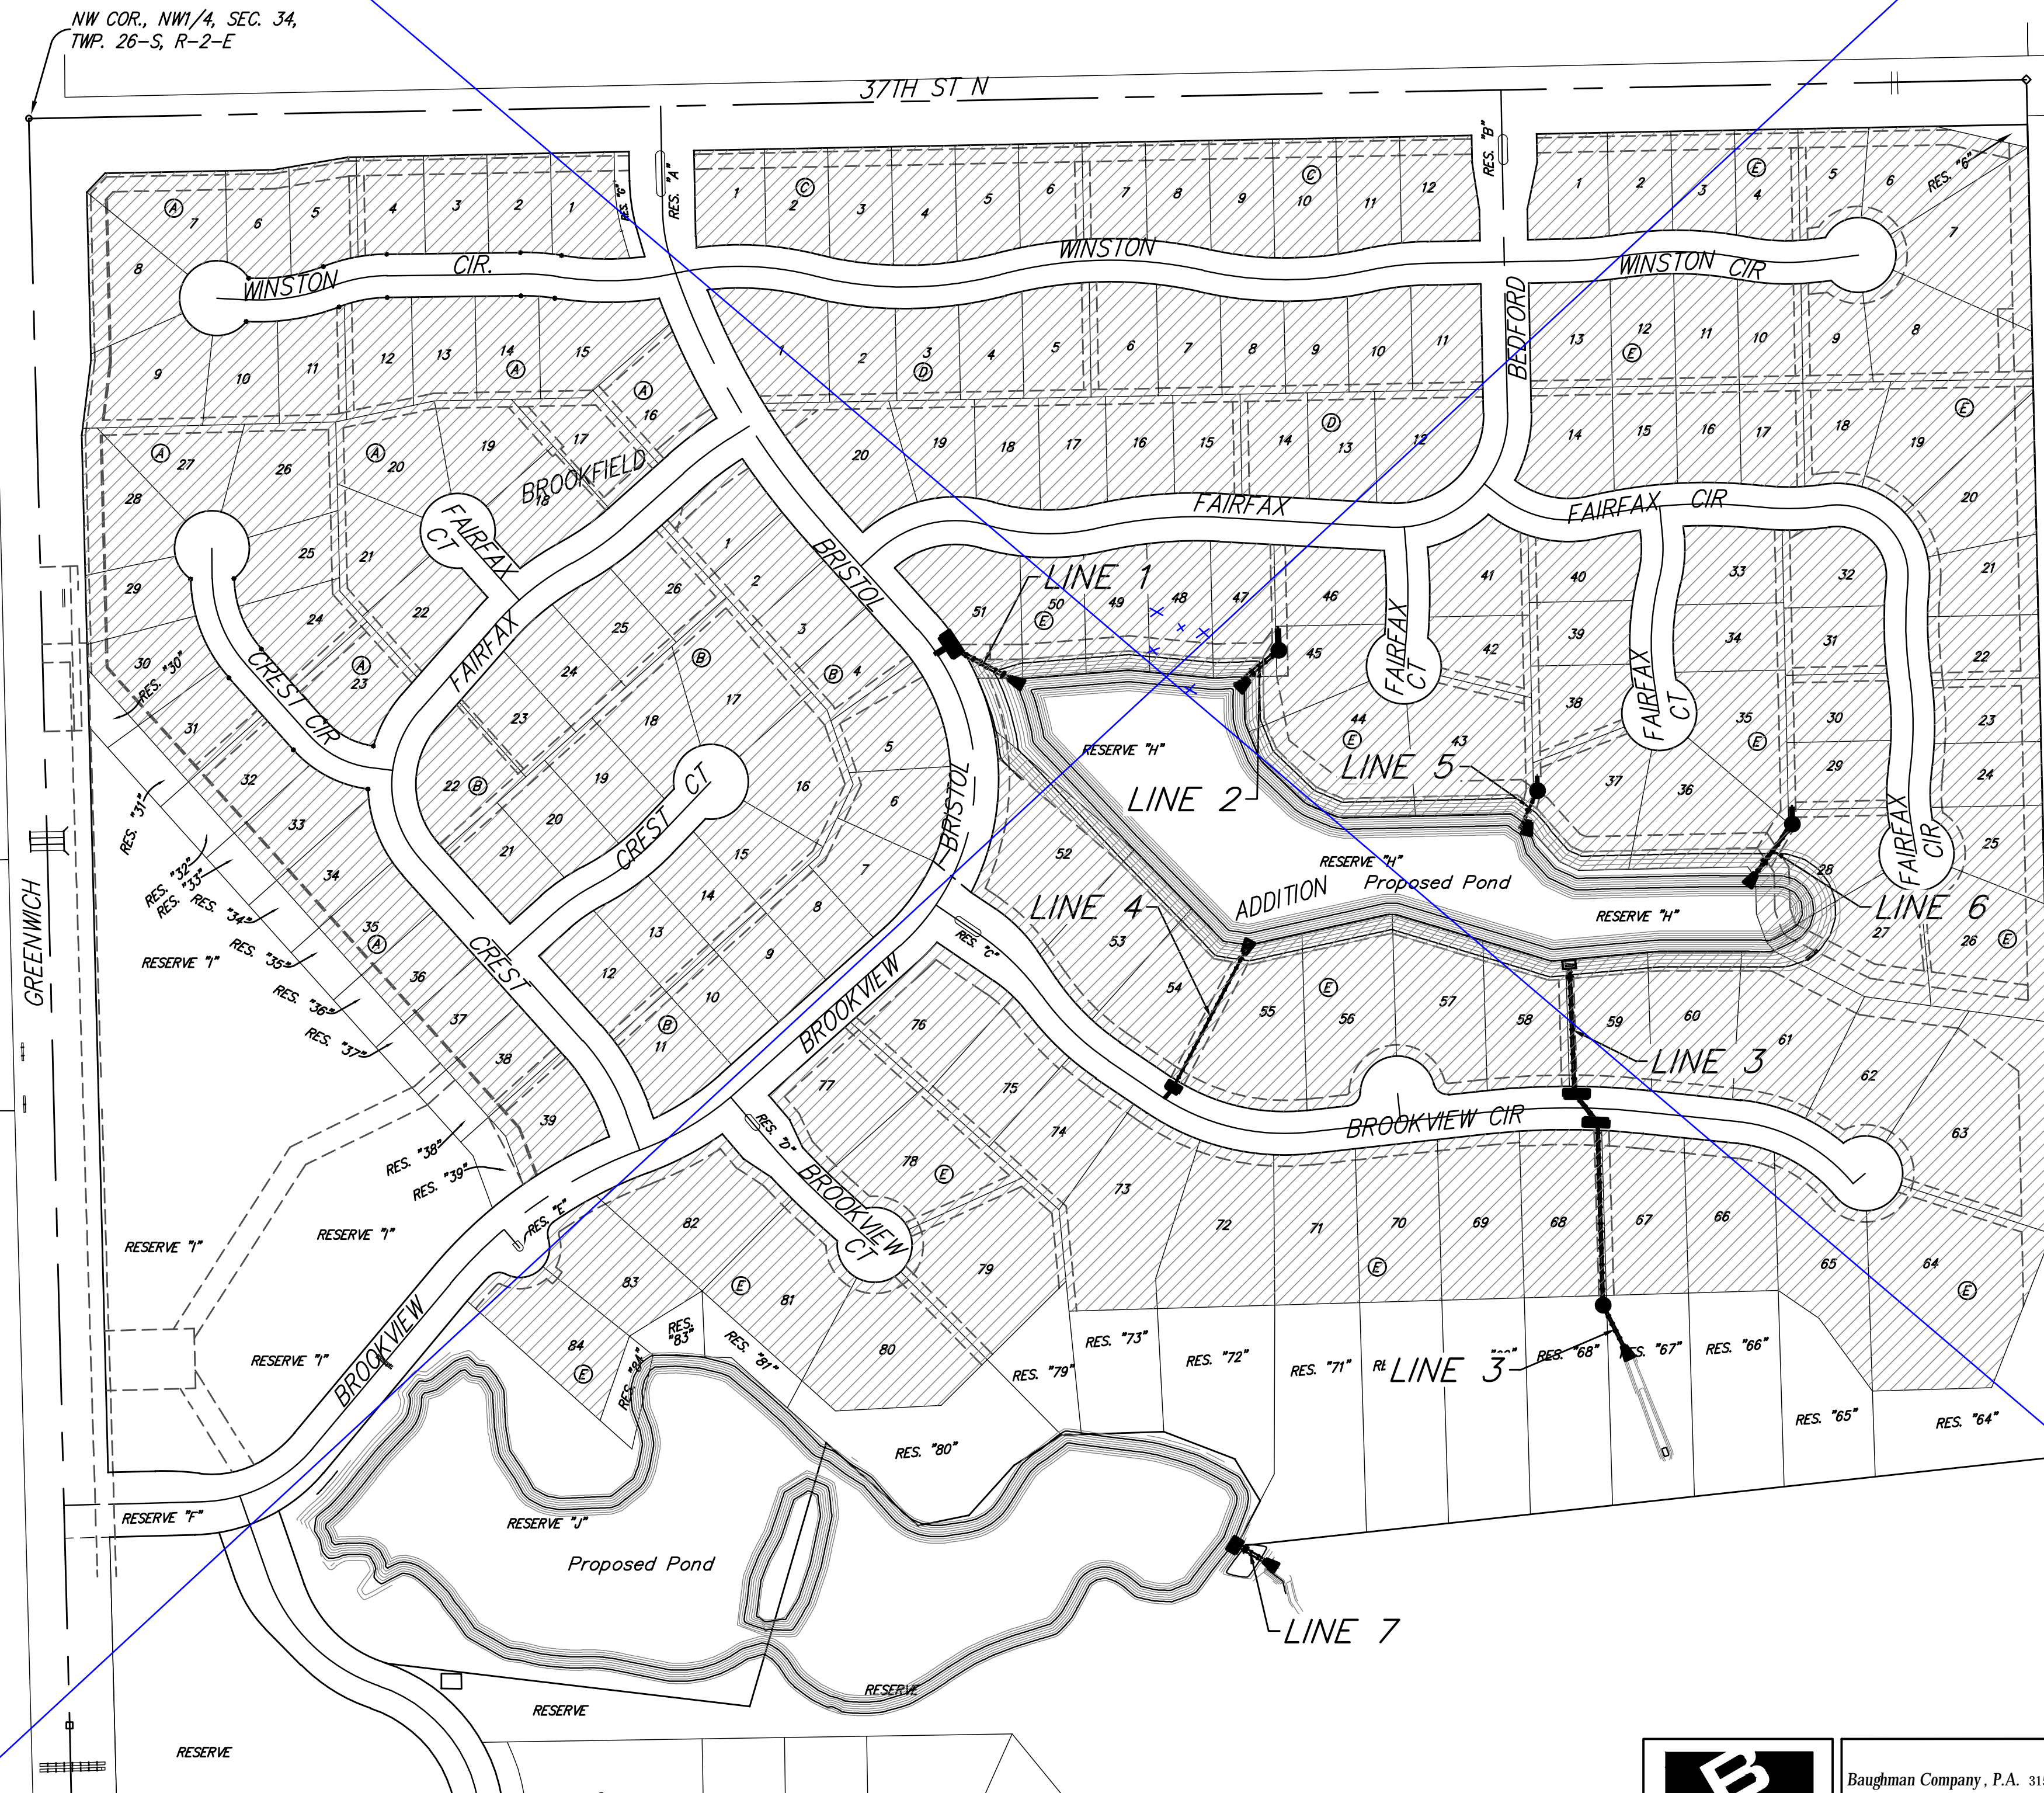

BENCHMARKS

- RR spike in asphalt, SW COR., N1/2, SW1/4, Sec. 34, TWP. 26-S, R-2-E. Elev. = 1400.59 NAVD88
- RR spike in E. face of power pole, 174± N. of S. line, N1/2, SW1/4 & 49± E. of W. line, SW1/4, Sec. 34, TWP. 26-S, R-2-E. Elev. = 1398.64 NAVD88
- RR spike in S. face of power pole, 294± S. of N. line, SW1/4, & 48± E. of W. line, SW1/4, Sec. 34, TWP. 26-S, R-2-E. Elev. = 1386.14 NAVD88

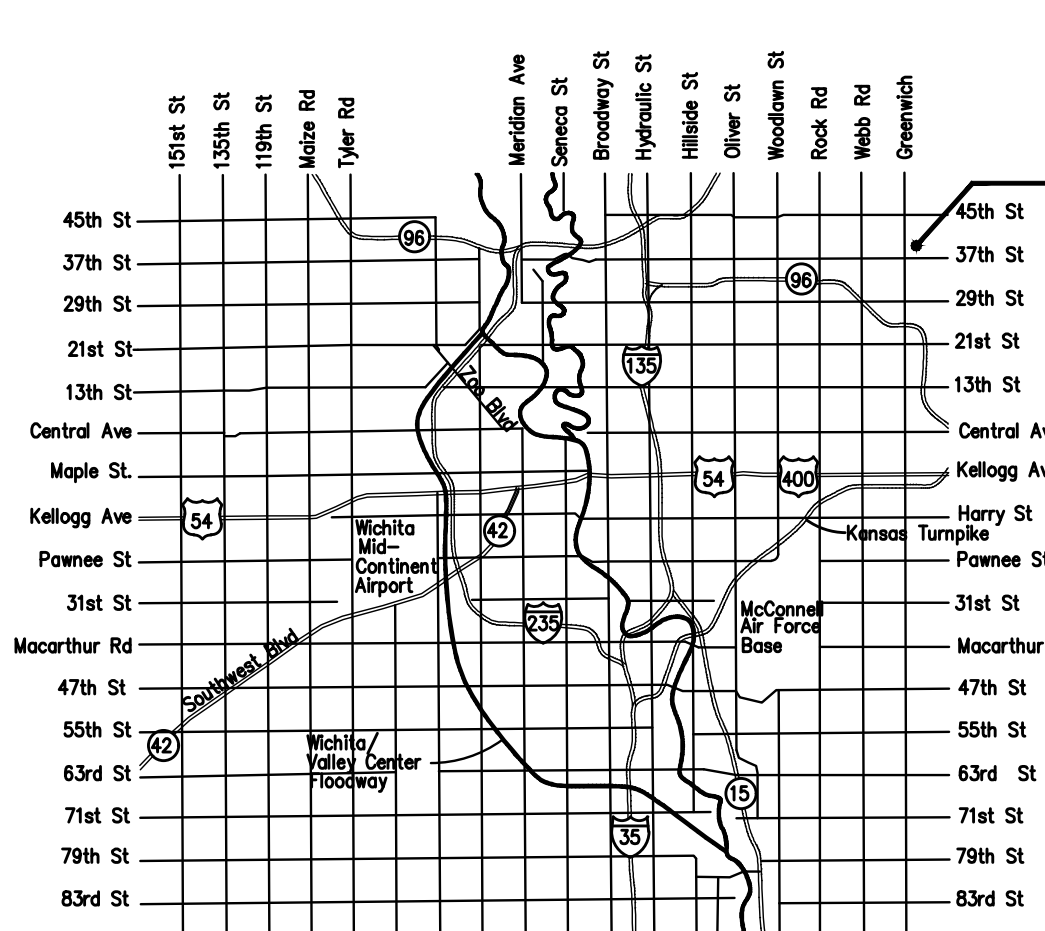

Vicinity Map

BENEFIT DISTRICT

VOID - SEE SHEET 1R



Baughman
Baughman Company, P.A. 315 Ellis St. Wichita, KS 67211 P 316-262-7271 F 316-262-0149
ENGINEERING | SURVEYING | PLANNING | LANDSCAPE ARCHITECTURE

GENERAL NOTES:

1. Contractor will be required to provide notice to utility companies a minimum of forty-eight (48) hours prior to any excavation, as follows:

- Kansas One-Call 687-2470
- The Contractor must notify the following in case of an emergency:
- Cox Communications 262-4270
 - Kansas Gas Service 1-888-482-4950
 - Westar Energy 383-8650
 - Aquila Energy 1-800-303-0357
 - AT&T 268-2245
 - City of Wichita Water Dept. 268-4563
 - City of Wichita Sewer Maint. 268-4024
 - City of Wichita Storm Sewer Maint. 268-4090
 - City of Wichita Traffic Maint. 268-4034
 - Conoco Phillips Pipeline Co. 1-877-267-2290
 - Southern Star Pipeline Co. 529-6600
 - Kinder-Morgan Pipeline Co. 1-888-844-5658

2. Utility service lines, poles, valve boxes, meters, and etcetera are to be adjusted as necessary by others prior to construction unless the plans specifically call for their adjustment by the Contractor or unless the plans specifically identify a utility to be adjusted by its owner during construction. Existing utilities and their location, as shown on the plans, represent the best information obtainable for design. The Contractor will be required to work around existing utilities within the right-of-way which do not conflict with proposed construction.

3. Rubble from the removal of miscellaneous structures and excess excavation which is to be wasted shall be disposed of on sites to be provided by the Contractor. These sites shall be approved by the Engineer as to suitability, appearance and site location. Locations, in the opinion of the Engineer, that will leave an unsightly appearance will not be approved. All disposal sites must be approved by the Kansas Department of Health and Environment. Material either stockpiled or disposed of in a flood plain would require a Kansas State Board of Agriculture permit. Any material dumped in waters of the United States or wetlands is subject to U.S. Corps of Engineers permitting regulations. Any material buried or stockpiled beyond approved construction limits would require additional archaeological investigations unless buried in a previously approved borrow location.

4. Trees and shrubs in public right-of-way which are in direct conflict with proposed new construction shall be removed by the Contractor with the Engineer's approval. Trees and shrubs which are not in direct conflict with proposed new construction shall be saved and protected from damage.

5. The Contractor shall give all property owners and/or tenants of developed property abutting the construction of this project a minimum of ten (10) days notice prior to start of construction.

6. The Contractor shall be responsible for preserving property irons. The Contractor will be required to re-establish any property irons which are damaged or destroyed by his construction operations. Such irons shall be re-established by a licensed land surveyor in accordance with state laws.

7. All existing and proposed erosion control measures including silt fencing, erosion control mat, straw bales, inlet barriers, and const. entrance shall be maintained throughout construction by the contractor and until project is accepted by the City of Wichita. The on-site engineer shall complete weekly reports on the status of erosion control measures. The contractor shall be required to comply with maintenance and/or replacement of erosion control measures as determined by the on-site engineer until project is accepted by City of Wichita. Maintenance and/or replacement of erosion control measures to be paid by L.S. bid item "Maintain Existing BMP's."

8. All excess excavation shall remain on-site and shall be stockpiled or spread at a location determined by the engineer.

9. All areas disturbed during construction shall be seeded as shown on sheet 11.

10. The Developer for this project is Ritchie Development (316) 684-7300

Storm Water Certification:

These construction plans were prepared in accordance with the current Storm Water Management Regulations as set forth in the City of Wichita's Storm Water Management Ordinance 16.32 and the policies/guidelines presented in the Wichita/Sedgwick County Storm Water Manual.

Disturbed Area = 90.0 ac.

Water Quality Treatment: Provided by ponds in Res. "H" and Res. "J".

Downstream Channel Protection: Provided by pond in Res. "H".

CONSTRUCTION SEQUENCE:

Sanitary sewer construction is currently progressing by Utility Solutions of Kansas (internal sewer) and by McCullough Excavation (Lift Station and Mains) with completion occurring from south to north. Grading, Water Line, and Storm Sewer construction will be allowed in the following areas and adjacent street rights-of-way immediately.

- 1) Reserve "J" pond excavation
- 2) Lots 39, Blk A
- 3) Lots 6-11, Blk B
- 4) Lots 52-84, Blk E
- 5) Reserve "H" pond excavation except near Lots 45-51, Blk E.

As additional parts of the sanitary sewer project are completed, additional area will be available for Grading, Water Line, and Storm Sewer work. Bidding Contractors may contact Engineer for up-to-date schedule and phasing of the Sanitary Sewer project prior to bid letting.

SHEET INDEX

Title Sheet	1
SWS Line 1 & Line 2	2
SWS Line 3	3-4
SWS Line 4 & Line 5	5
SWS Lines 6, 7, & 8	6
Mass Grading Plan	7-9
Res. "H" Pond Plan	10
Res. "J" Pond Plan	11
Erosion Control BMP Details	12-16
Mass Grading Typical Section	17
Std. Type 1A Curb Inlet Detail	18
Precast Manhole Detail	19
Single/Double Drop Inlet Detail	20
Frame & Cover Detail	21
Inlet Manhole Detail	22
Coordinate Sheet	23-24
Copy of Plat	25-26

EARTH WORK TOTALS (Unadjusted)

Project Totals	C.Y. EXCAVATION	C.Y. FILL
	216,257	199,422

Earthwork Quantities reflect the best available topography. The Contractor shall satisfy himself with the earthwork quantities as bid for L.S. bid item "Grading, Mass" prior to bidding. No additional payments or change orders for earthwork will be accepted.

STORMWATER DRAIN #417

to serve

BROOKFIELD ADDITION - PHASE I

CITY OF WICHITA, KANSAS



Gary Janzen, P.E. City Engineer

Project Number 468 - 85177

OCA Number 751555

AS BUILT PLANS

Contractor: Unruh Excavating
Inspector: David VanSickle, Baughman Co.
As Builts by: KEK, 2/21/18

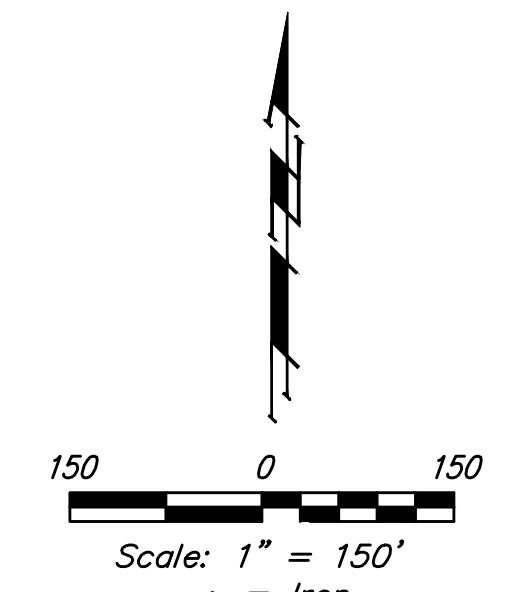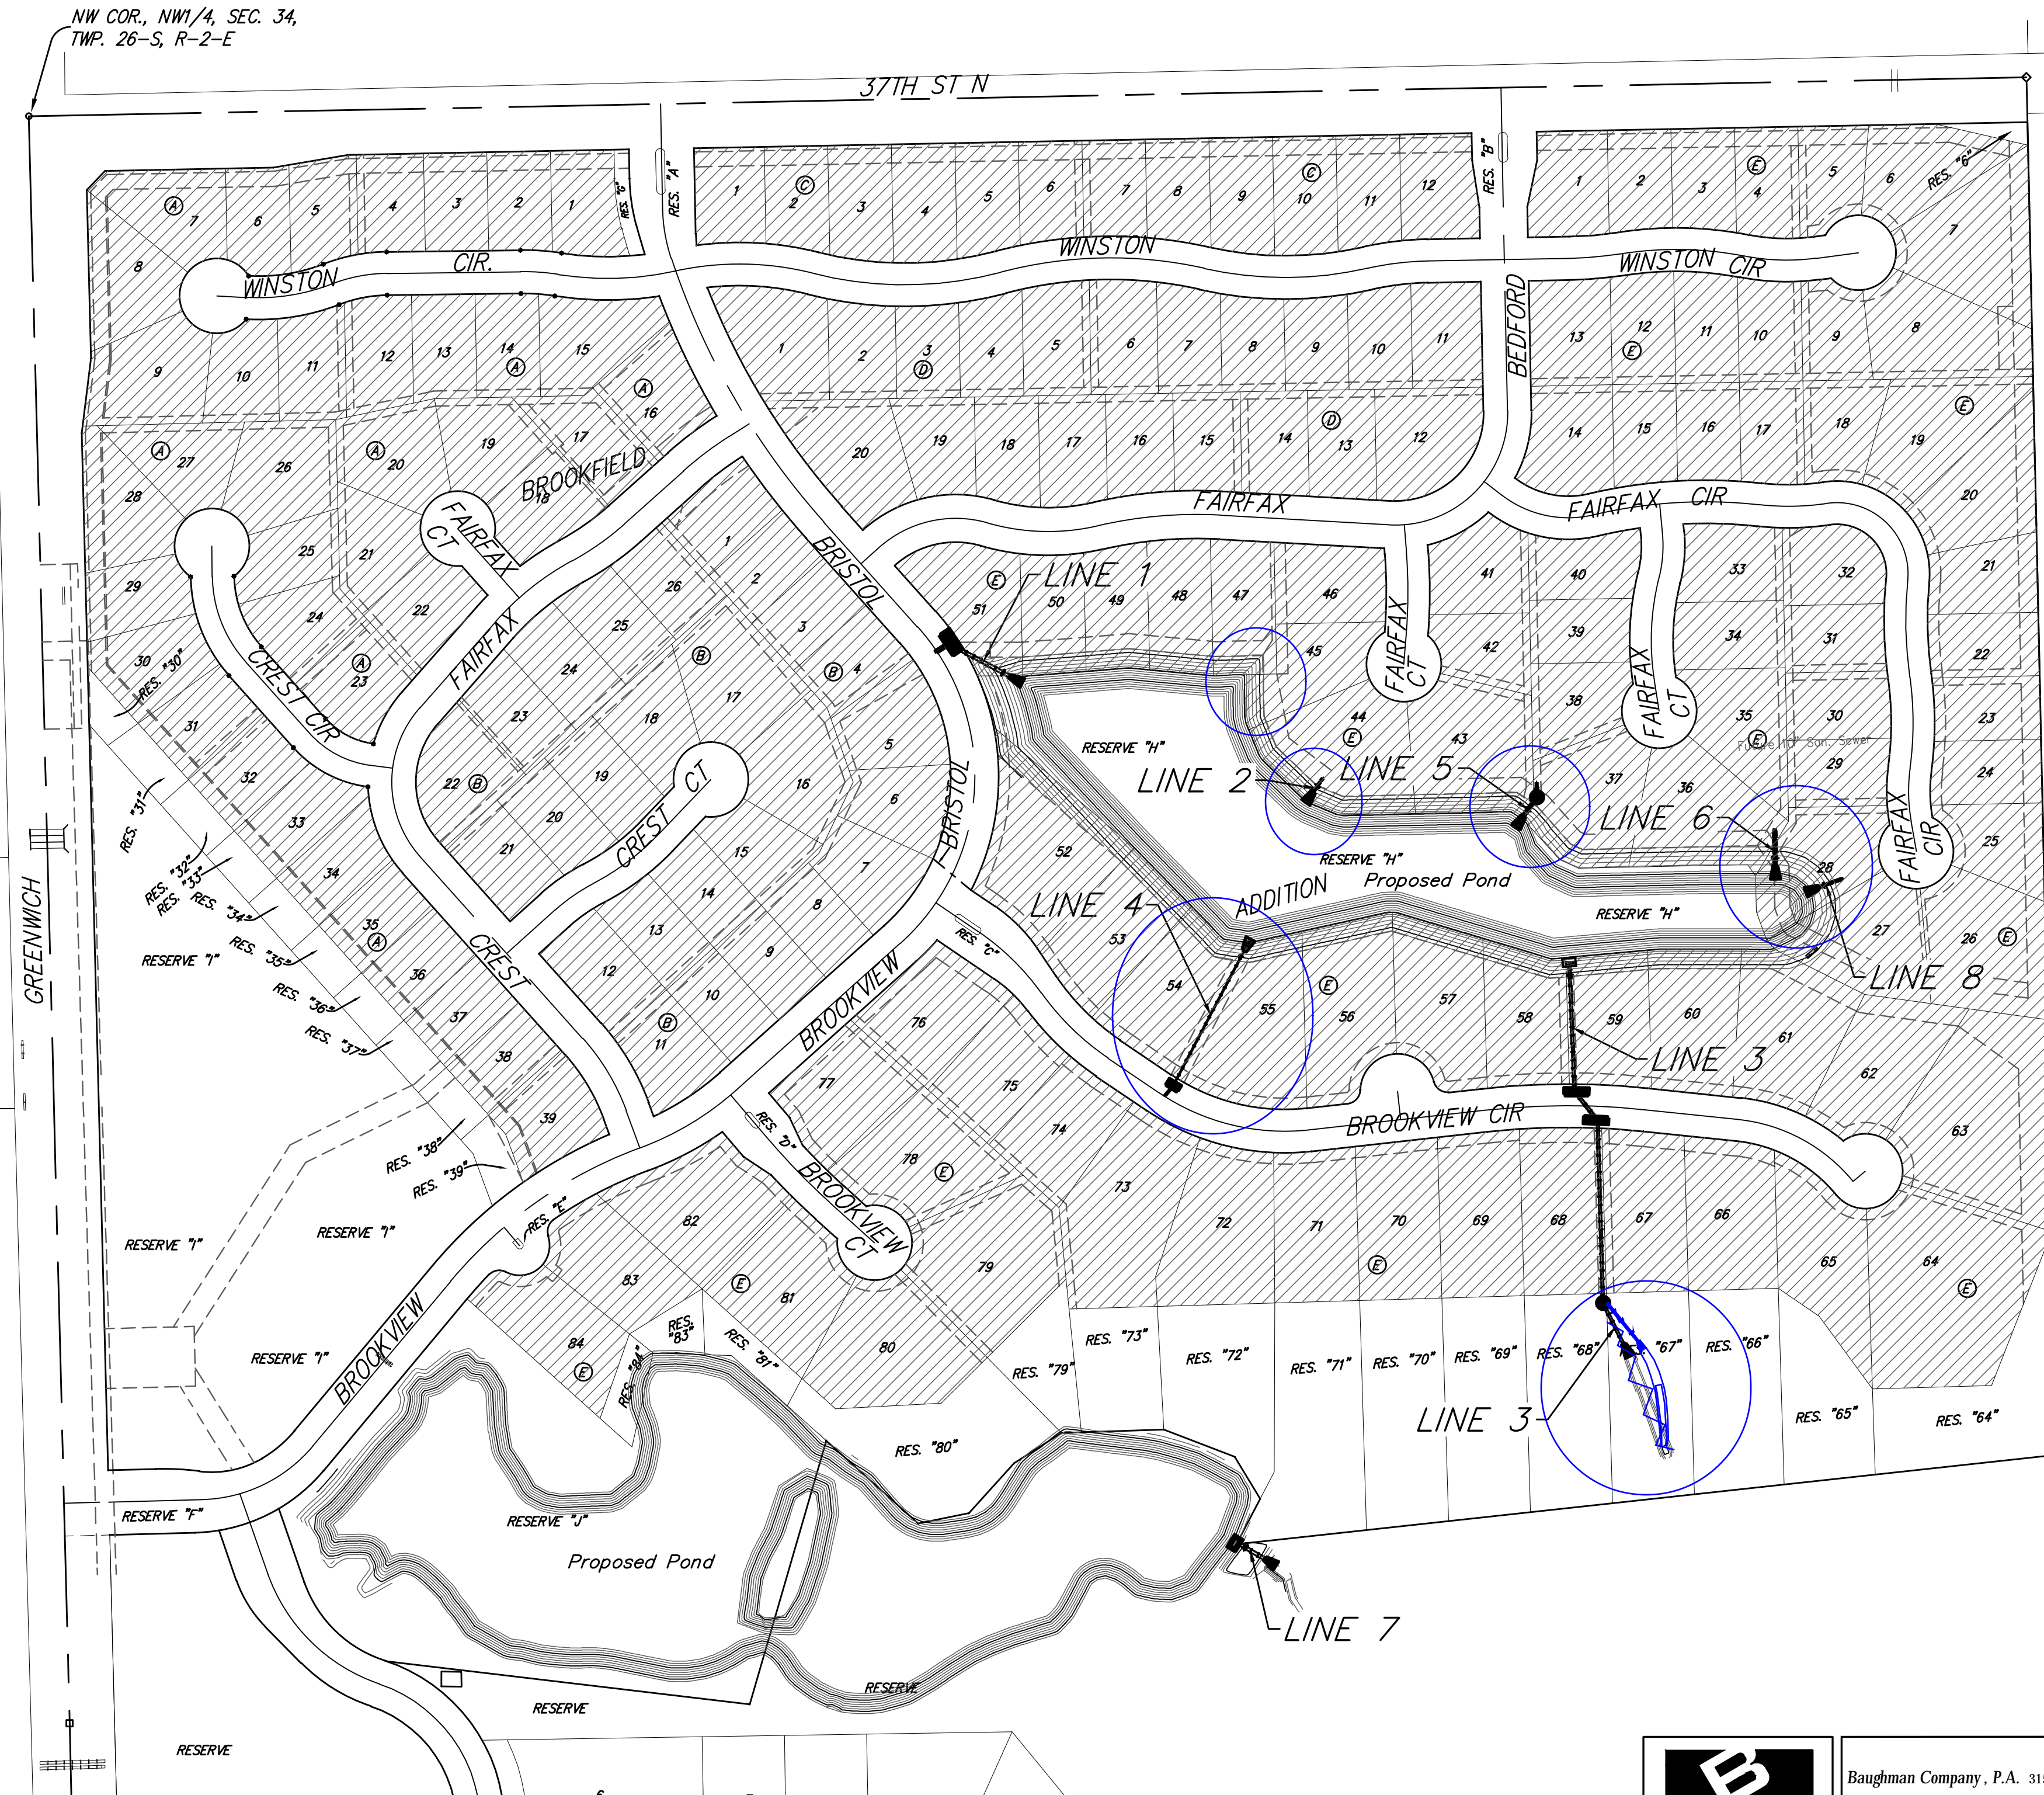


BENCHMARKS

RR spike in asphalt, SW COR., N1/2, SW1/4, Sec. 34, TWP. 26-S, R-2-E. Elev. = 1400.59 NAVD88

RR spike in E. face of power pole, 174± N. of S. line, N1/2, SW1/4 & 49± E. of W. line, SW1/4, Sec. 34, TWP. 26-S, R-2-E. Elev. = 1398.64 NAVD88

RR spike in S. face of power pole, 294± S. of N. line, SW1/4, & 48± E. of W. line, SW1/4, Sec. 34, TWP. 26-S, R-2-E. Elev. = 1386.14 NAVD88

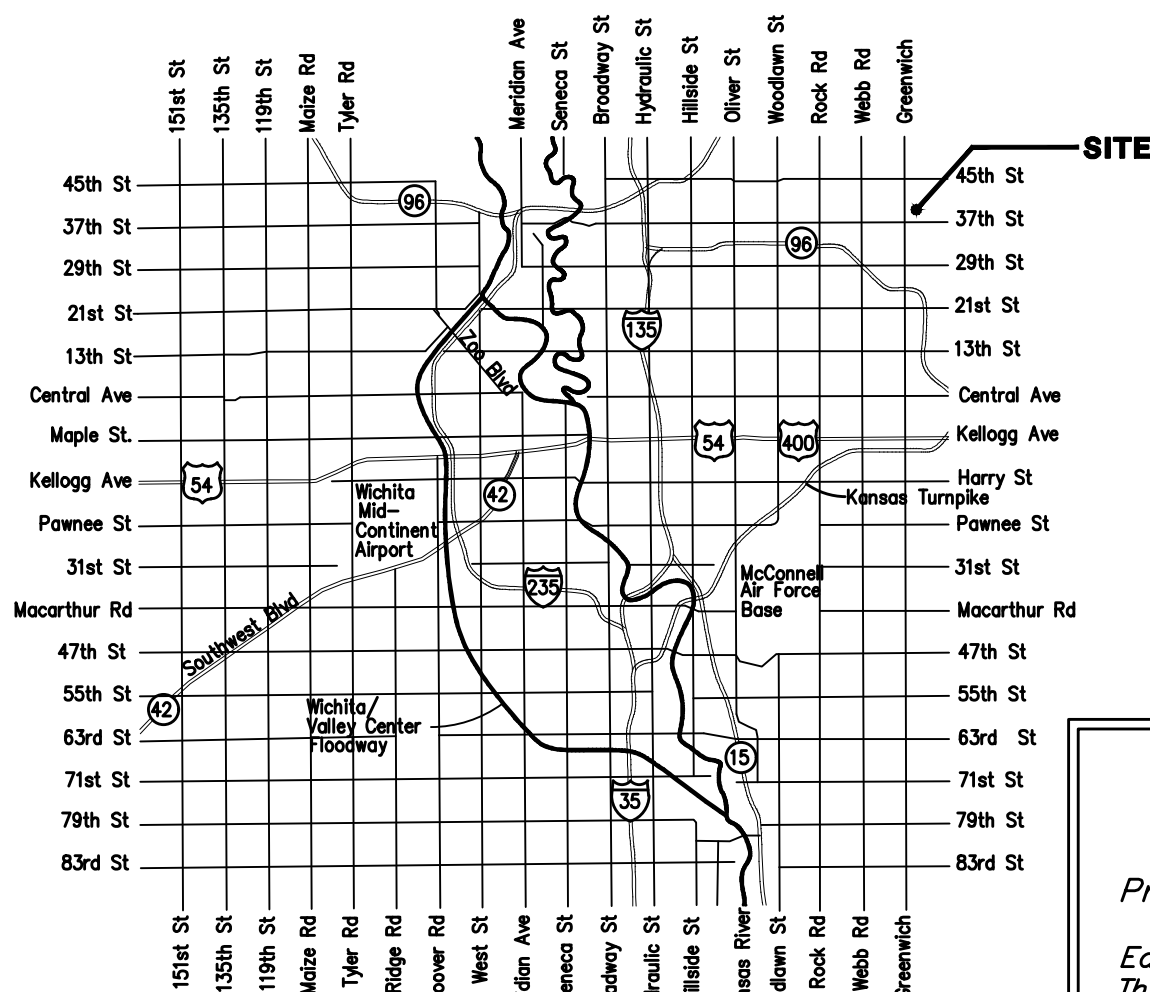

Vicinity Map

BENEFIT DISTRICT








Baughman Company, P.A. 315 Ellis St. Wichita, KS 67211 P 316-262-7271 F 316-262-0149
ENGINEERING | SURVEYING | PLANNING | LANDSCAPE ARCHITECTURE

BENCHMARKS:
 RR spike in asphalt, SW COR., N1/2, SW1/4, Sec. 34, TWP. 26-S, R-2-E. Elev. = 1400.59 NAVD88

RR spike in E. face of power pole, 174± N. of S. line, N1/2, SW1/4 & 49± E. of W. line, SW1/4, Sec. 34, TWP. 26-S, R-2-E. Elev. = 1398.64 NAVD88






RR spike in S. face of power pole, 294± S. of N. line, SW1/4, & 48± E. of W. line, SW1/4, Sec. 34, TWP. 26-S, R-2-E. Elev. = 1386.14 NAVD88

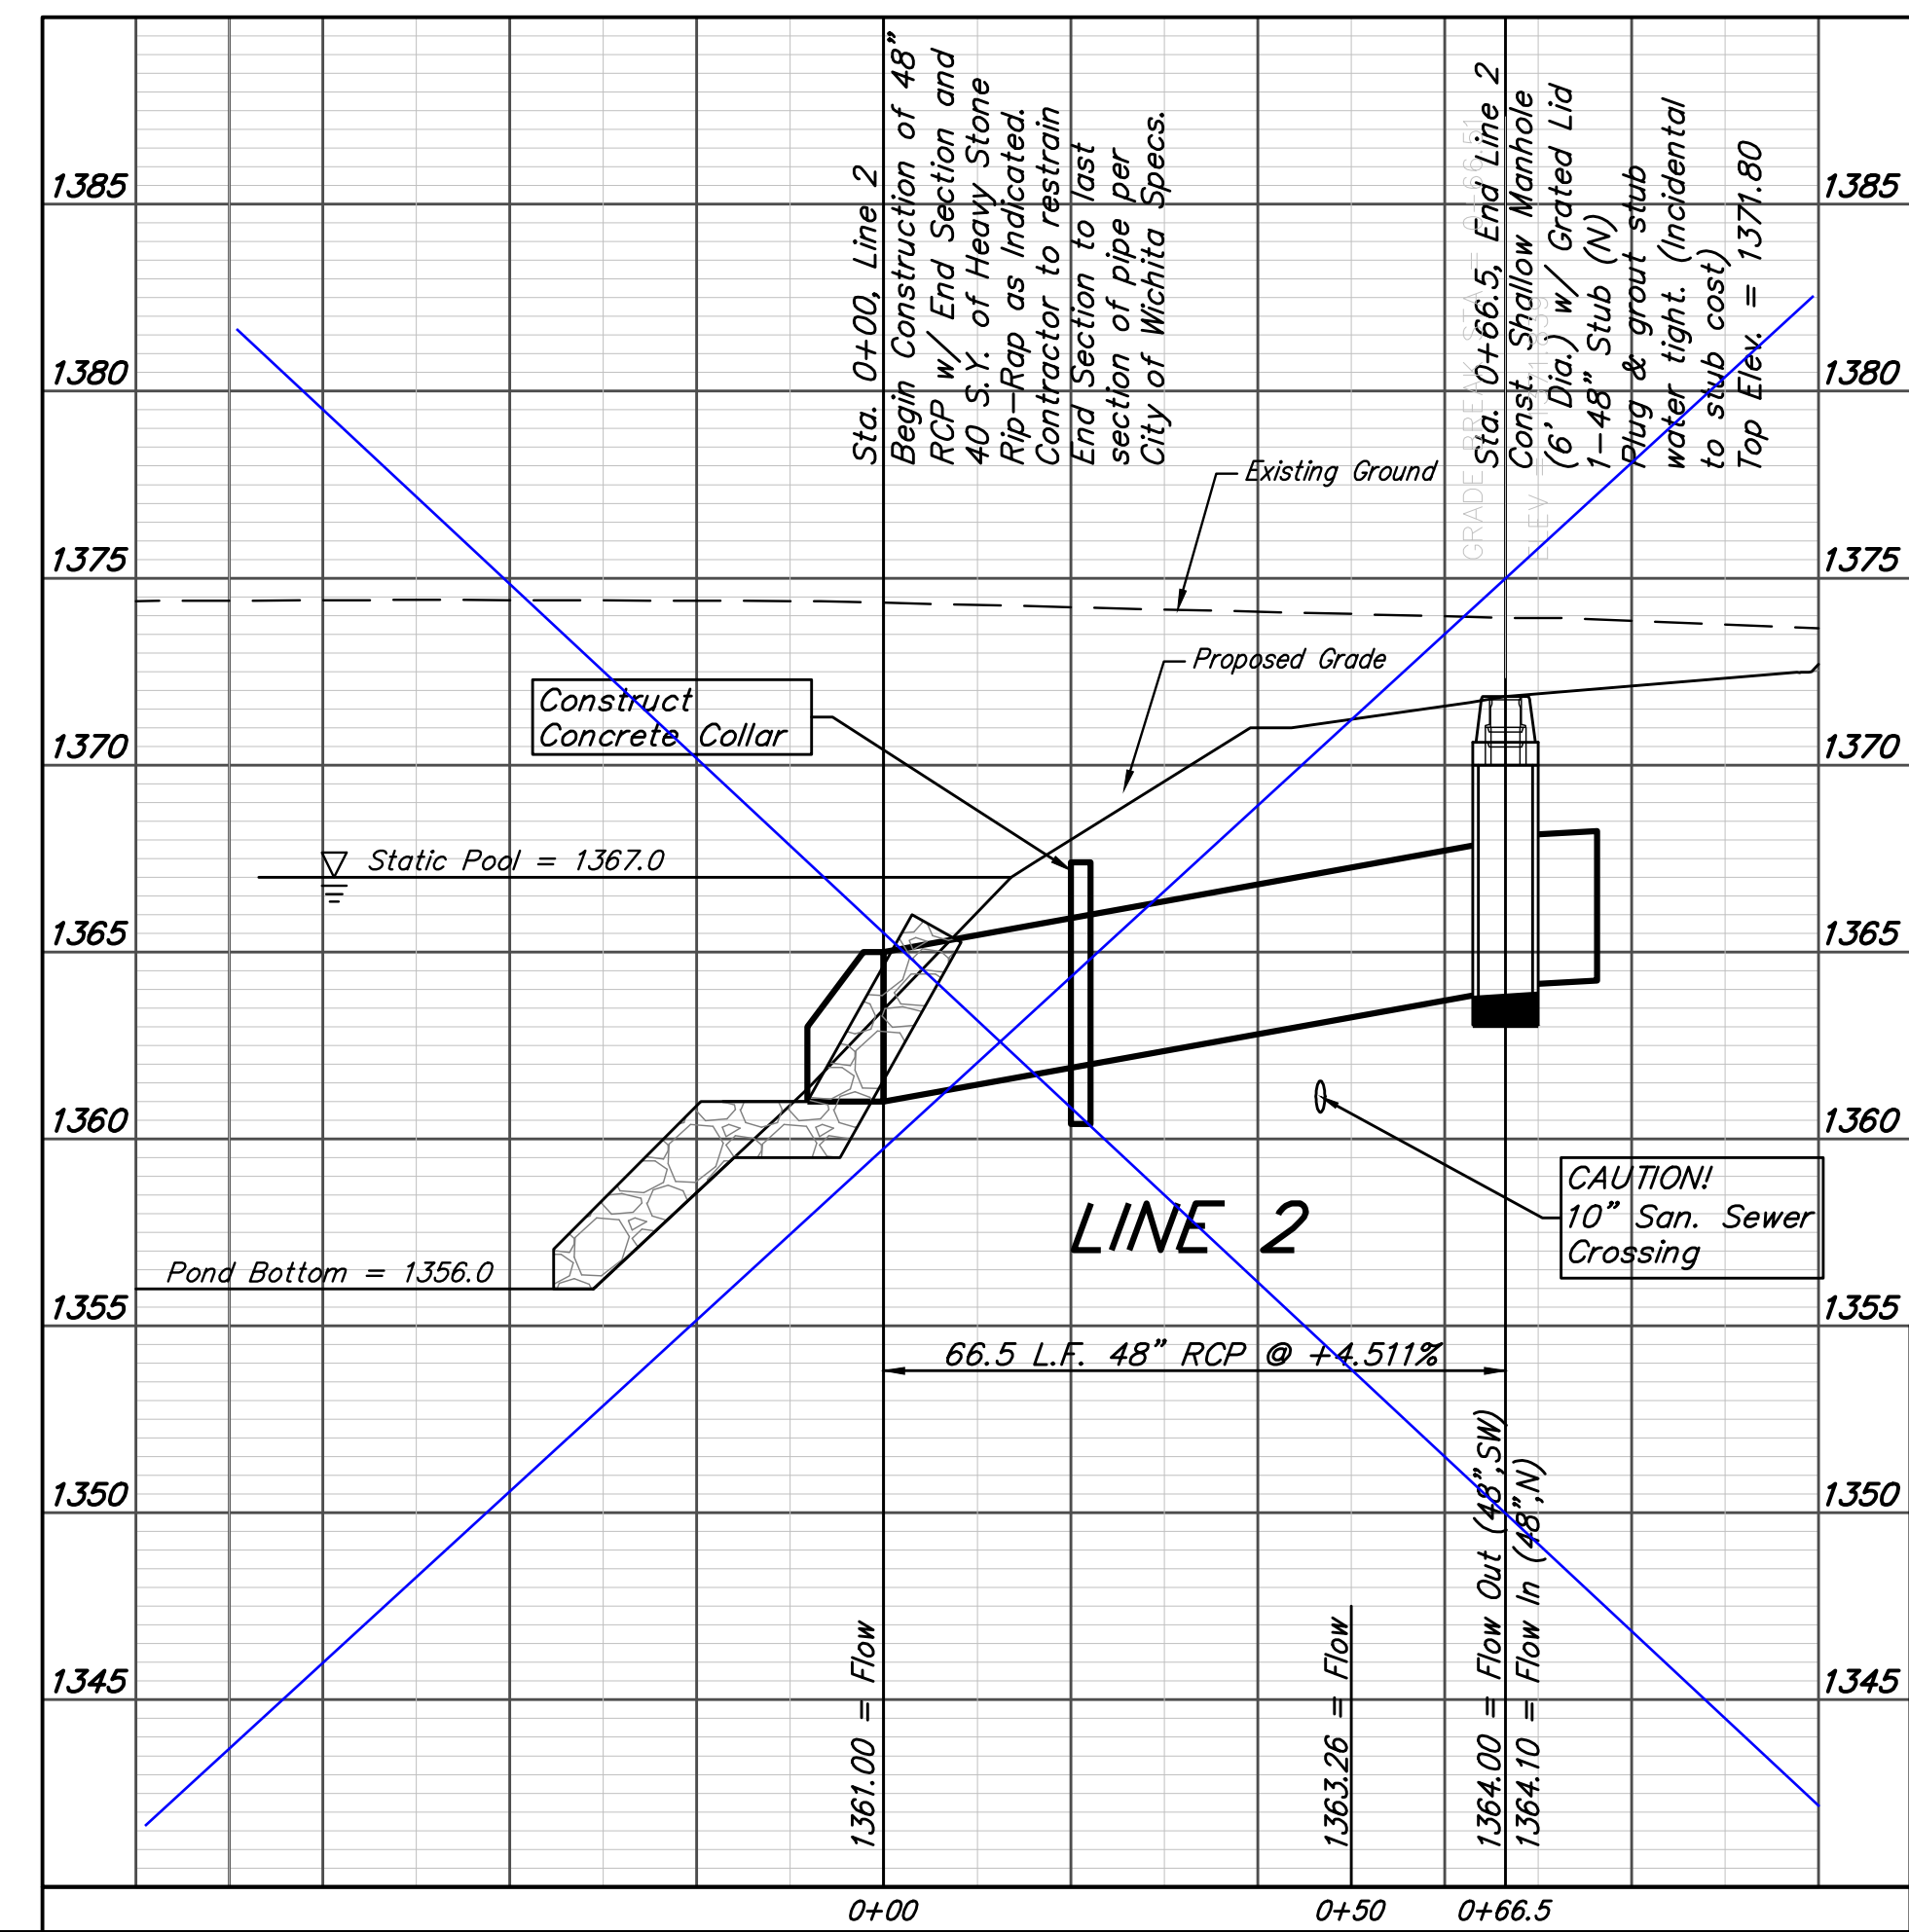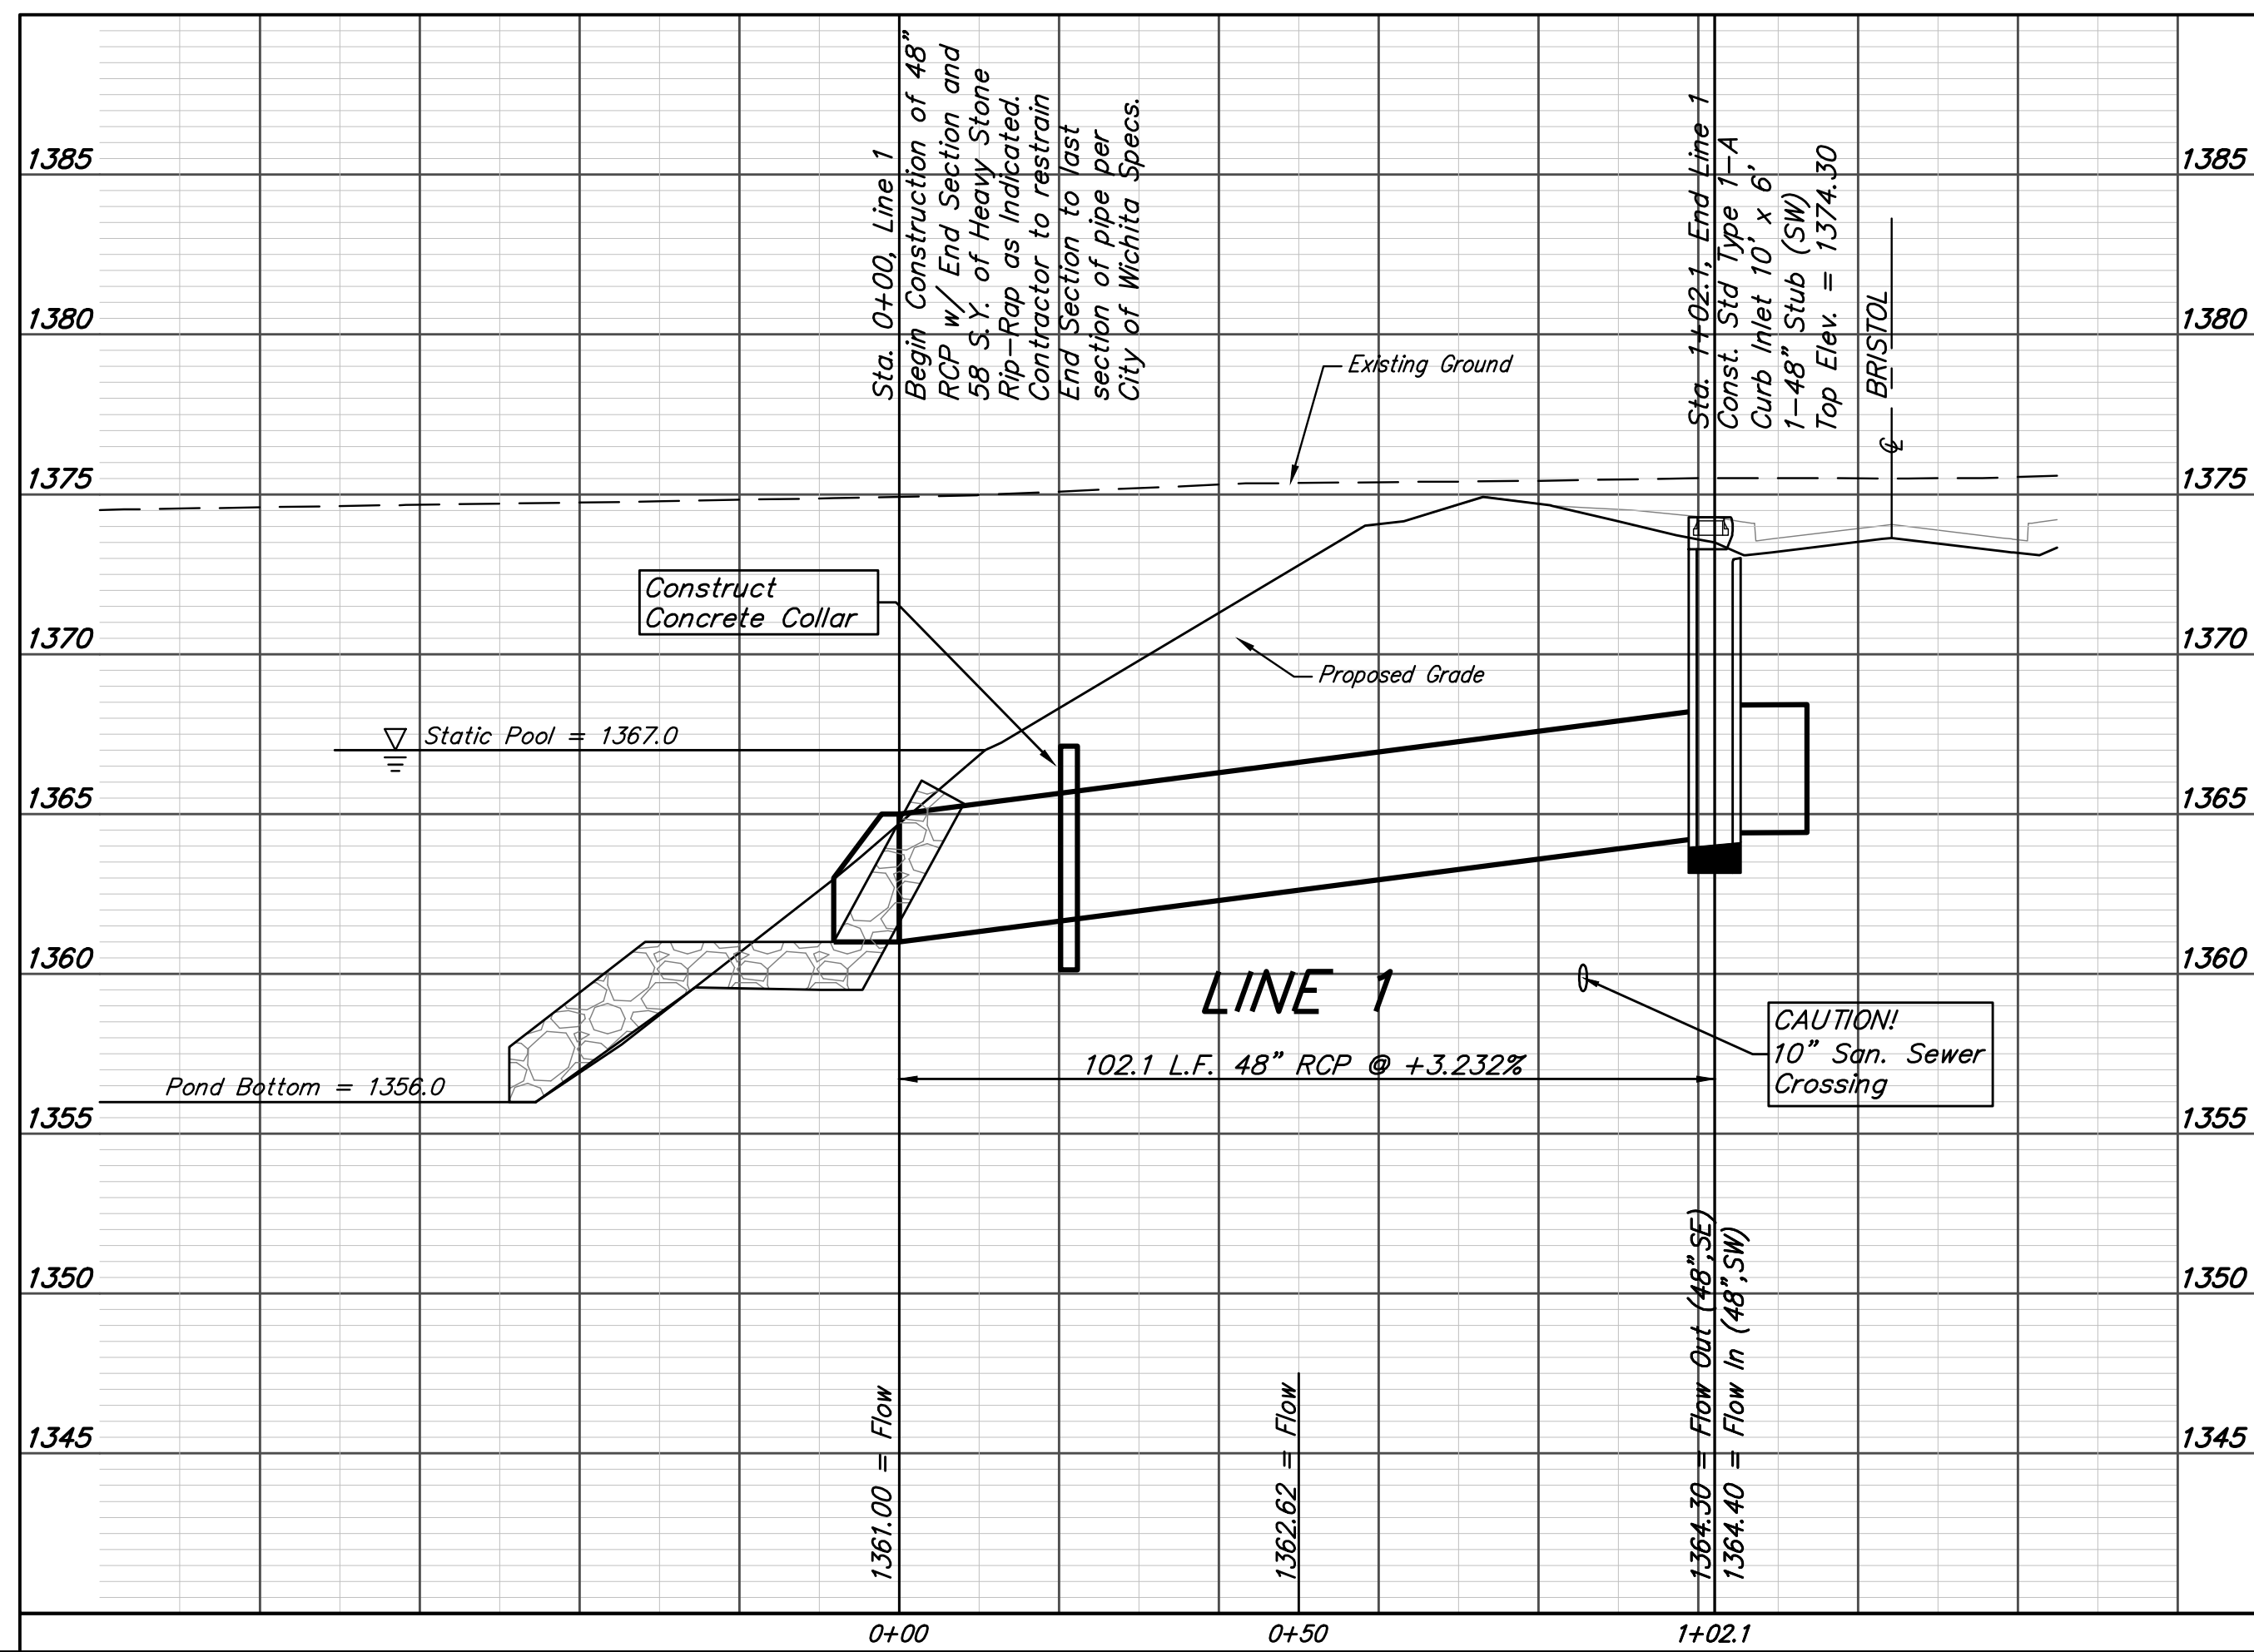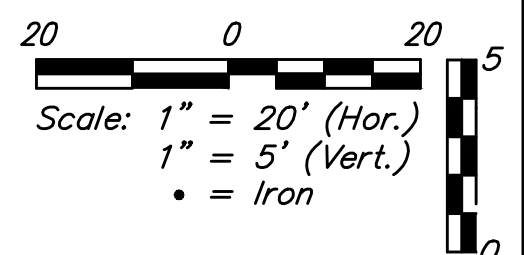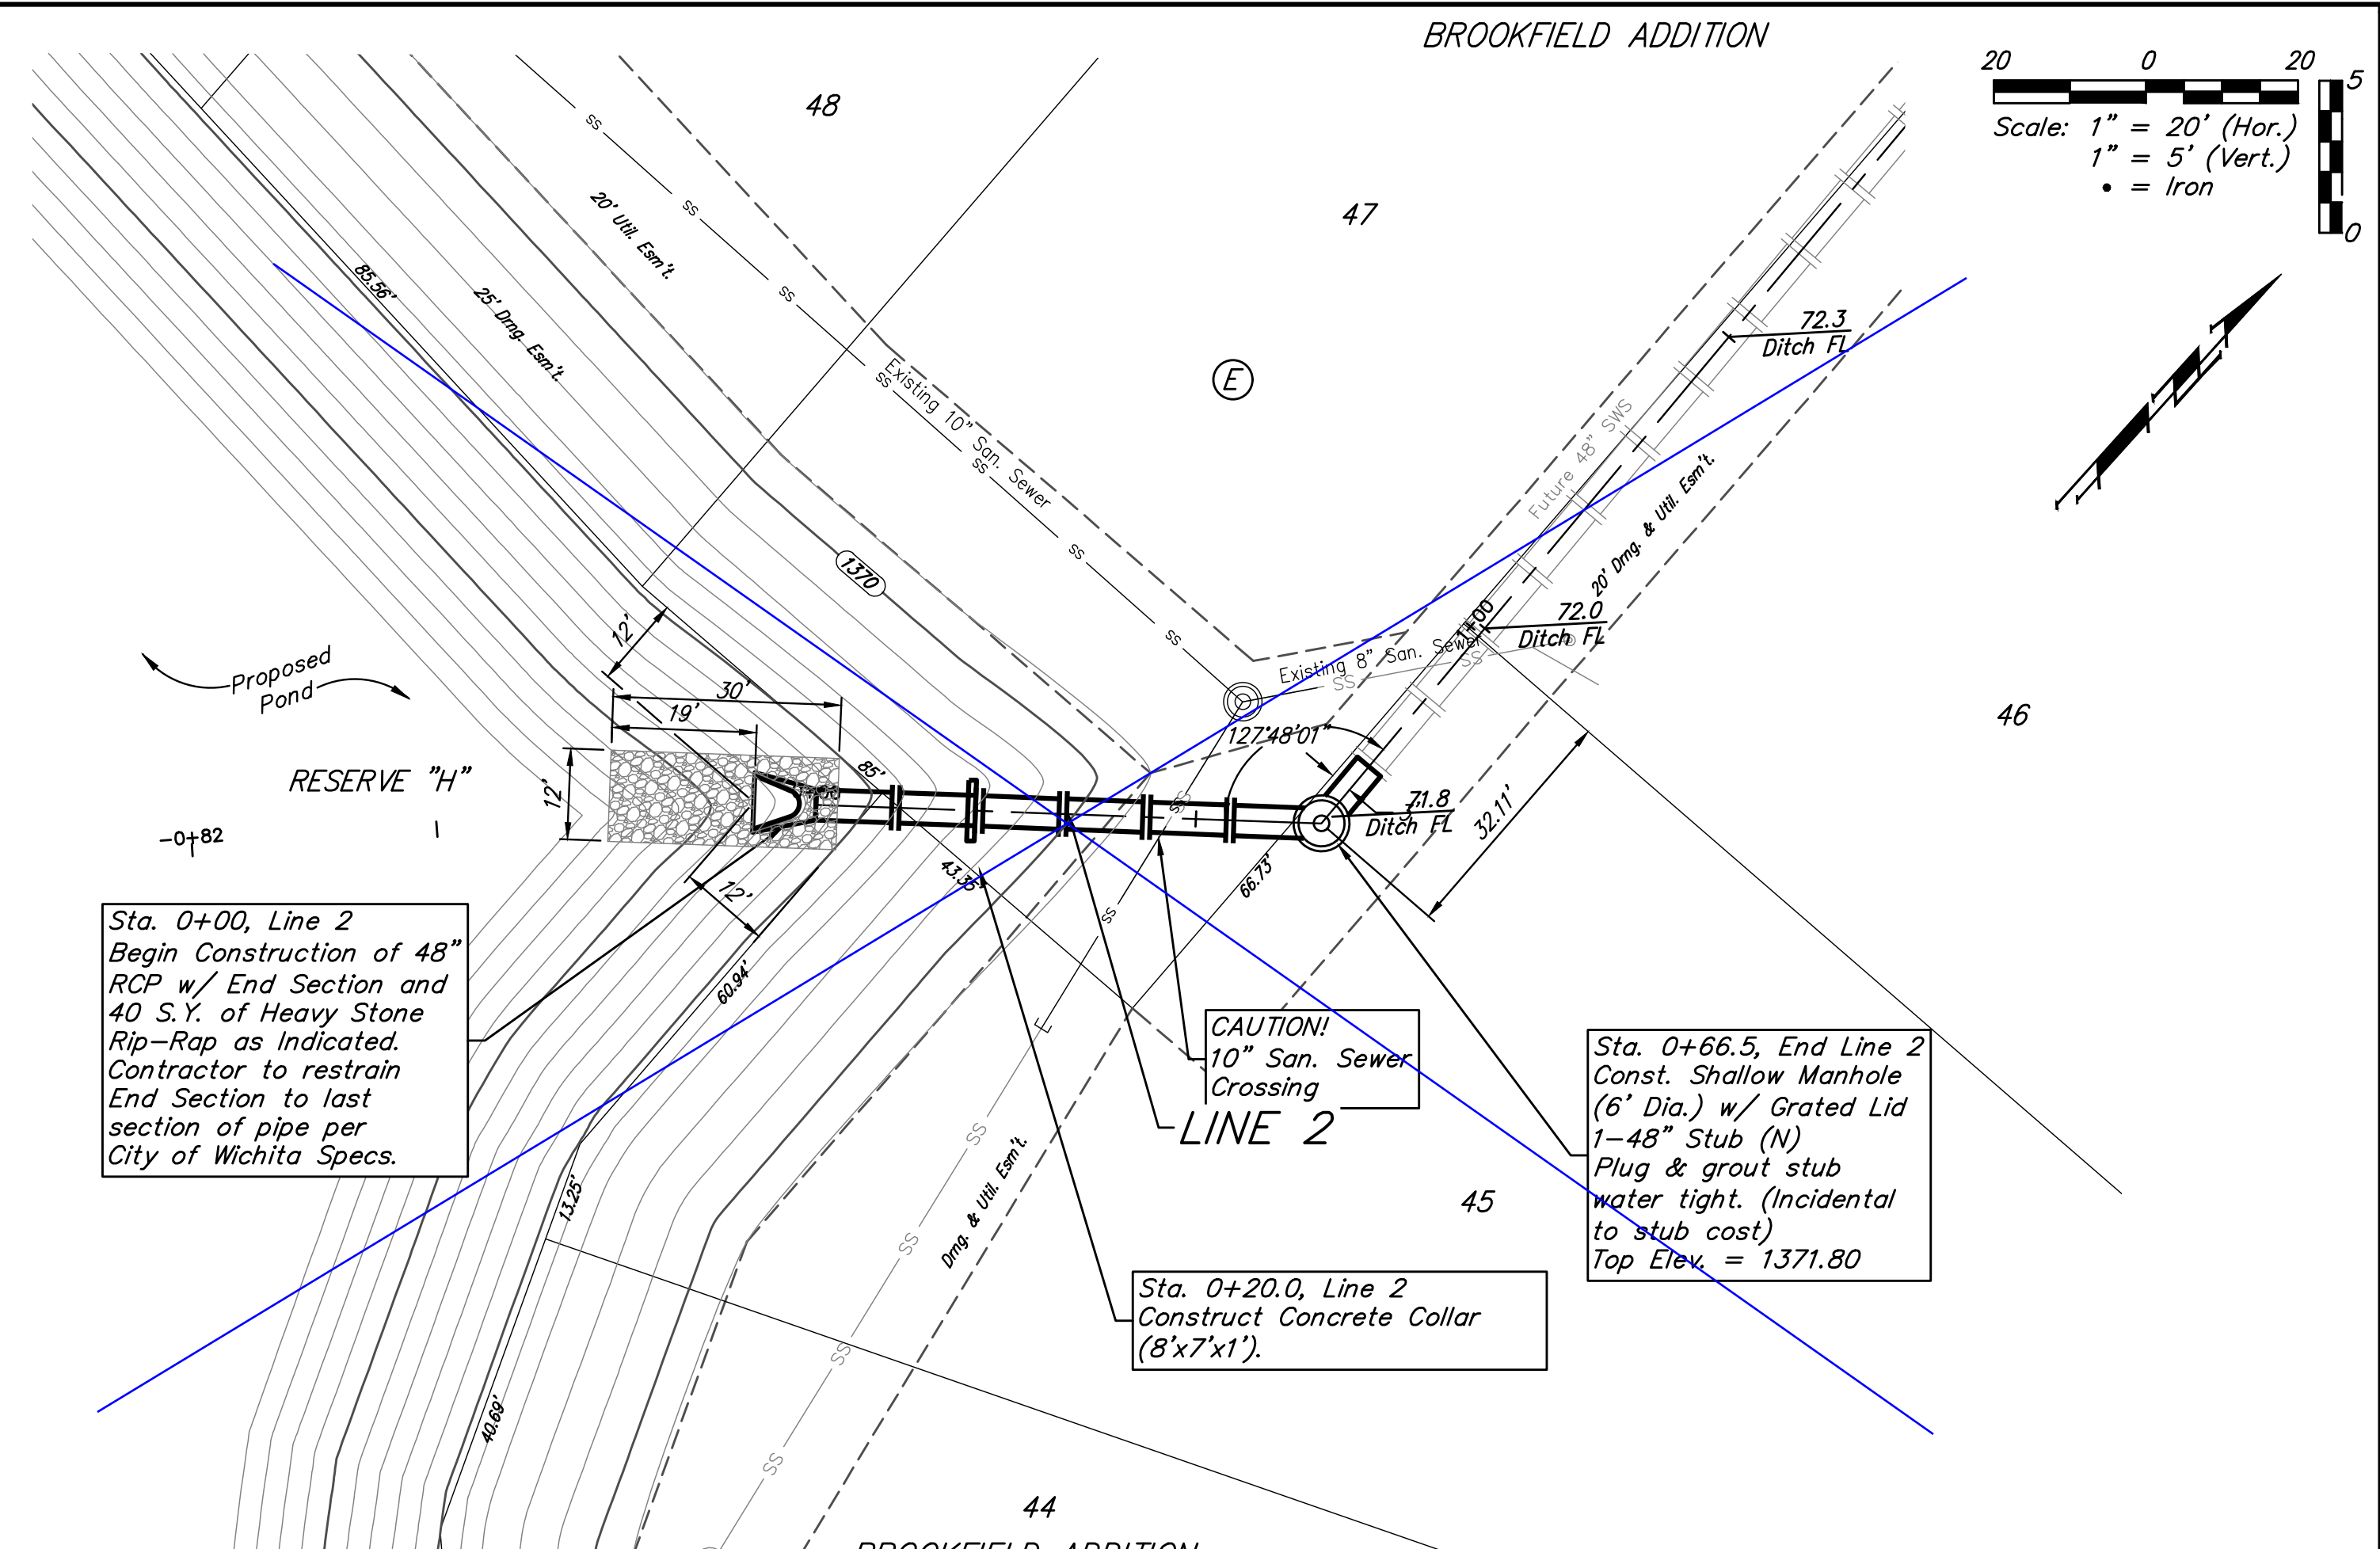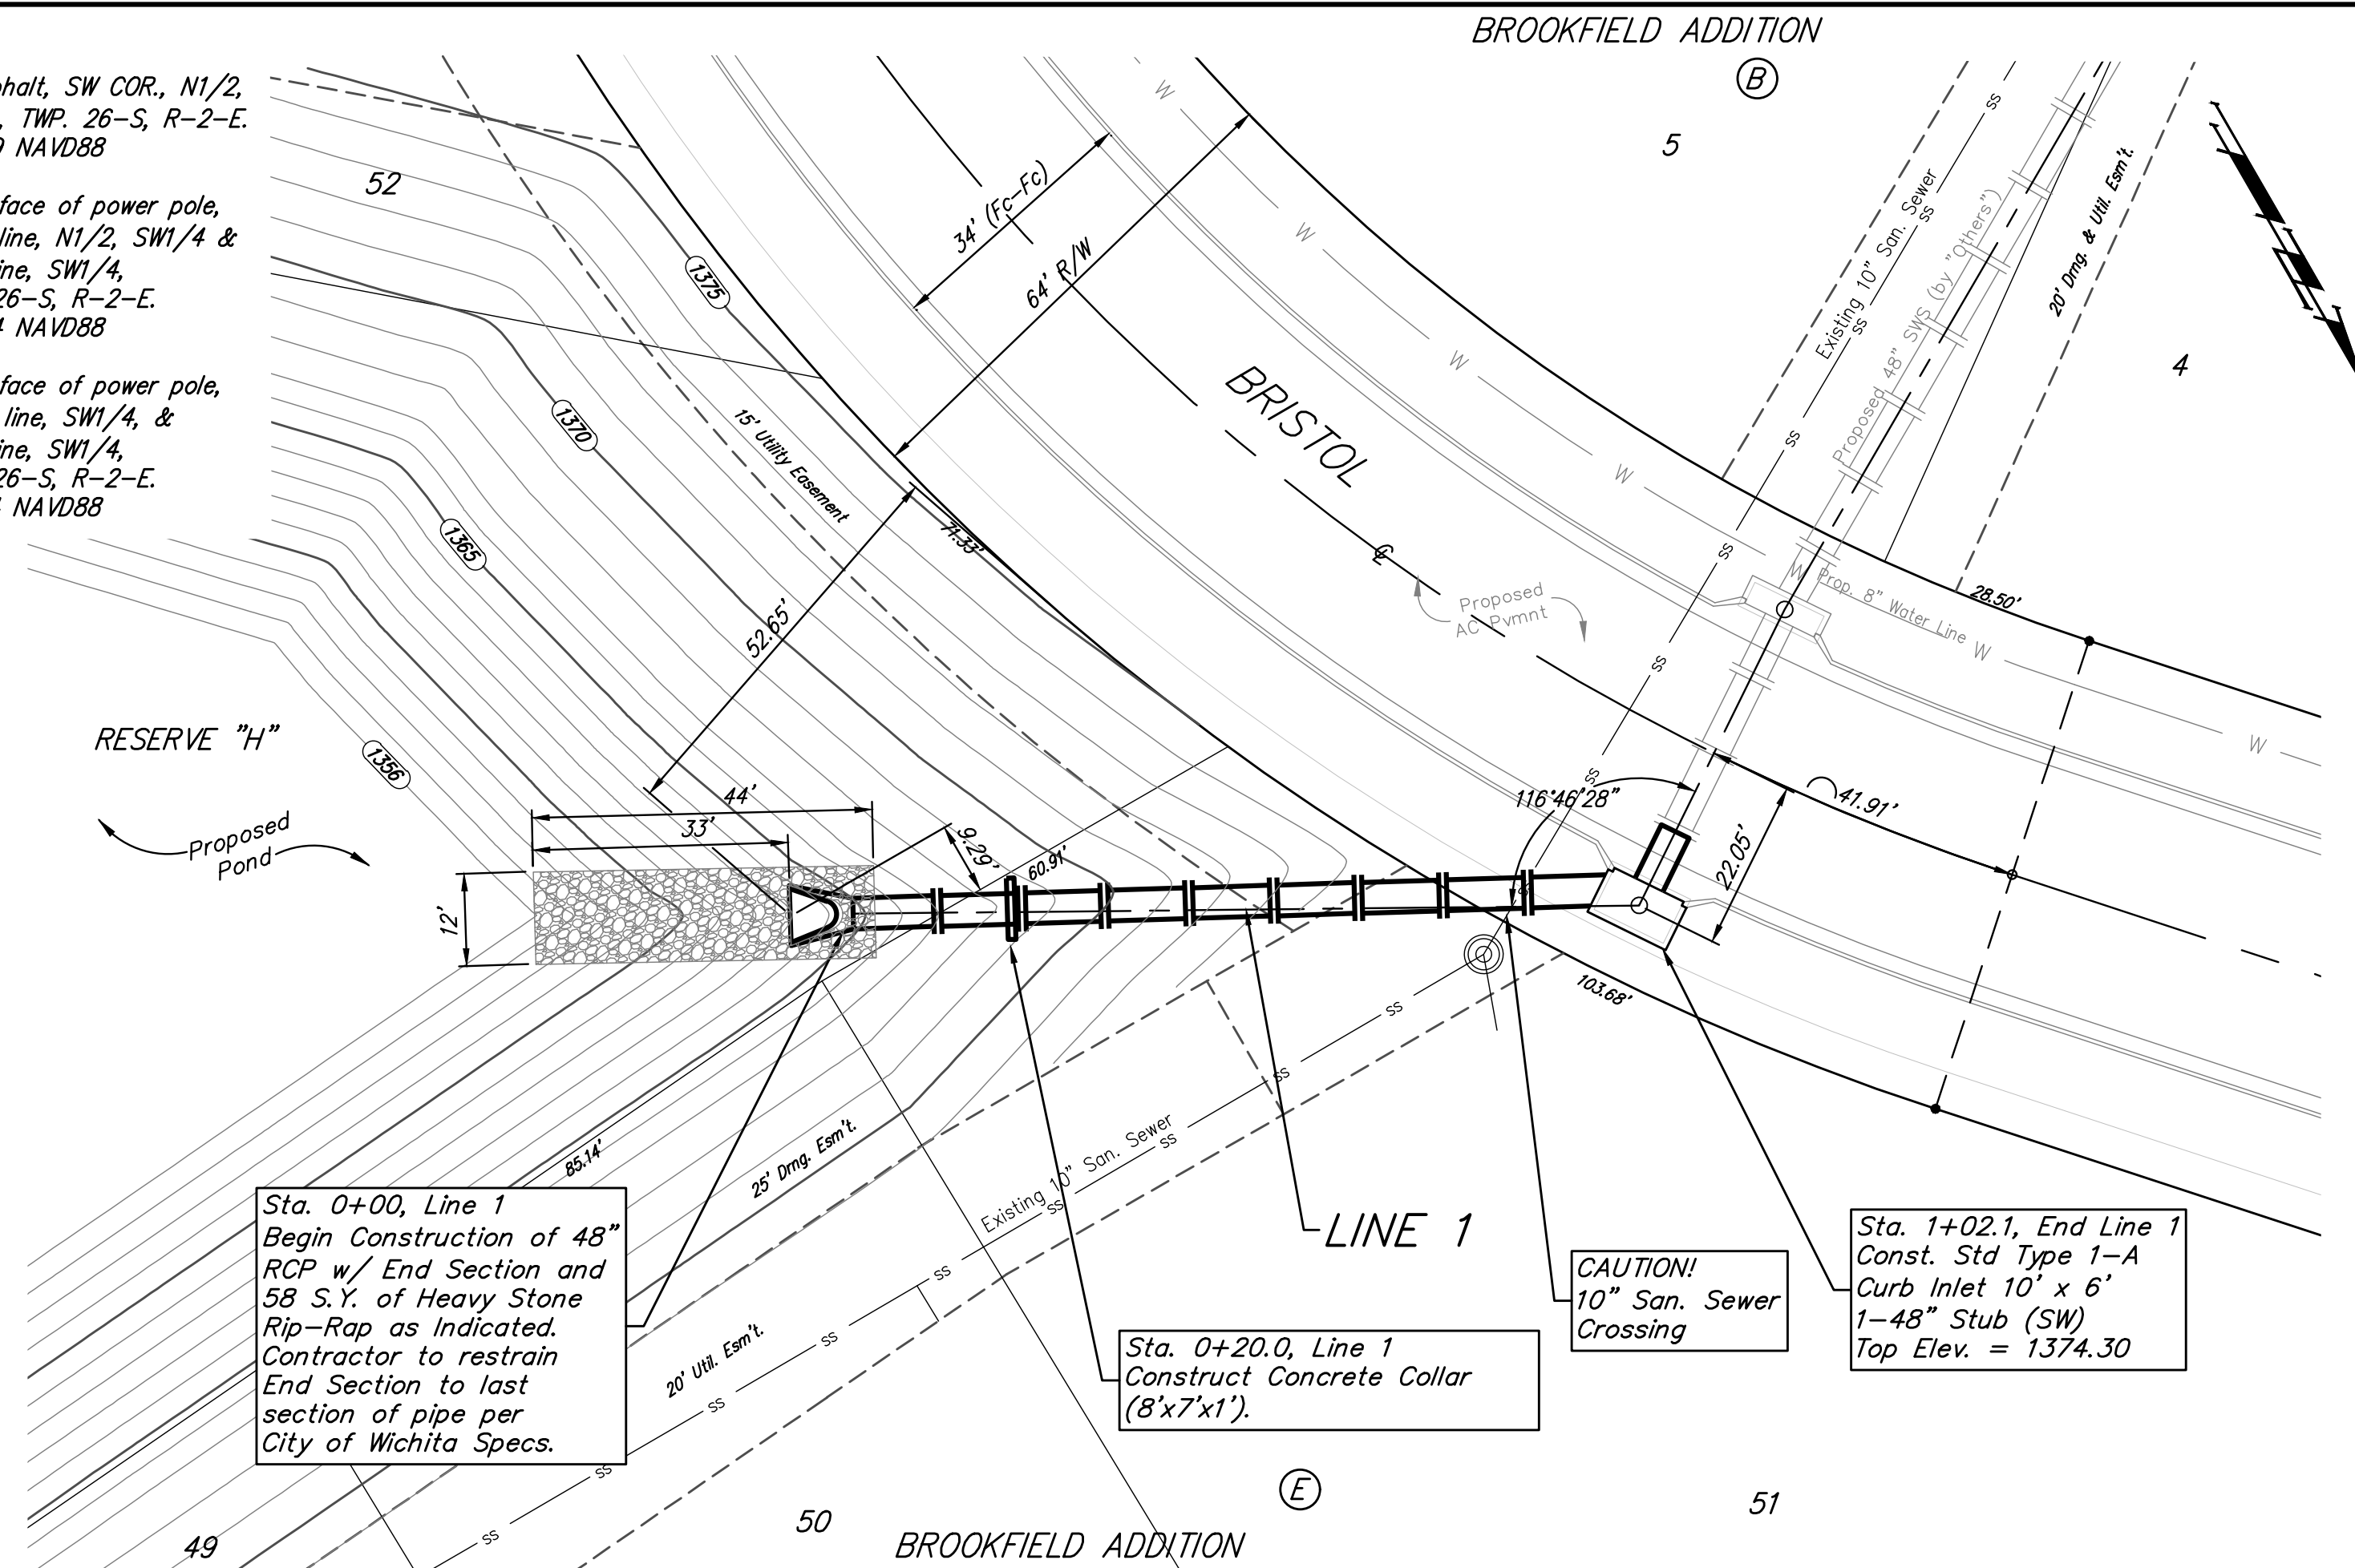

VOID - SEE SHEET 2R

		Brookfield Addition - Phase I LINE 1 & LINE 2 Storm Water Drain Improvements	
		<small>Baughman Company, P.A. 315 Ellis St. Wichita, KS 67211 P 316-262-7271 F 316-262-0149 ENGINEERING SURVEYING PLANNING LANDSCAPE ARCHITECTURE</small>	
PROJECT NUMBER 468-85177	DESIGN AEG	DRAWN JAK	DATE 6/30/17
REVISIONS:	APPROVED	SCALE Noted SHEET	2 OF 26

BENCHMARKS:
 RR spike in asphalt, SW COR., N1/2, SW1/4, Sec. 34, TWP. 26-S, R-2-E. Elev. = 1400.59 NAVD88
 RR spike in E. face of power pole, 174± N. of S. line, N1/2, SW1/4 & 49± E. of W. line, SW1/4, Sec. 34, TWP. 26-S, R-2-E. Elev. = 1398.64 NAVD88
 RR spike in S. face of power pole, 294± S. of N. line, SW1/4, & 48± E. of W. line, SW1/4, Sec. 34, TWP. 26-S, R-2-E. Elev. = 1386.14 NAVD88

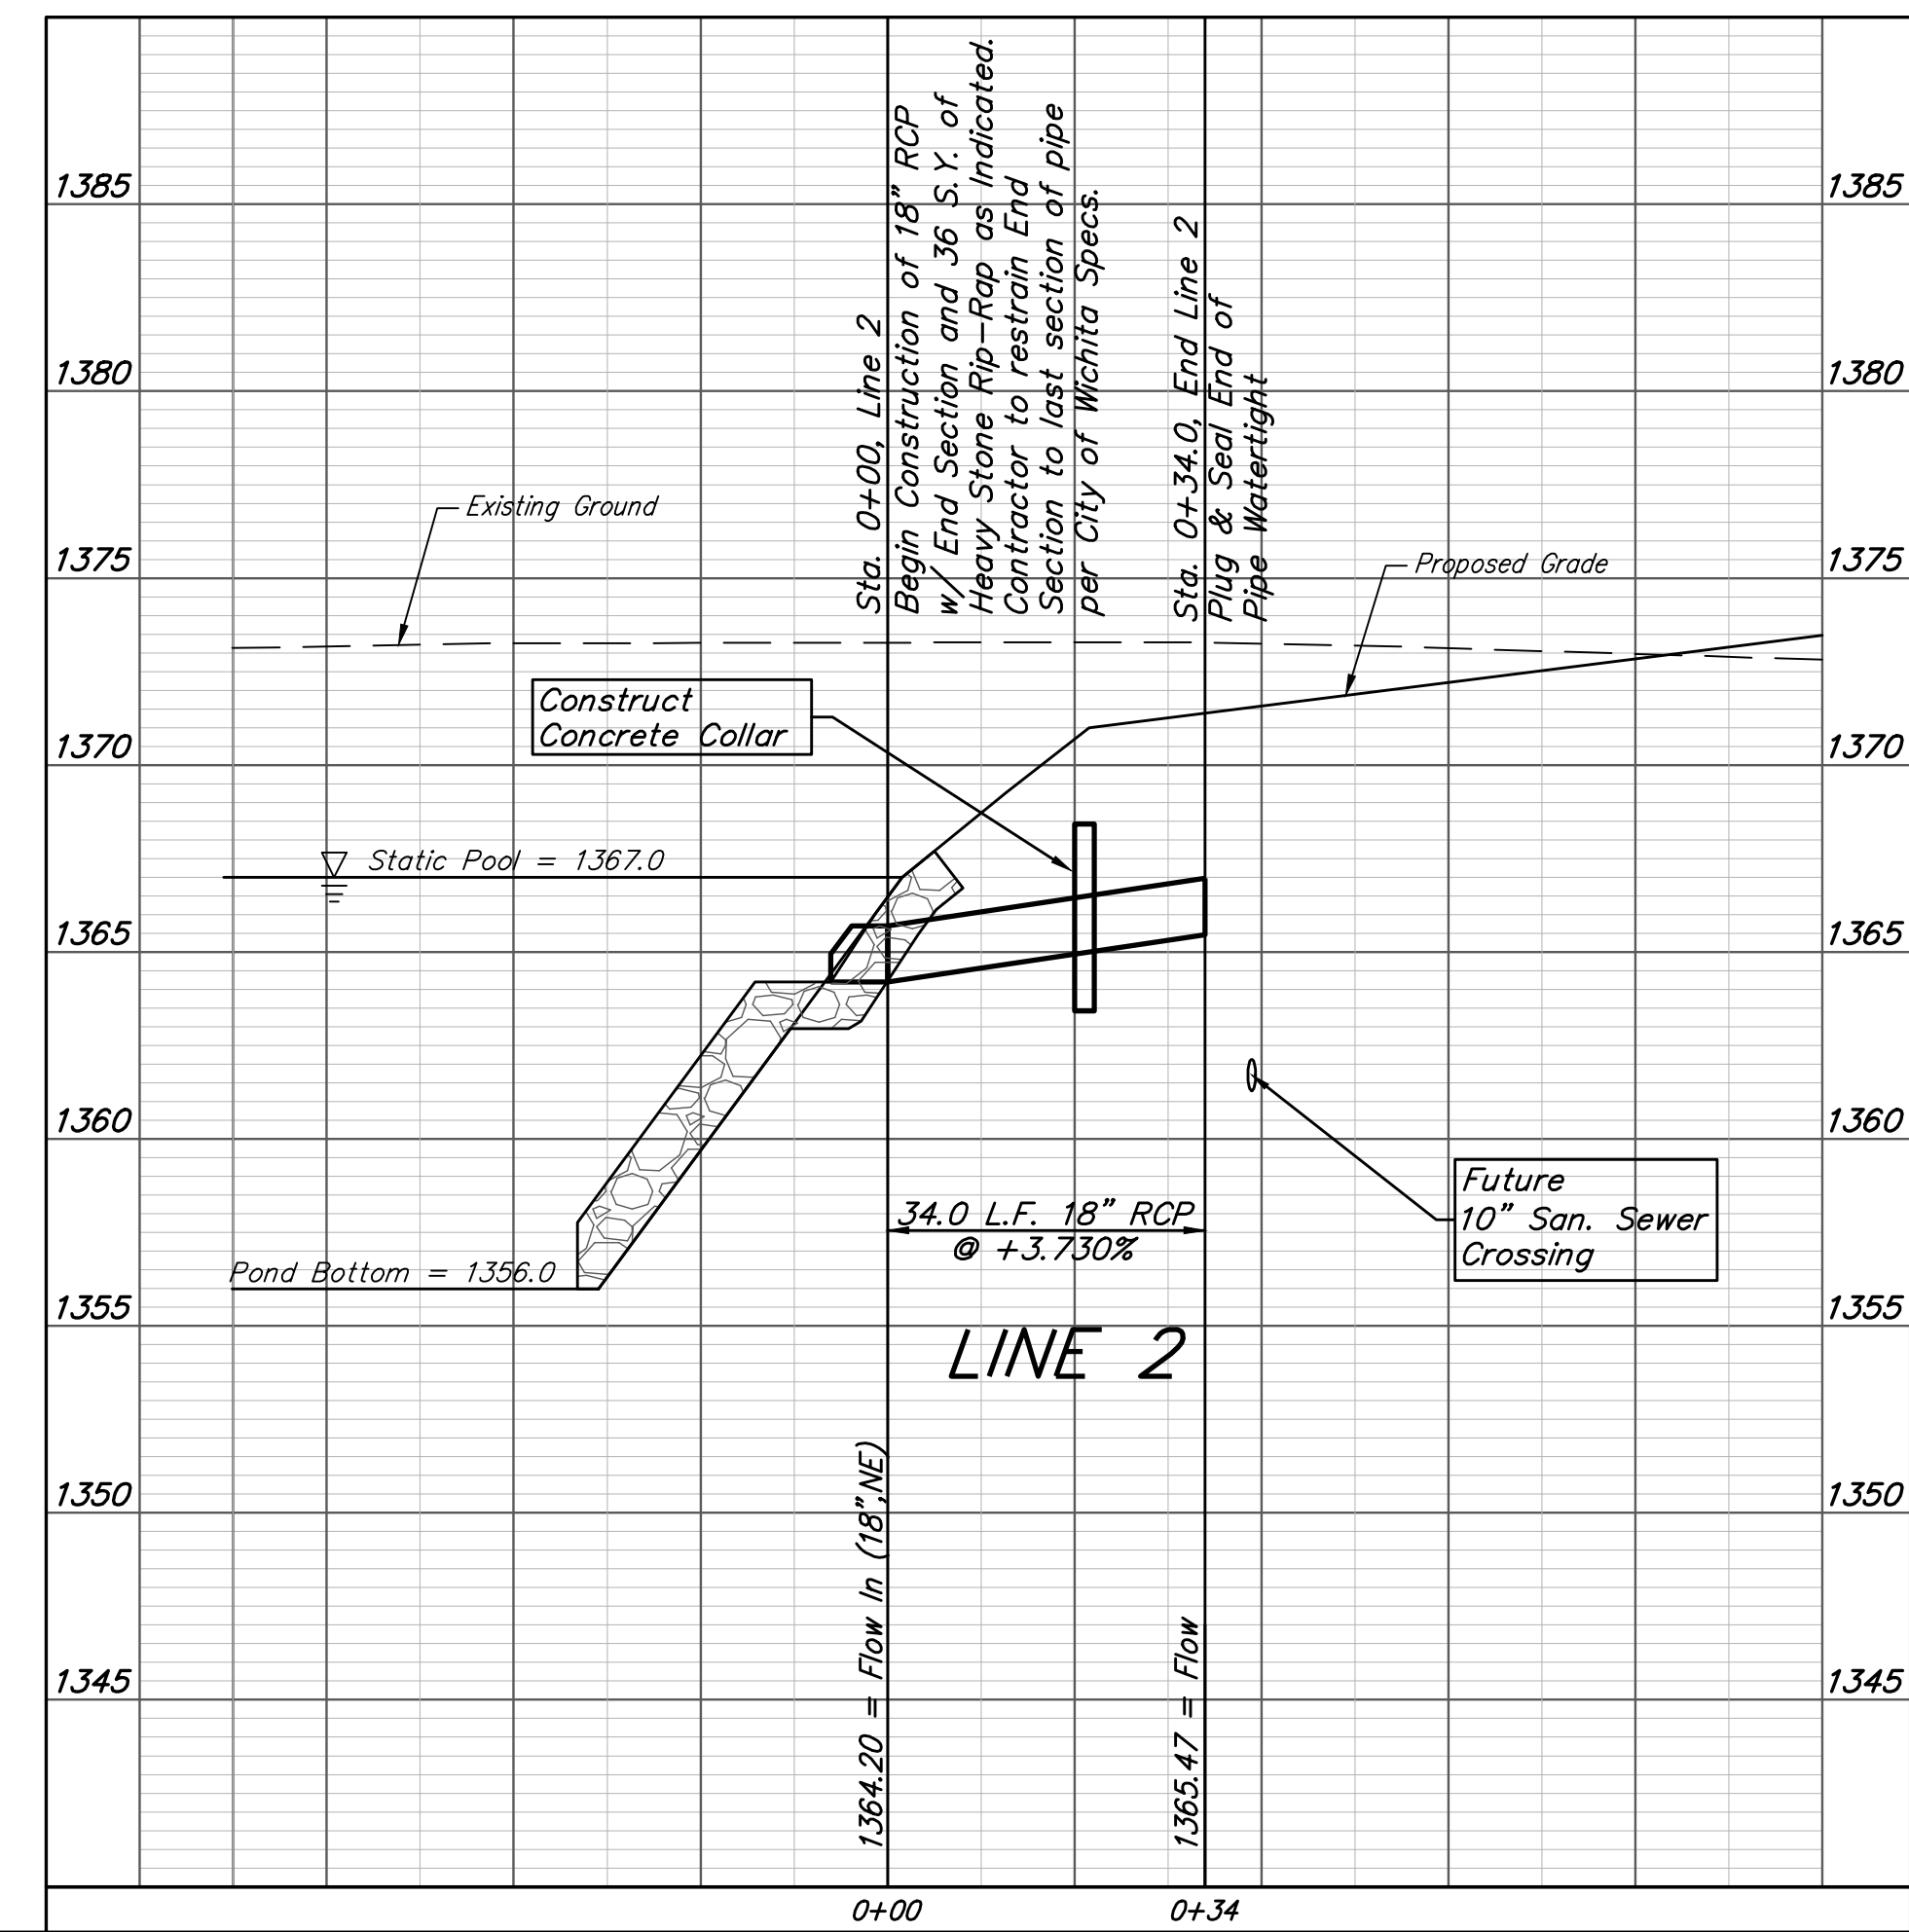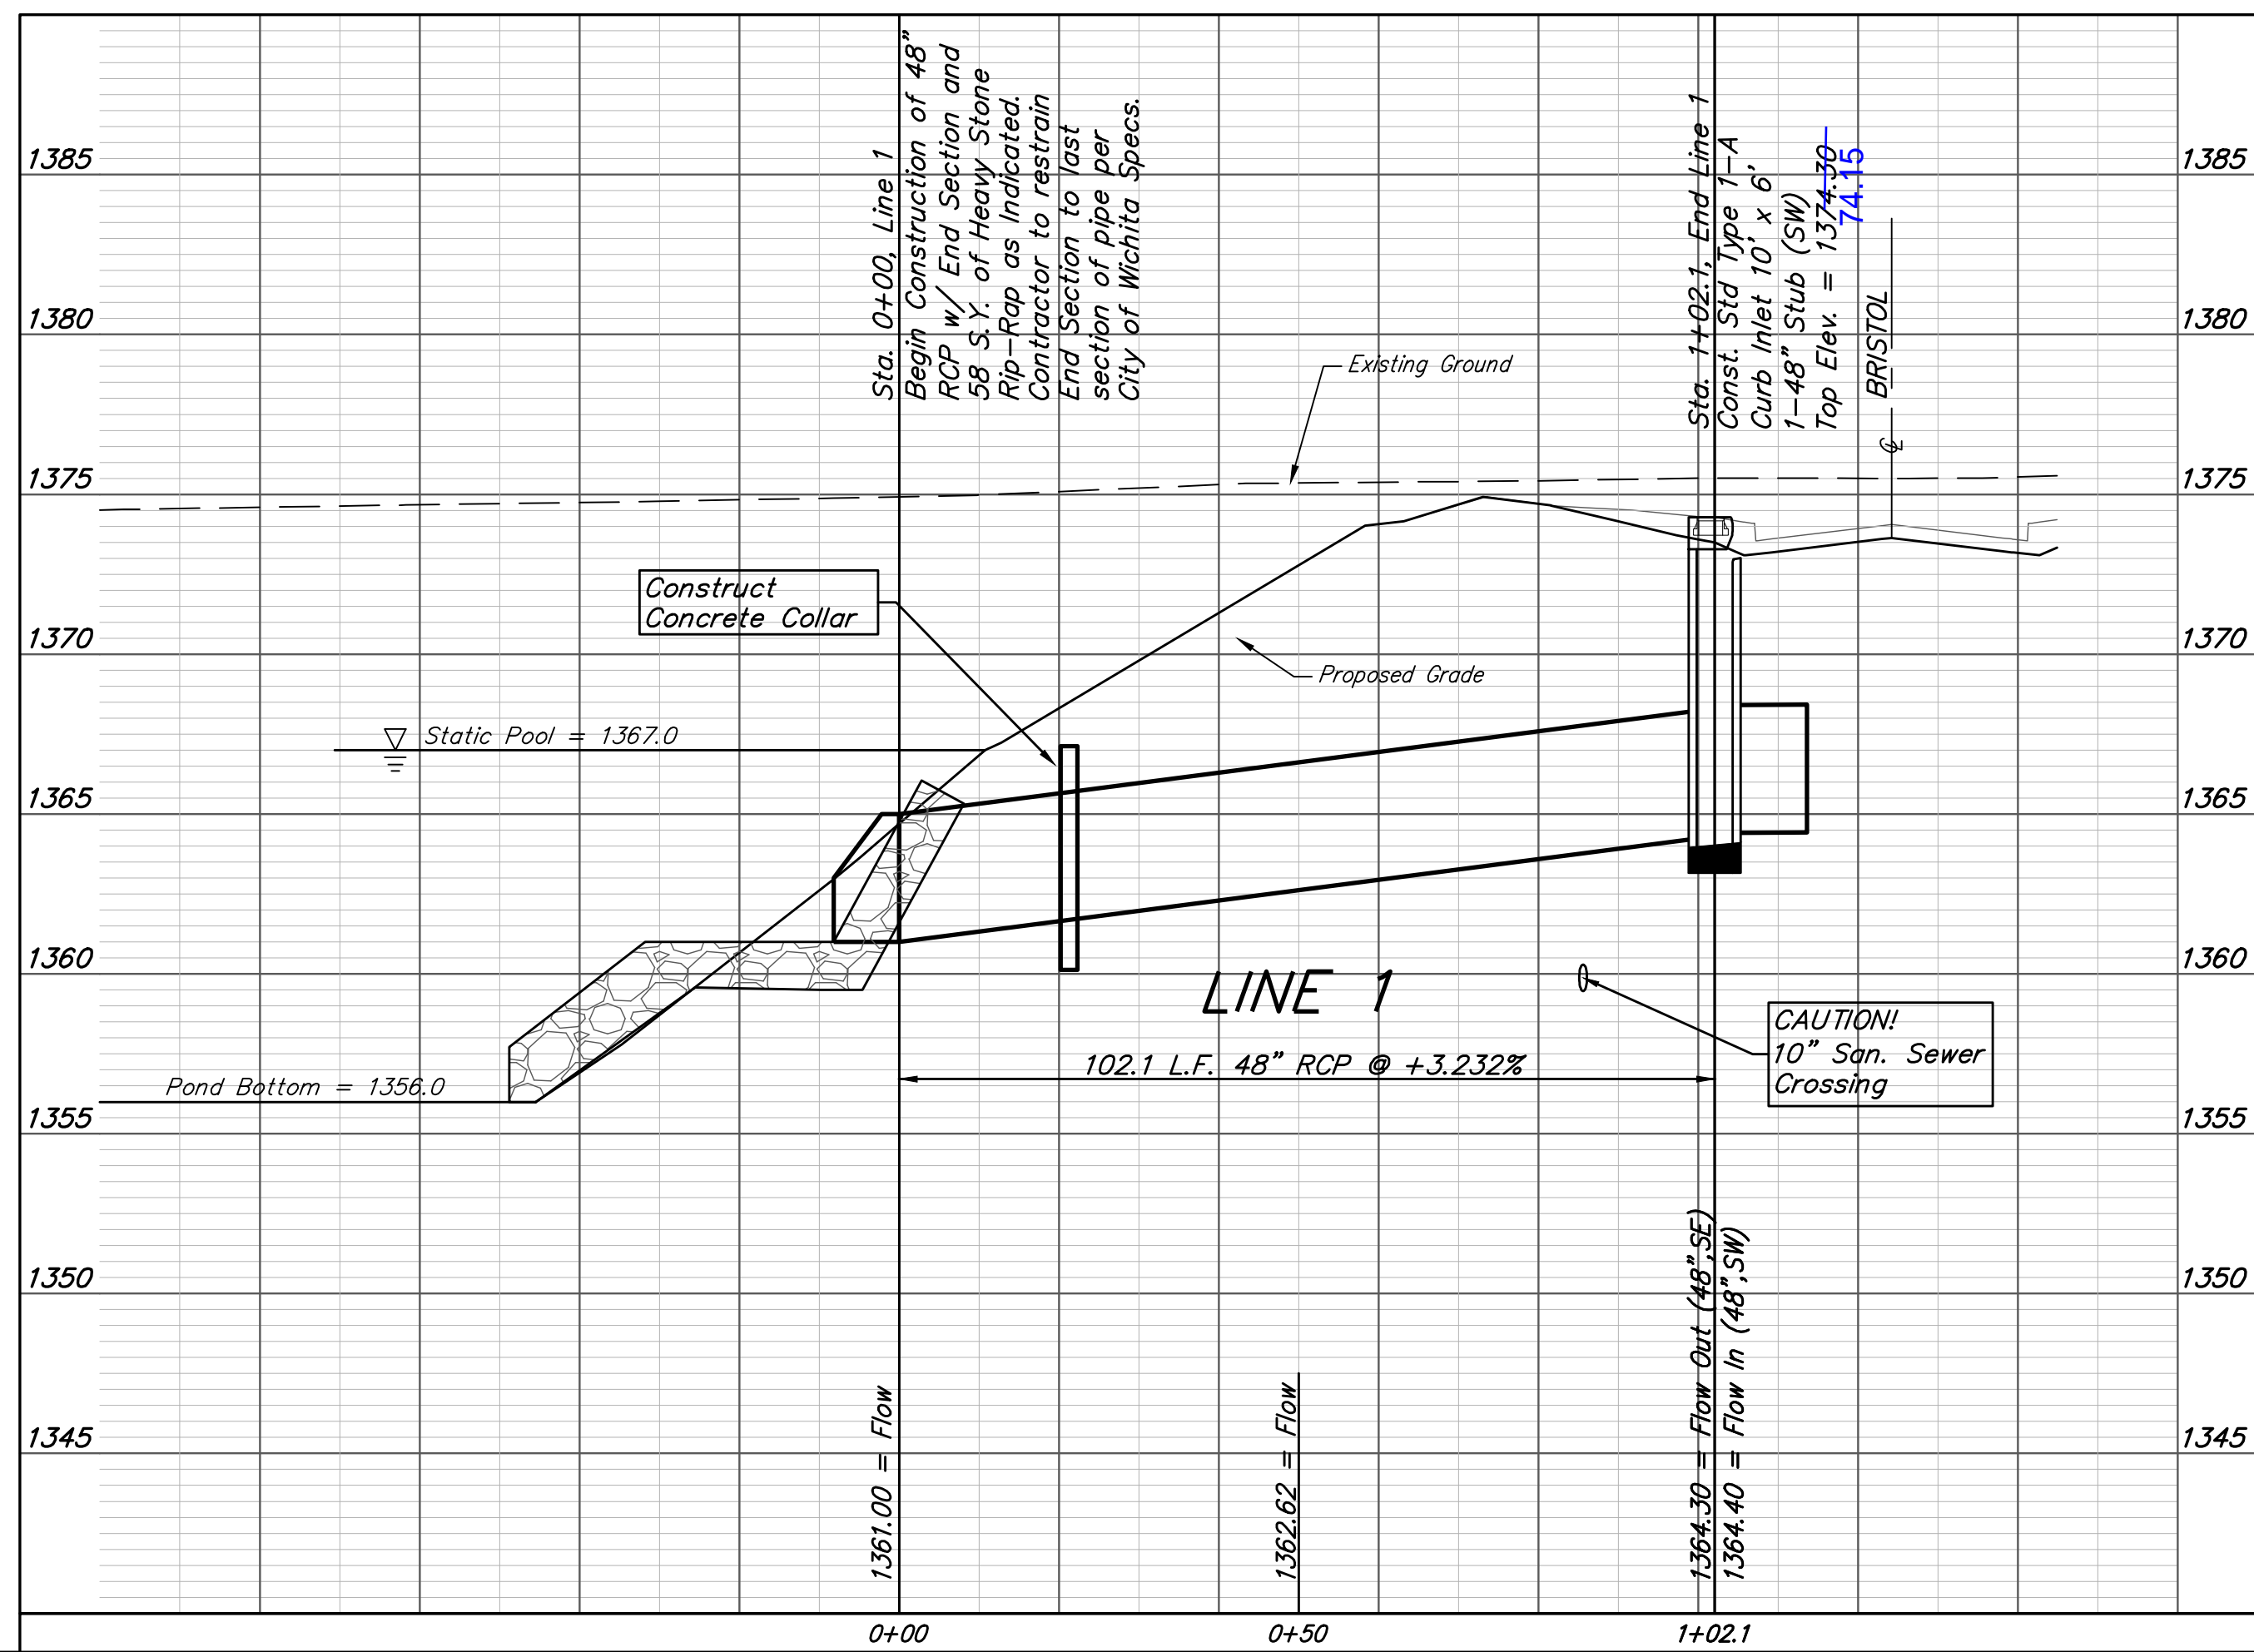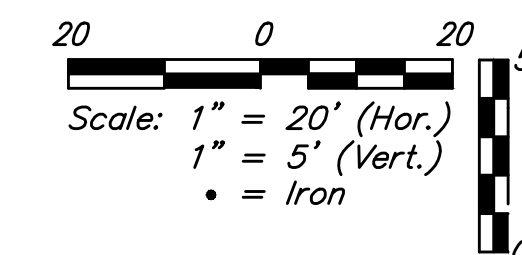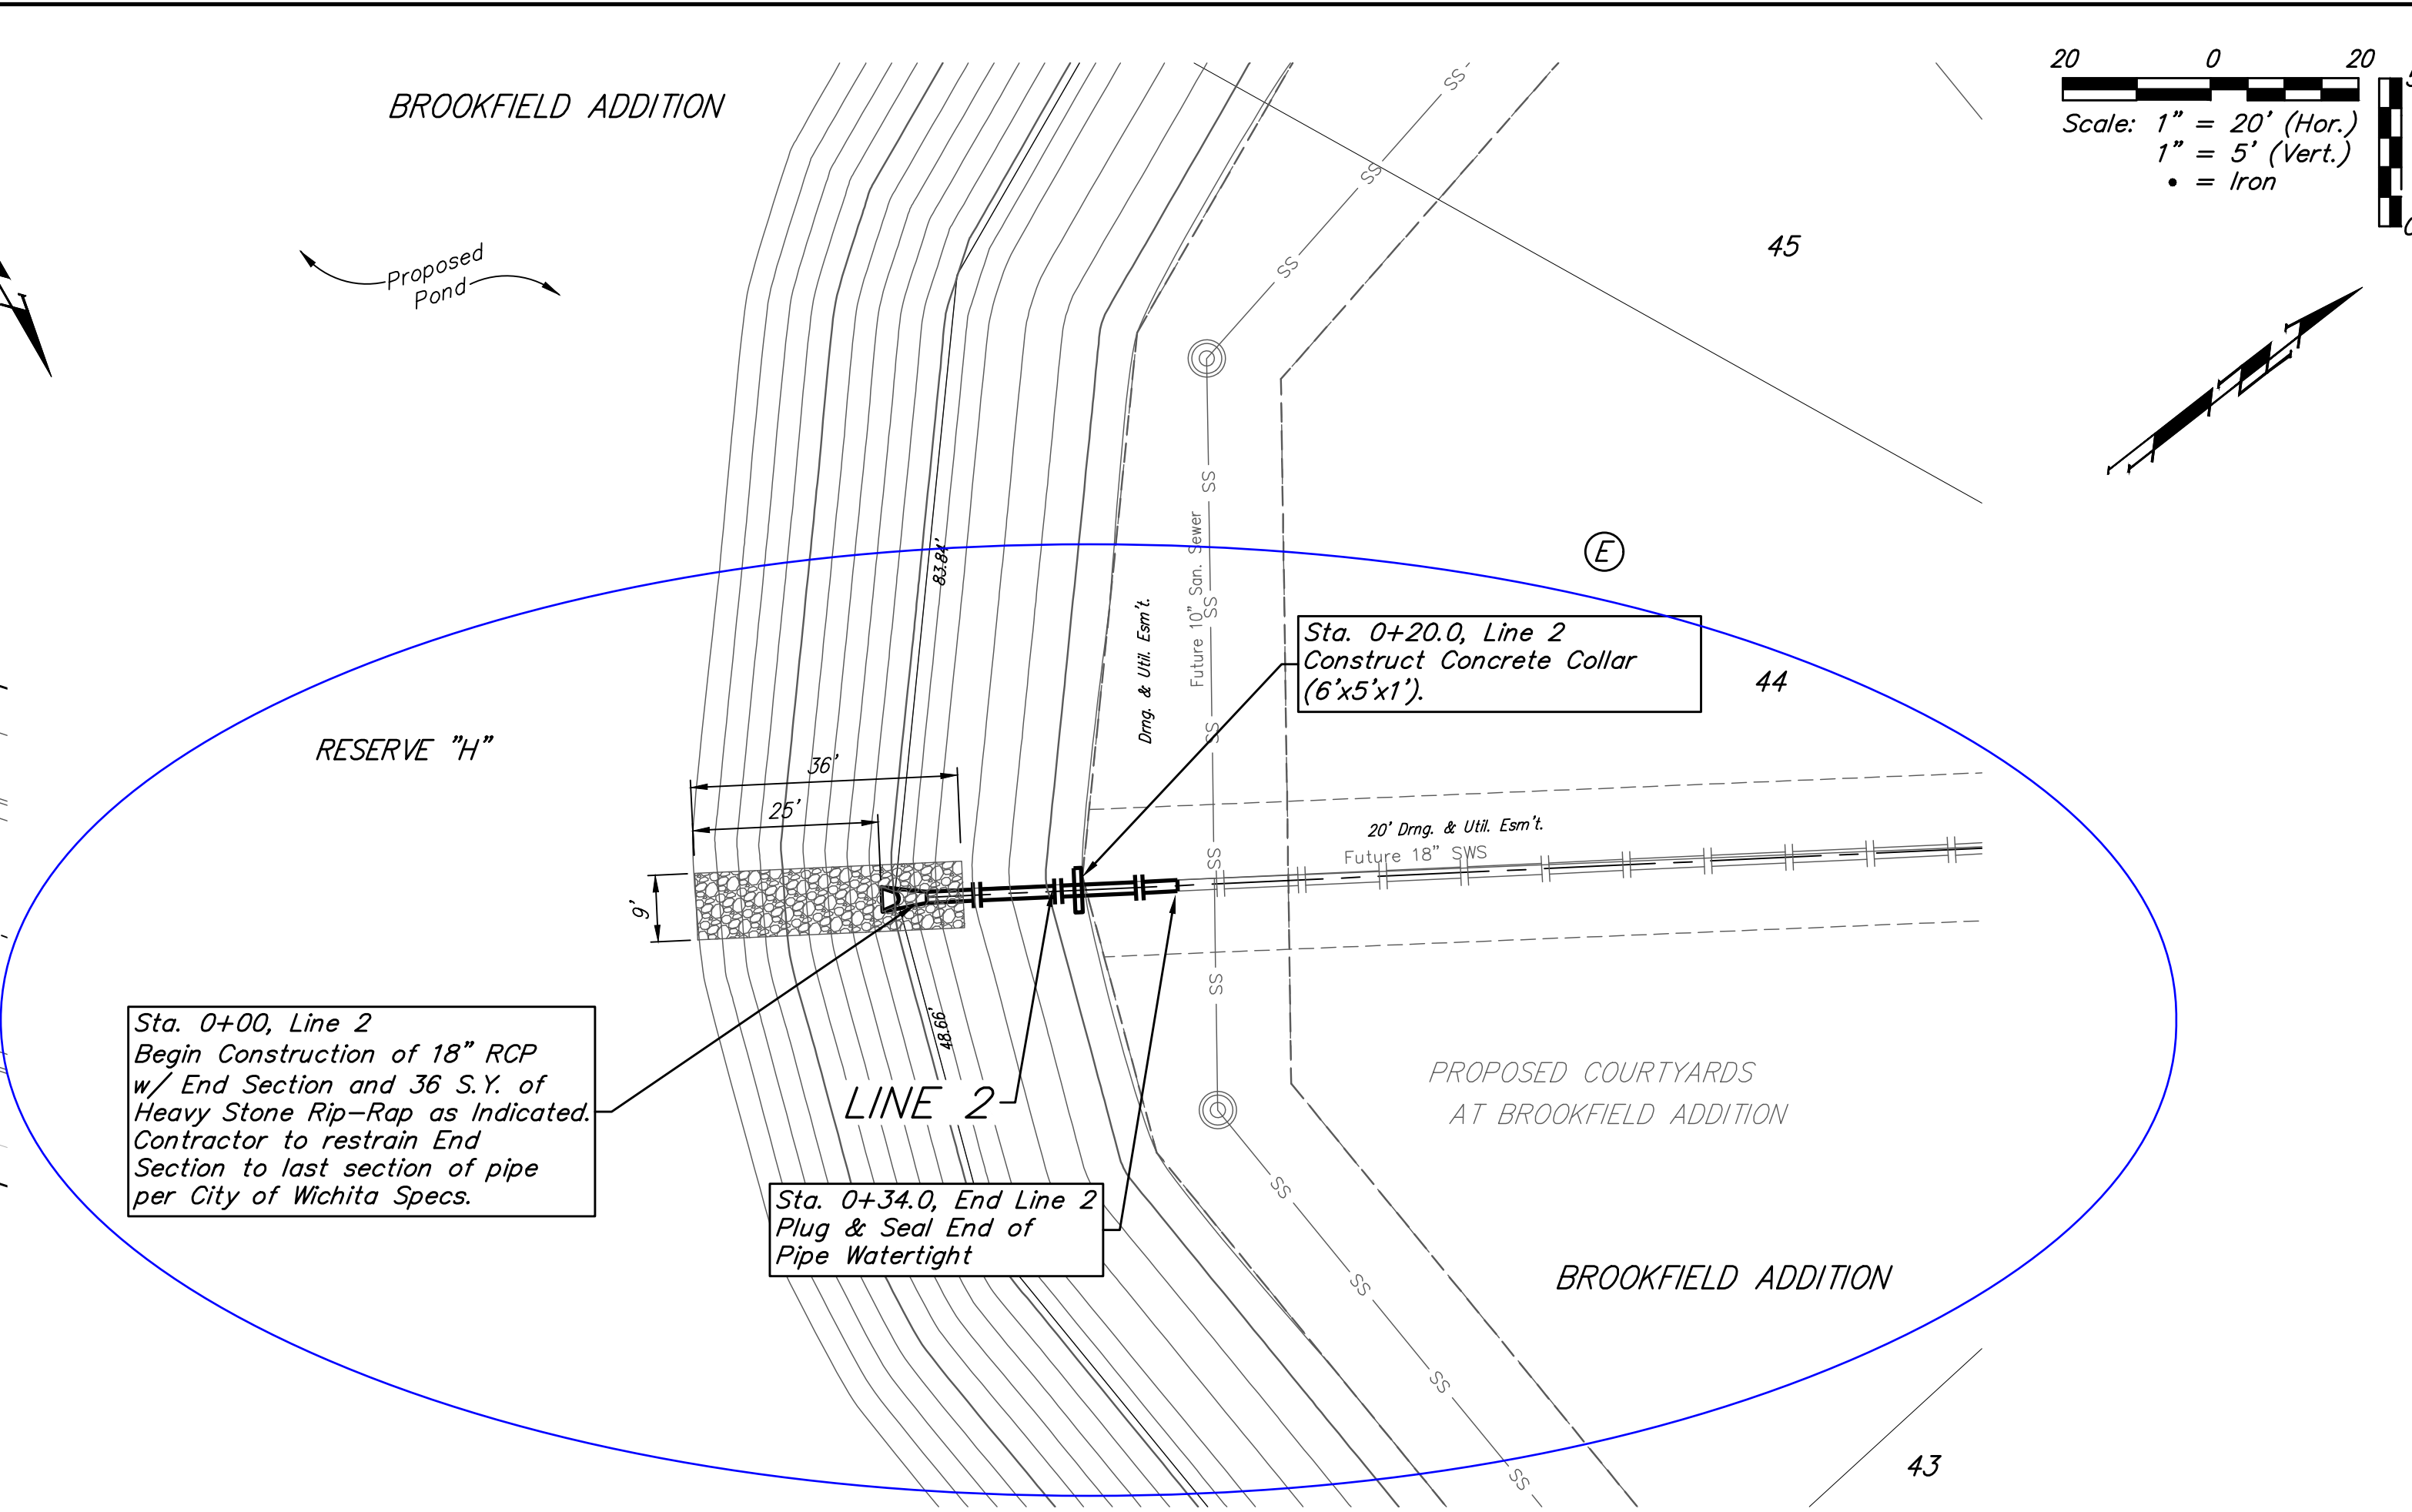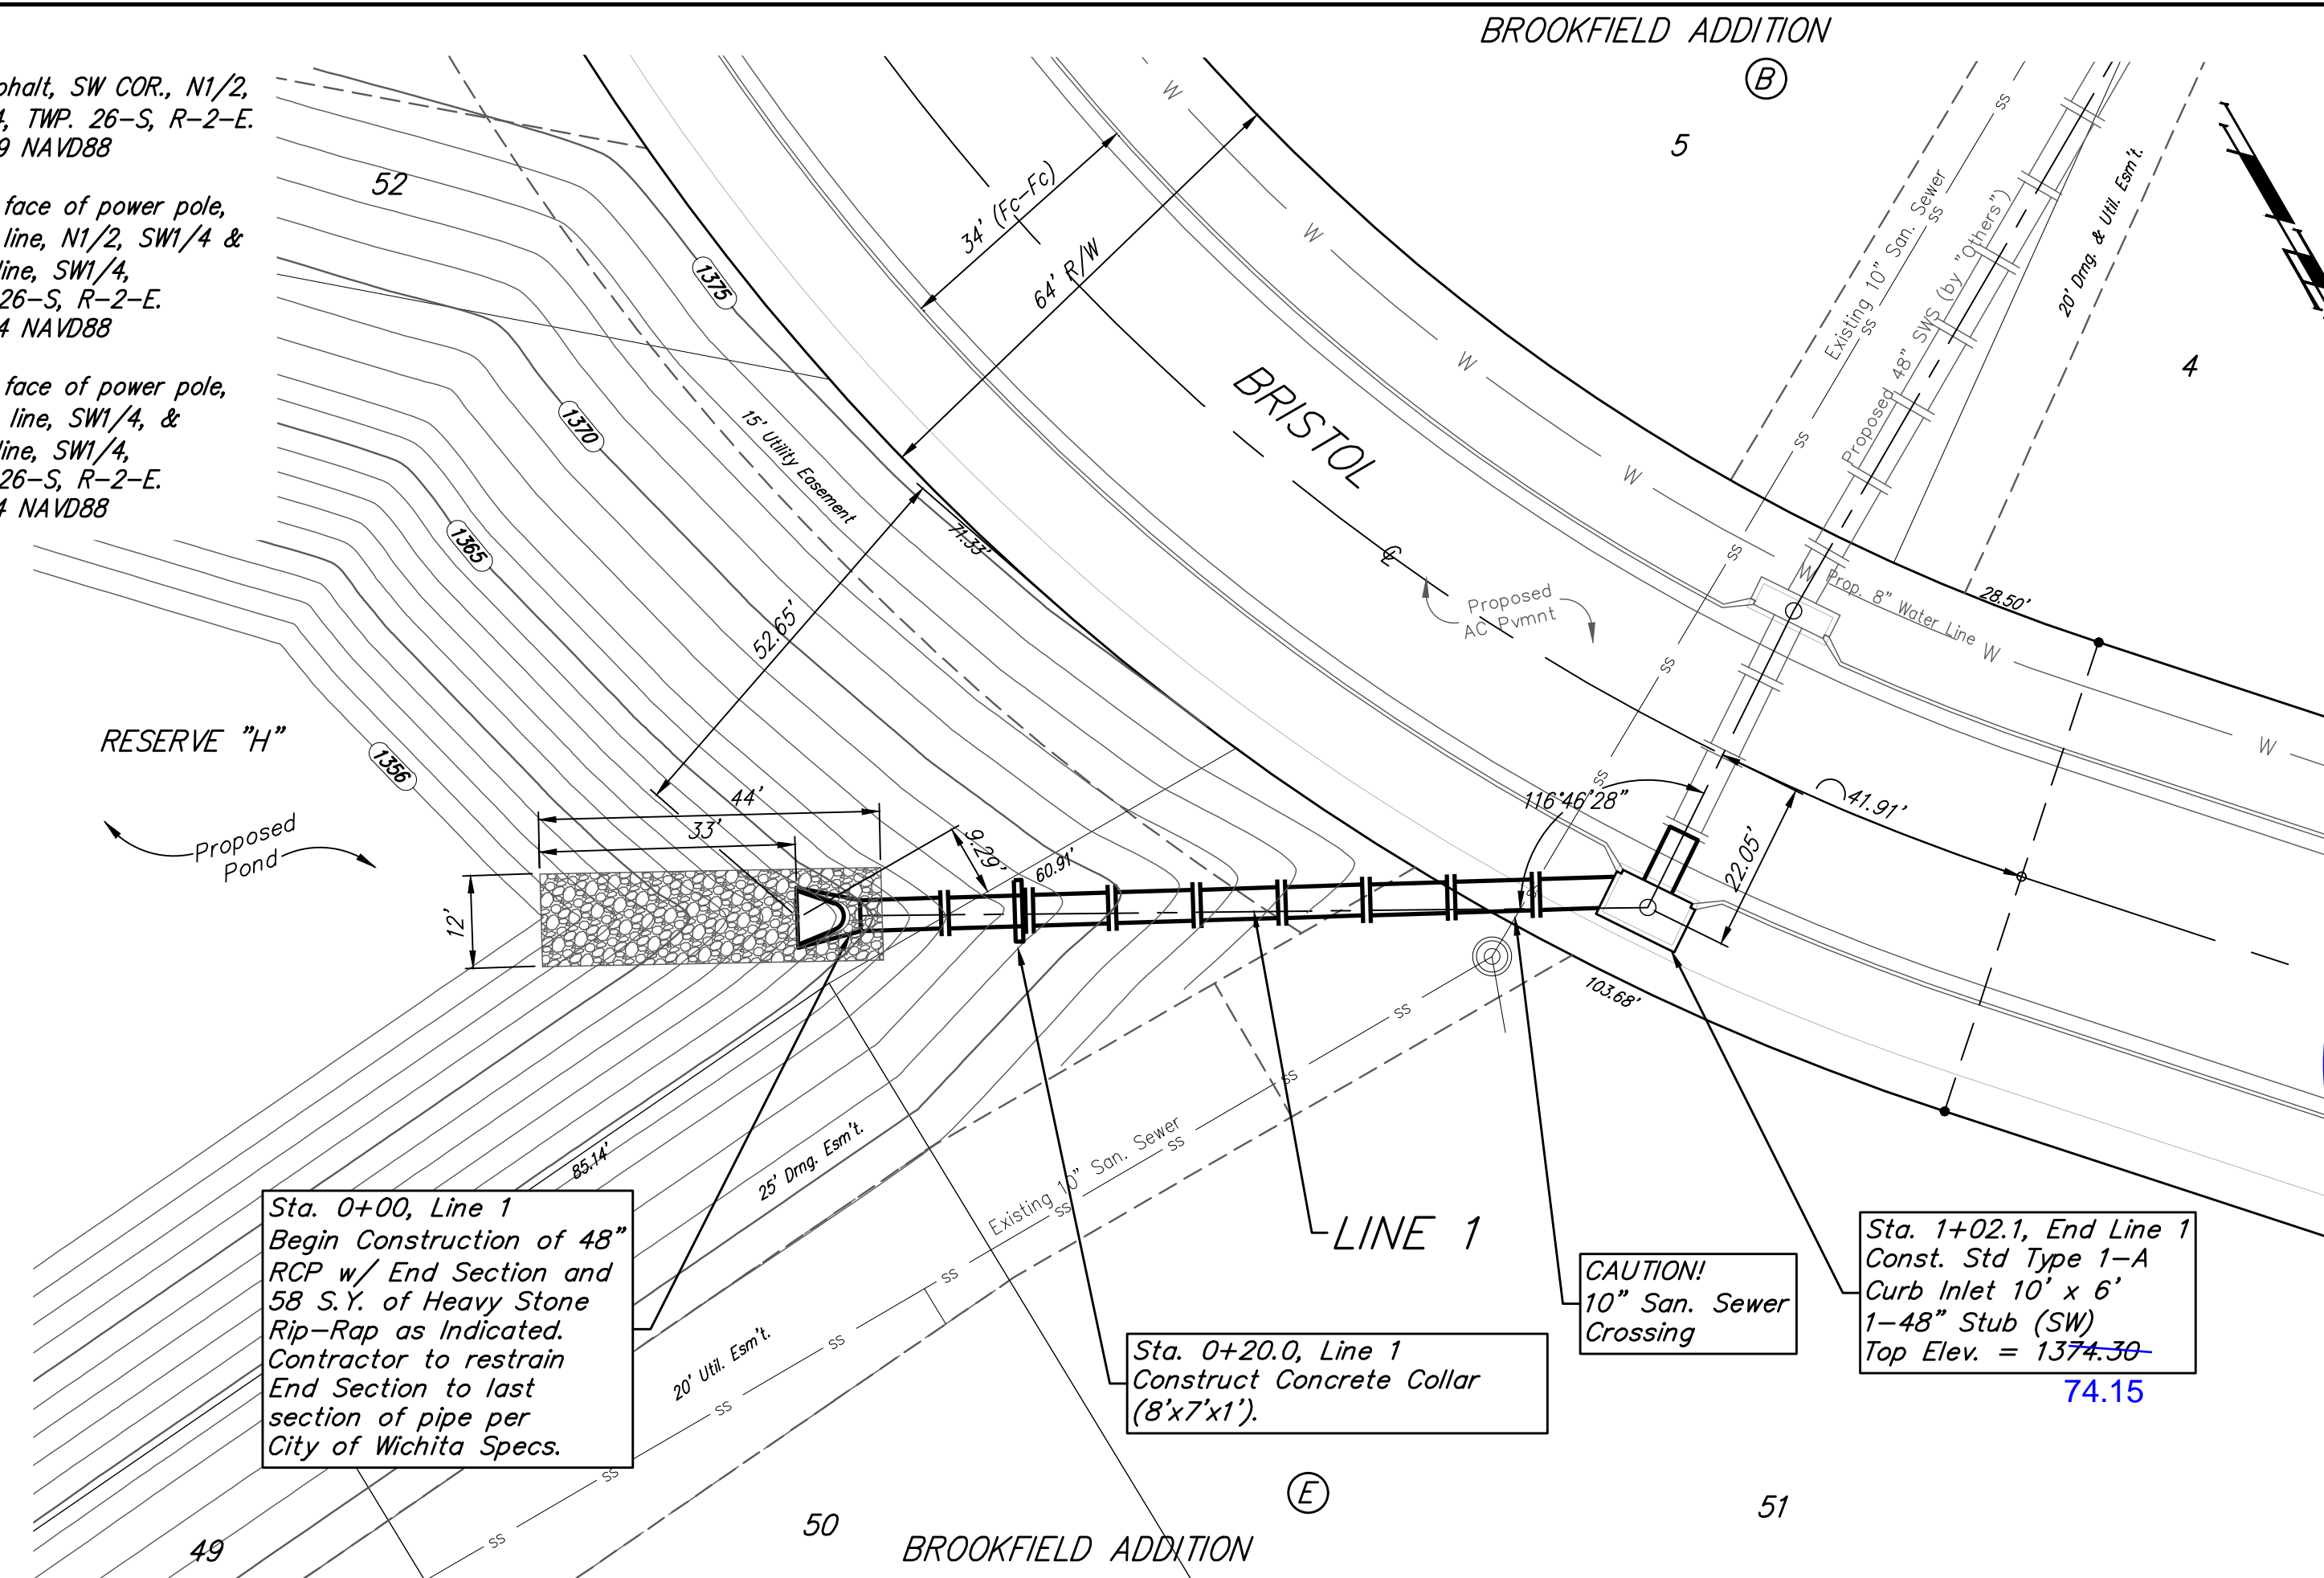



Baughman Brookfield Addition - Phase I
LINE 1 & LINE 2
 Storm Water Drain Improvements

Baughman Company, P.A. 315 Ellis St. Wichita, KS 67211 P 316-262-7271 F 316-262-0149
 ENGINEERING | SURVEYING | PLANNING | LANDSCAPE ARCHITECTURE

PROJECT NUMBER 468-85177	DESIGN AEG	DRAWN JAK
REVISIONS: 7/18/17 Line 2	JAK	APPROVED DATE 6/30/17
SCALE Noted		SHEET 2R OF 26

I:\Projects\Brookfield Addition_1604P190\Engineering\Phase I\SWD_1608E543\SWD PLANS.dwg

BENCHMARKS:
 RR spike in asphalt, SW COR., N1/2, SW1/4, Sec. 34, TWP. 26-S, R-2-E. Elev. = 1400.59 NAVD88
 RR spike in E. face of power pole, 174± N. of S. line, N1/2, SW1/4, & 49± E. of W. line, SW1/4, Sec. 34, TWP. 26-S, R-2-E. Elev. = 1398.64 NAVD88
 RR spike in S. face of power pole, 294± S. of N. line, SW1/4, & 48± E. of W. line, SW1/4, Sec. 34, TWP. 26-S, R-2-E. Elev. = 1386.14 NAVD88

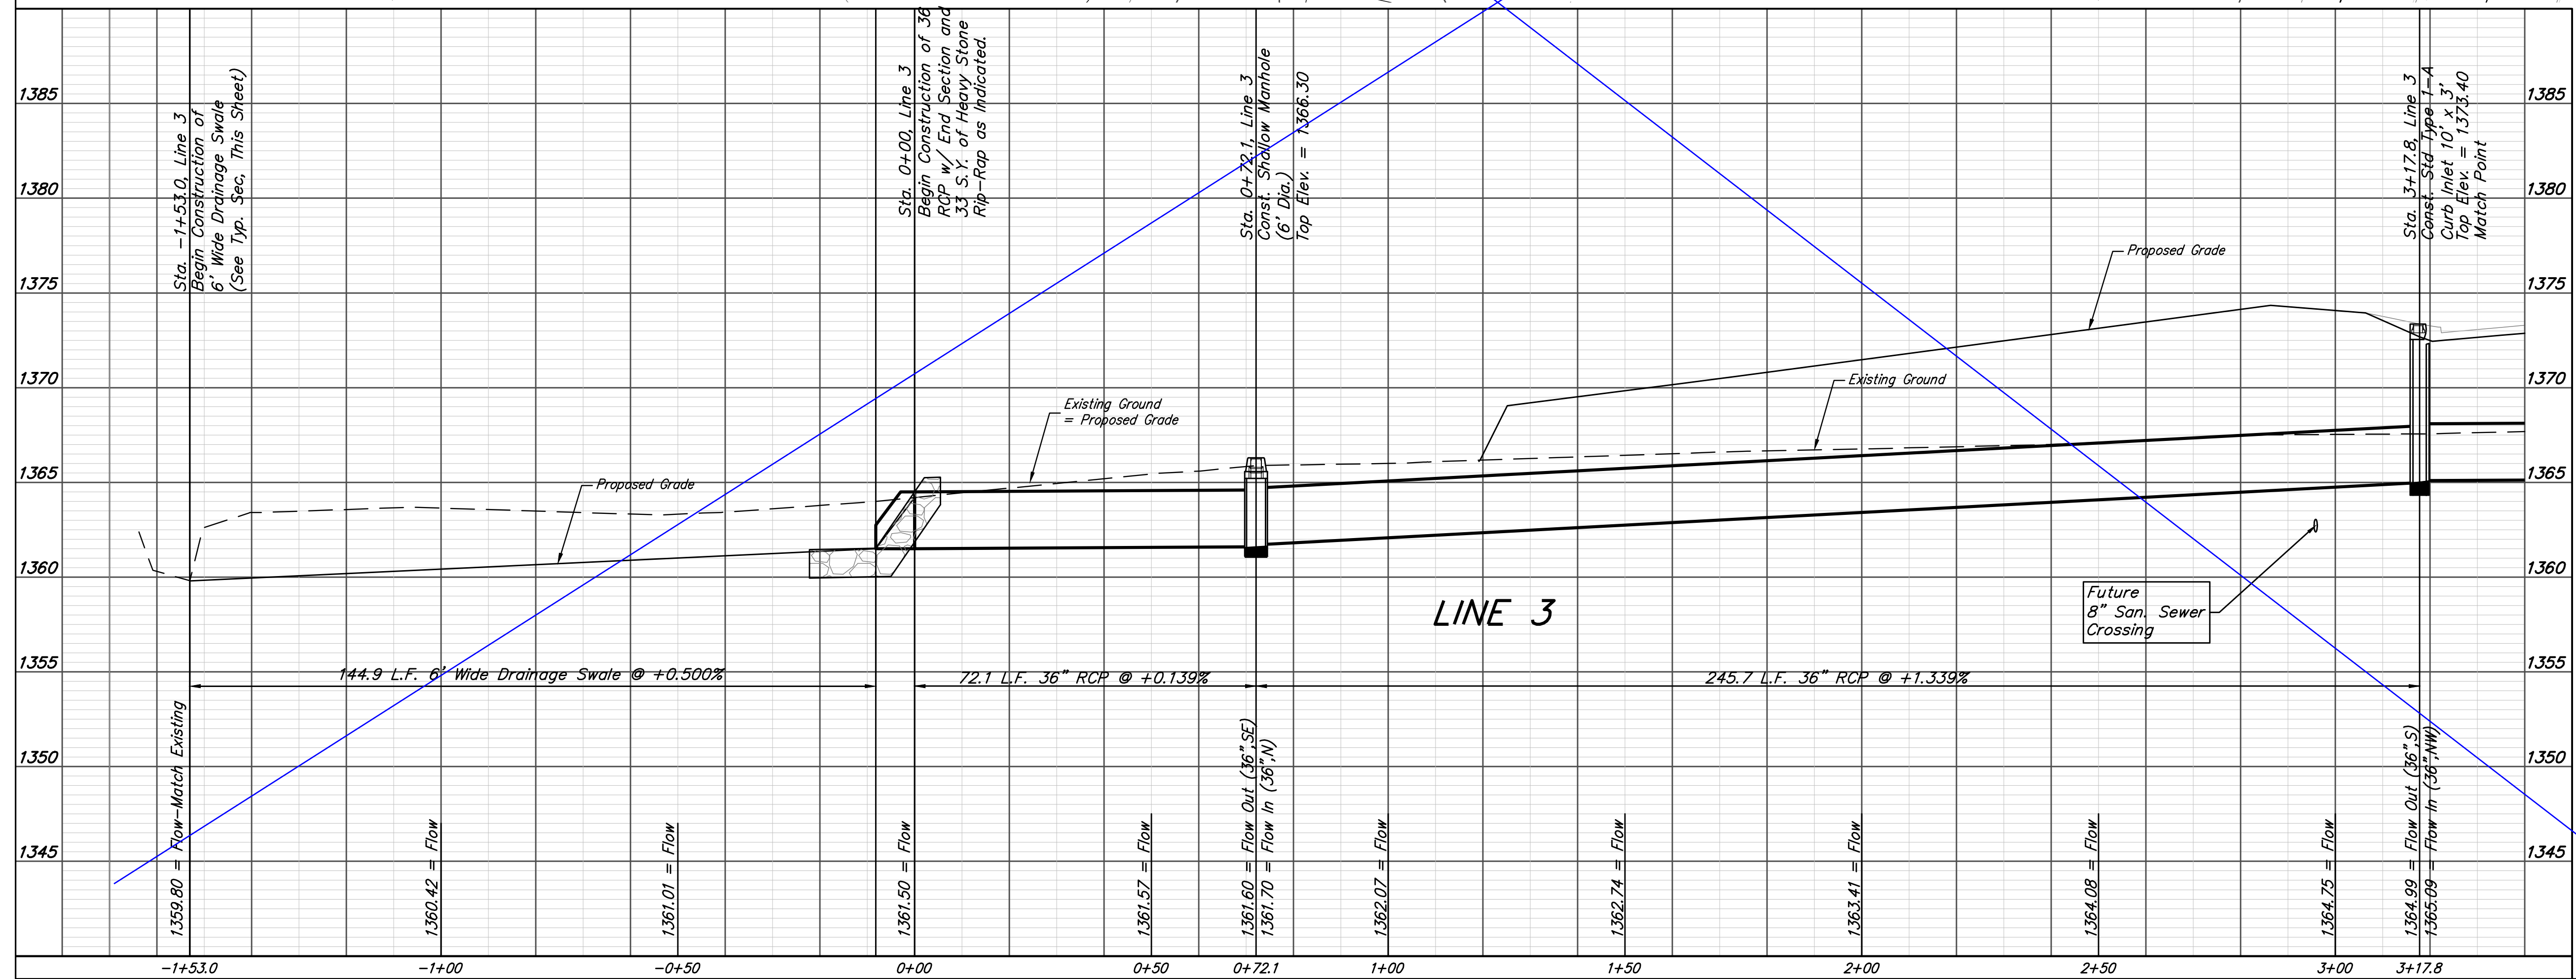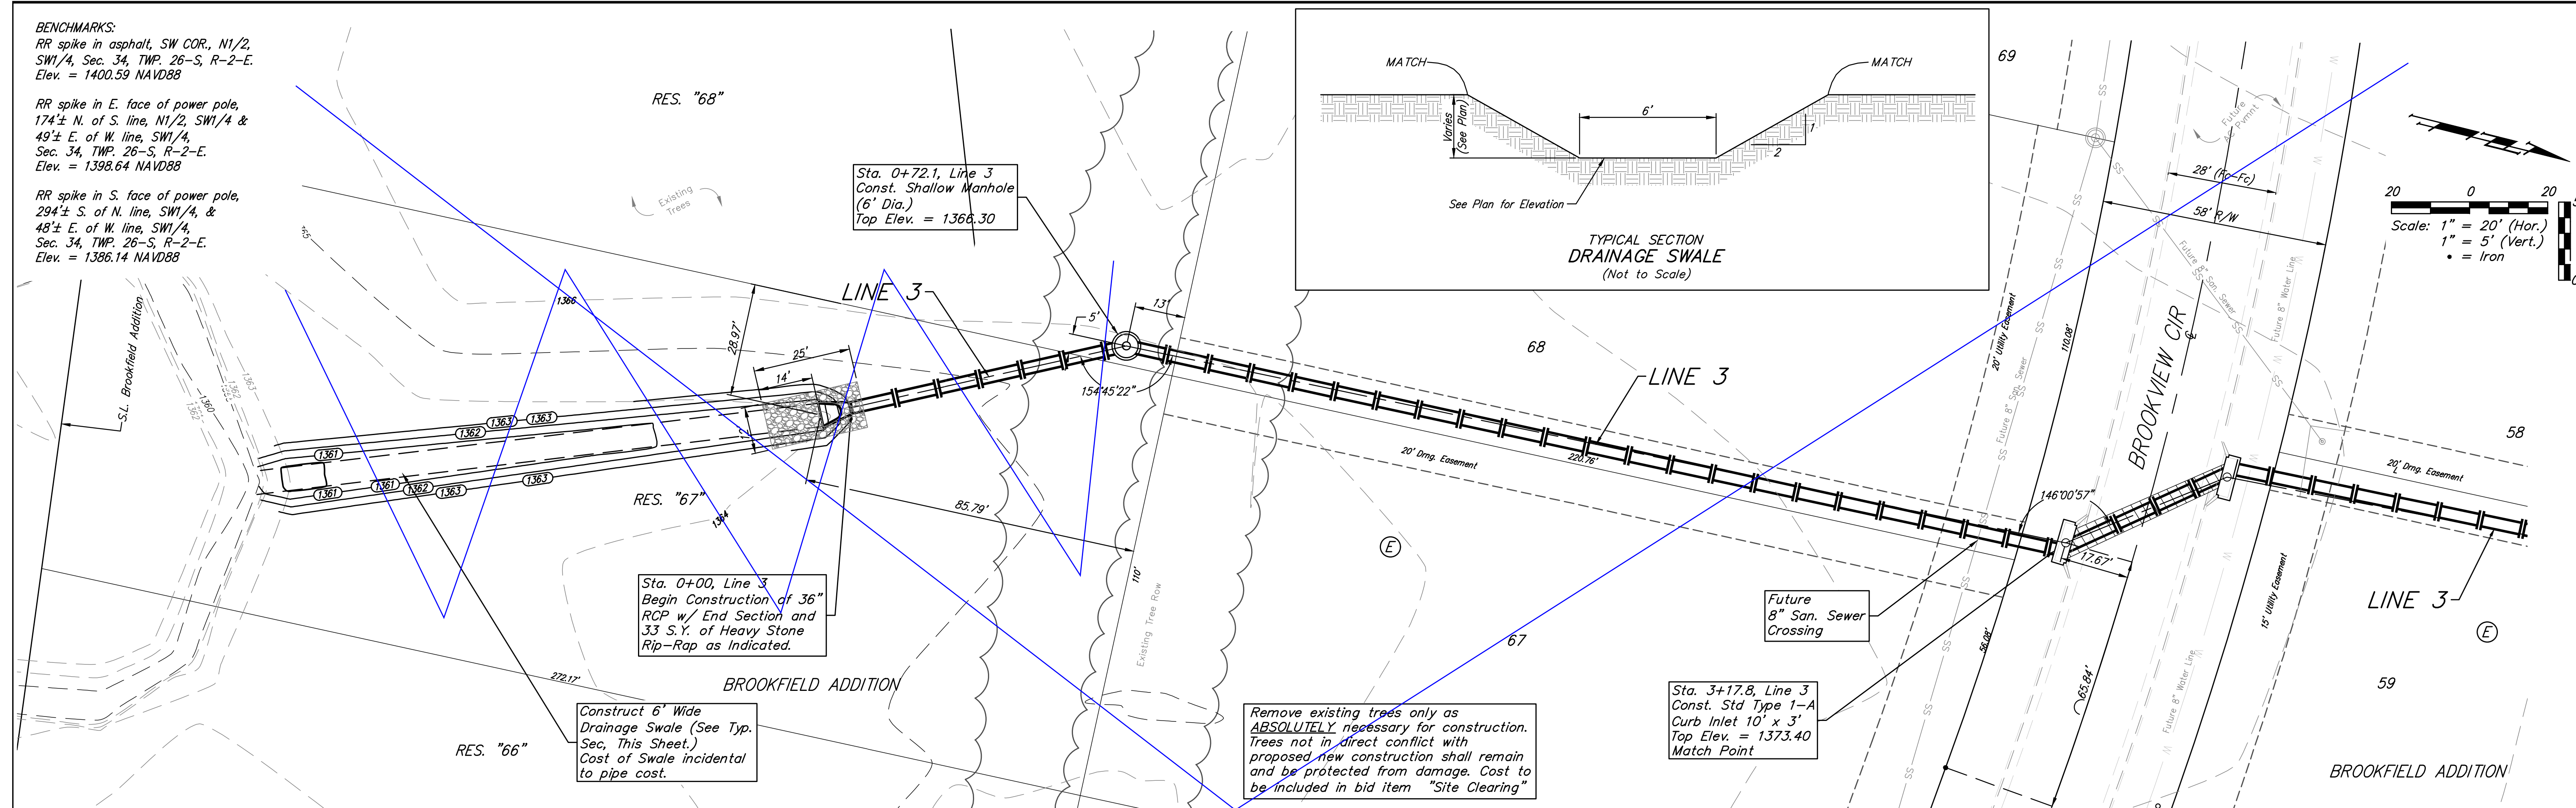

VOID - SEE SHEET 3R

		Brookfield Addition - Phase I LINE 3 Storm Water Drain Improvements	
		<small>Baughman Company, P.A. 315 Ellis St. Wichita, KS 67211 P 316-262-7271 F 316-262-0149 ENGINEERING SURVEYING PLANNING LANDSCAPE ARCHITECTURE</small>	
PROJECT NUMBER 468-85177	DESIGN AEG	DRAWN JAK	DATE 6/30/17
REVISIONS:	APPROVED	SCALE Noted	SHEET 3 OF 26

BENCHMARKS:
 RR spike in asphalt, SW COR., N1/2, SW1/4, Sec. 34, TWP. 26-S, R-2-E. Elev. = 1400.59 NAVD88
 RR spike in E. face of power pole, 174'± N. of S. line, N1/2, SW1/4 & 49'± E. of W. line, SW1/4, Sec. 34, TWP. 26-S, R-2-E. Elev. = 1398.64 NAVD88
 RR spike in S. face of power pole, 294'± S. of N. line, SW1/4, & 49'± E. of W. line, SW1/4, Sec. 34, TWP. 26-S, R-2-E. Elev. = 1386.14 NAVD88

Rotate Storm Sewer Pipe & End Section from 0+00 to 0+72.1 approx. 9° easterly (about 15' east at the end section) to avoid existing trees. Adjust drainage swale to match.
 Rev. 9/1/17 by AEG.





Sta. 0+72.1, Line 3
 Const. Shallow Manhole (6" Dia.)
 Top Elev. = 1366.30

Sta. 0+00, Line 3
 Begin Construction of 36" RCP w/ End Section and 33 S.Y. of Heavy Stone Rip-Rap as Indicated.

Construct 6' Wide Drainage Swale (See Typ. Sec. This Sheet.)
 Cost of Swale incidental to pipe cost.

Remove existing trees only as ABSOLUTELY necessary for construction. Trees not in direct conflict with proposed new construction shall remain and be protected from damage. Cost to be included in bid item "Site Clearing"

Sta. 3+17.8, Line 3
 Const. Std Type 1-A Curb Inlet 10' x 3'
 Top Elev. = 1373.40
 Match Point 73.24

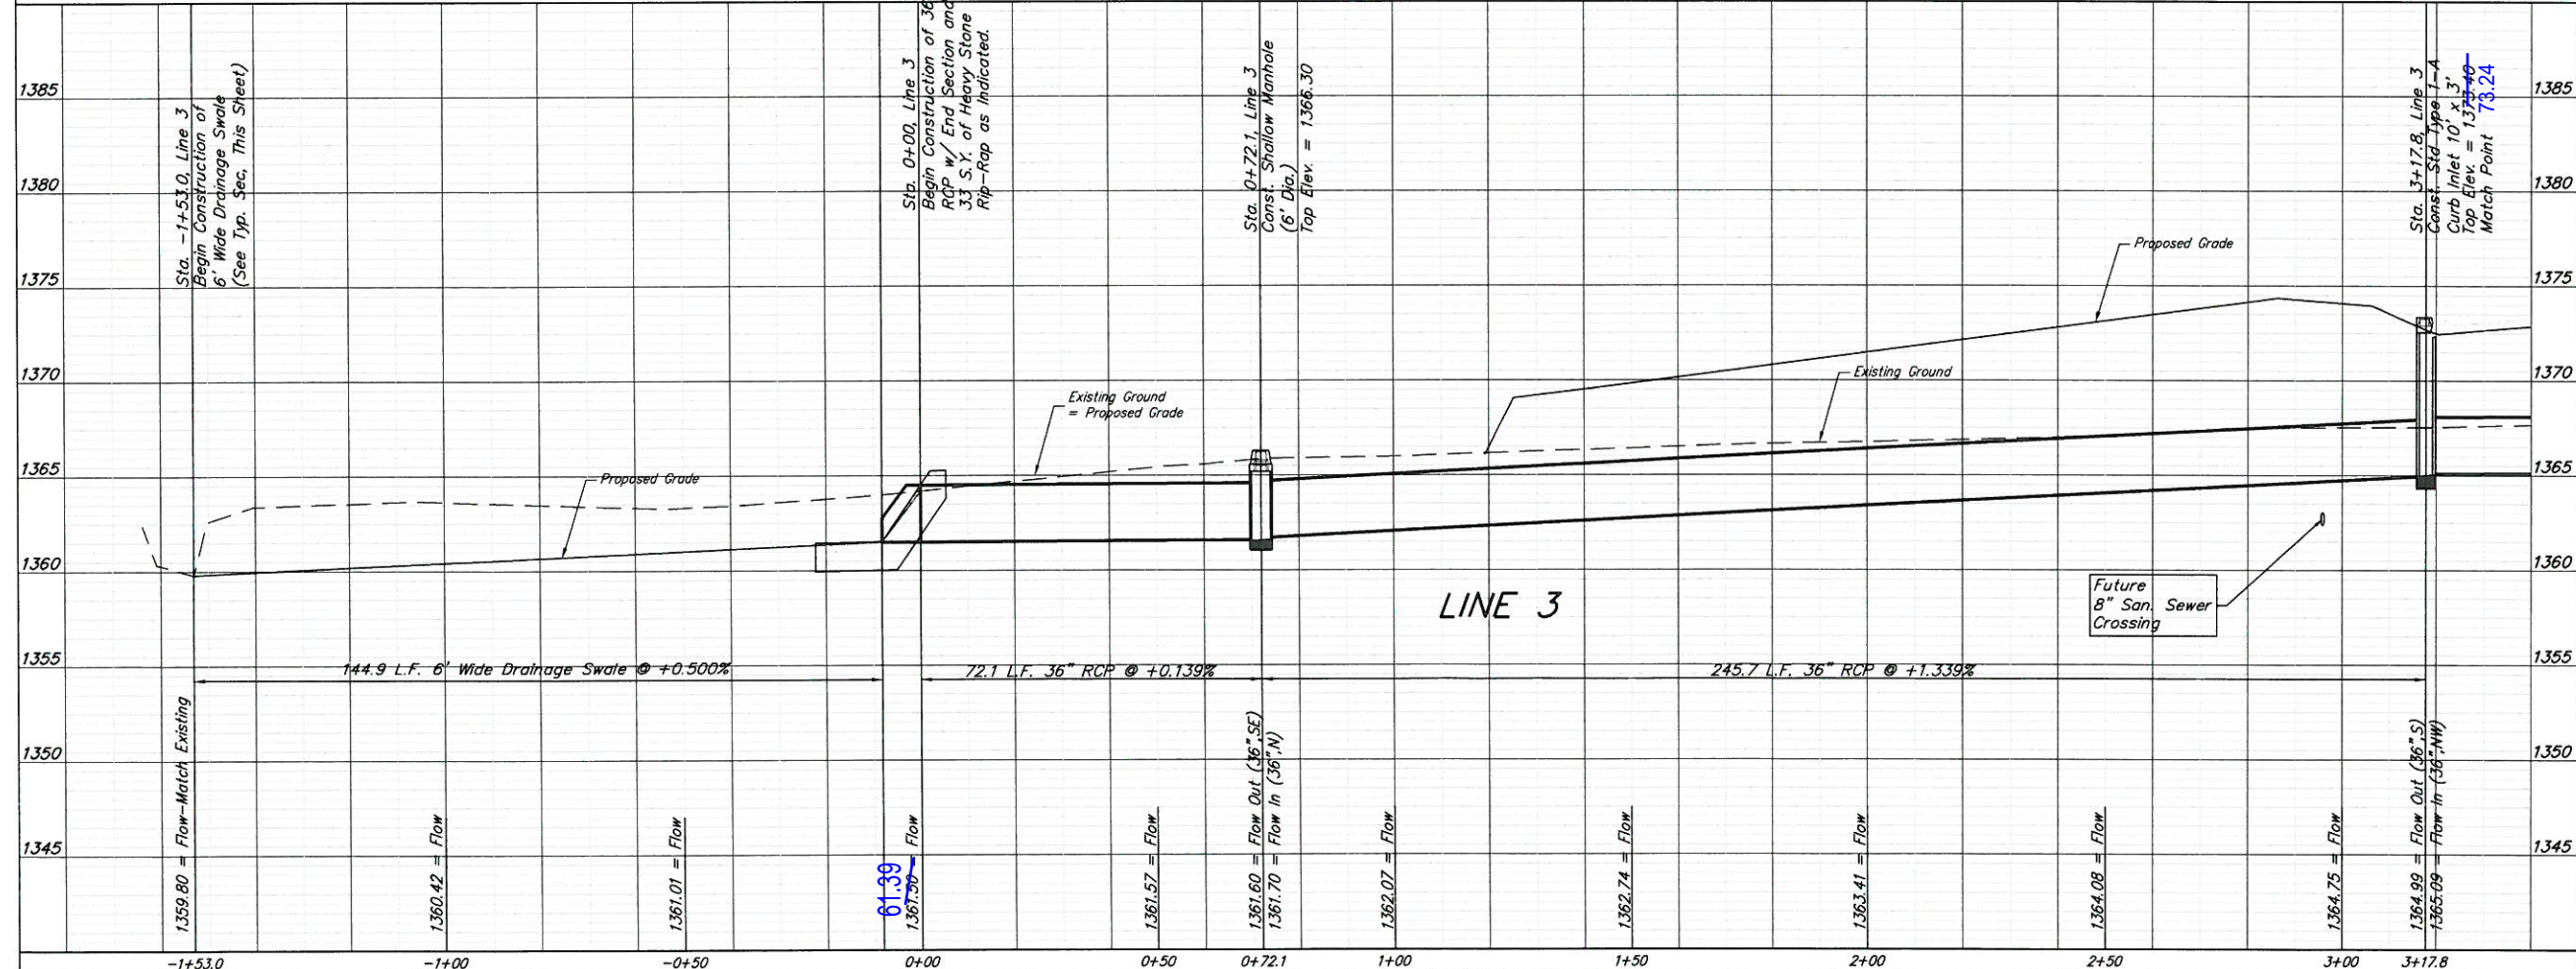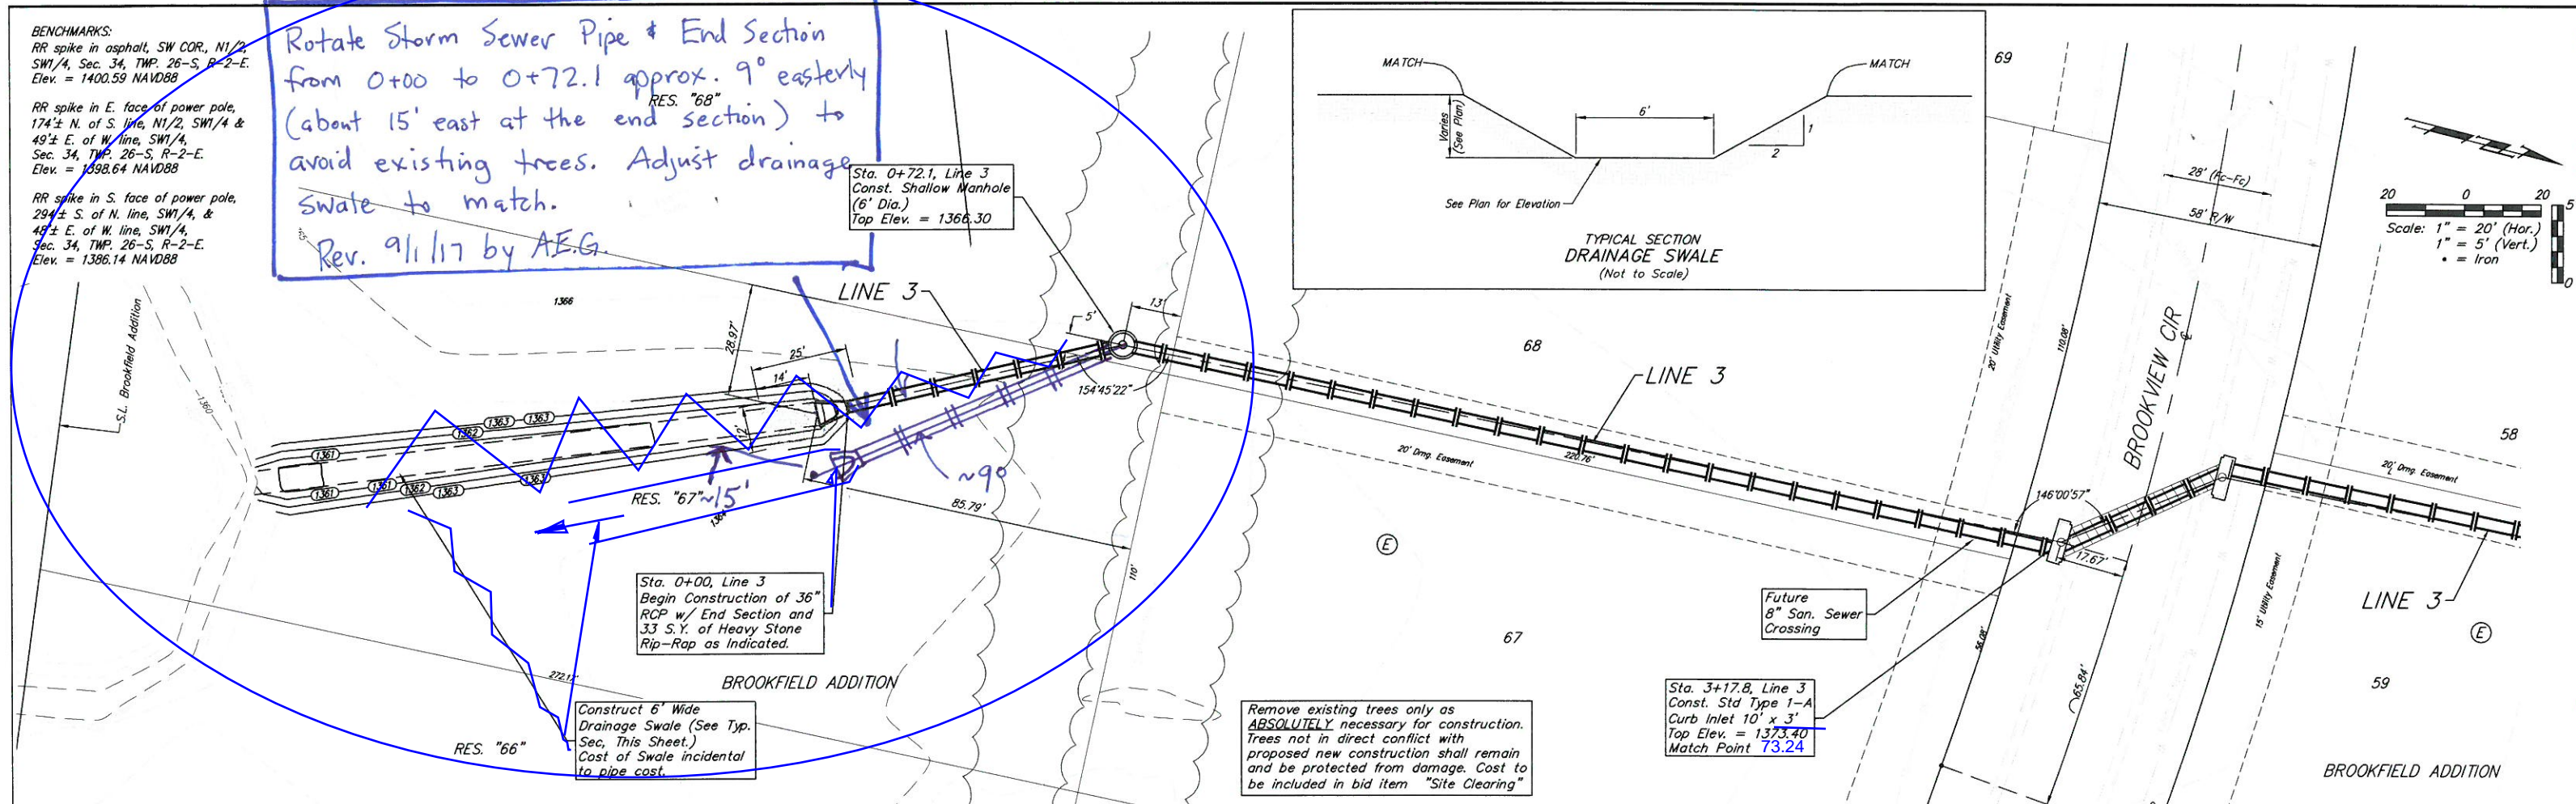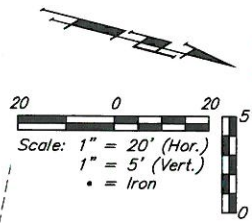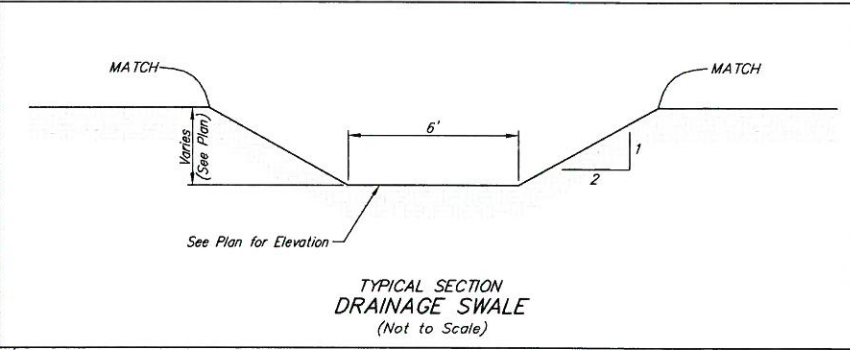




Baughman Brookfield Addition - Phase I
LINE 3
 Storm Water Drain Improvements

PROJECT NUMBER: 468-85177
 DESIGN: AEG
 DRAWN: JAK
 APPROVED: [Signature]
 DATE: 6/30/17

REVISIONS:
 9/1/17 A.G.





SCALE: Noted
 SHEET: 38 OF 26

BENCHMARKS:
 RR spike in asphalt, SW COR., N1/2, SW1/4, Sec. 34, TWP. 26-S, R-2-E. Elev. = 1400.59 NAVD88
 RR spike in E. face of power pole, 174± N. of S. line, N1/2, SW1/4 & 49± E. of W. line, SW1/4, Sec. 34, TWP. 26-S, R-2-E. Elev. = 1398.64 NAVD88
 RR spike in S. face of power pole, 294± S. of N. line, SW1/4, & 48± E. of W. line, SW1/4, Sec. 34, TWP. 26-S, R-2-E. Elev. = 1386.14 NAVD88

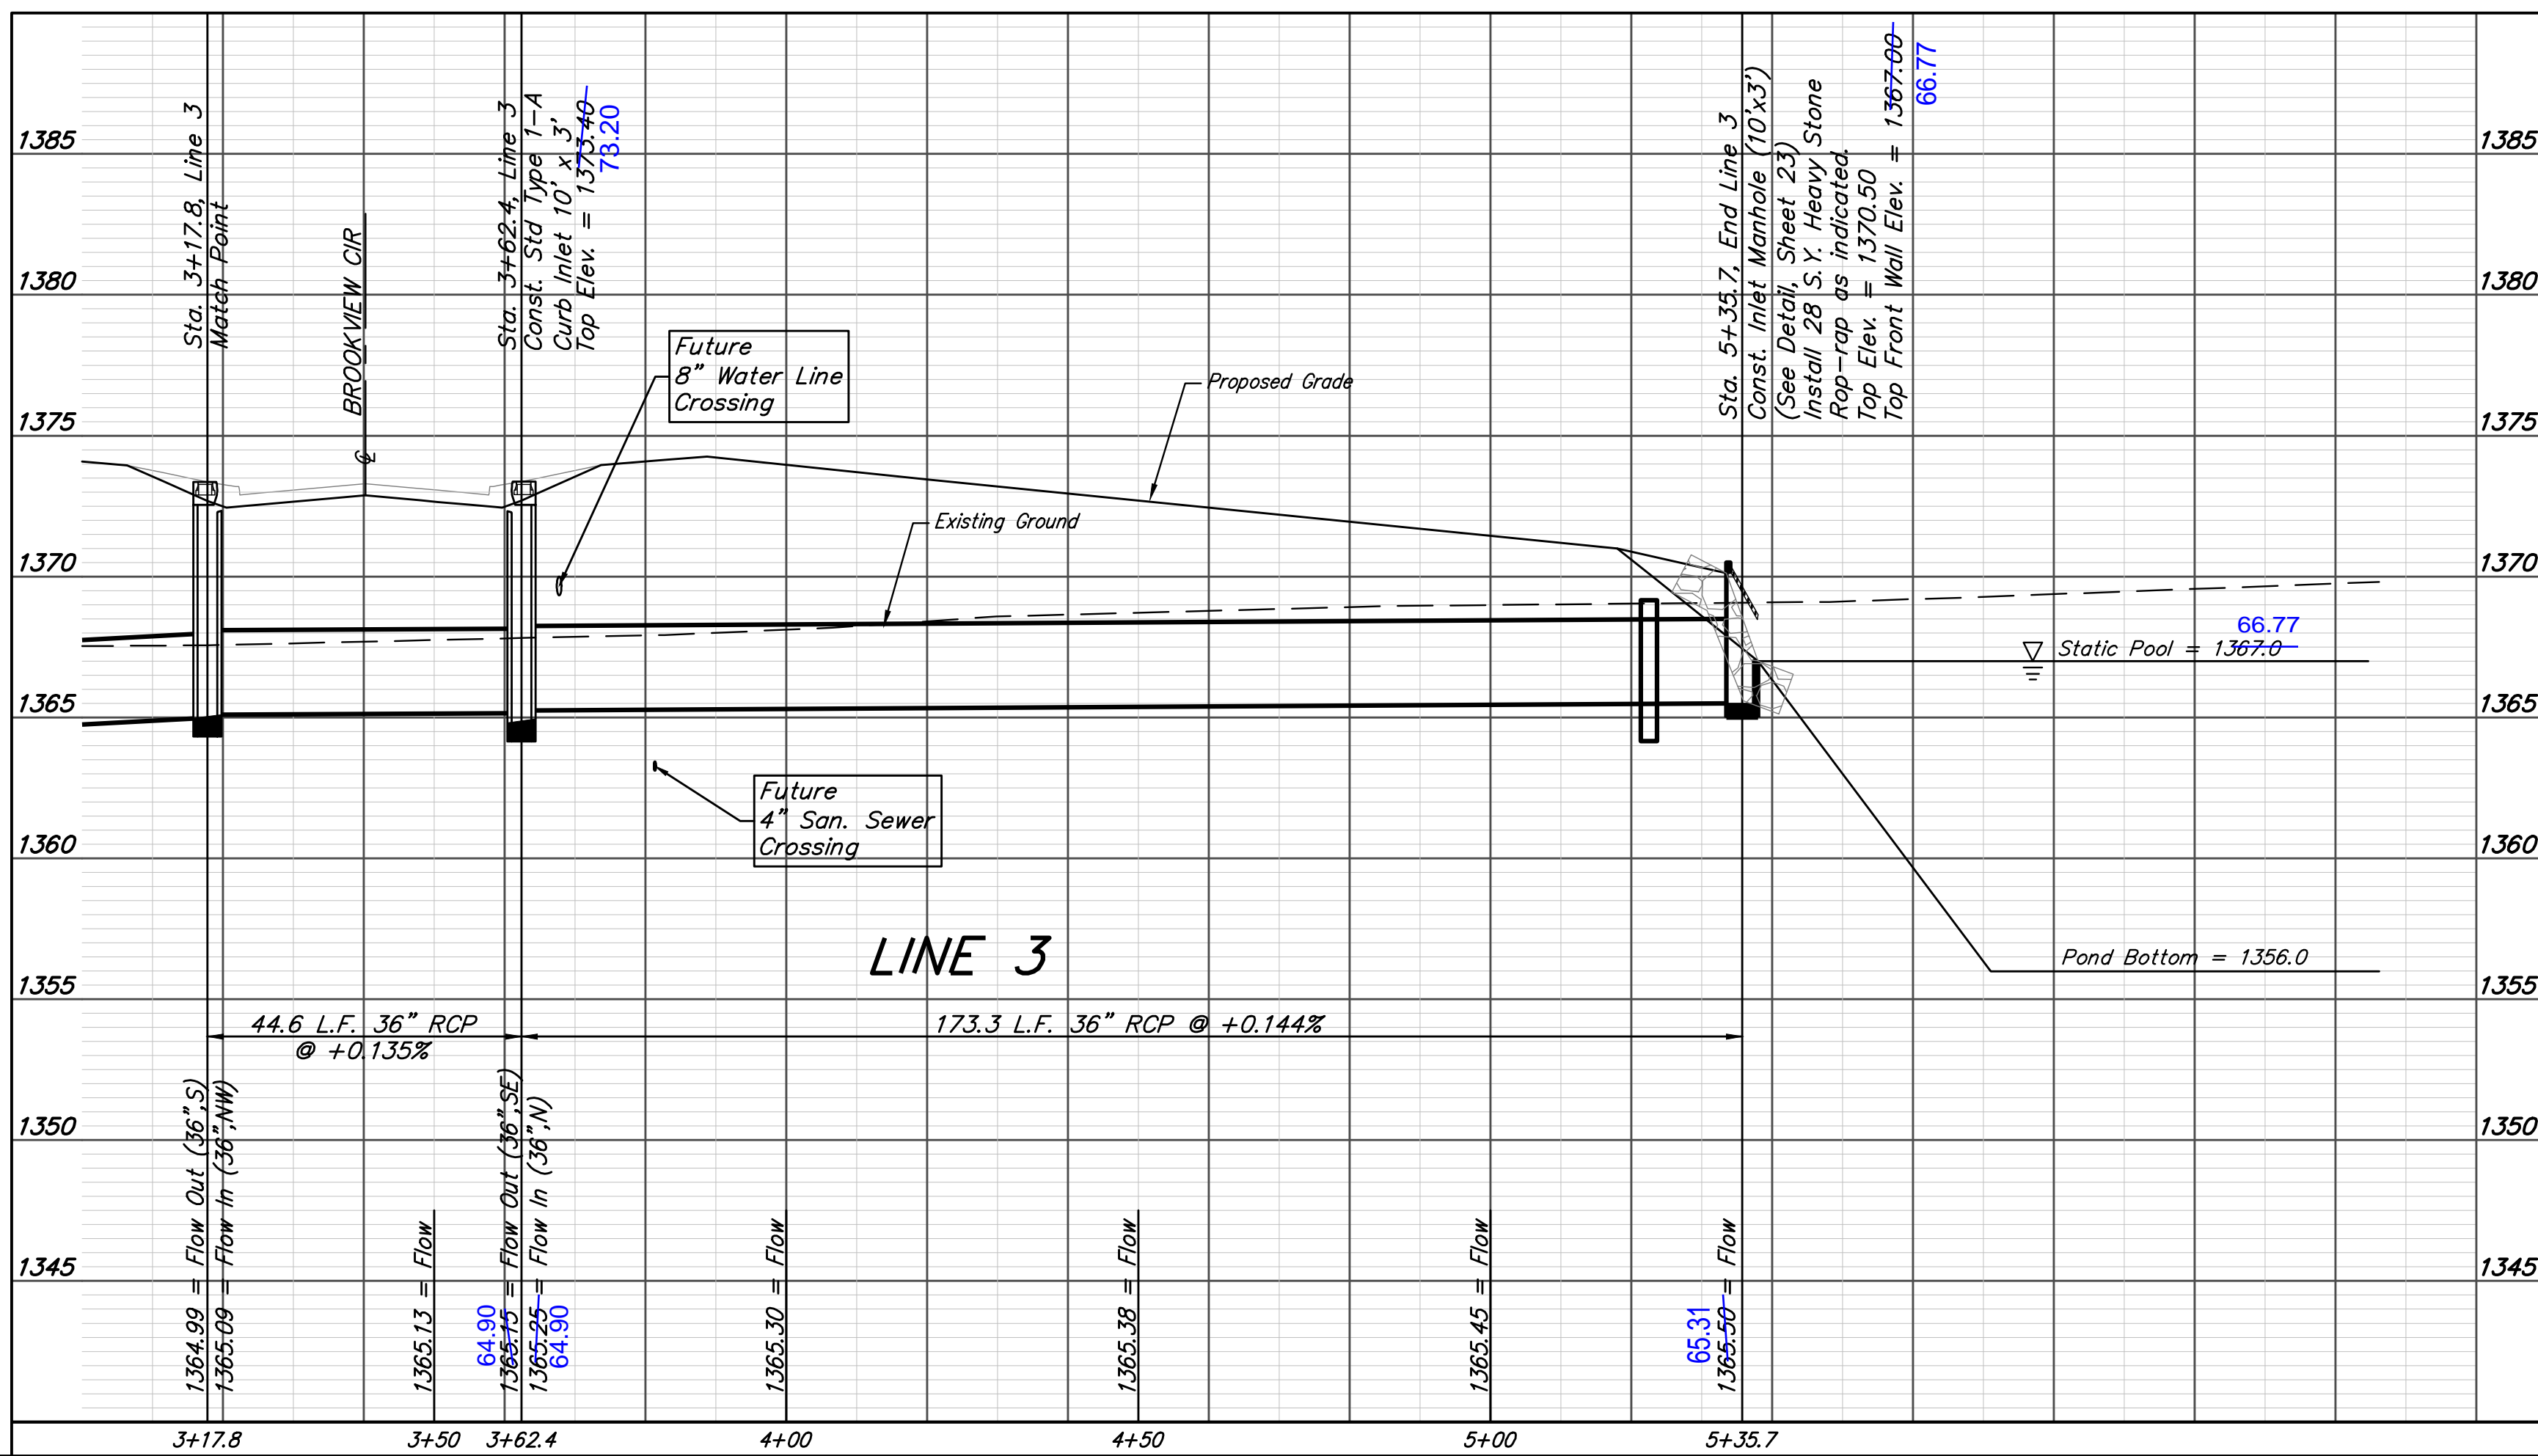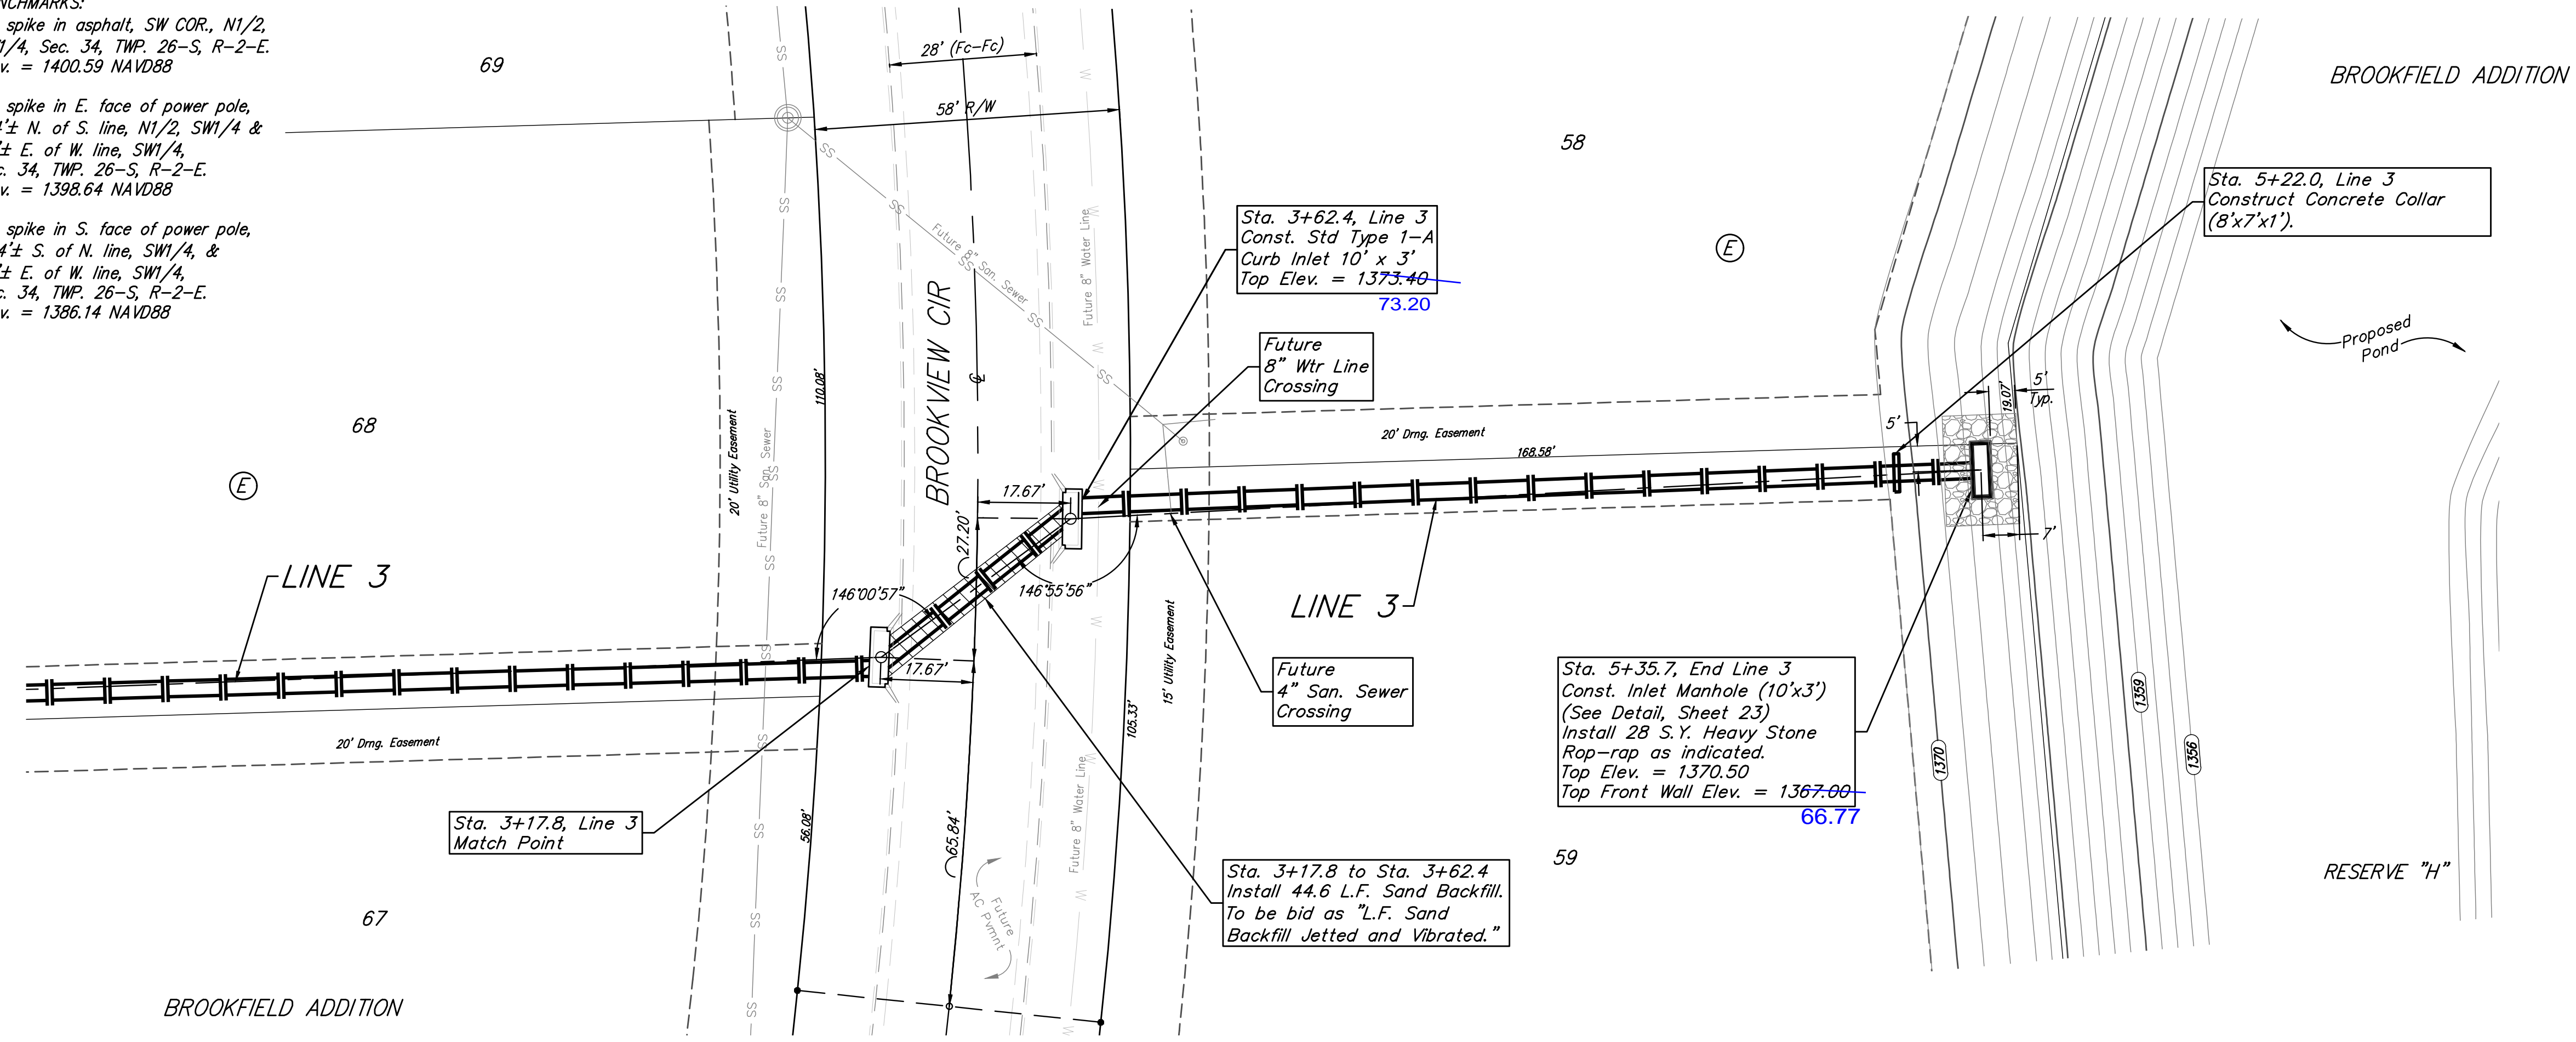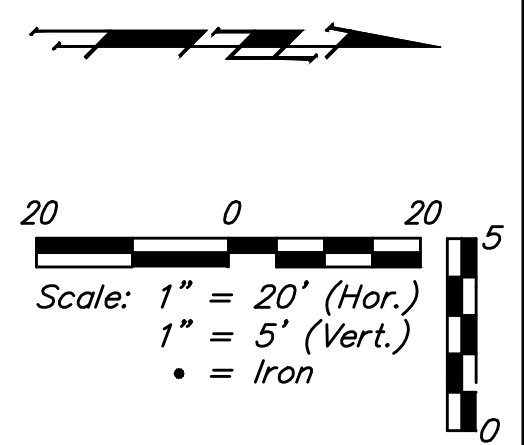

		Brookfield Addition - Phase I LINE 3 Storm Water Drain Improvements	
		<small>Baughman Company, P.A. 315 Ellis St. Wichita, KS 67211 P 316-262-7271 F 316-262-0149 ENGINEERING SURVEYING PLANNING LANDSCAPE ARCHITECTURE</small>	
PROJECT NUMBER 468-85177	DESIGN AEG	DRAWN JAK	
REVISIONS:	APPROVED	DATE 6/30/17	
	SCALE Noted		
	SHEET		4 OF 26

BENCHMARKS:
 RR spike in asphalt, SW COR., N1/2, SW1/4, Sec. 34, TWP. 26-S, R-2-E. Elev. = 1400.59 NAVD88
 RR spike in E. face of power pole, 174± N. of S. line, N1/2, SW1/4, & 49± E. of W. line, SW1/4, Sec. 34, TWP. 26-S, R-2-E. Elev. = 1398.64 NAVD88
 RR spike in S. face of power pole, 294± S. of N. line, SW1/4, & 48± E. of W. line, SW1/4, Sec. 34, TWP. 26-S, R-2-E. Elev. = 1386.14 NAVD88

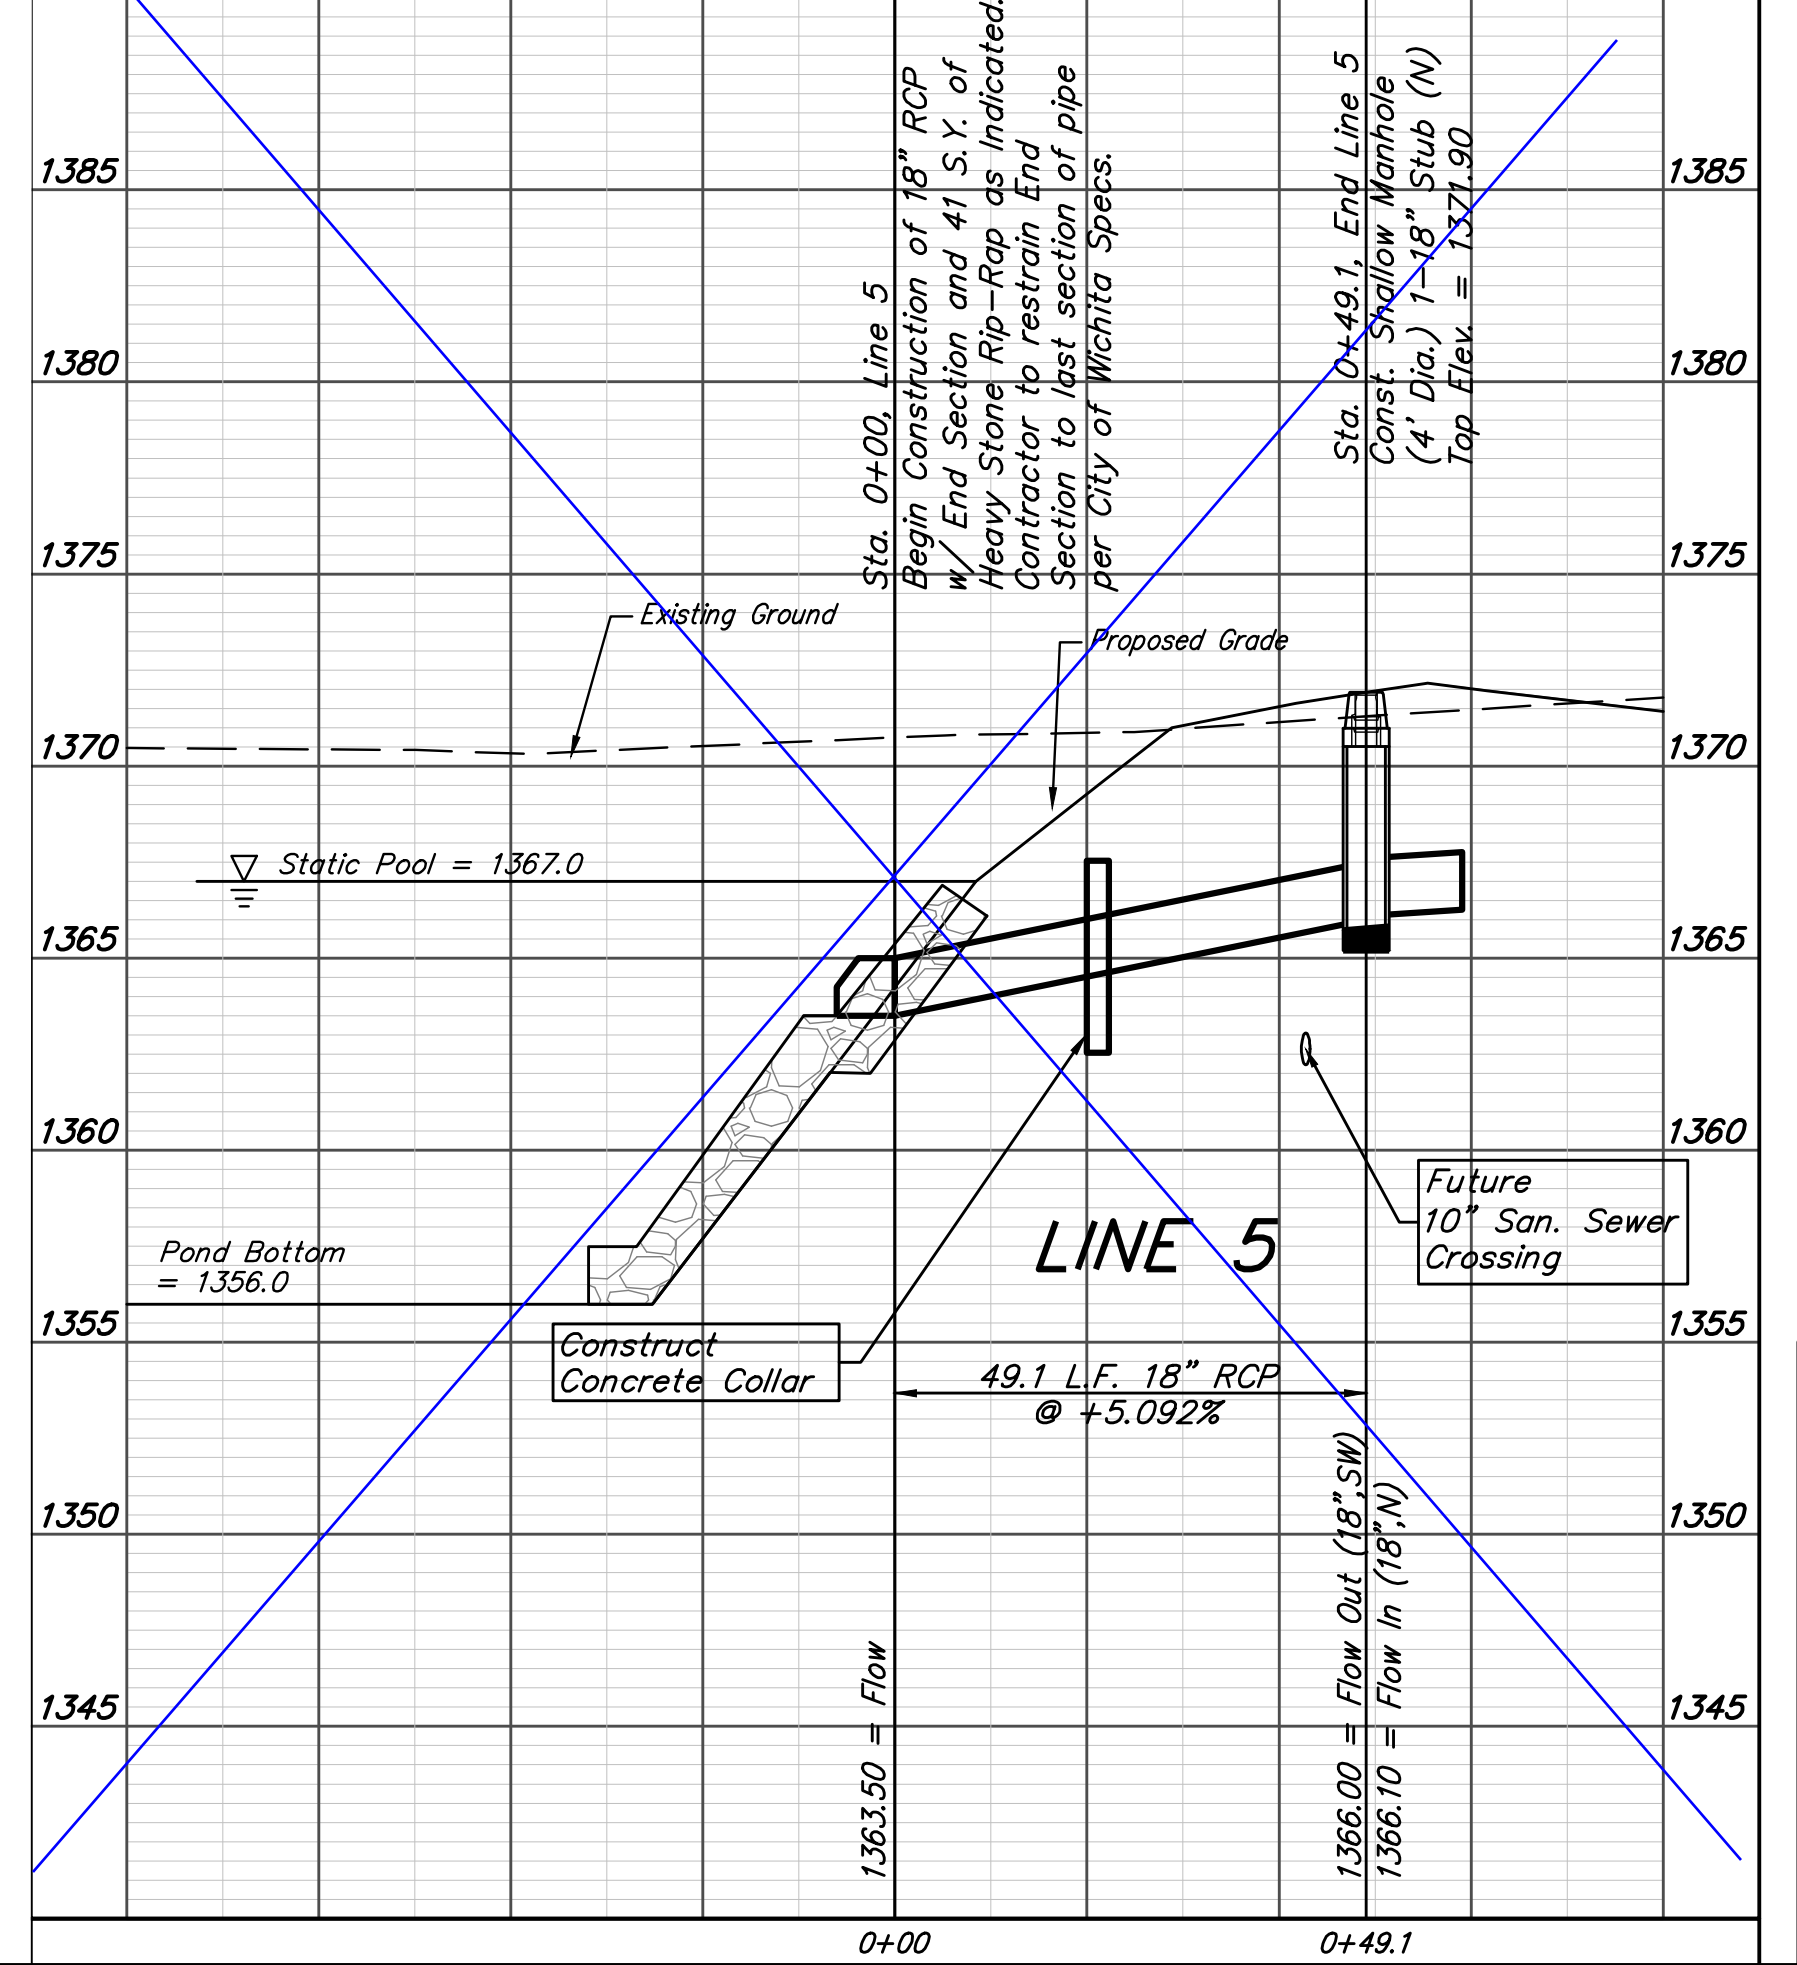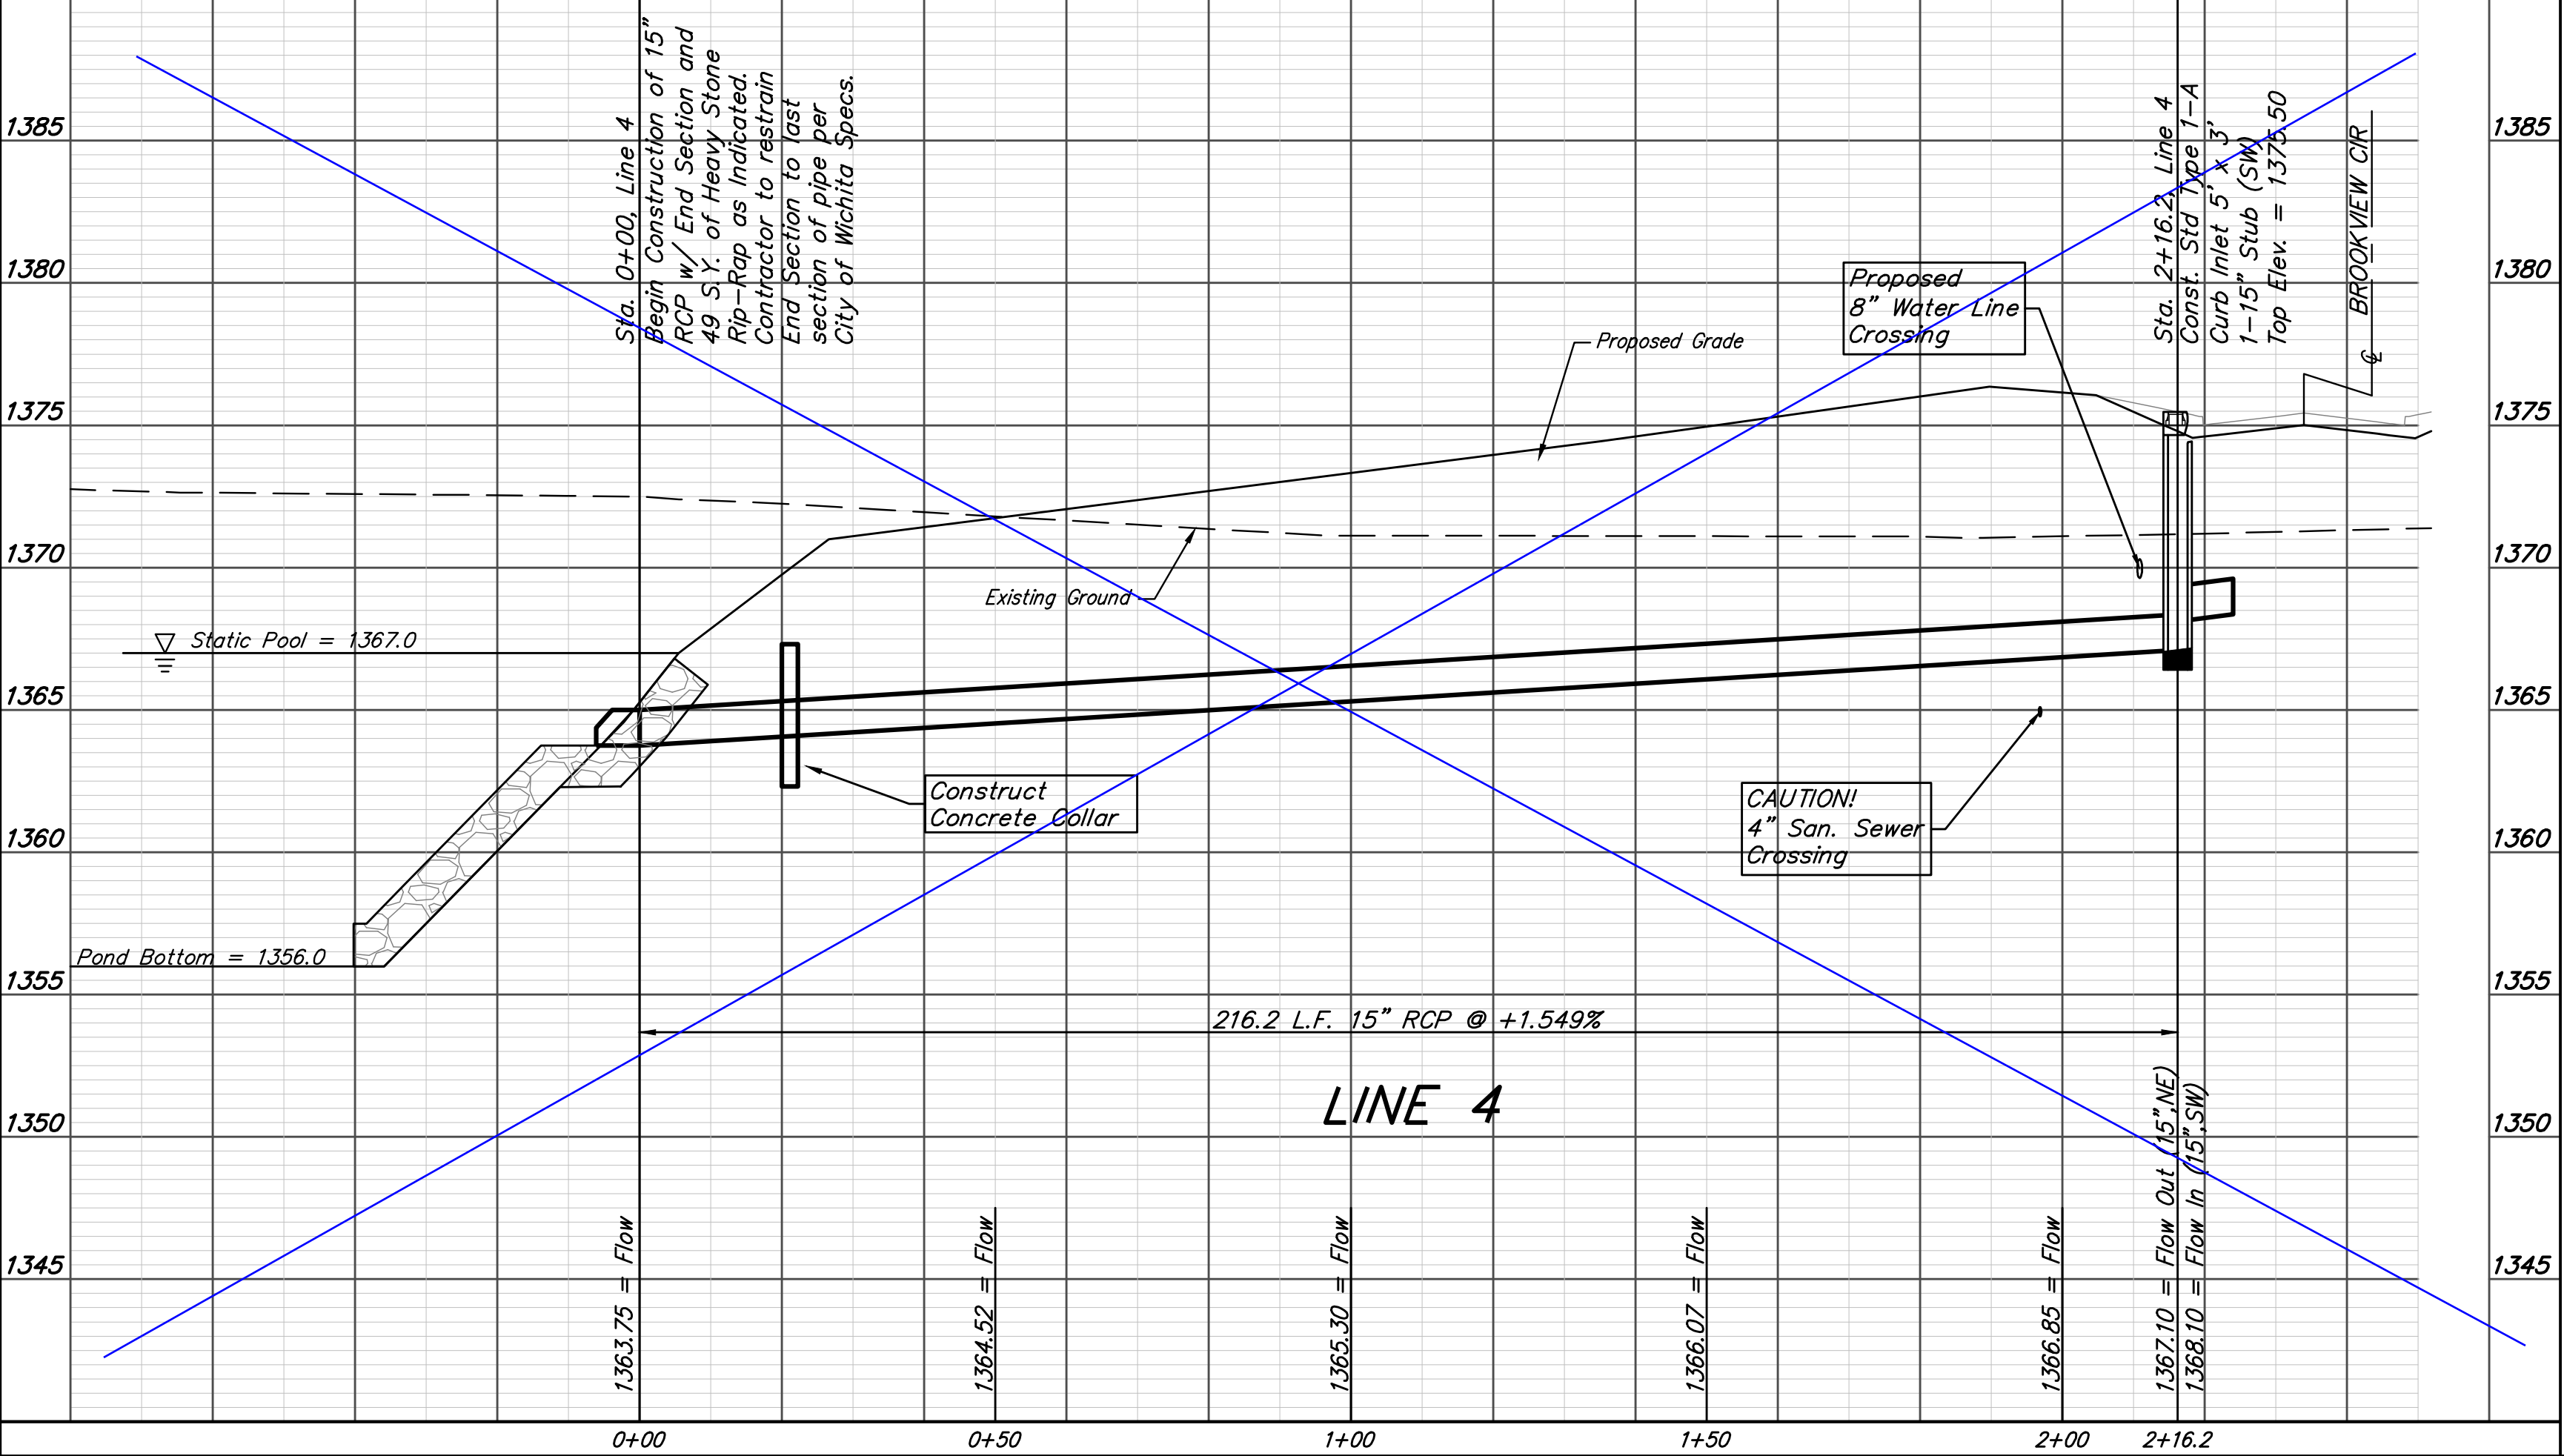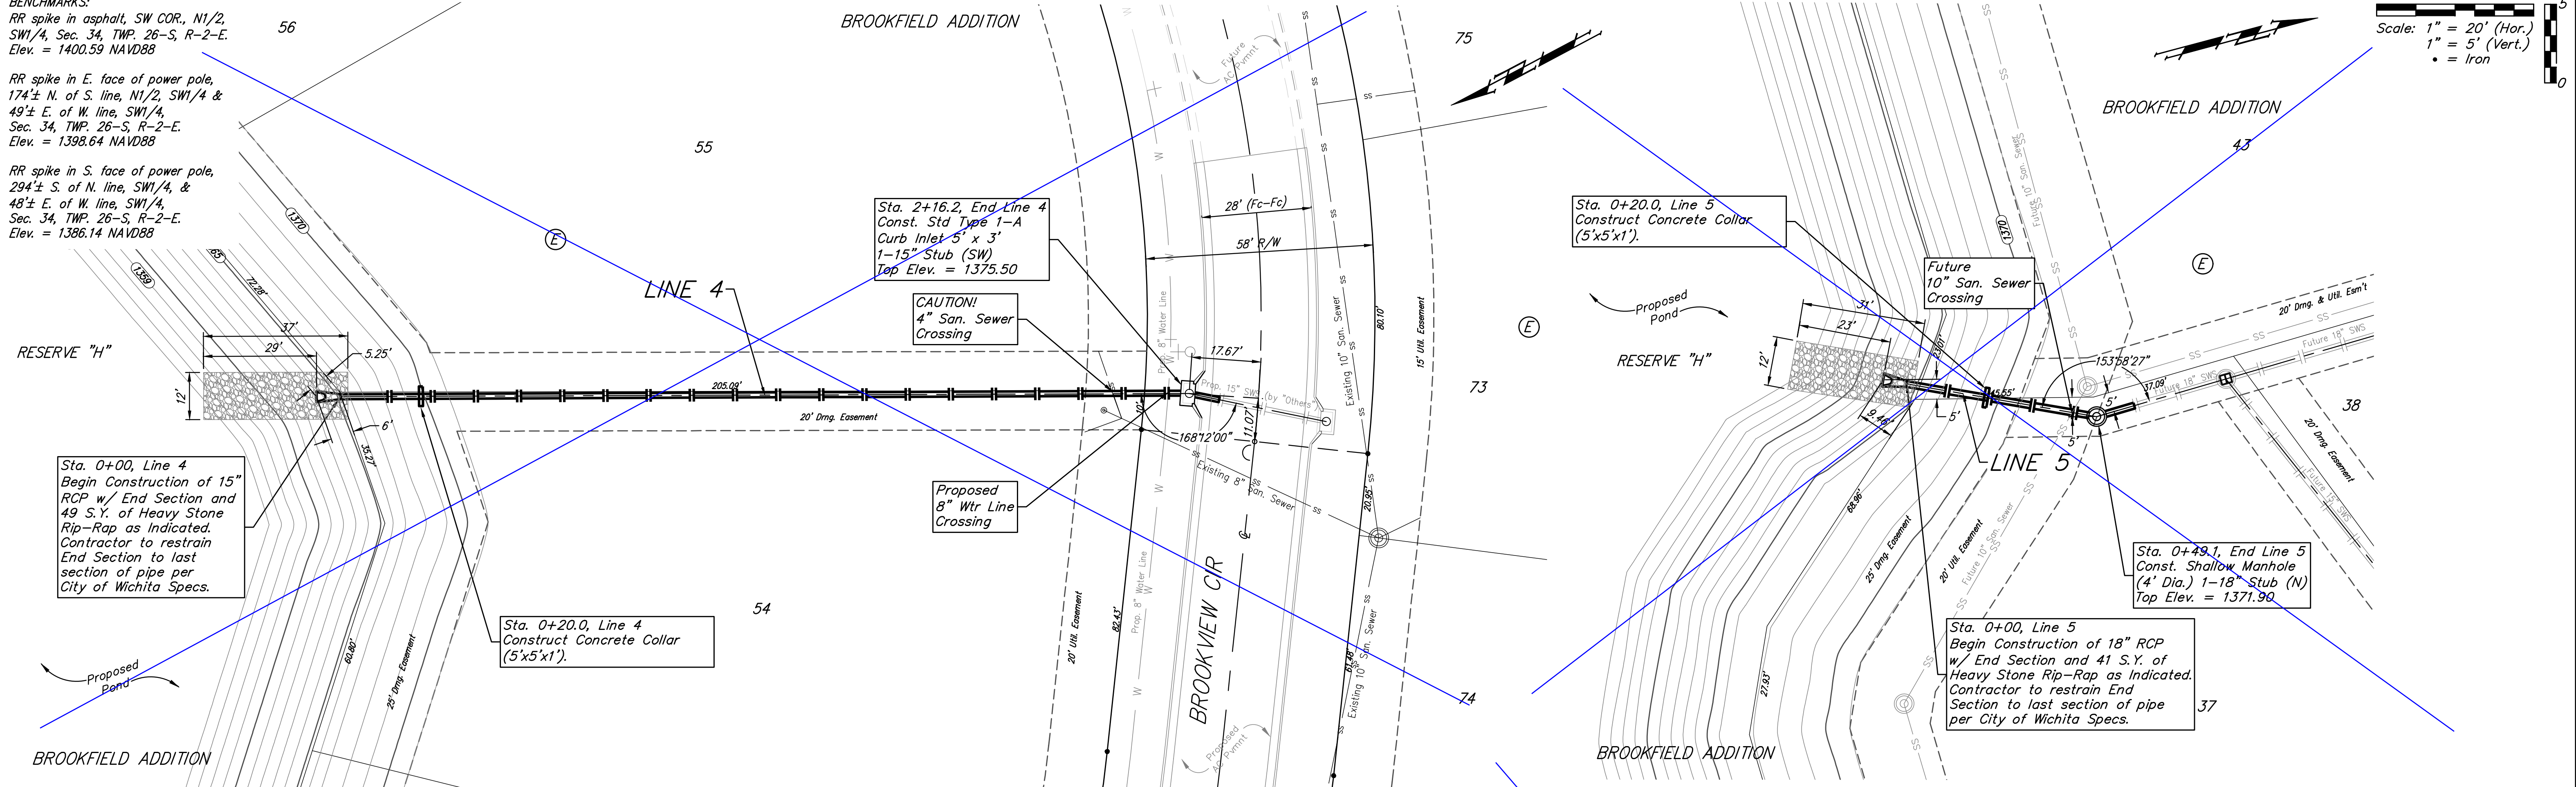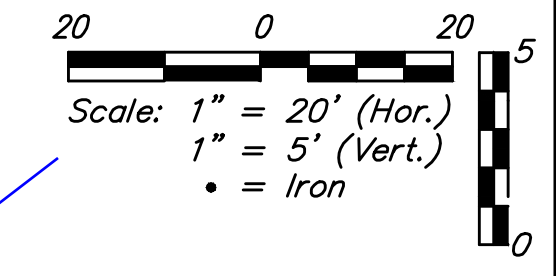

VOID - SEE SHEET 5R





		Brookfield Addition - Phase I LINE 4 & LINE 5 Storm Water Drain Improvements	
		<small>Baughman Company, P.A. 315 Ellis St. Wichita, KS 67211 P 316-262-7271 F 316-262-0149 ENGINEERING SURVEYING PLANNING LANDSCAPE ARCHITECTURE</small>	
PROJECT NUMBER 468-85177	DESIGN AEG	DRAWN JAK	SCALE Noted SHEET 5 OF 26
REVISIONS:	APPROVED 	DATE 6/30/17	

E:\Projects\Brookfield Addition_1664F190\Engineering\Phase I\SWD_1668E543\SWD PLANS.dwg

BENCHMARKS:
 RR spike in asphalt, SW COR., N1/2, SW1/4, Sec. 34, TWP. 26-S, R-2-E.
 Elev. = 1400.59 NAVD88

RR spike in E. face of power pole,
 174± N. of S. line, N1/2, SW1/4 &
 49± E. of W. line, SW1/4,
 Sec. 34, TWP. 26-S, R-2-E.
 Elev. = 1398.64 NAVD88

RR spike in S. face of power pole,
 294± S. of N. line, SW1/4, &
 48± E. of W. line, SW1/4,
 Sec. 34, TWP. 26-S, R-2-E.
 Elev. = 1386.14 NAVD88


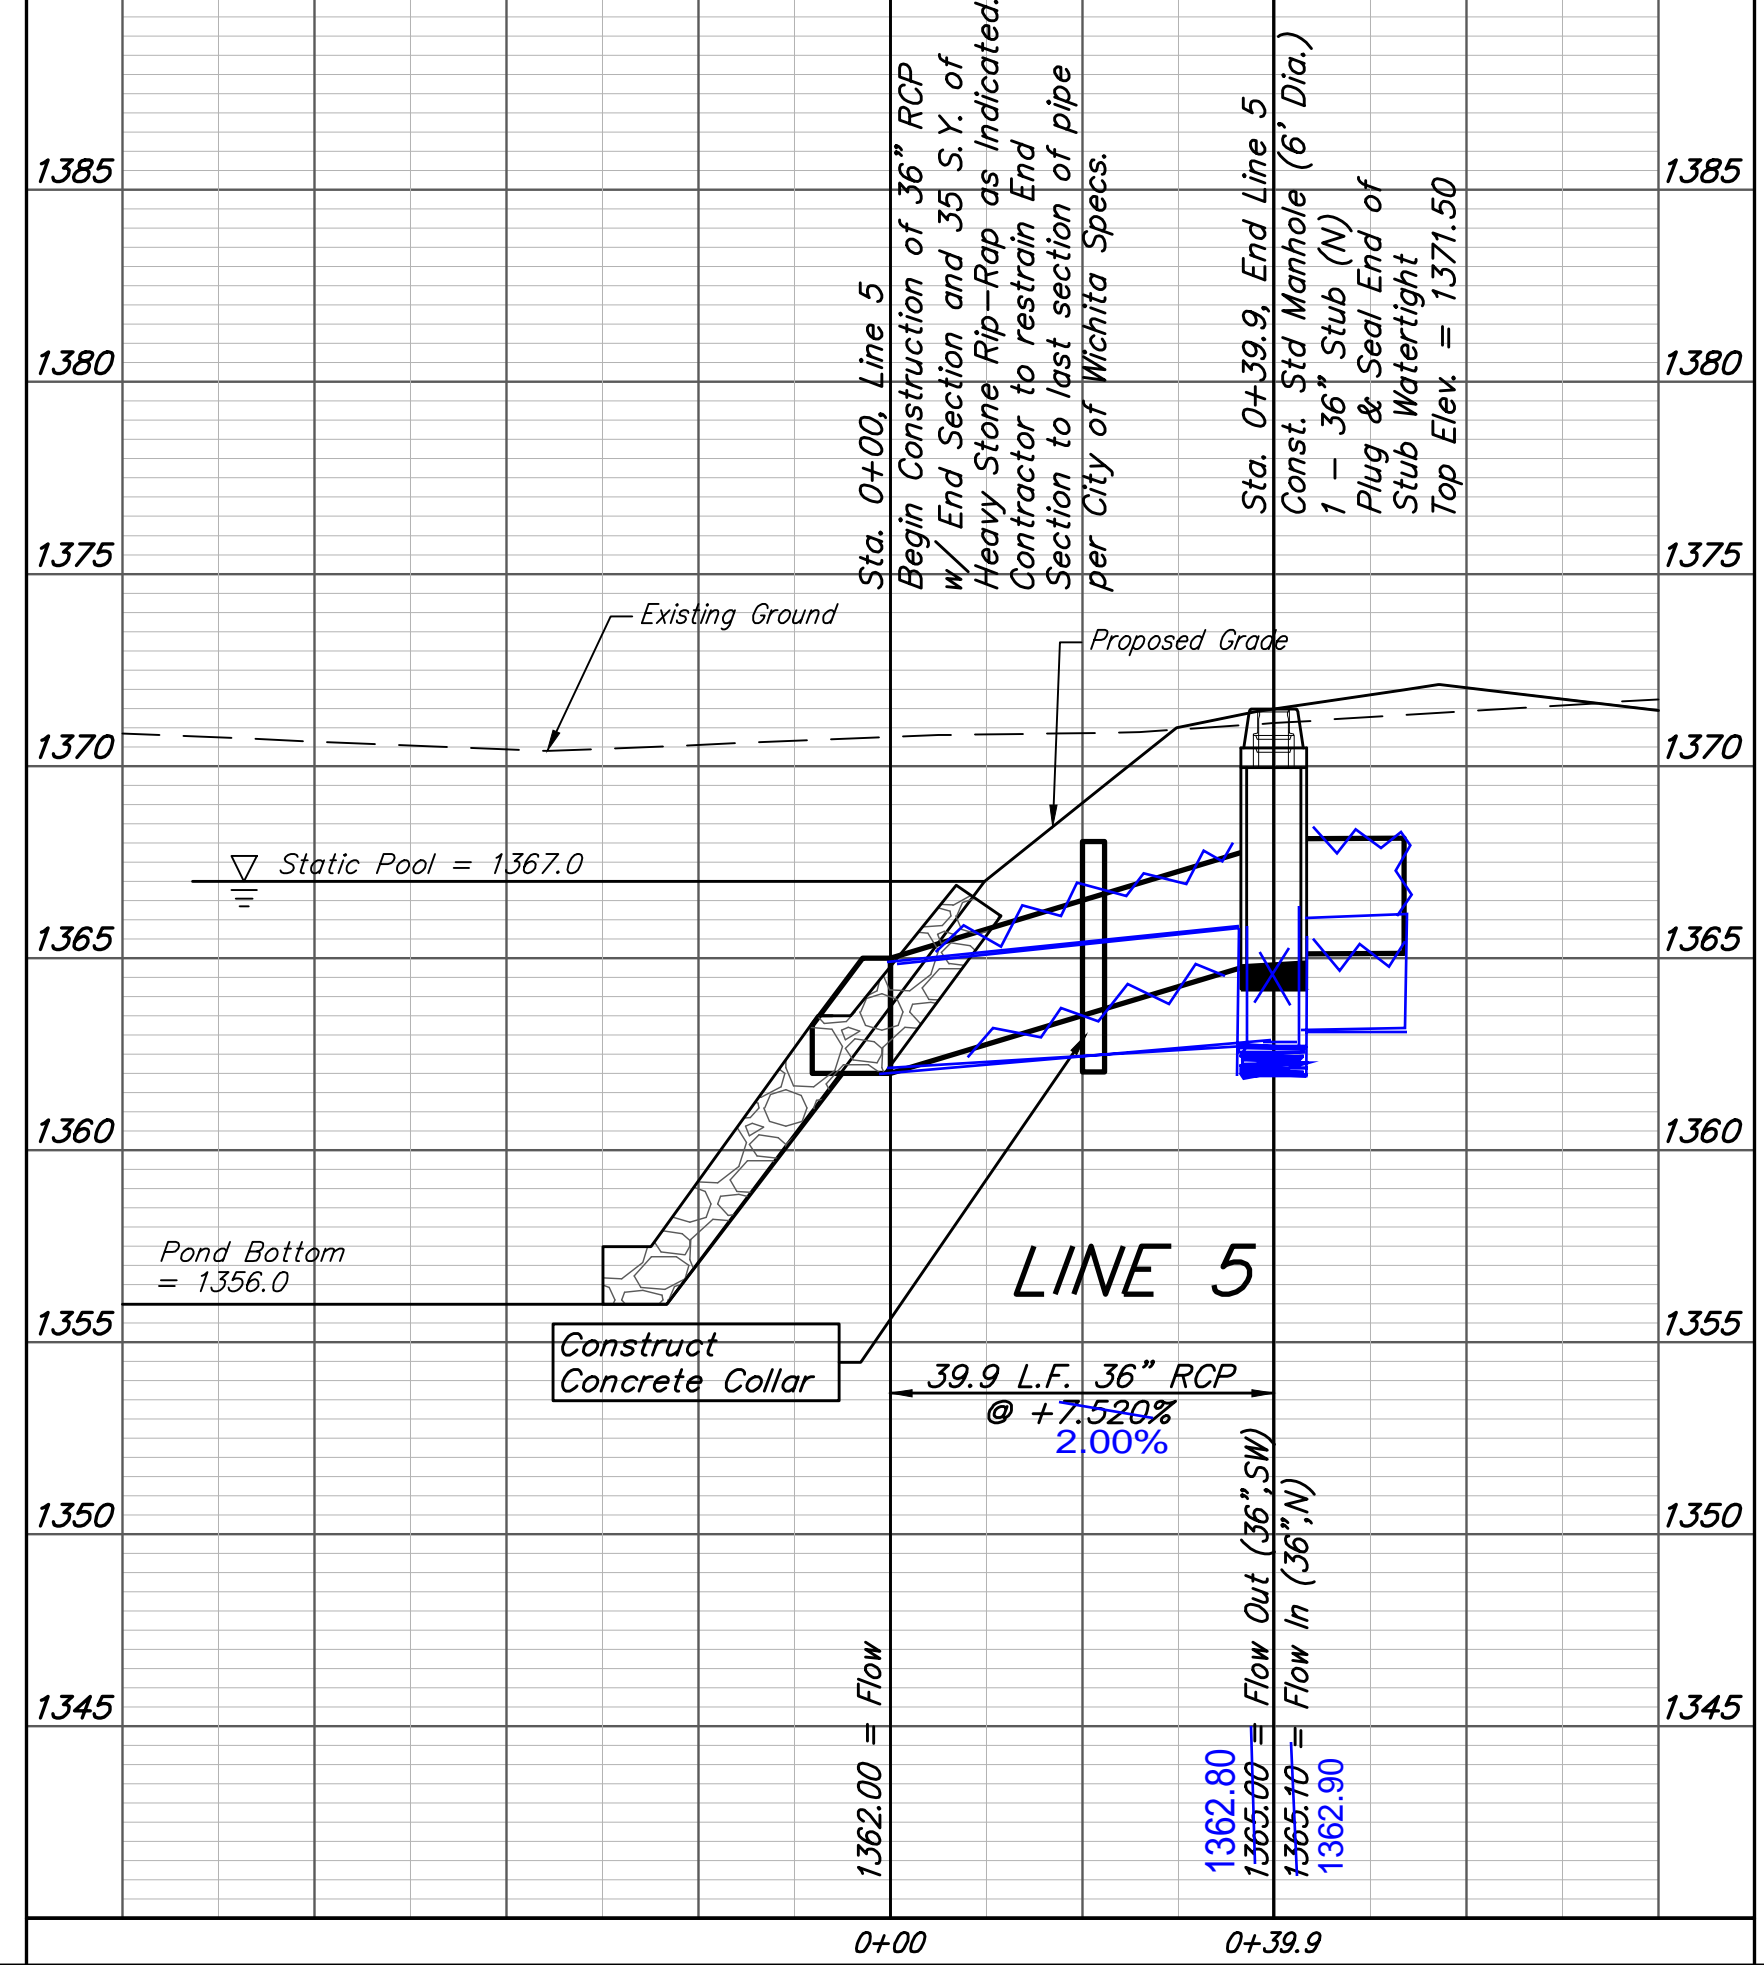
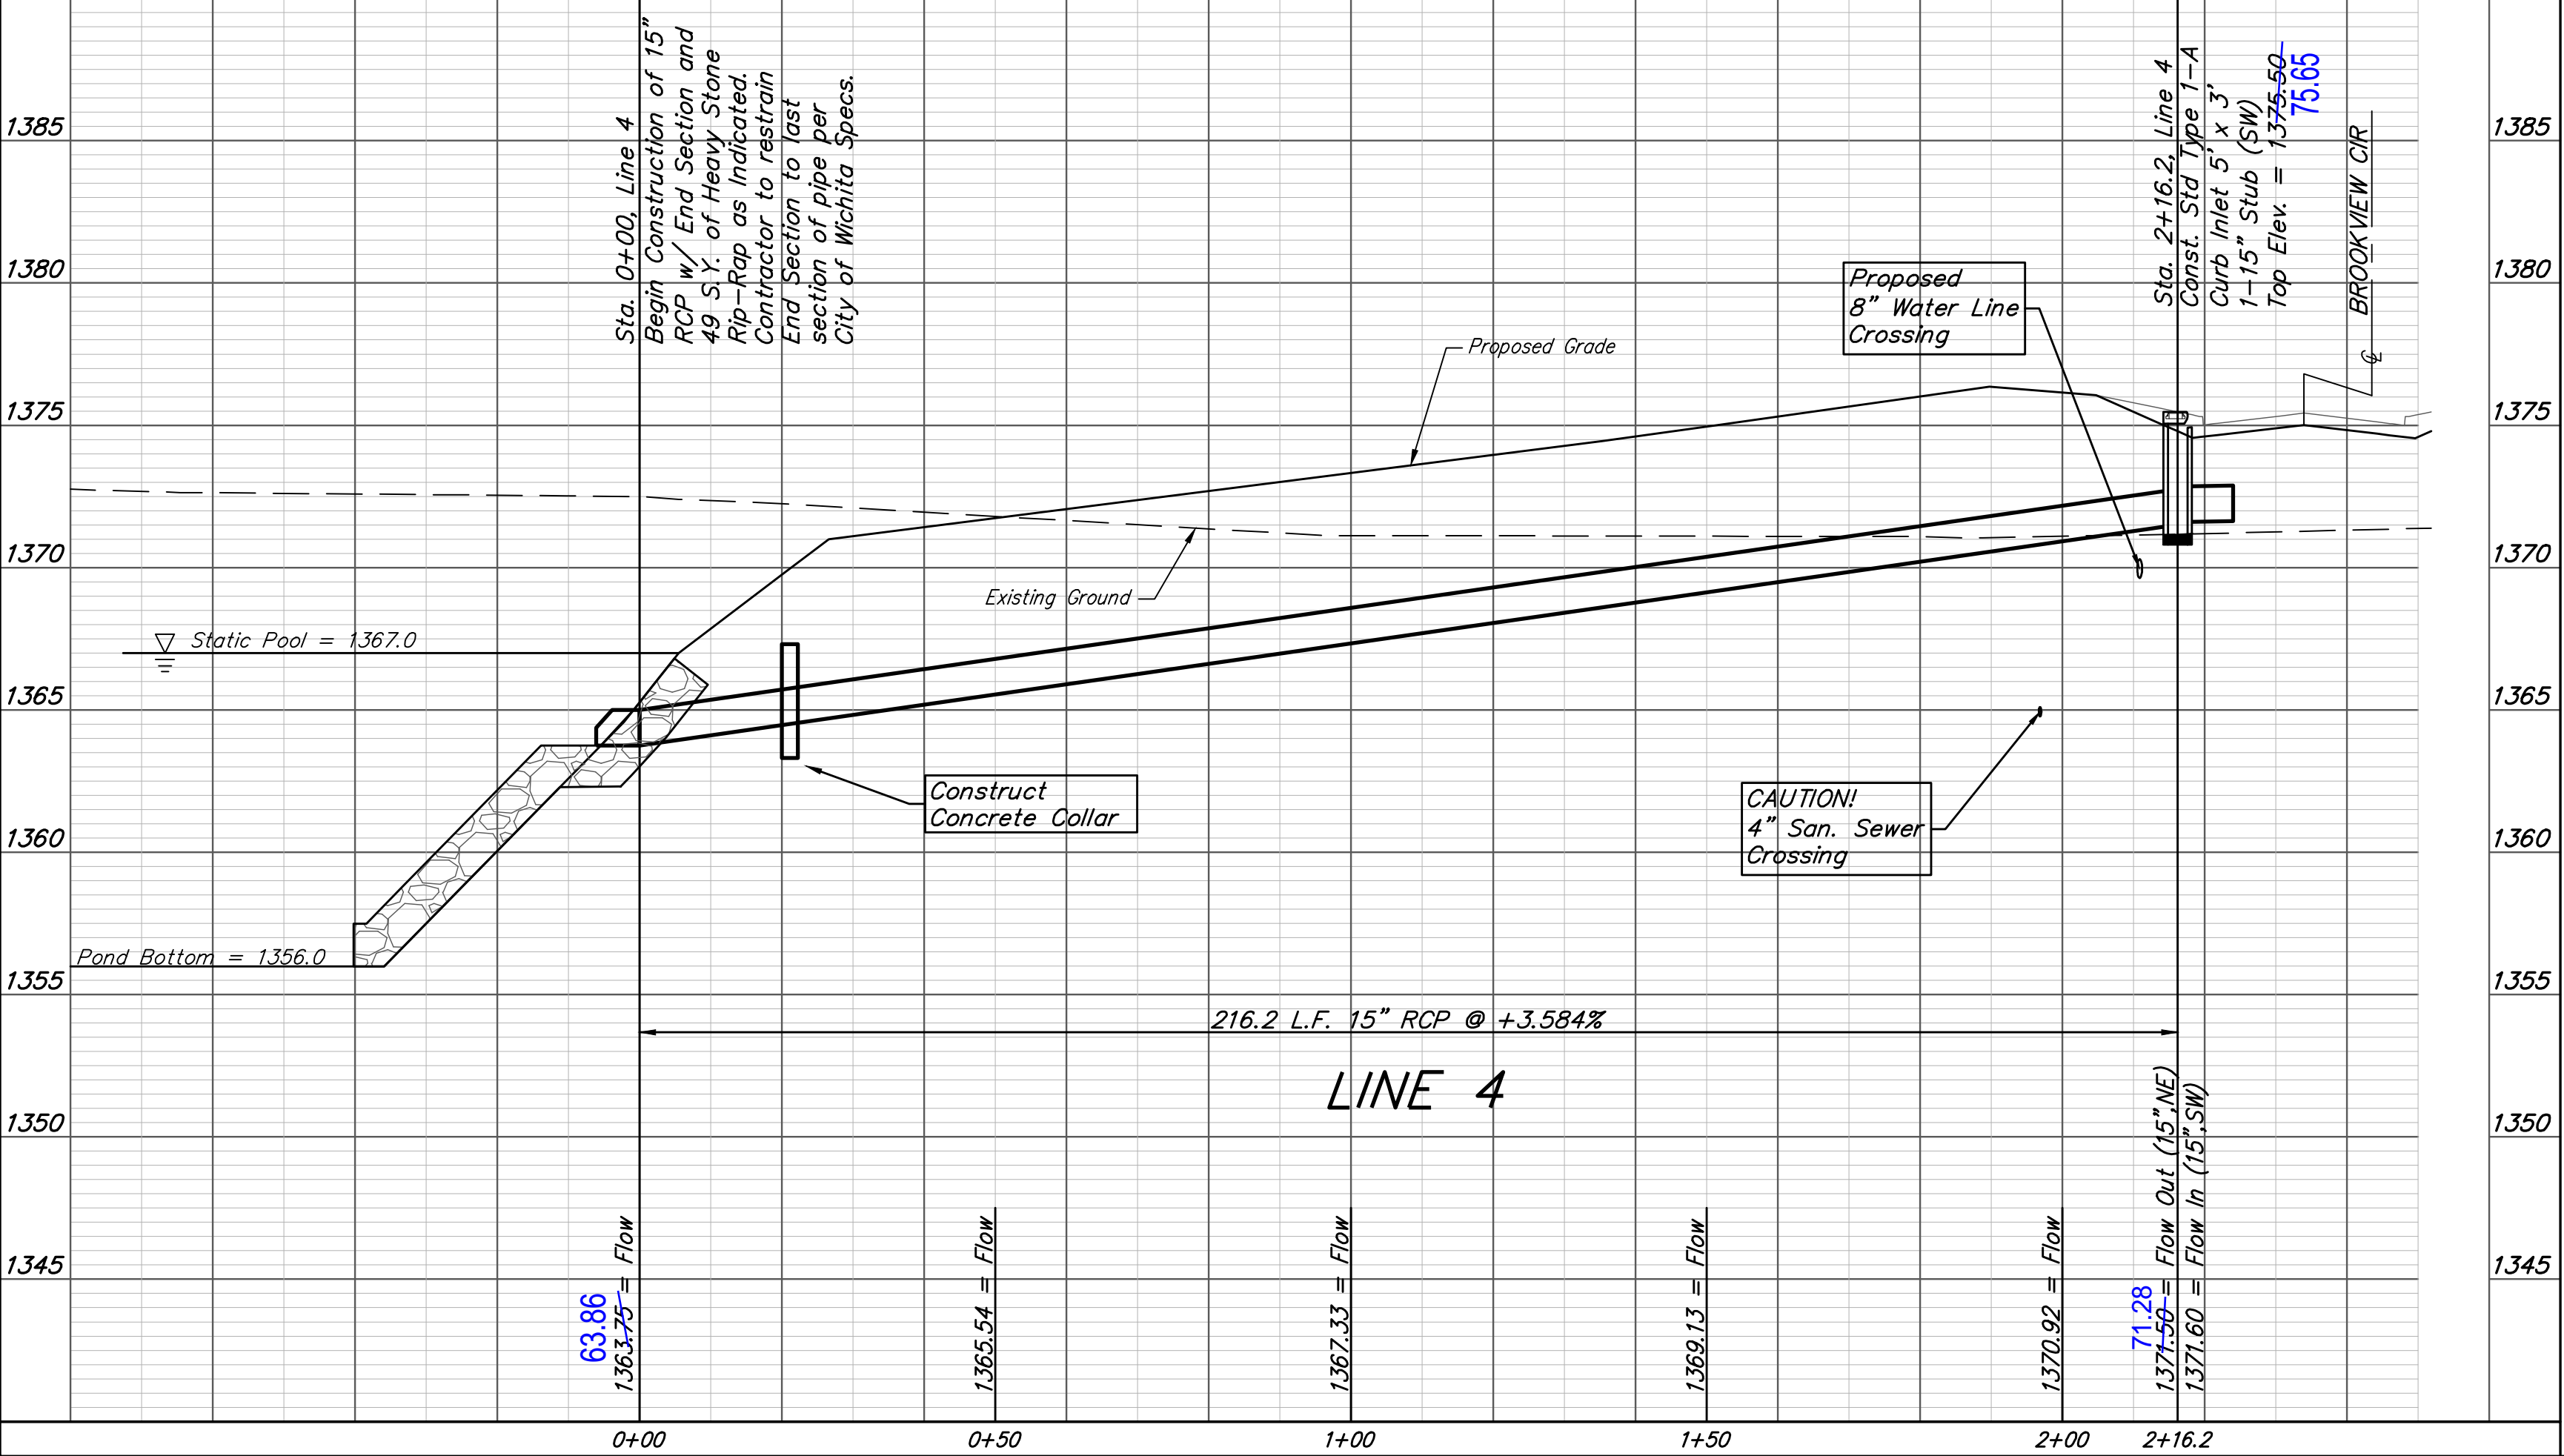
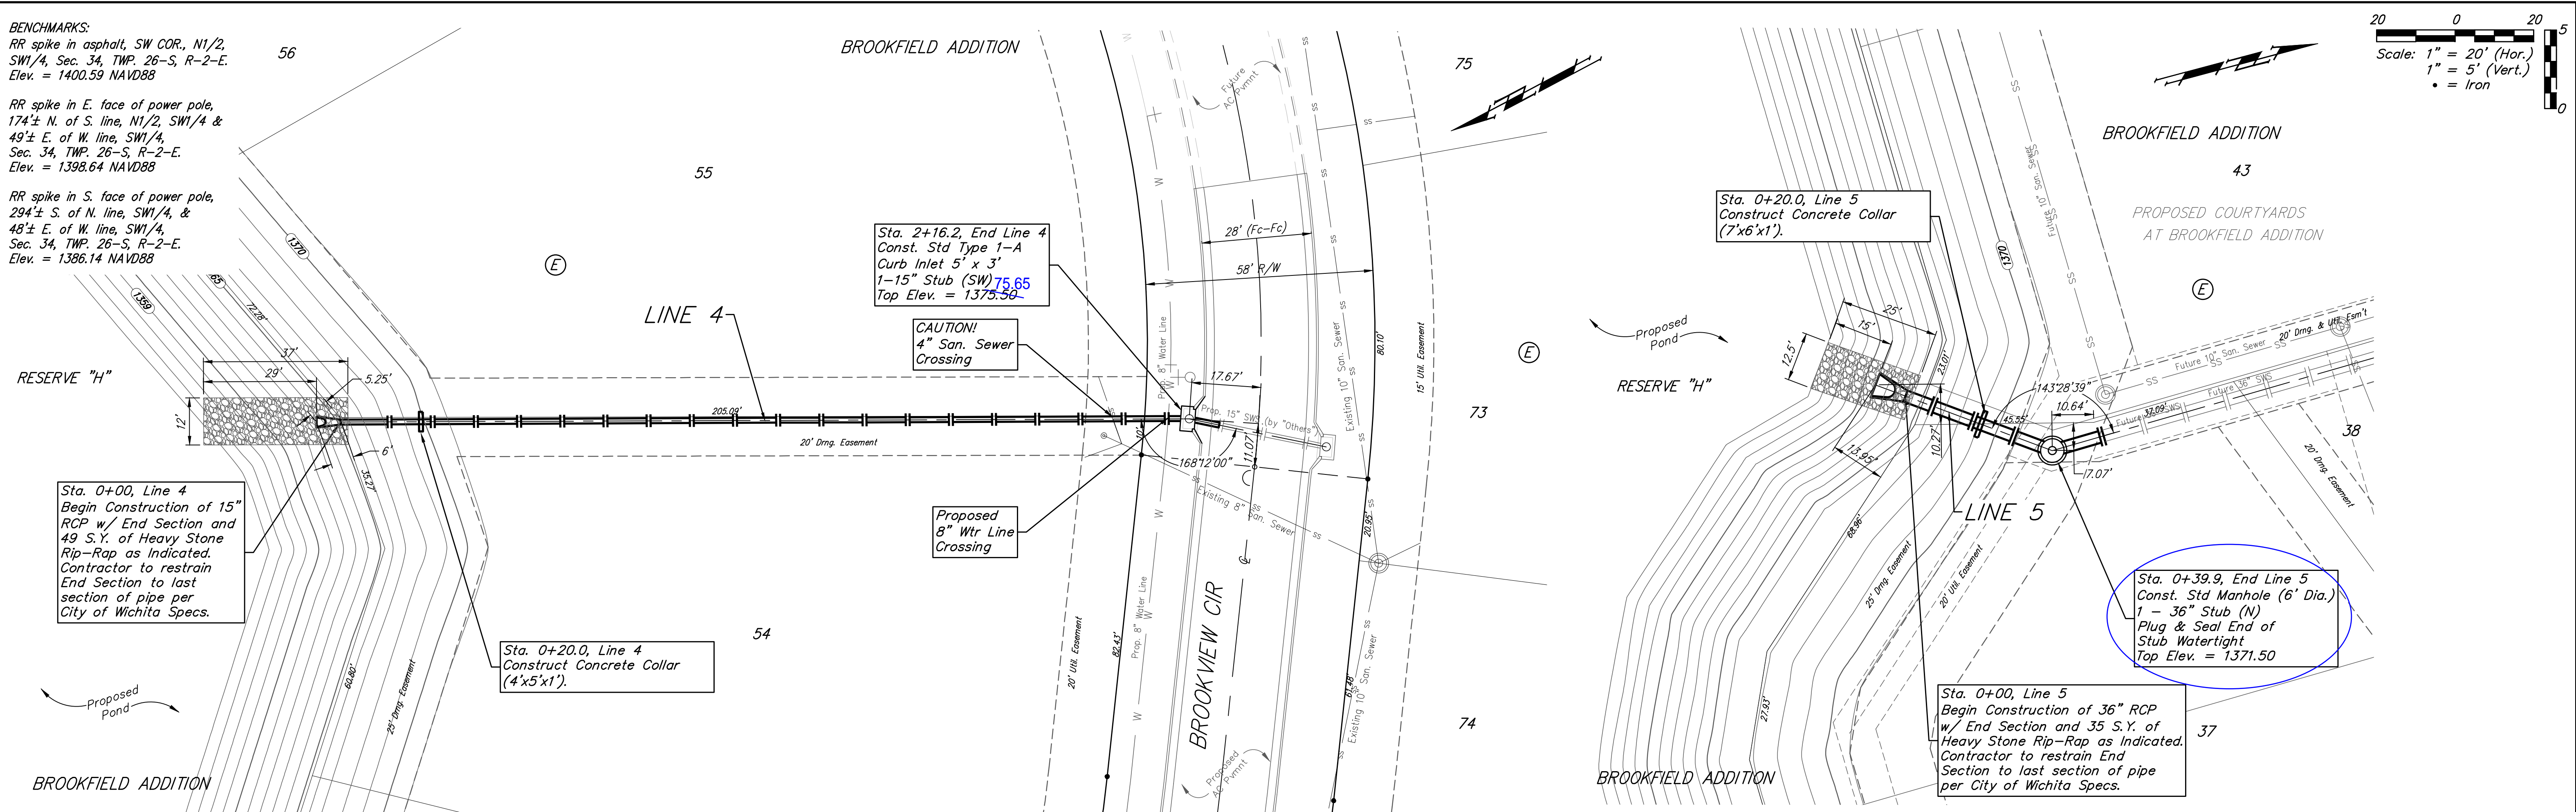
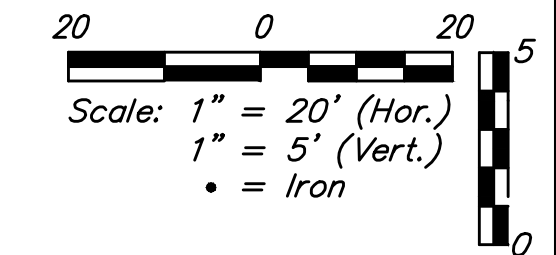


Sta 0+39.9 - Add 2'-2" barrel section to manhole to account for revised flow lines for 6' diameter manhole.

		Brookfield Addition - Phase I LINE 4 & LINE 5 Storm Water Drain Improvements	
		<small>Baughman Company, P.A. 315 Ellis St. Wichita, KS 67211 P 316-262-7271 F 316-262-0149 ENGINEERING SURVEYING PLANNING LANDSCAPE ARCHITECTURE</small>	
PROJECT NUMBER 468-85177	DESIGN AEG	DRAWN JAK	DATE 6/30/17
REVISIONS: 7/18/17 JAK Sta. 2+16.2, Line 4 Inlet Flowline 7/18/17 JAK Line 5 10/4/17 A.G.	APPROVED 	SCALE Noted	SHEET 5R OF 26

I:\Projects\Brookfield Addition_1604P190\Engineering\Phase I\SWD_1608E543\SWD PLANS.dwg

BENCHMARKS:
 RR spike in asphalt, SW COR., N1/2, SW1/4, Sec. 34, TWP. 26-S, R-2-E. Elev. = 1400.59 NAVD88
 RR spike in E. face of power pole, 174± N. of S. line, N1/2, SW1/4 & 49± E. of W. line, SW1/4, Sec. 34, TWP. 26-S, R-2-E. Elev. = 1398.64 NAVD88
 RR spike in S. face of power pole, 294± S. of N. line, SW1/4, & 48± E. of W. line, SW1/4, Sec. 34, TWP. 26-S, R-2-E. Elev. = 1386.14 NAVD88

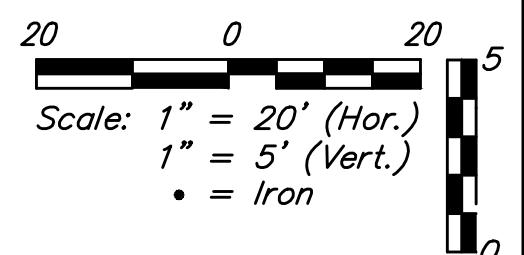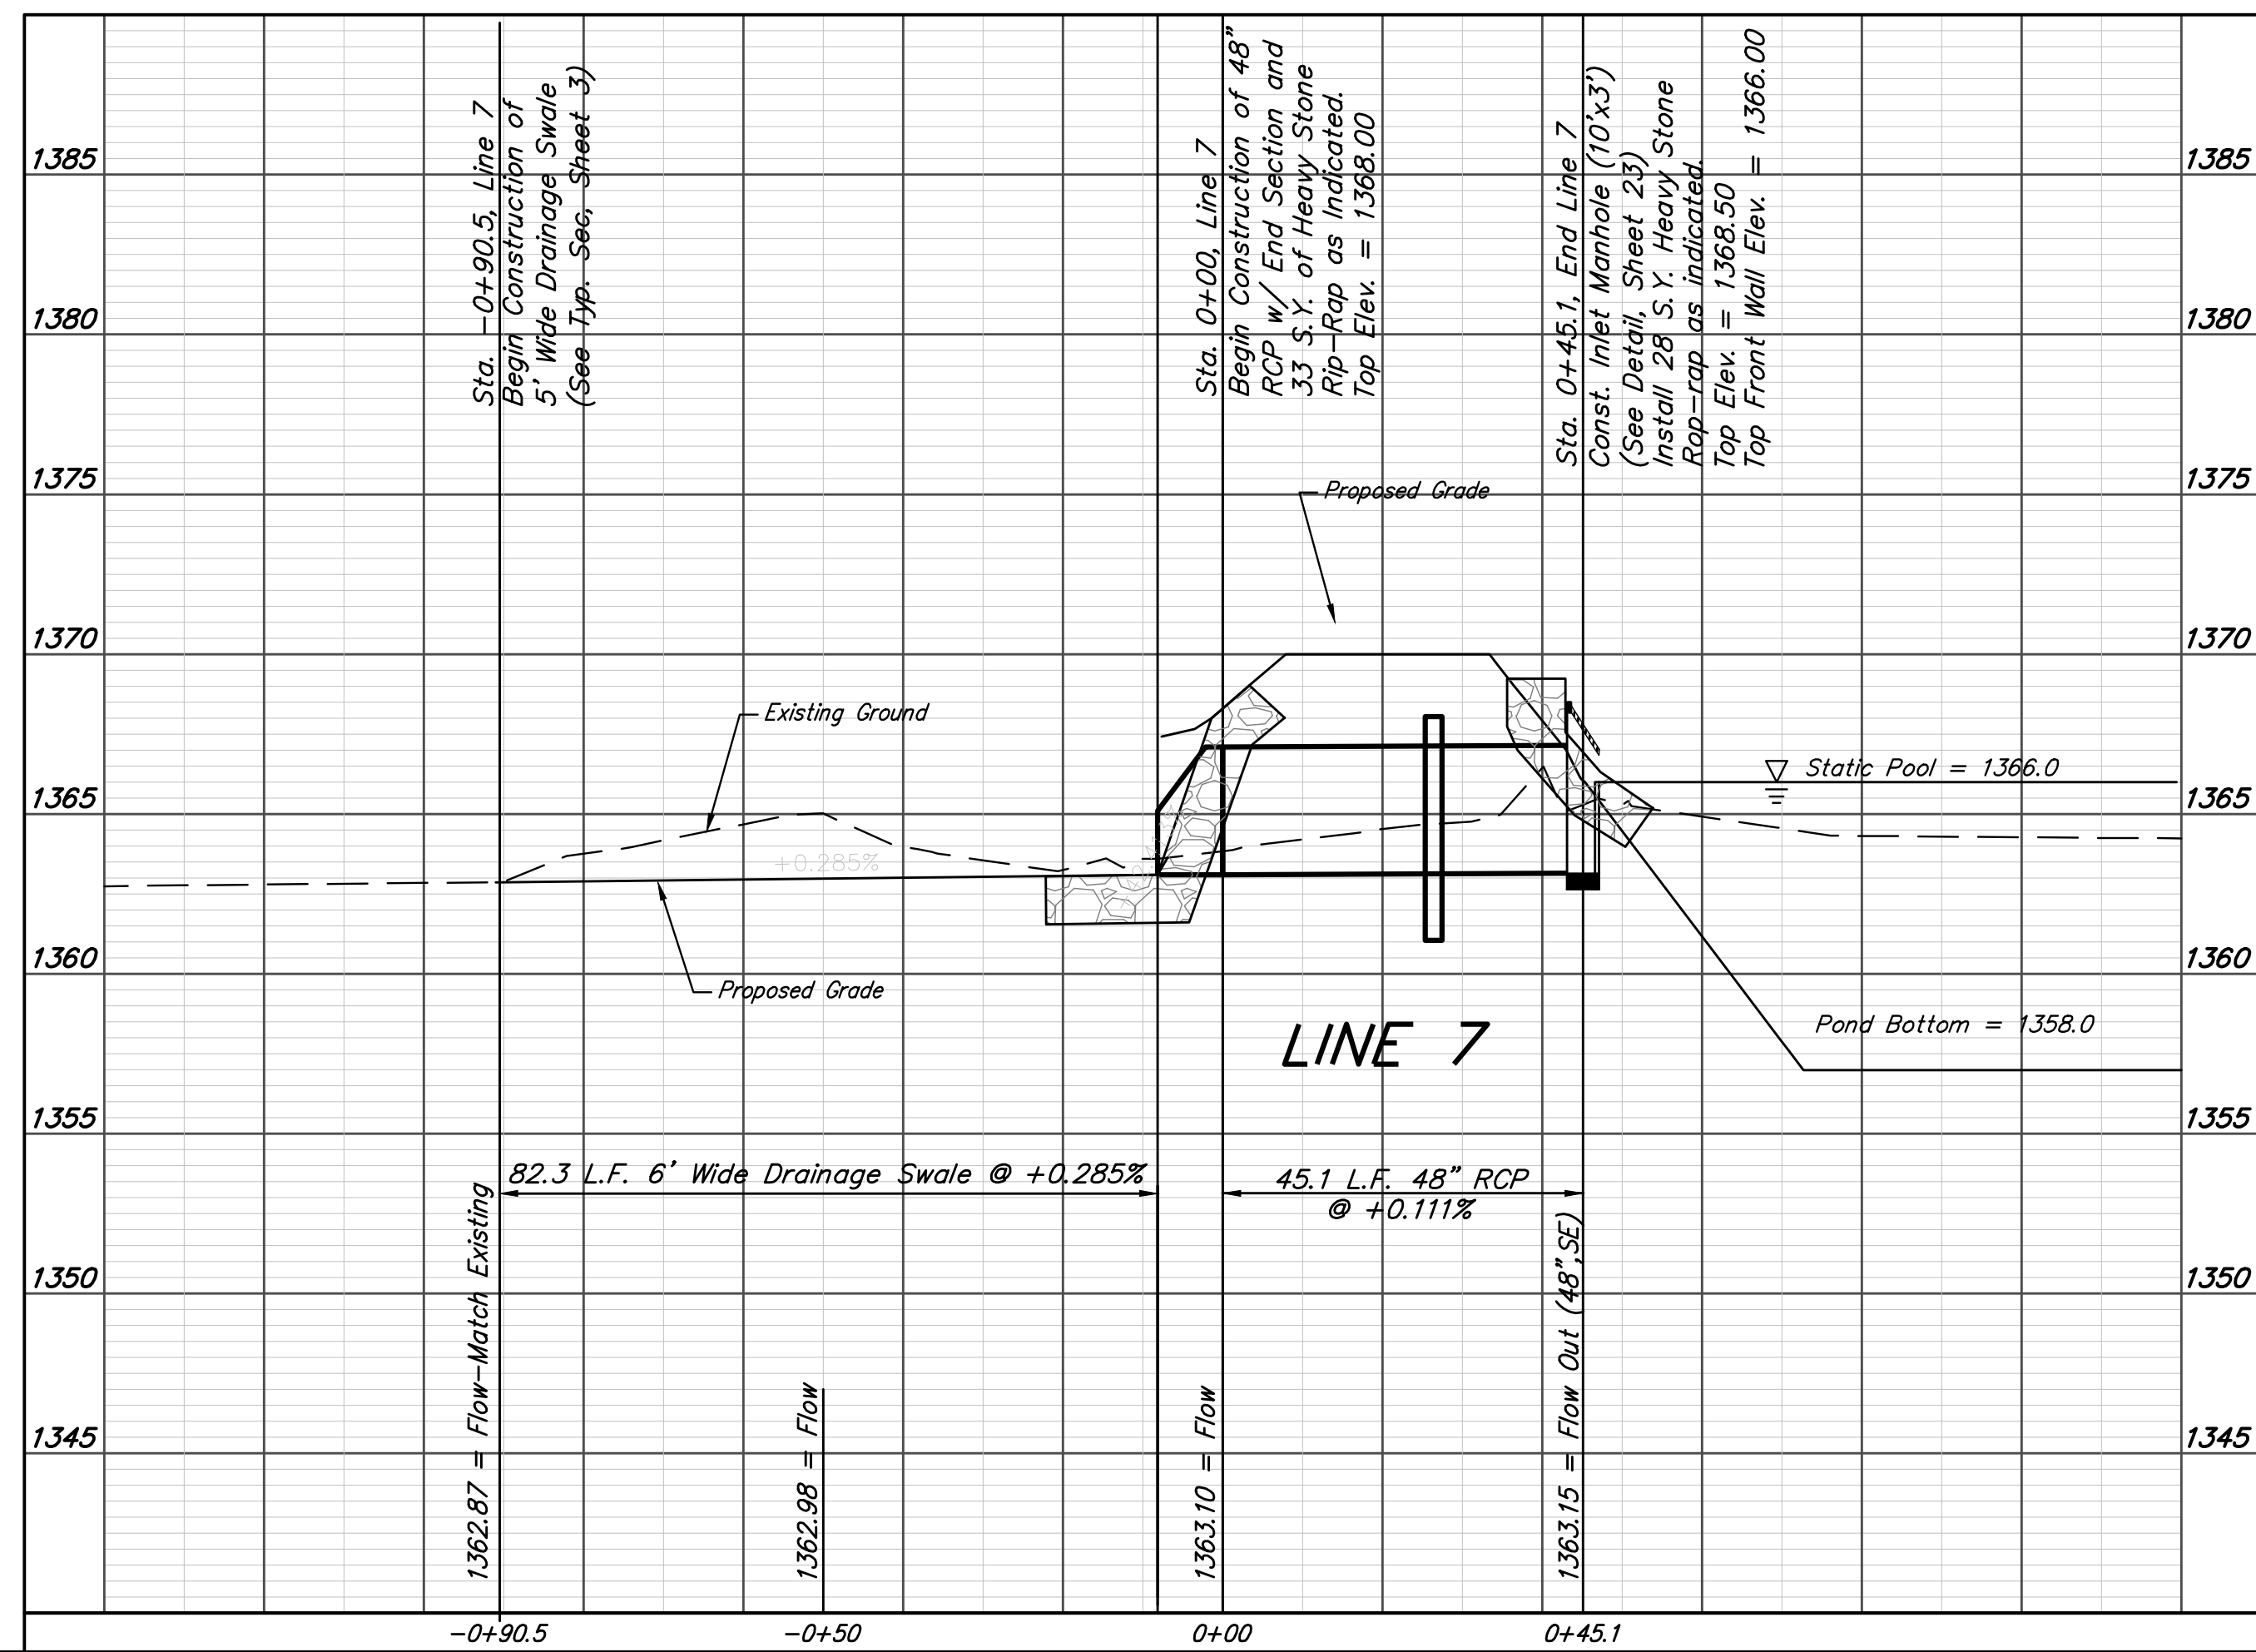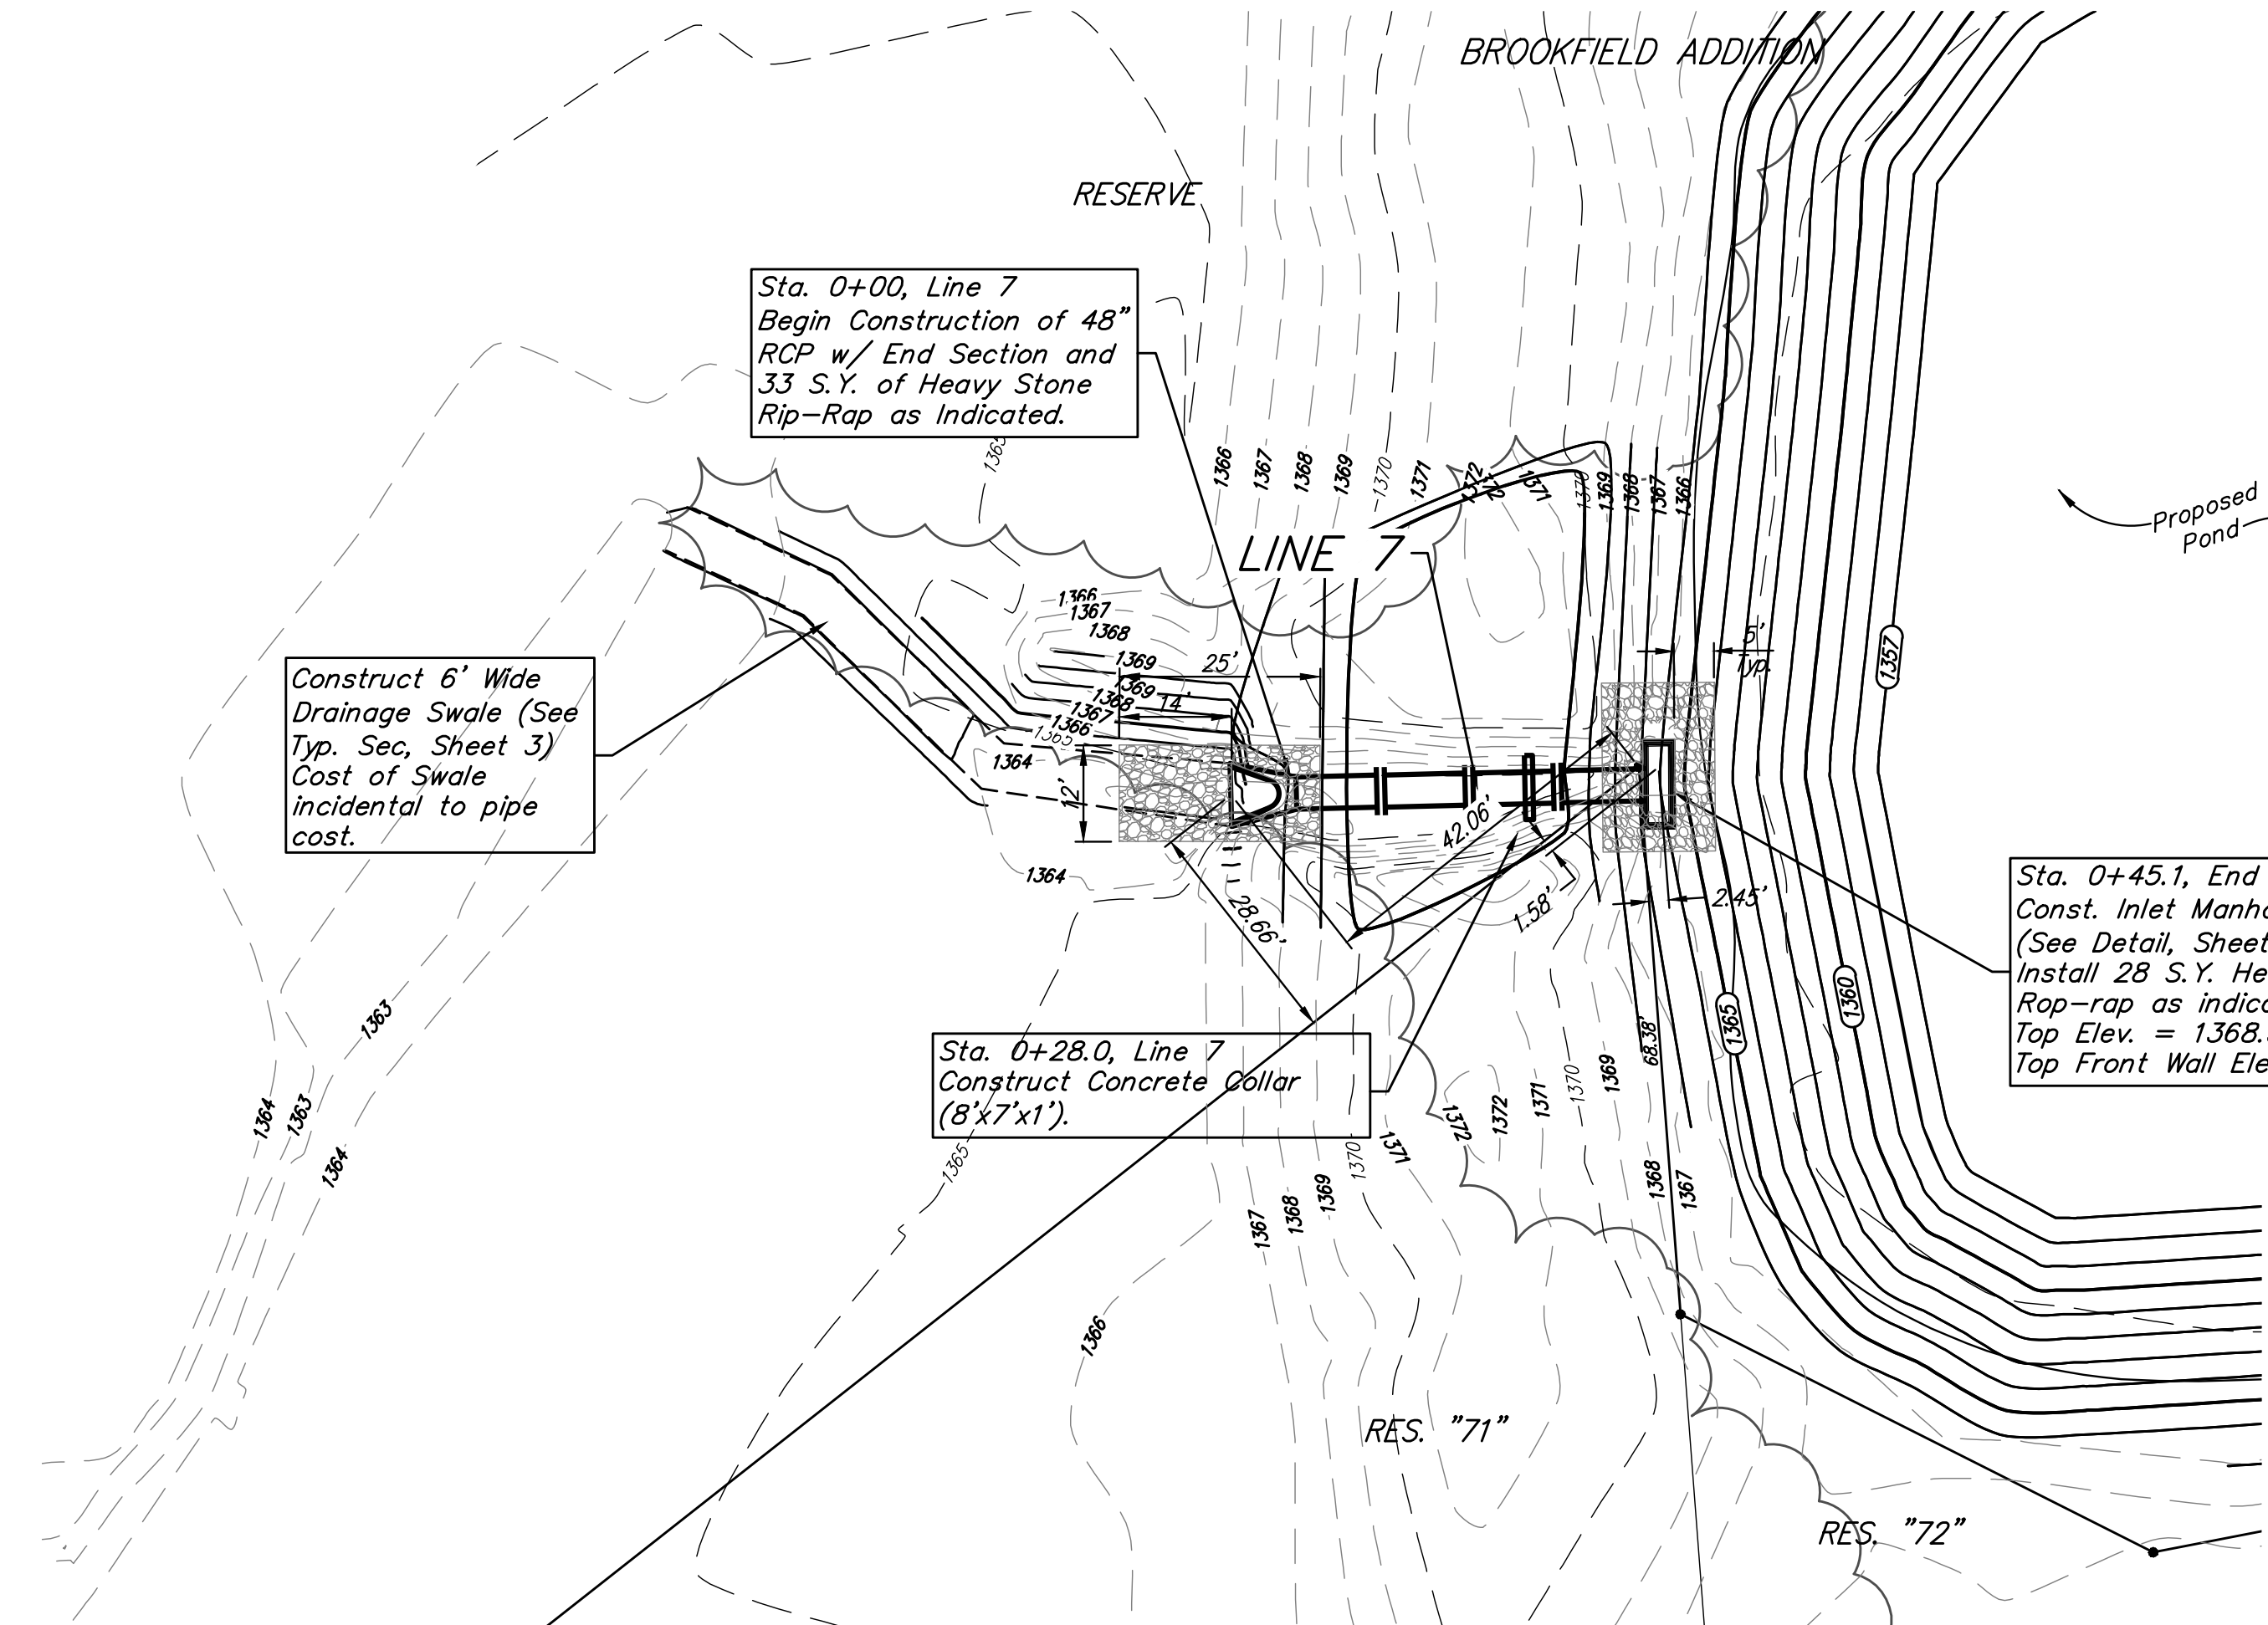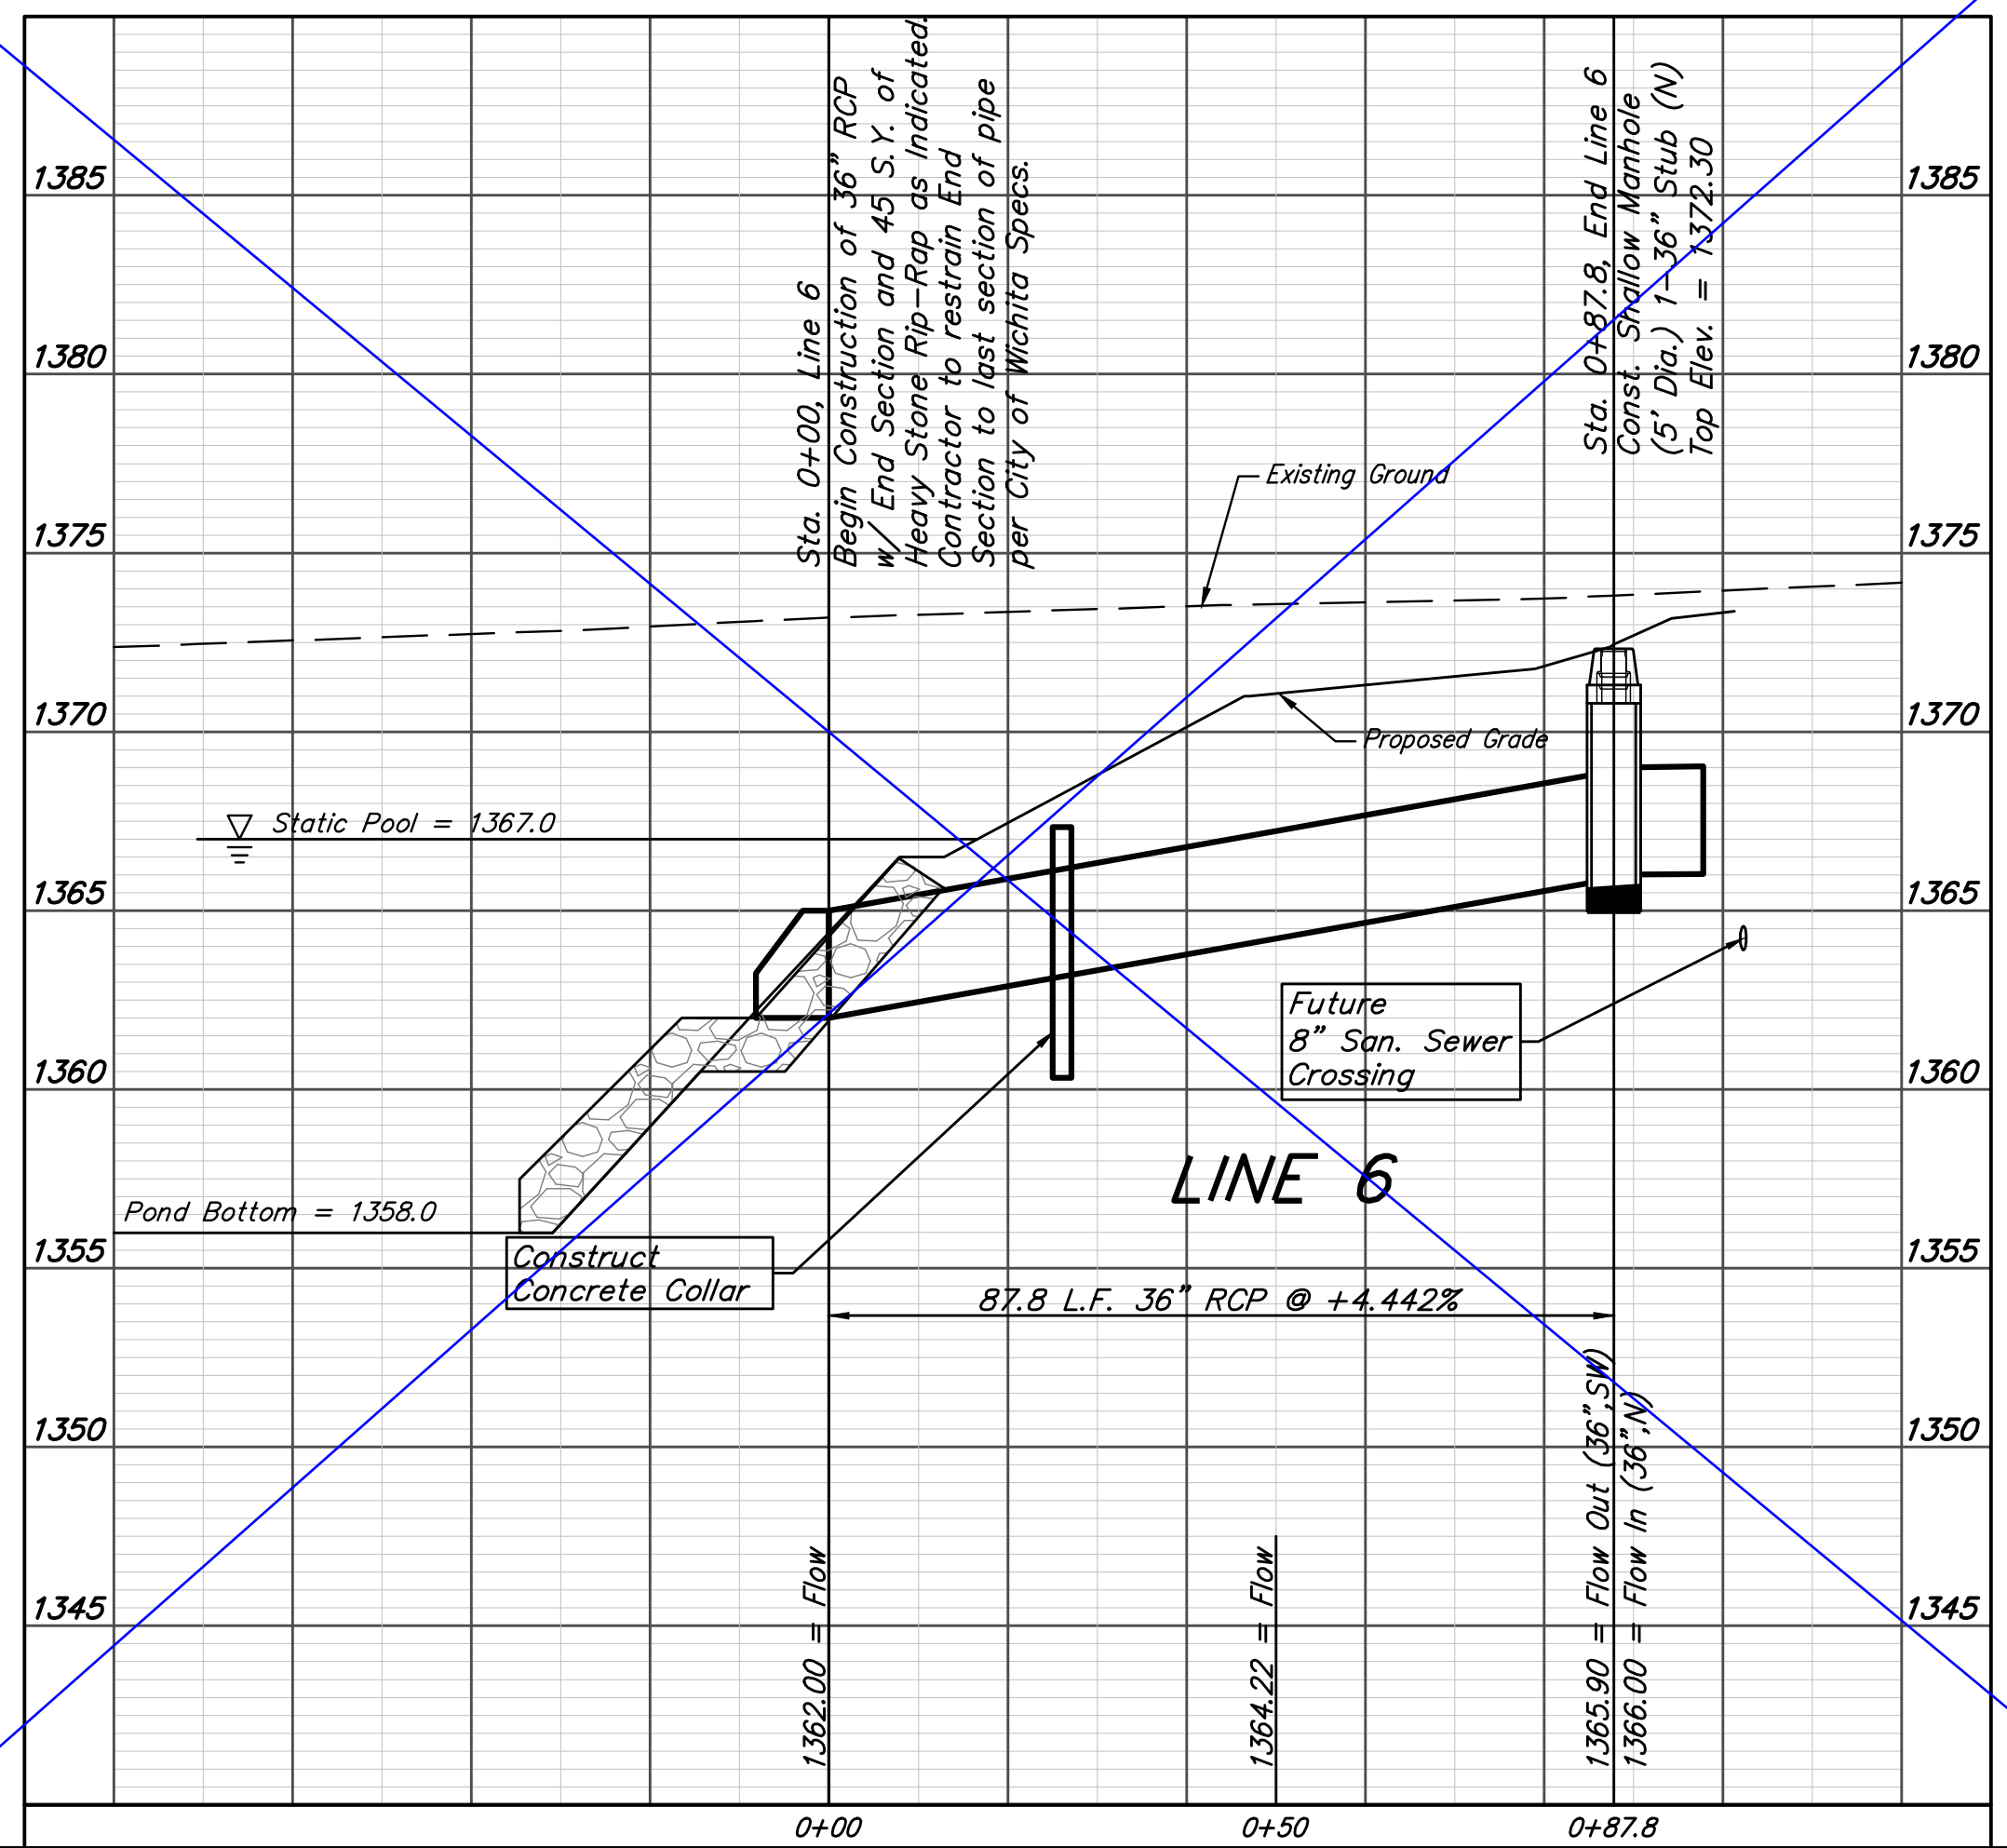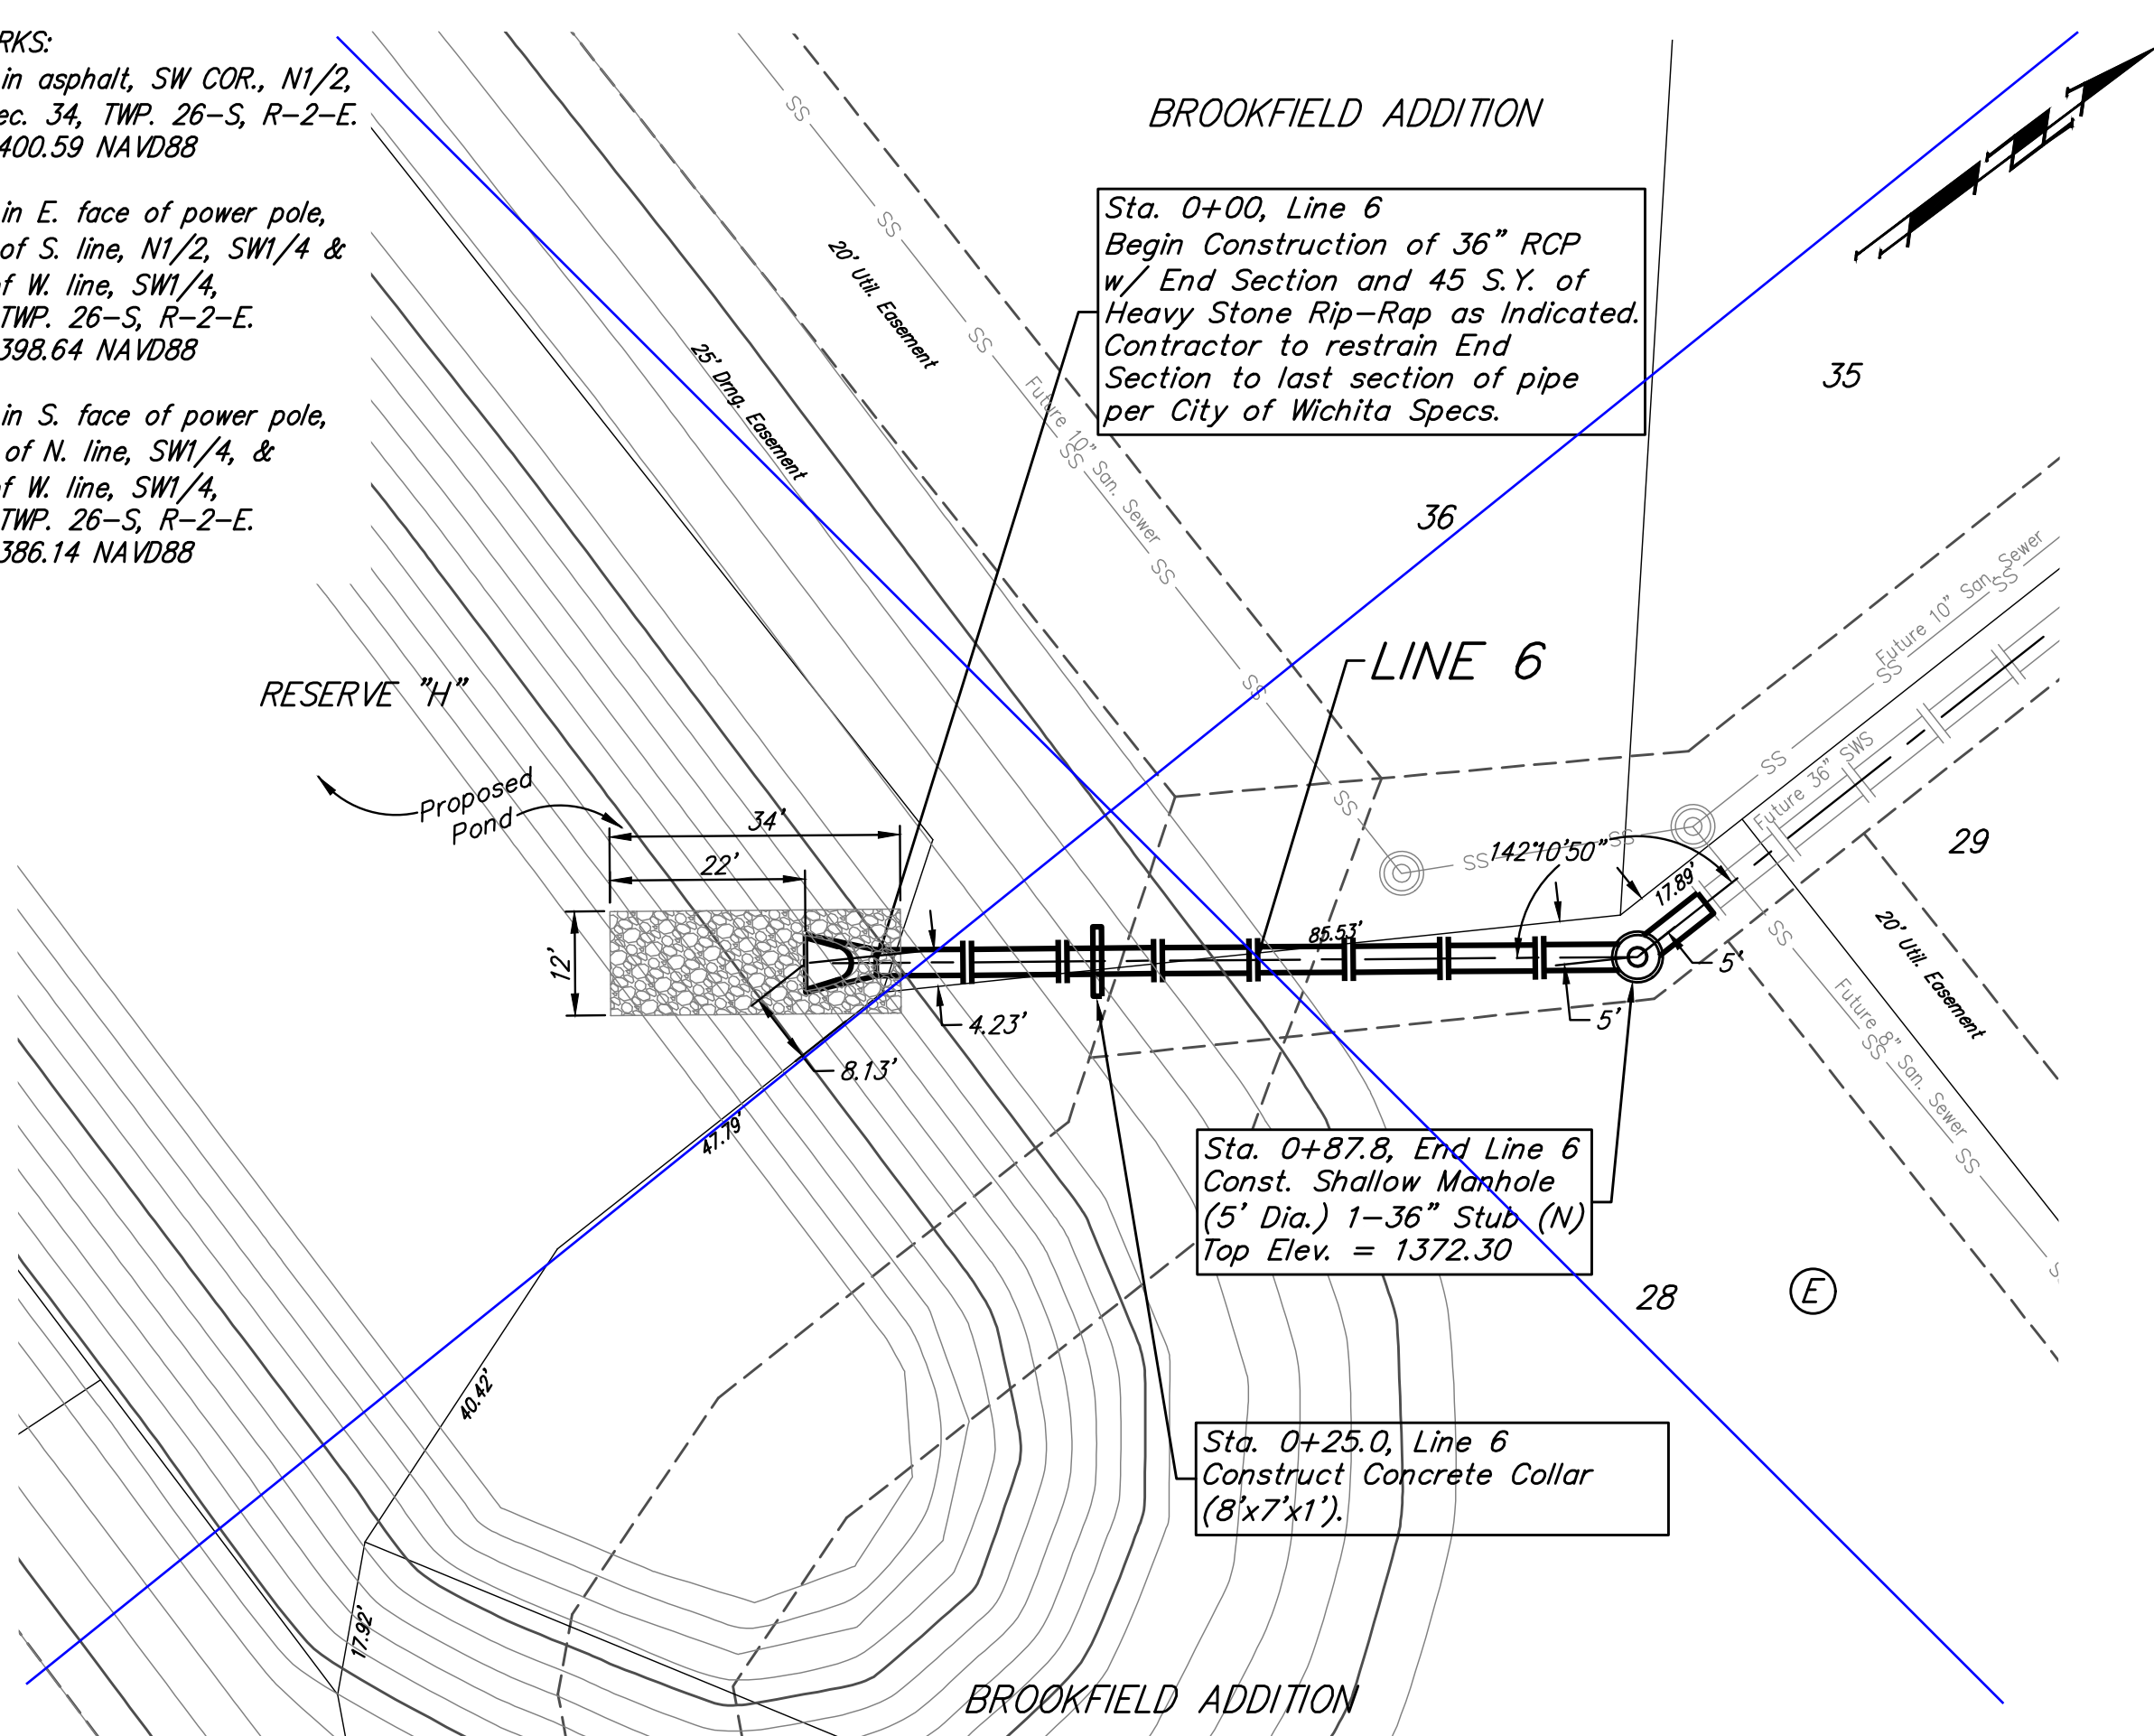






VOID - SEE SHEET 6R

		Brookfield Addition - Phase I LINE 6 & LINE 7 Storm Water Drain Improvements	
		<small>Baughman Company, P.A. 315 Ellis St. Wichita, KS 67211 P 316-262-7271 F 316-262-0149 ENGINEERING SURVEYING PLANNING LANDSCAPE ARCHITECTURE</small>	
PROJECT NUMBER 468-85177	DESIGN AEG	DRAWN JAK	DATE 6/30/17
REVISIONS:	APPROVED	SCALE Noted SHEET	6 OF 26

BENCHMARKS:
 RR spike in asphalt, SW COR., N1/2, SW1/4, Sec. 34, TWP. 26-S, R-2-E. Elev. = 1400.59 NAVD88

RR spike in E. face of power pole, 174± N. of S. line, N1/2, SW1/4 & 49± E. of W. line, SW1/4, Sec. 34, TWP. 26-S, R-2-E. Elev. = 1398.64 NAVD88

RR spike in S. face of power pole, 294± S. of N. line, SW1/4, & 48± E. of W. line, SW1/4, Sec. 34, TWP. 26-S, R-2-E. Elev. = 1386.14 NAVD88

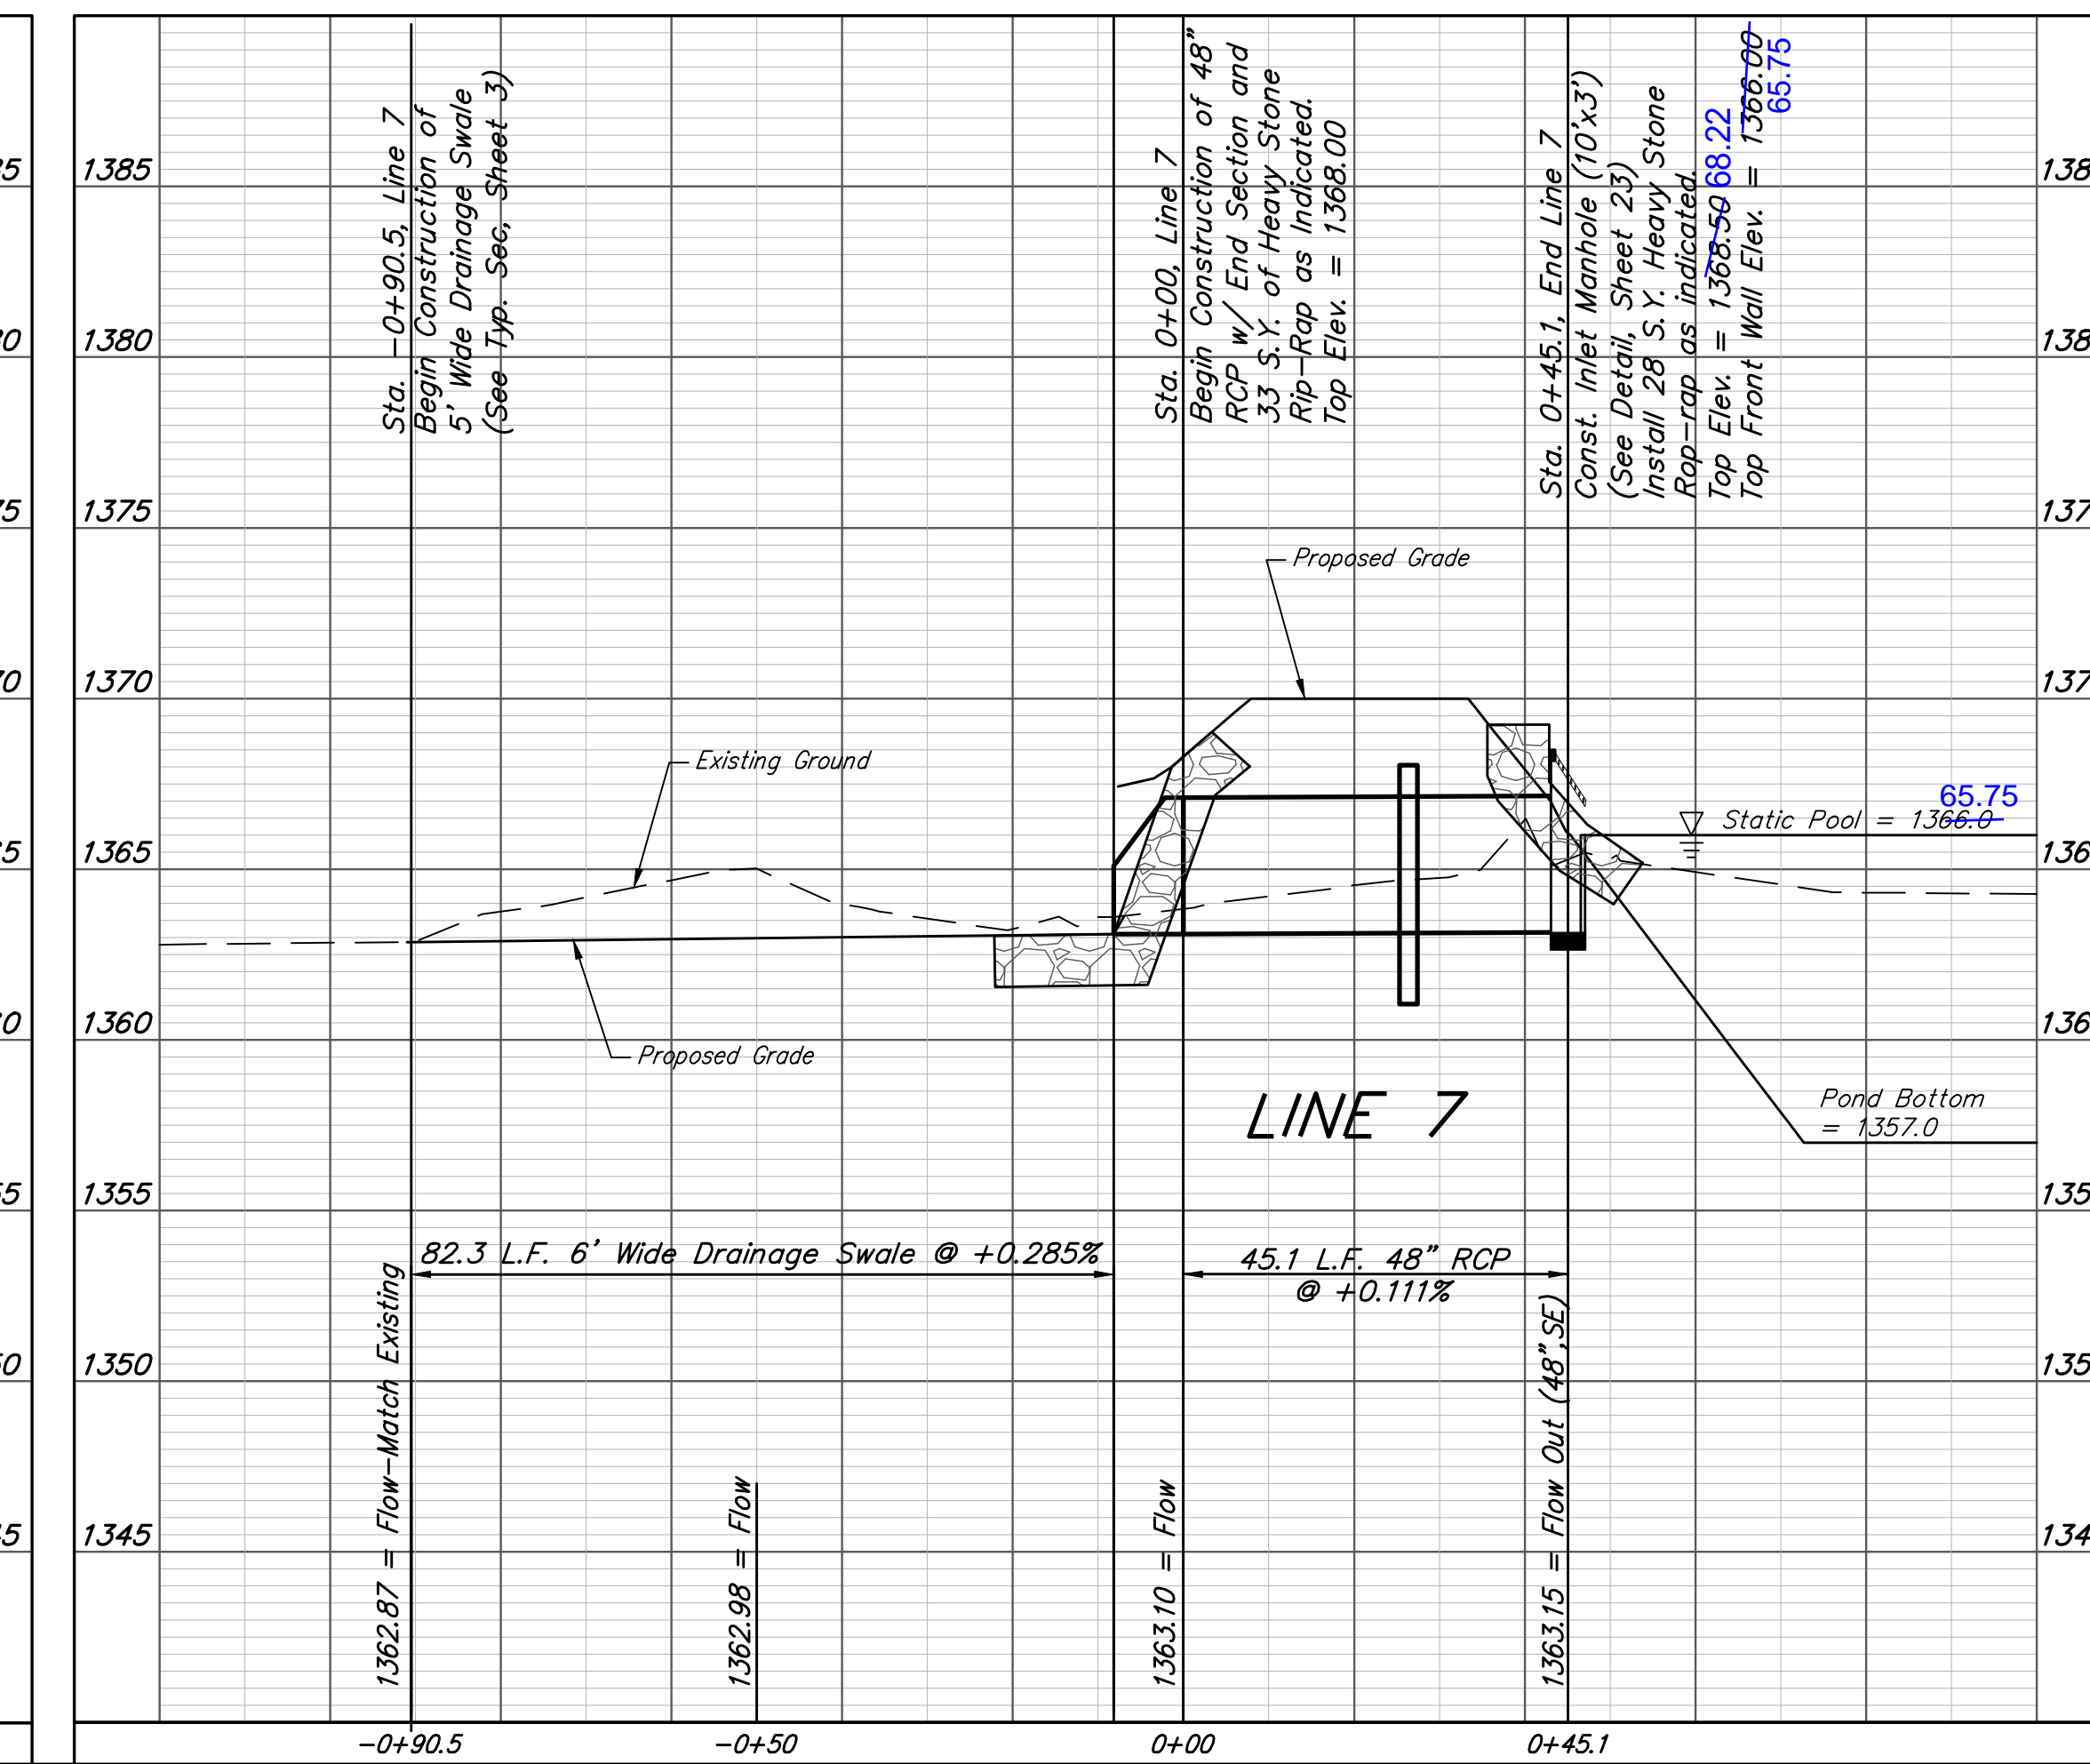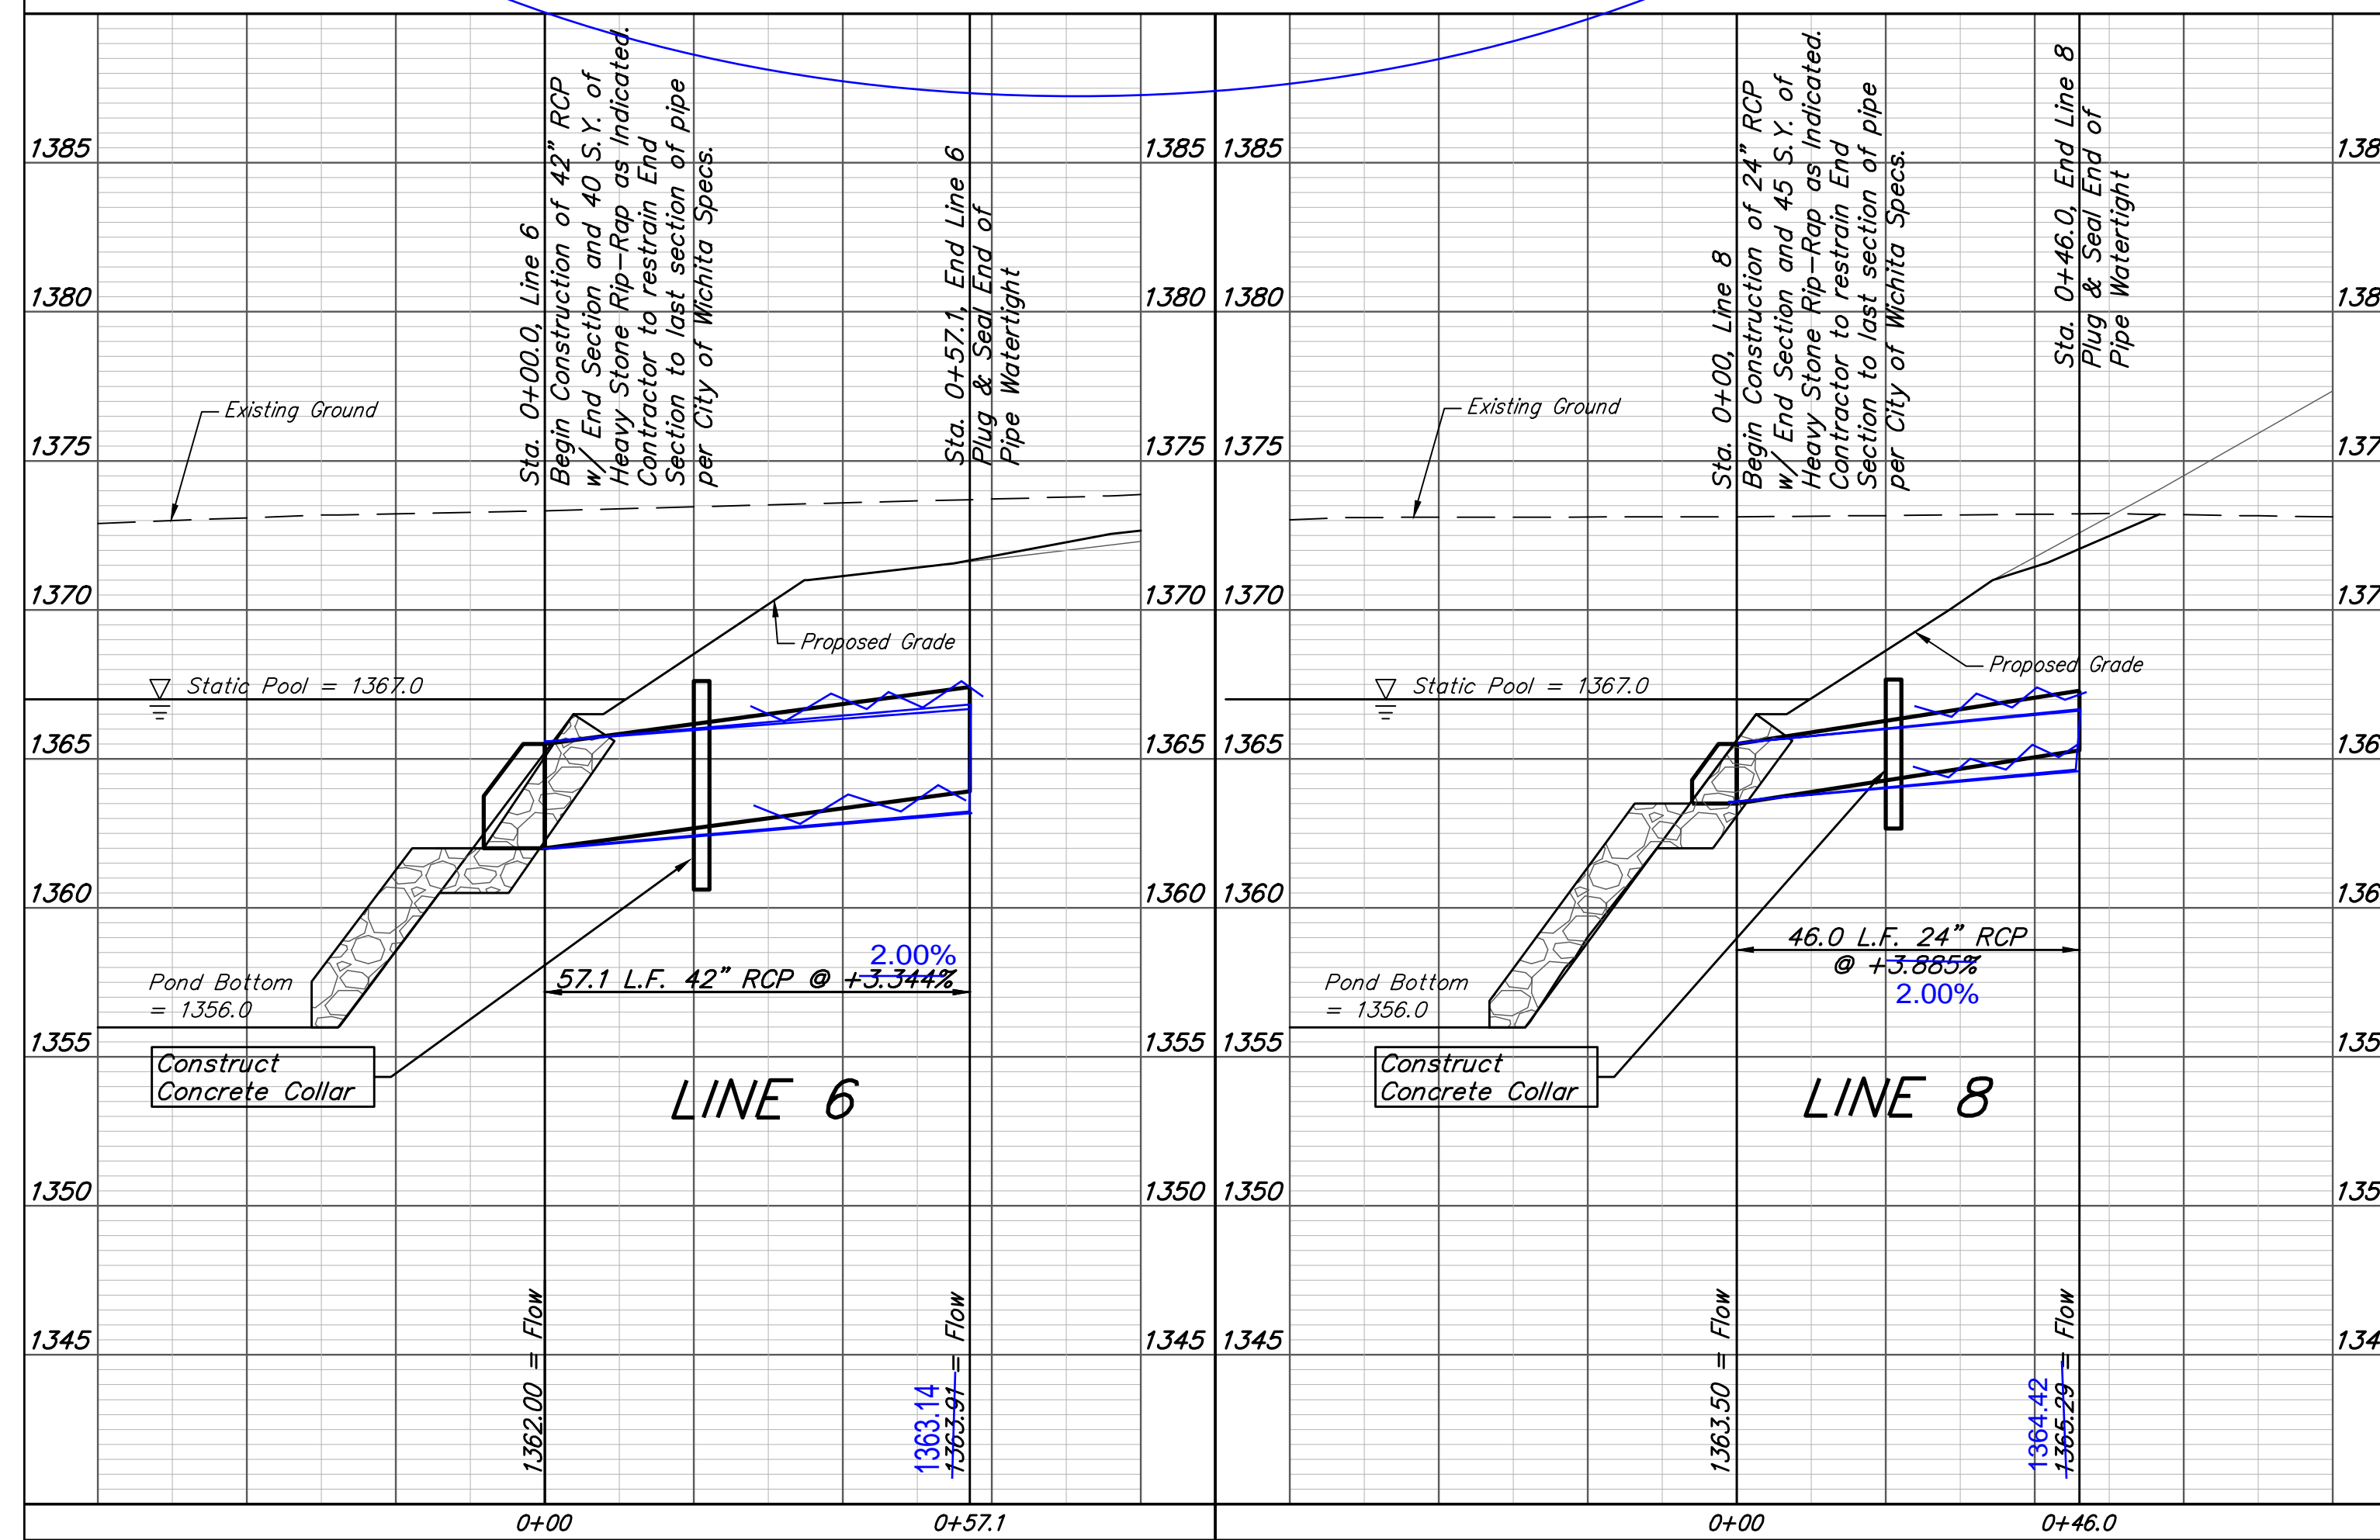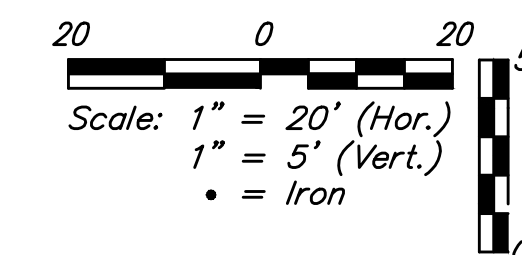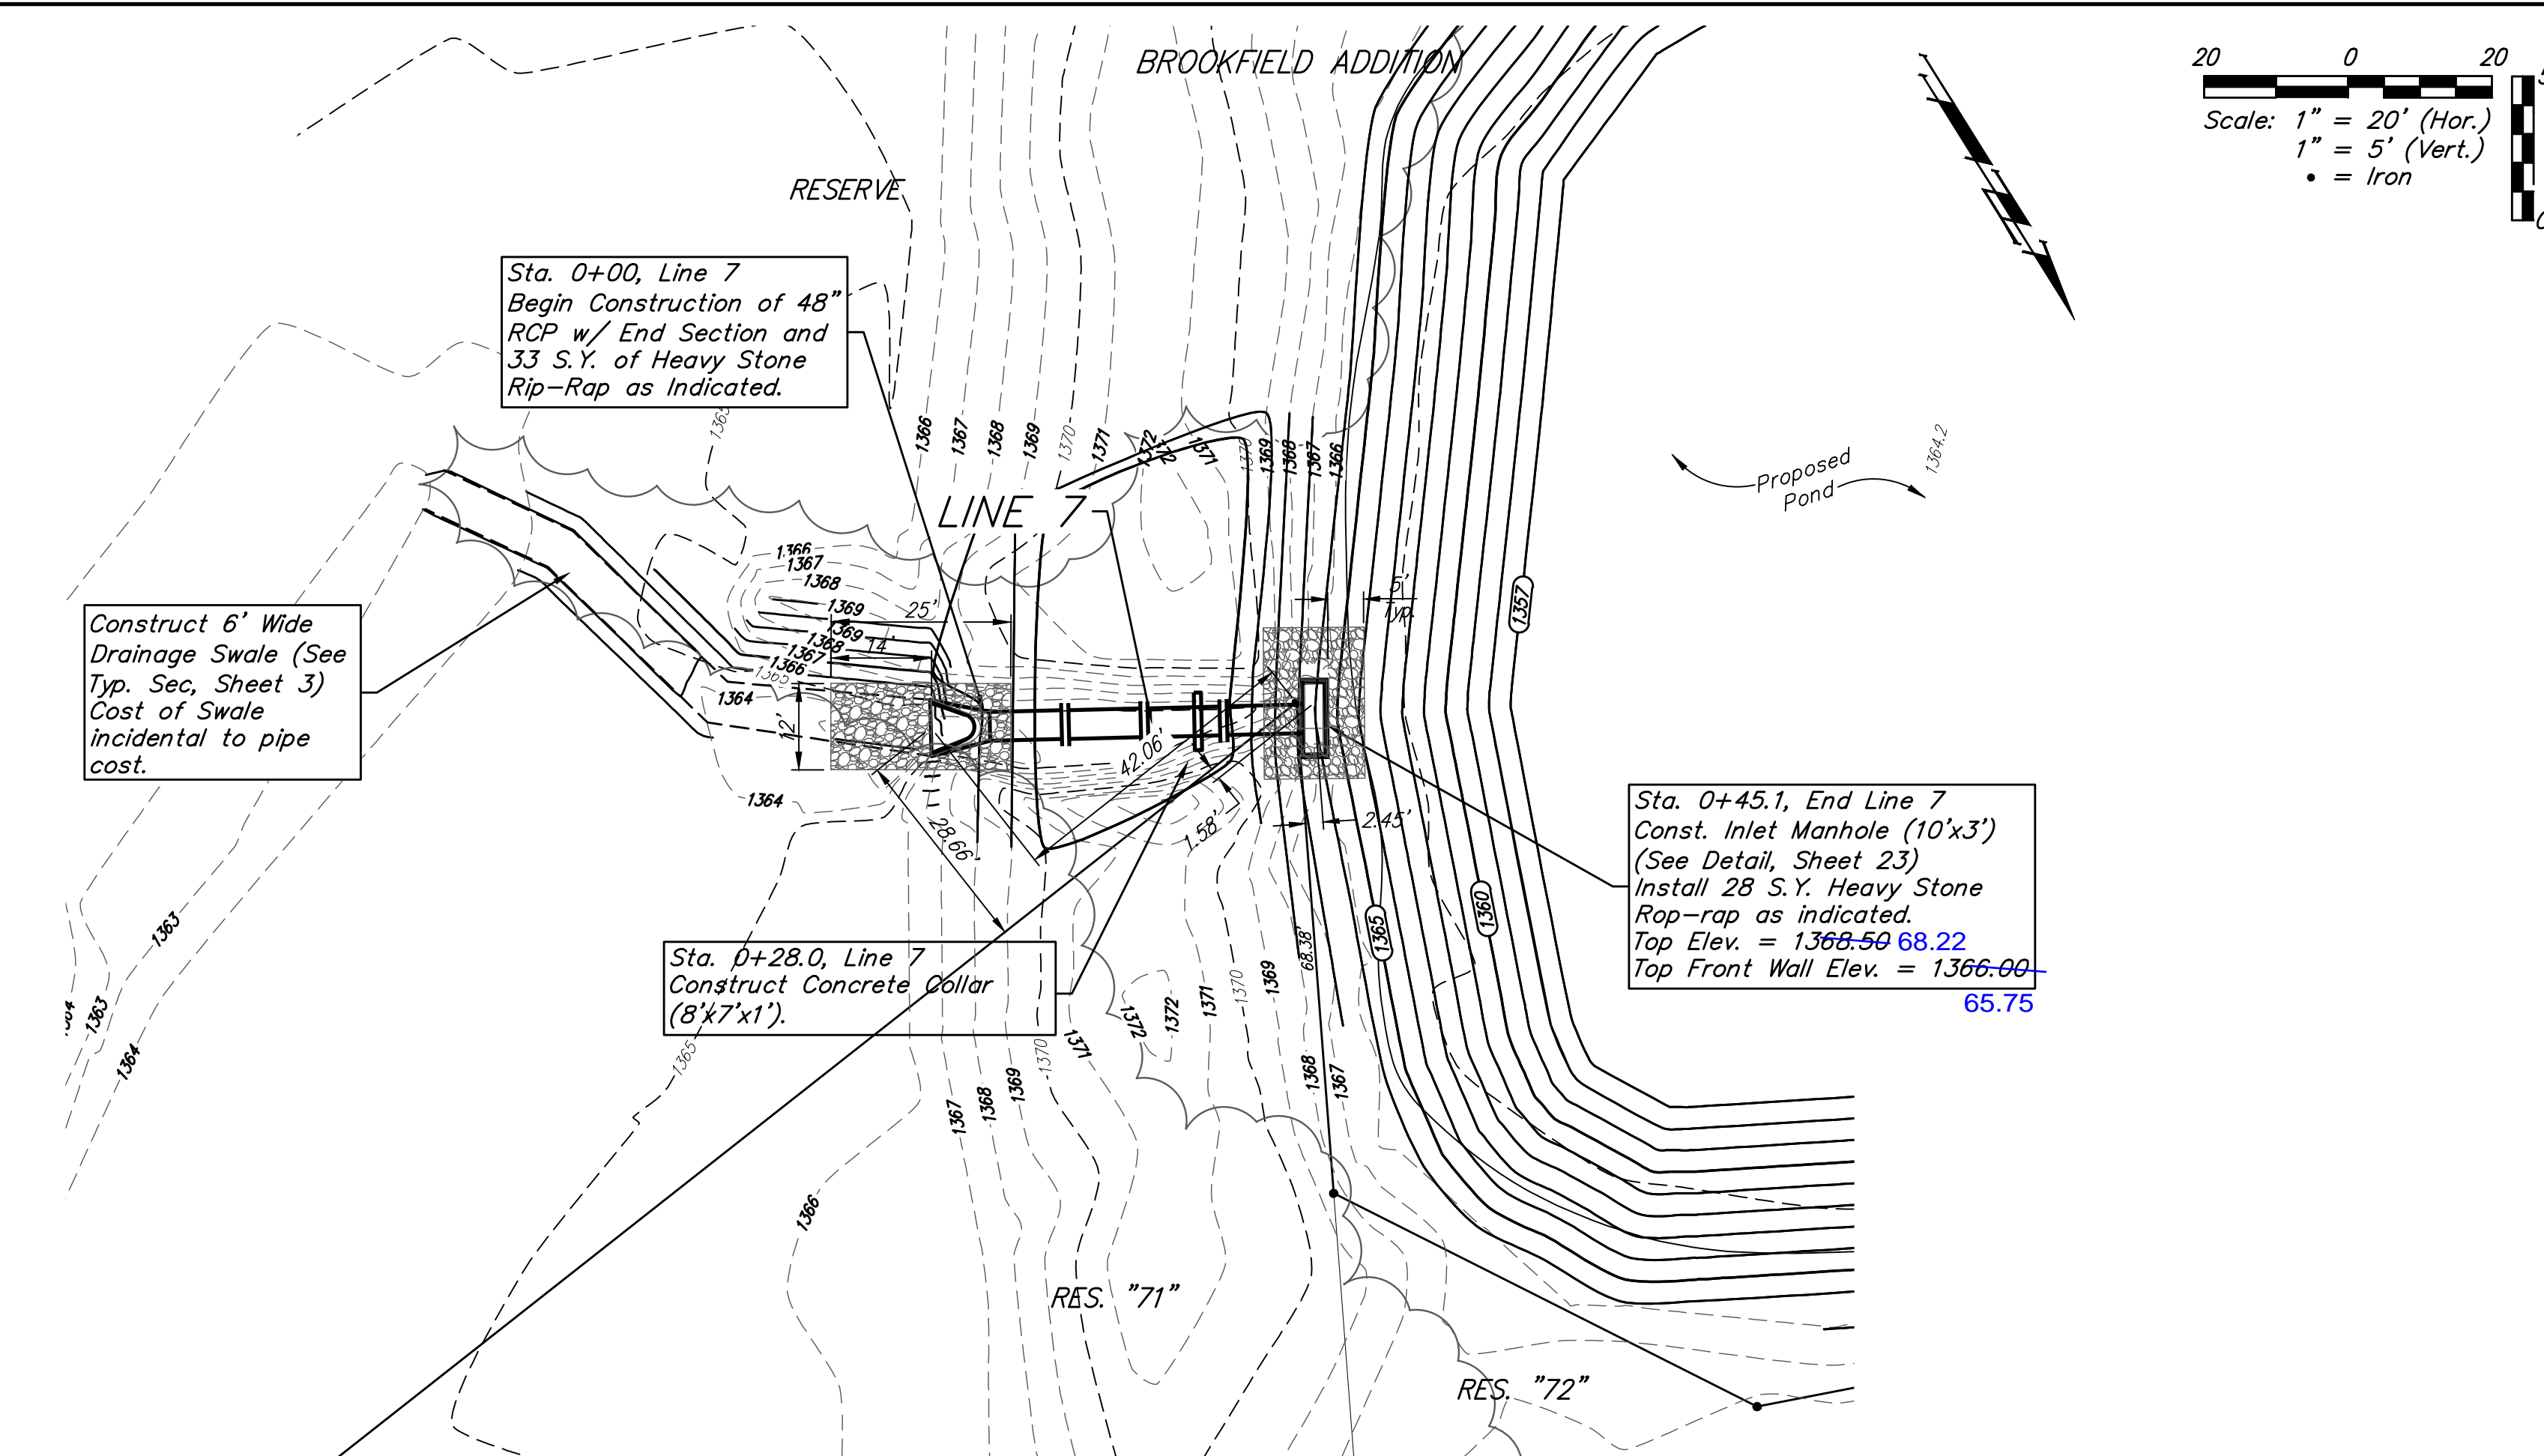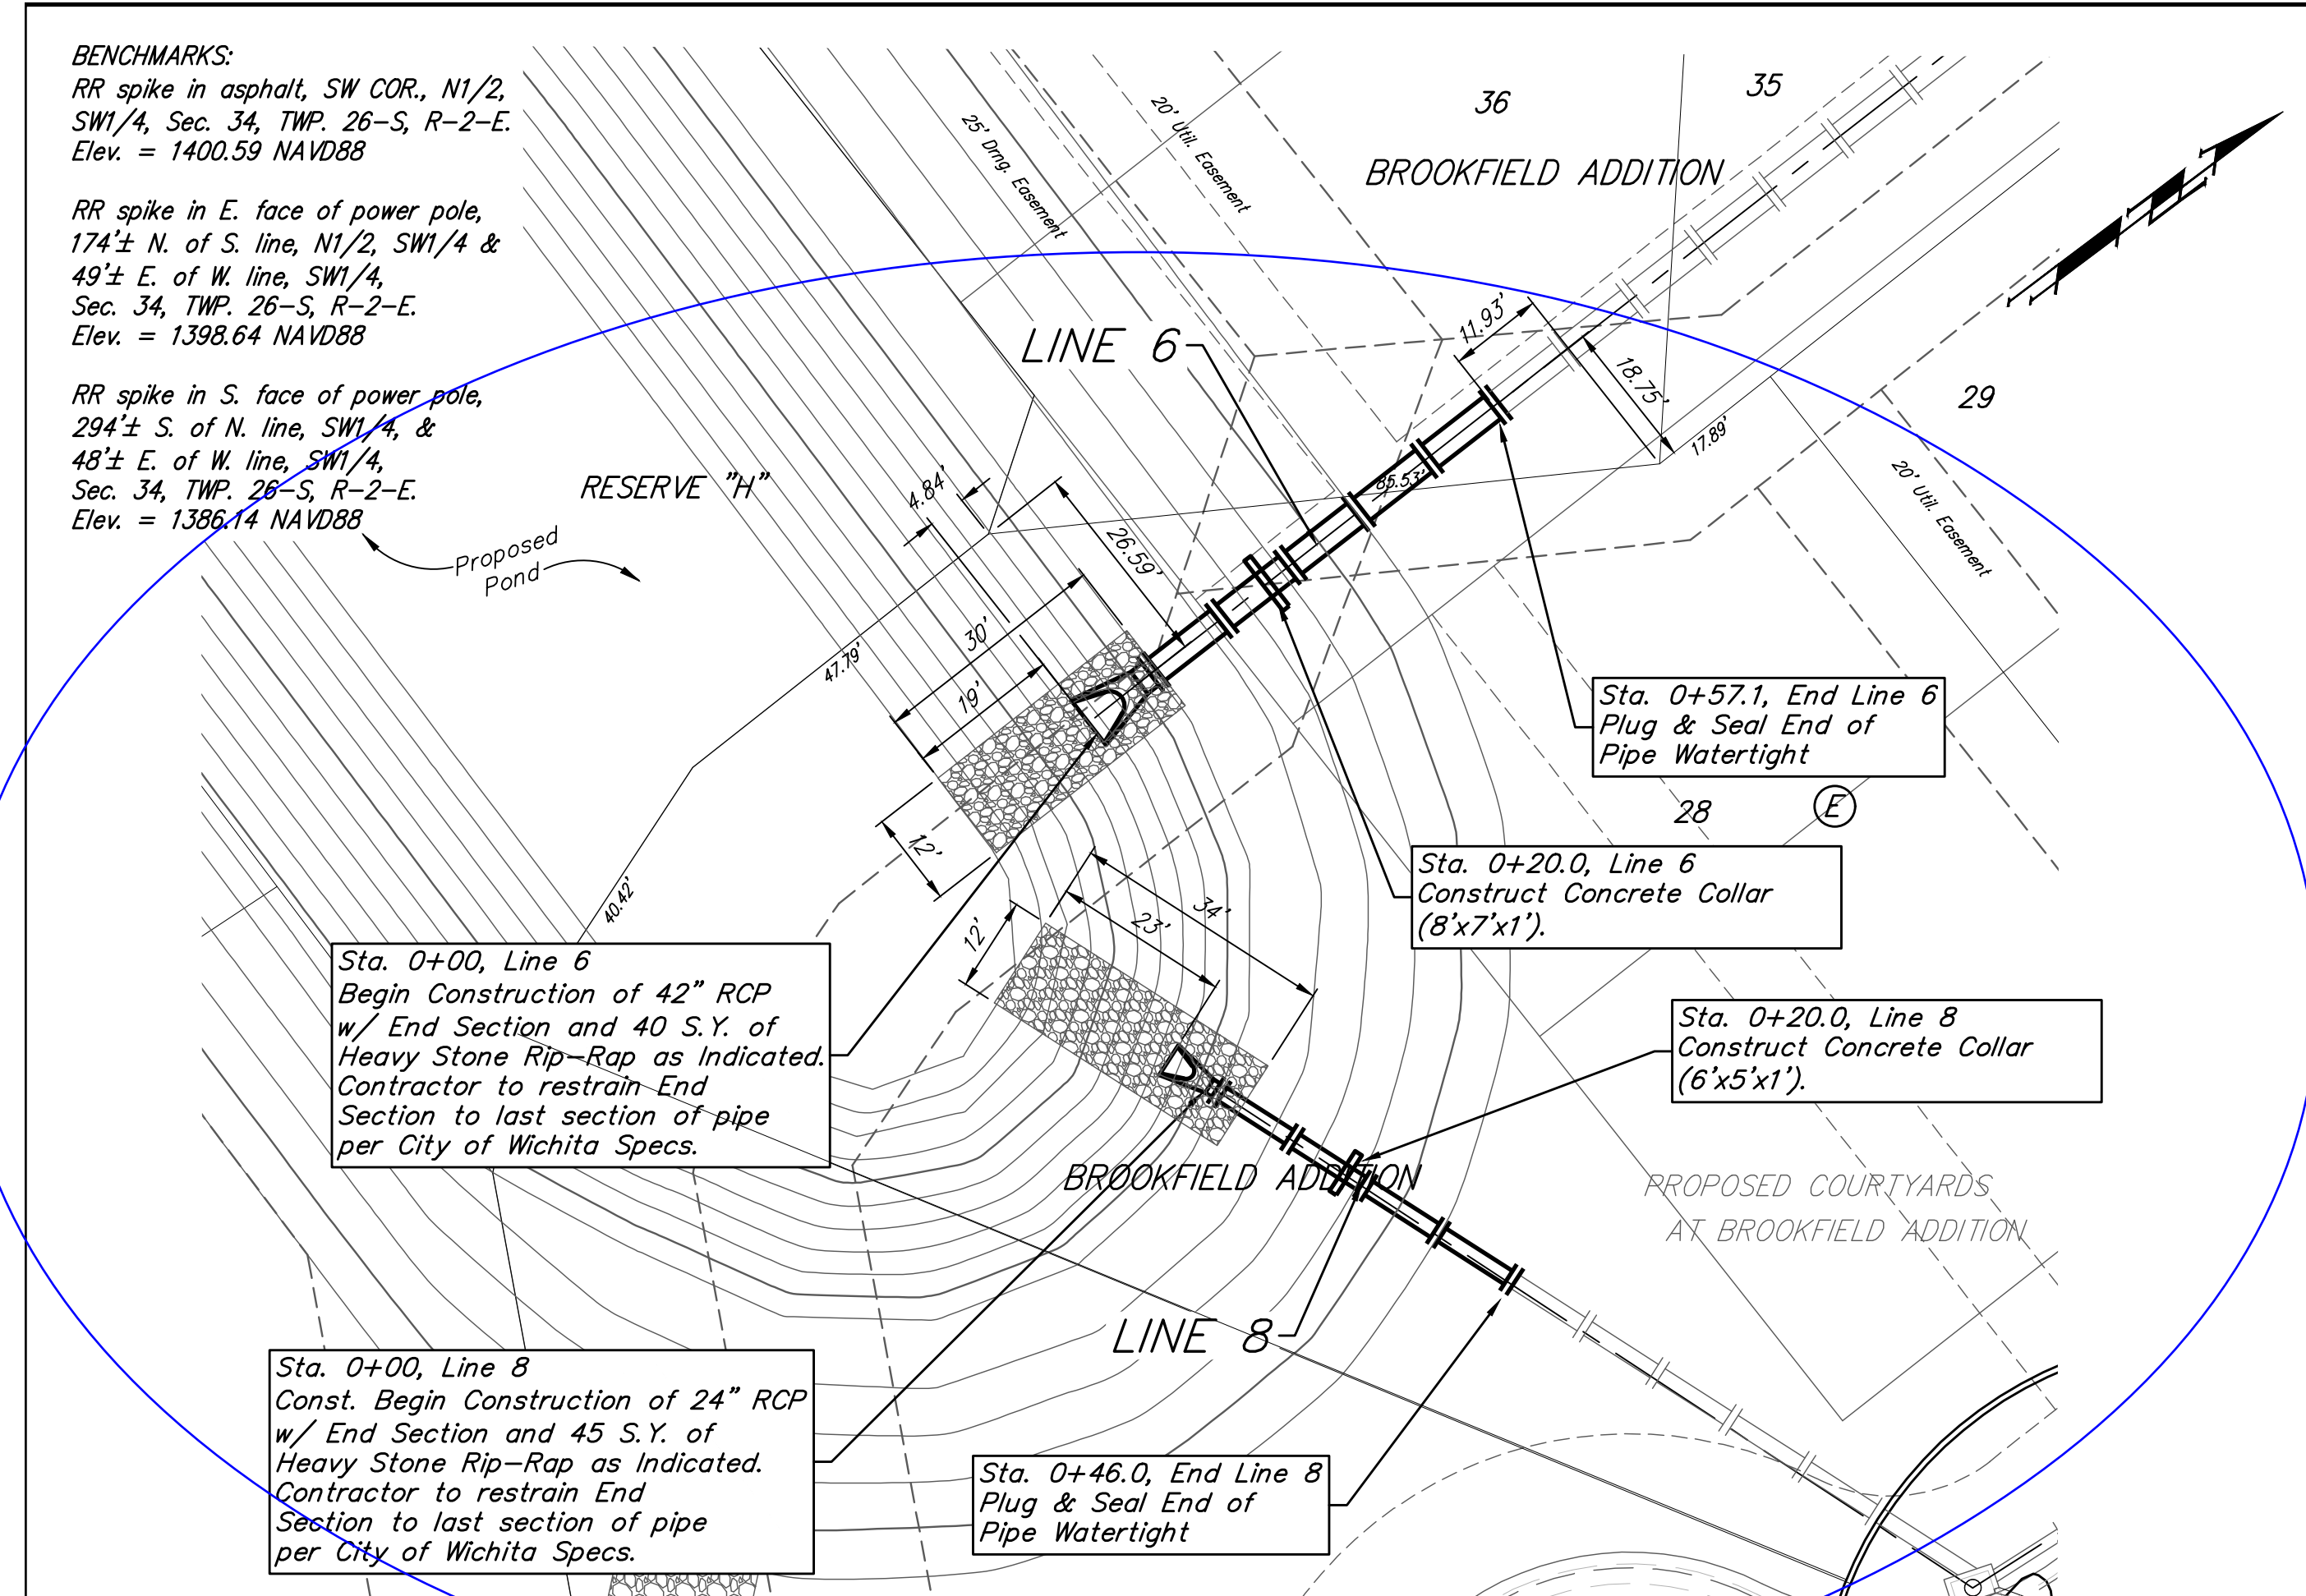

Baughman Brookfield Addition - Phase I
LINES 6, 7, & 8
 Storm Water Drain Improvements

Baughman Company, P.A. 315 Ellis St. Wichita, KS 67211 P 316-262-7271 F 316-262-0149
 ENGINEERING | SURVEYING | PLANNING | LANDSCAPE ARCHITECTURE



PROJECT NUMBER: 468-85177
 DESIGN: AEG
 DRAWN: JAK

REVISIONS:
 7/18/17 JAK
 Line 6 & Line 8
 10/4/17 A.G.

APPROVED: [Signature]
 DATE: 6/30/17

SCALE: Noted
 SHEET: **6R OF 26**


\\Projects\Brookfield Addition_1604P190\Engineering\Phase I\SWD_1608E543\SWD PLANS.dwg

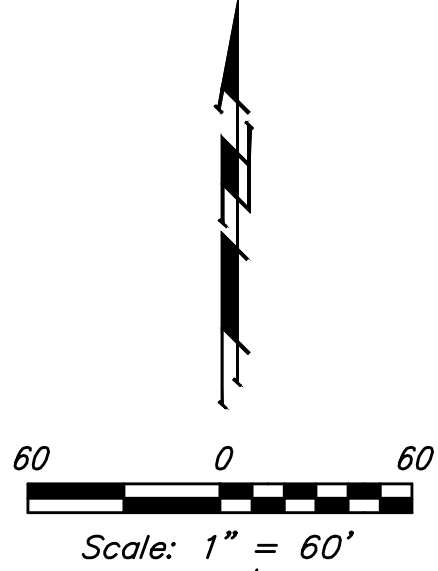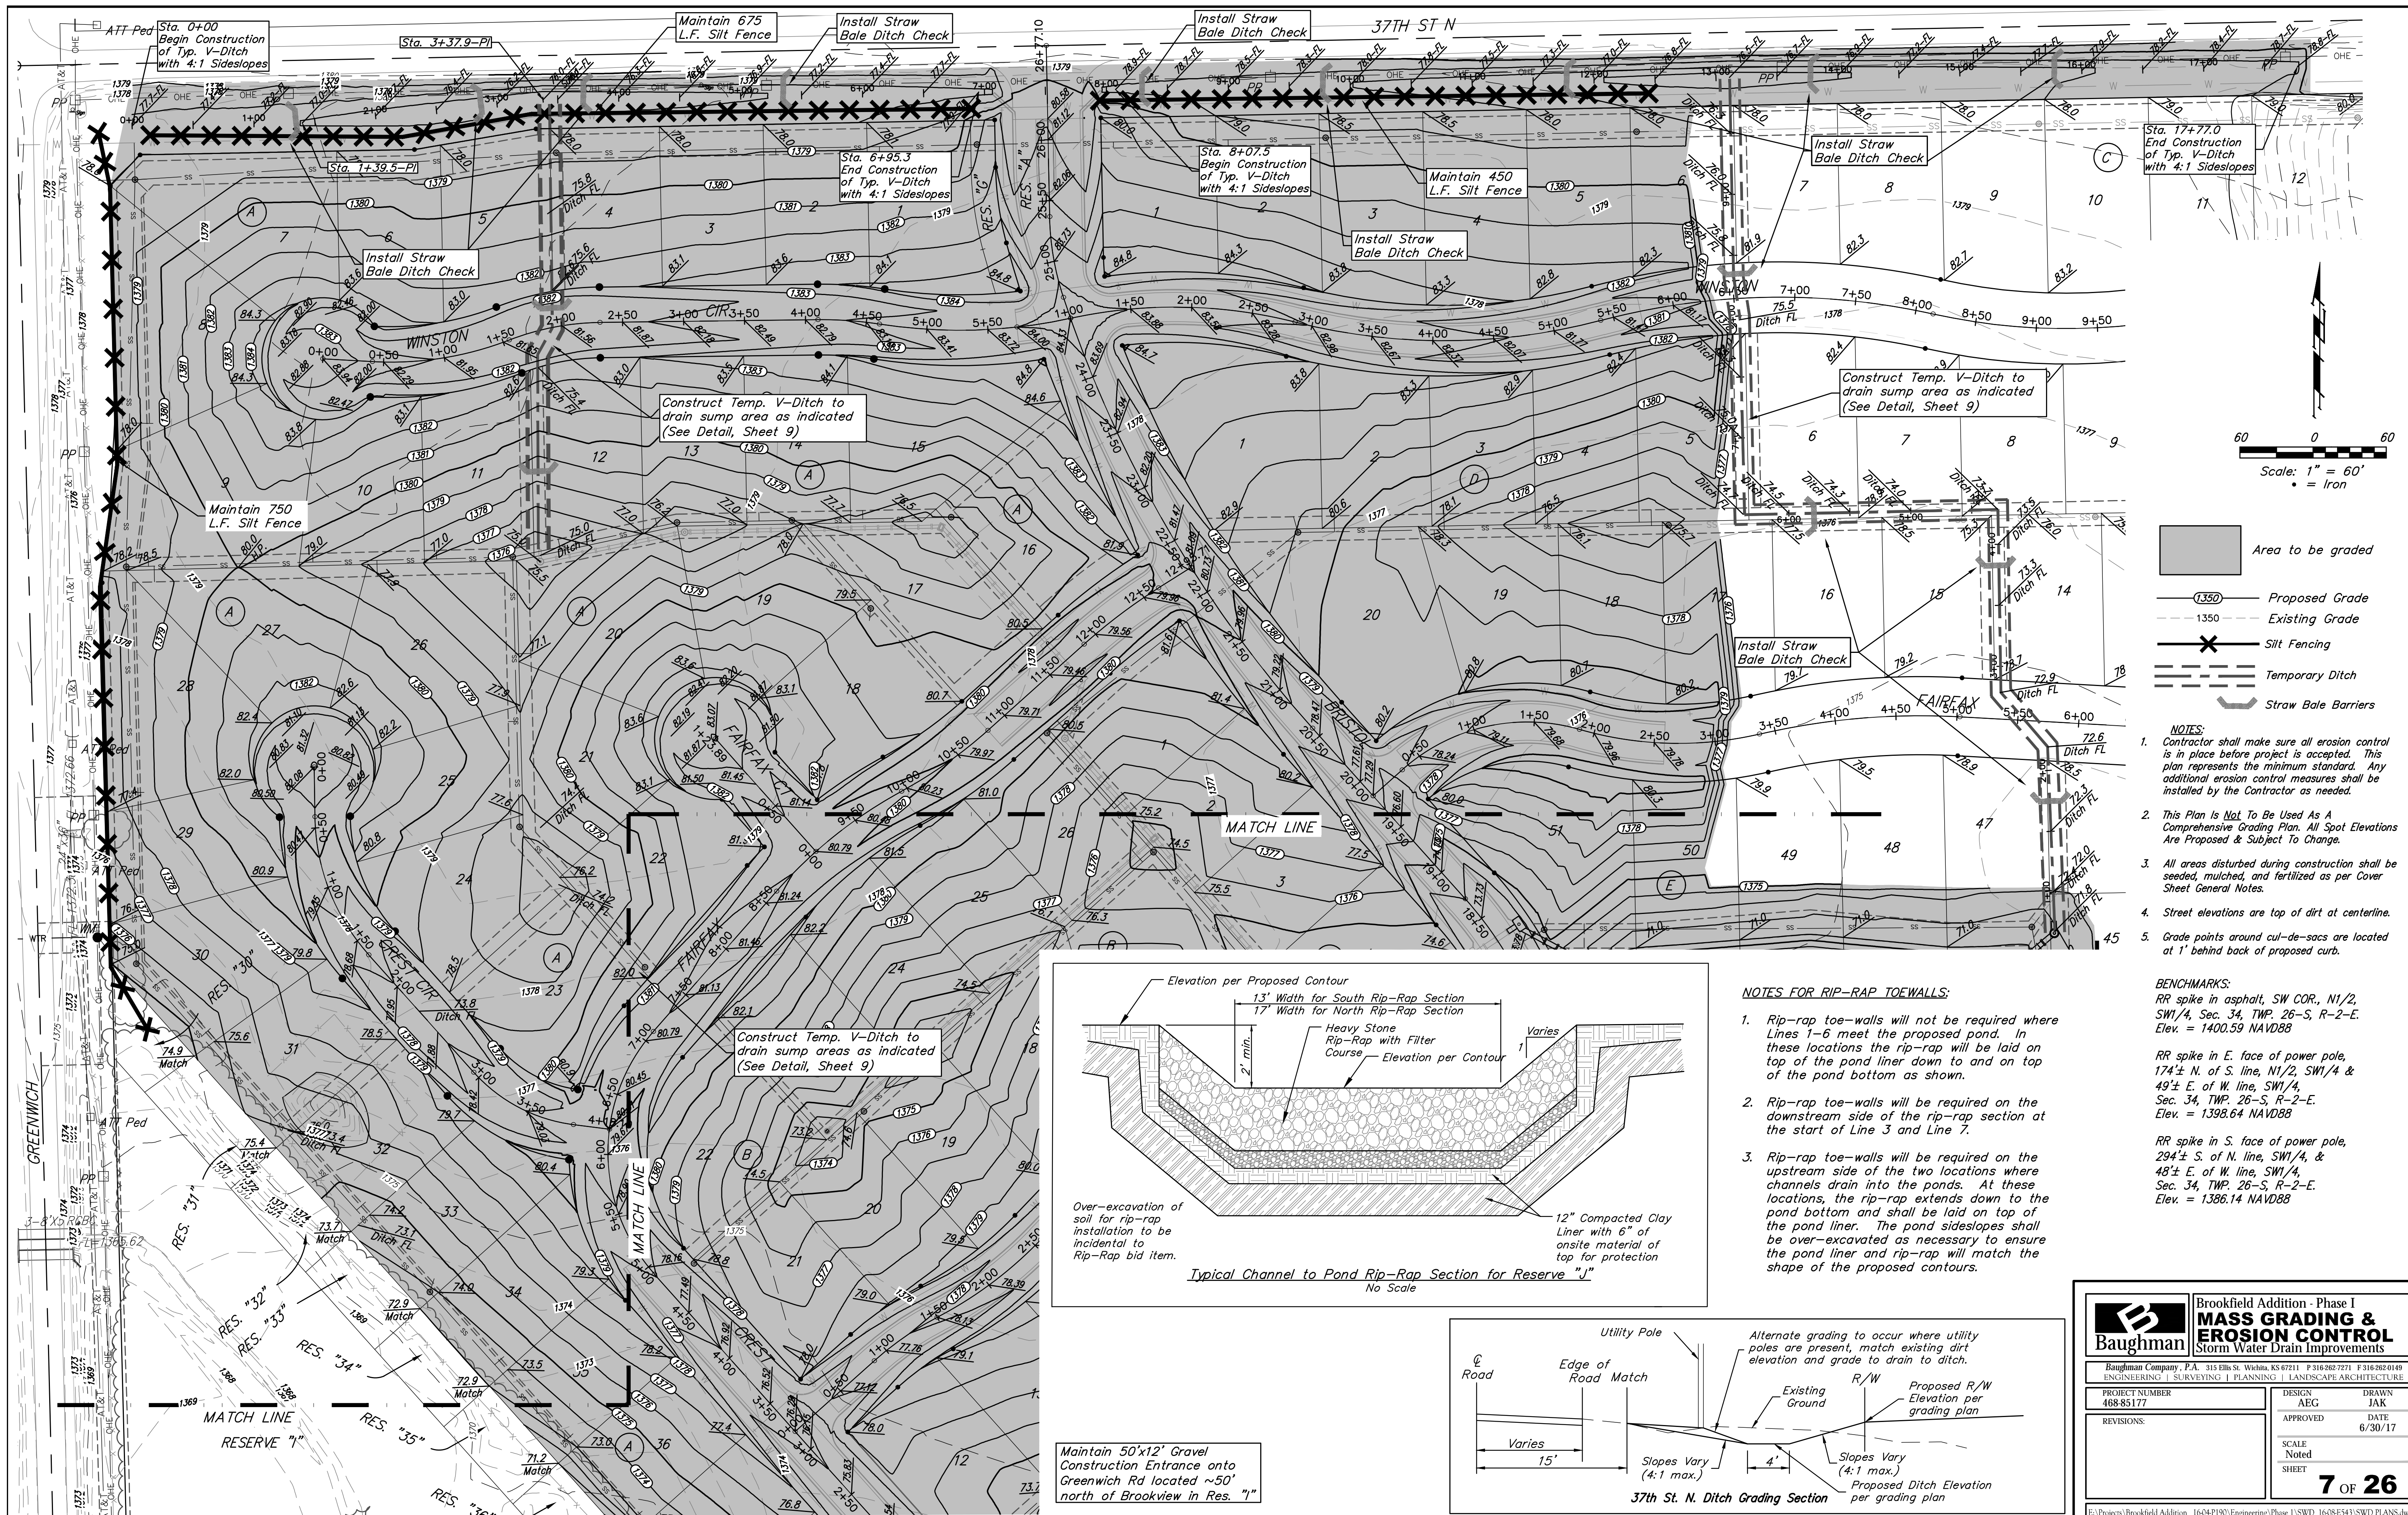


- Area to be graded
- Proposed Grade
- Existing Grade
- x Silt Fencing
- Temporary Ditch
- x Straw Bale Barriers

- NOTES:**
- Contractor shall make sure all erosion control is in place before project is accepted. This plan represents the minimum standard. Any additional erosion control measures shall be installed by the Contractor as needed.
 - This Plan is **Not** To Be Used As A Comprehensive Grading Plan. All Spot Elevations Are Proposed & Subject To Change.
 - All areas disturbed during construction shall be seeded, mulched, and fertilized as per Cover Sheet General Notes.
 - Street elevations are top of dirt at centerline.
 - Grade points around cul-de-sacs are located at 1' behind back of proposed curb.

- BENCHMARKS:**
- RR spike in asphalt, SW COR., N1/2, SW1/4, Sec. 34, TWP. 26-S, R-2-E. Elev. = 1400.59 NAVD88
 - RR spike in E. face of power pole, 174± N. of S. line, N1/2, SW1/4 & 49± E. of W. line, SW1/4, Sec. 34, TWP. 26-S, R-2-E. Elev. = 1398.64 NAVD88
 - RR spike in S. face of power pole, 294± S. of N. line, SW1/4, & 48± E. of W. line, SW1/4, Sec. 34, TWP. 26-S, R-2-E. Elev. = 1386.14 NAVD88

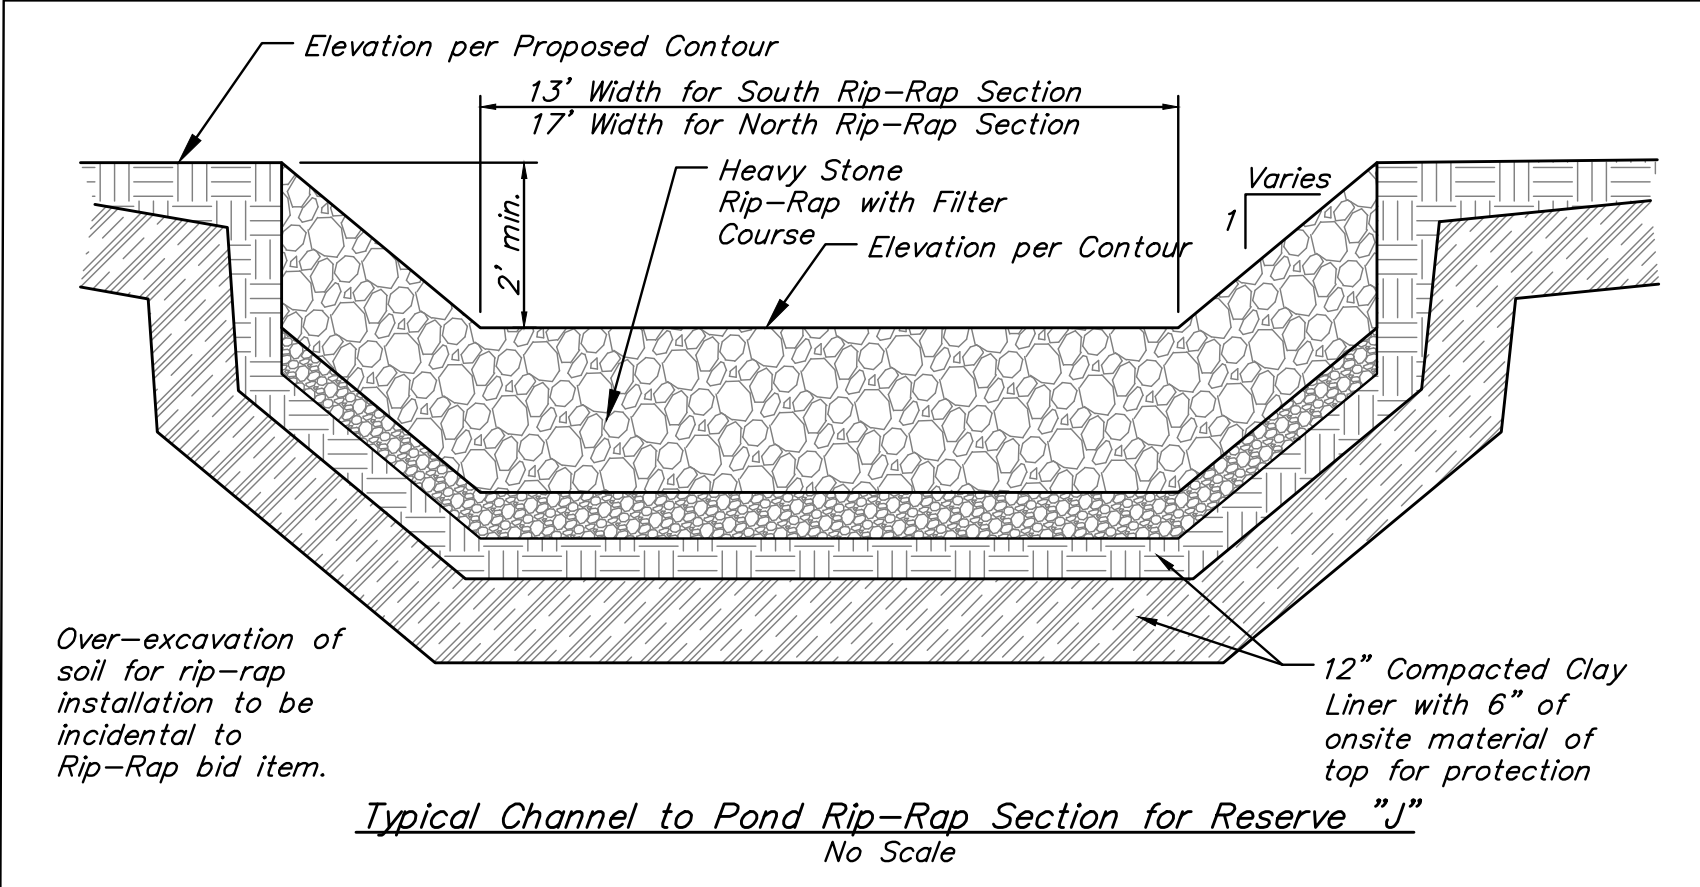

- NOTES FOR RIP-RAP TOEWALLS:**
- Rip-rap toe-walls will not be required where Lines 1-6 meet the proposed pond. In these locations the rip-rap will be laid on top of the pond liner down to and on top of the pond bottom as shown.
 - Rip-rap toe-walls will be required on the downstream side of the rip-rap section at the start of Line 3 and Line 7.
 - Rip-rap toe-walls will be required on the upstream side of the two locations where channels drain into the ponds. At these locations, the rip-rap extends down to the pond bottom and shall be laid on top of the pond liner. The pond sideslopes shall be over-excavated as necessary to ensure the pond liner and rip-rap will match the shape of the proposed contours.

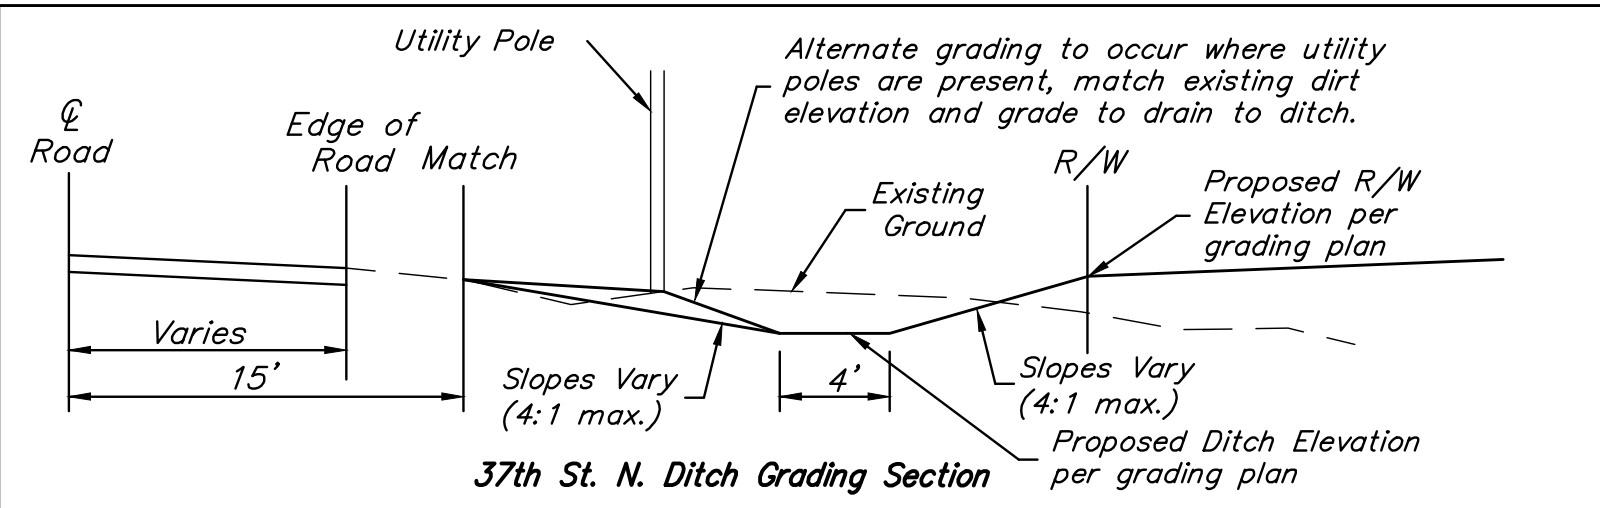

Maintain 50'x12' Gravel Construction Entrance onto Greenwich Rd located ~50' north of Brookview in Res. "J"

**Brookfield Addition - Phase I
MASS GRADING &
EROSION CONTROL
Storm Water Drain Improvements**


Baughman Company, P.A. 315 Ellis St. Wichita, KS 67211 P 316-262-7271 F 316-262-0149
ENGINEERING | SURVEYING | PLANNING | LANDSCAPE ARCHITECTURE

<small>PROJECT NUMBER 468-85177</small>	<small>DESIGN AEG</small>
<small>REVISIONS:</small>	<small>DRAWN JAK</small>
	<small>DATE 6/30/17</small>
	<small>SCALE Noted</small>
	<small>SHEET</small>

7 OF 26


E:\Projects\Brookfield Addition_1664F190\Engineering\Phase I\SWD_1608E543\SWD PLANS.dwg

BENCHMARKS:
 RR spike in asphalt, SW COR., N1/2, SW1/4, Sec. 34, TWP. 26-S, R-2-E. Elev. = 1400.59 NAVD88
 RR spike in E. face of power pole, 174± N. of S. line, N1/2, SW1/4 & 49± E. of W. line, SW1/4, Sec. 34, TWP. 26-S, R-2-E. Elev. = 1398.64 NAVD88
 RR spike in S. face of power pole, 294± S. of N. line, SW1/4, & 48± E. of W. line, SW1/4, Sec. 34, TWP. 26-S, R-2-E. Elev. = 1386.14 NAVD88

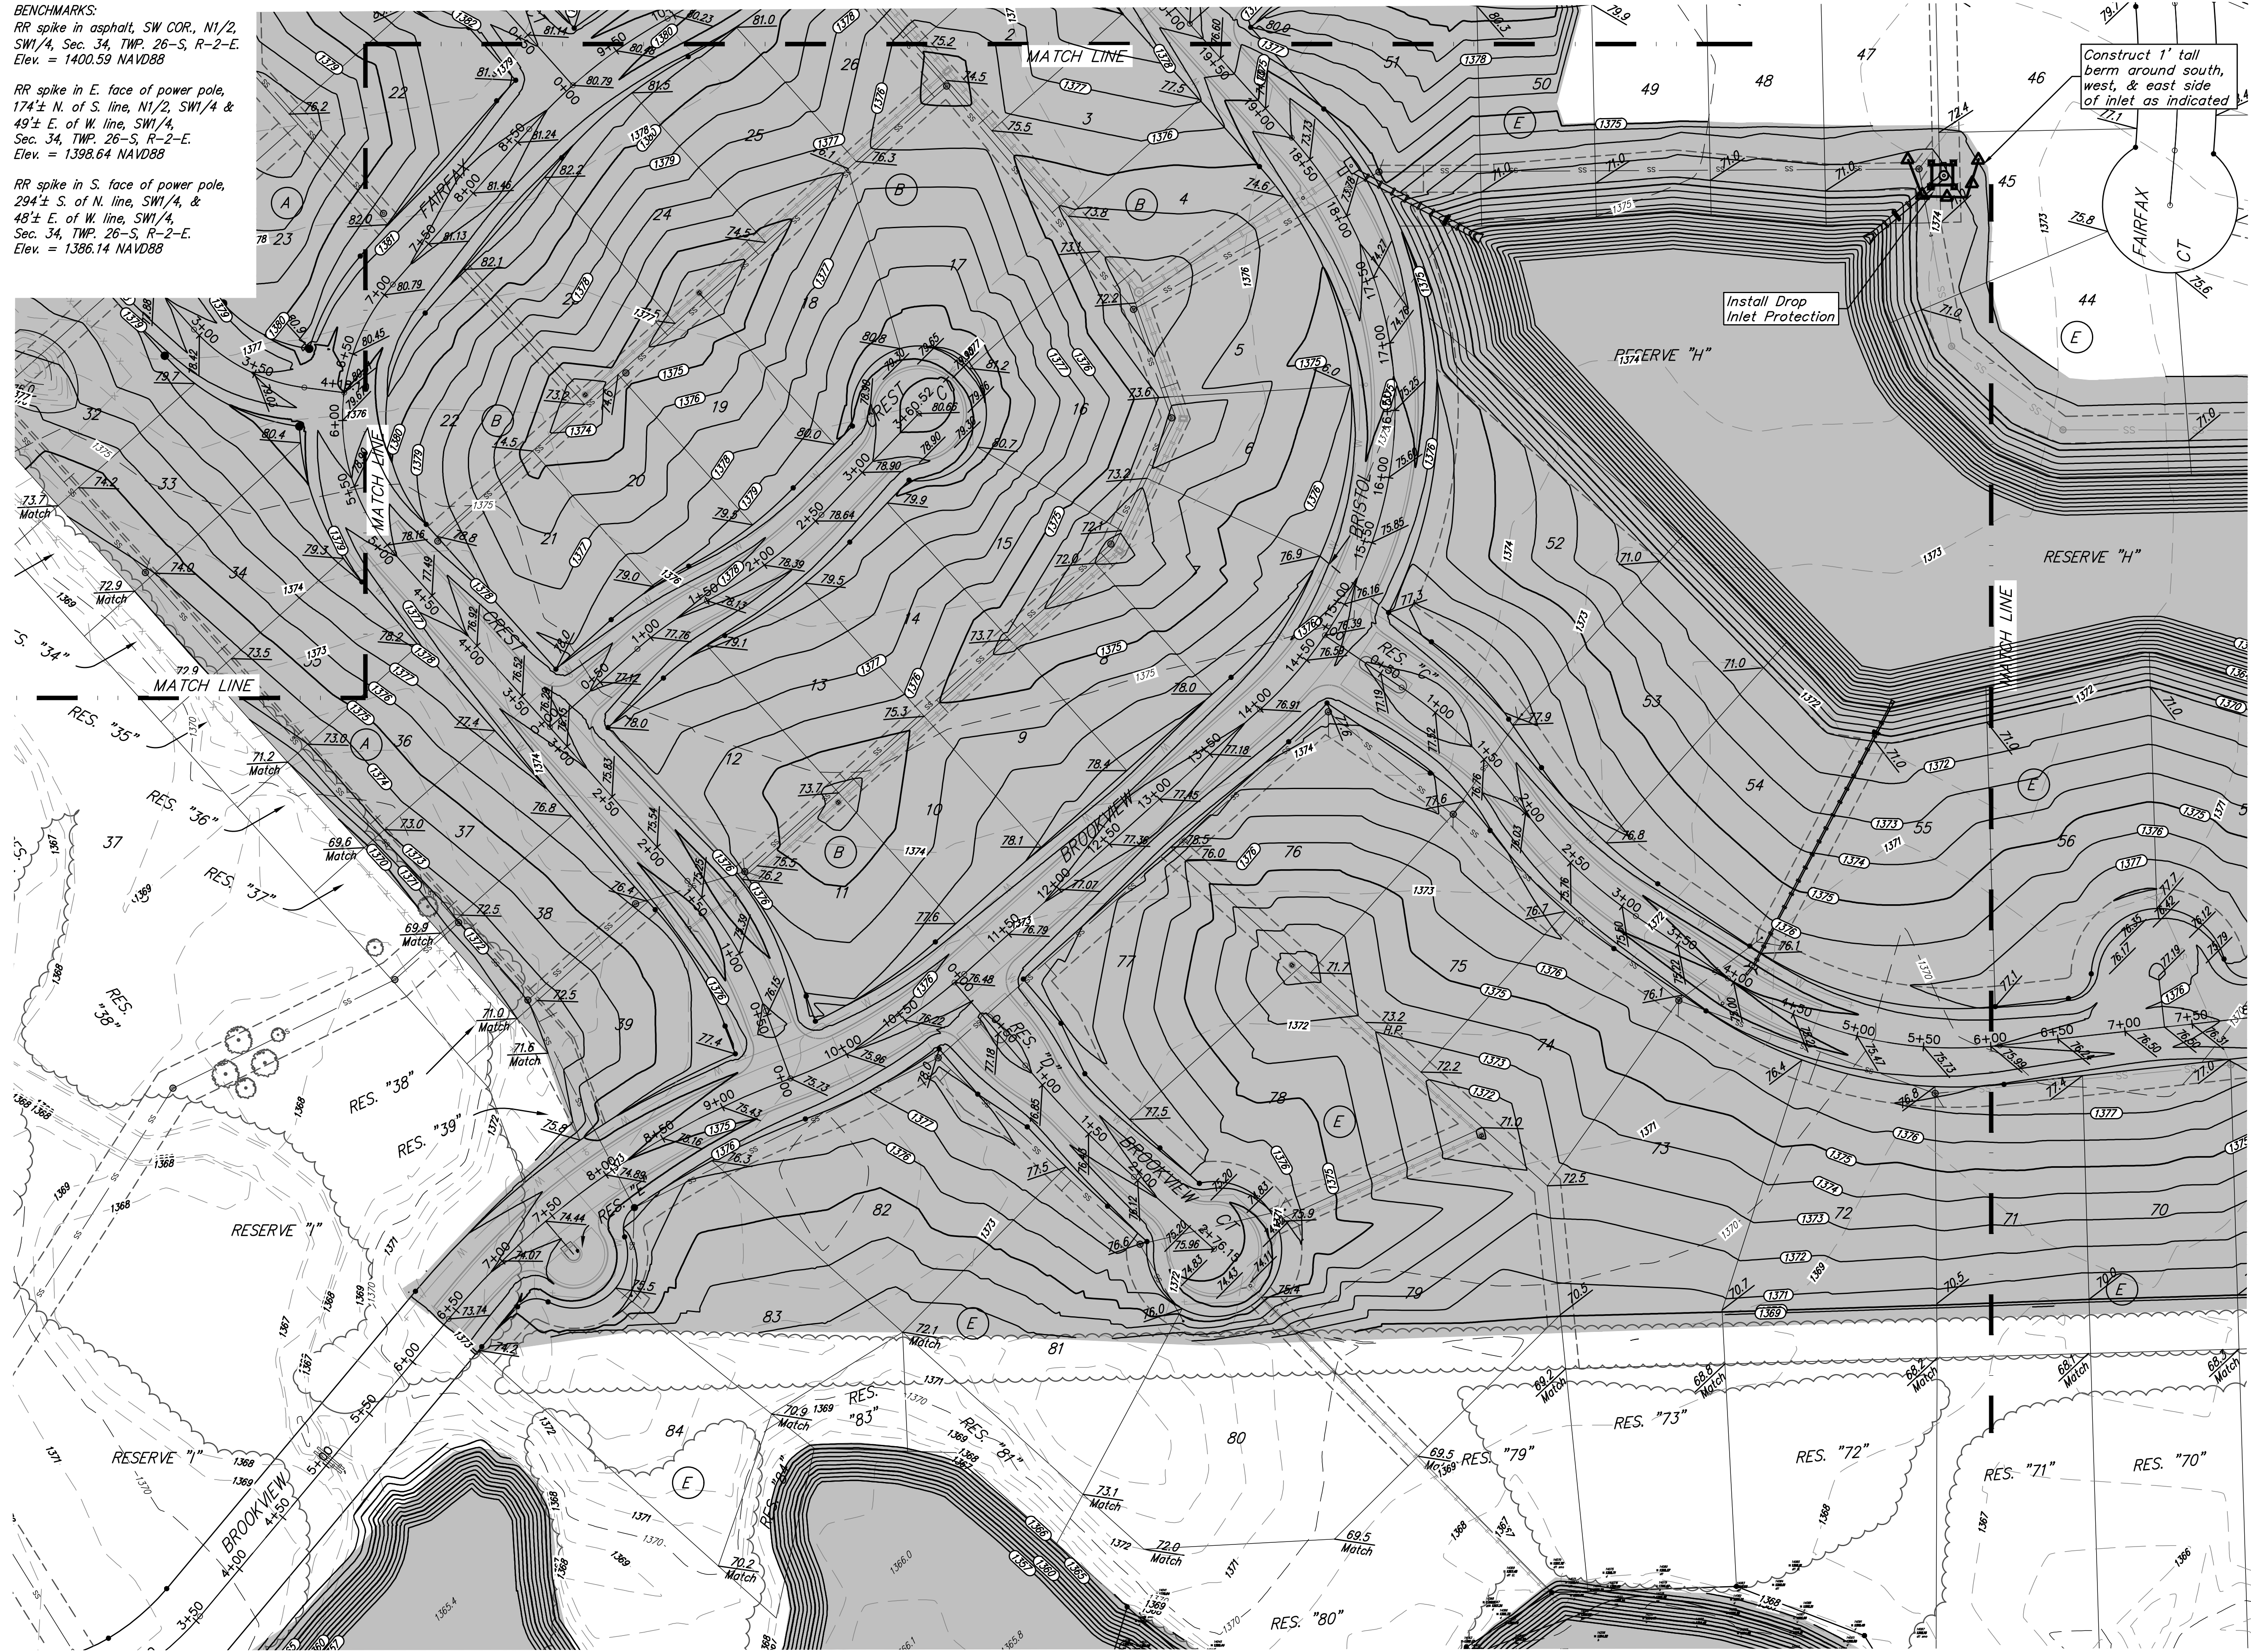

Construct 1' tall berm around south, west, & east side of inlet as indicated

Install Drop Inlet Protection

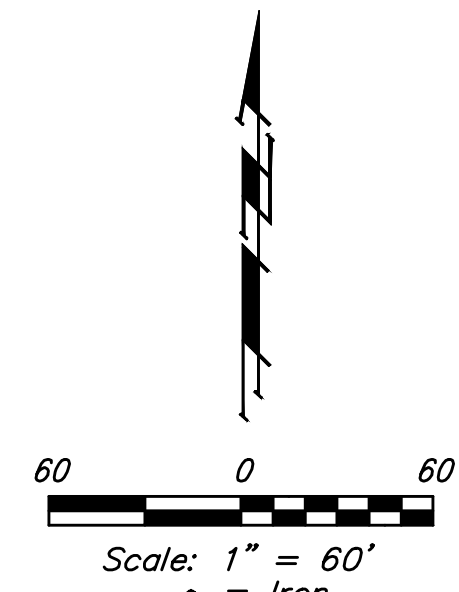

- Area to be graded
- Proposed Grade
- Existing Grade
- Temporary Ditch
- Drop Inlet Protection

- NOTES:**
- Contractor shall make sure all erosion control is in place before project is accepted. This plan represents the minimum standard. Any additional erosion control measures shall be installed by the Contractor as needed.
 - This Plan is *Not* To Be Used As A Comprehensive Grading Plan. All Spot Elevations Are Proposed & Subject To Change.
 - All areas disturbed during construction shall be seeded, mulched, and fertilized as per Cover Sheet General Notes.
 - Street elevations are top of dirt at centerline.
 - Grade points around cul-de-sacs are located at 1' behind back of proposed curb.

EROSION CONTROL MEASURE	INSTALL	MAINTAIN
CONSTRUCTION ENTRANCE (EA)	0	1
SILT FENCE (LF)	0	1,875
DITCH CHECKS (EA)	18	0
DROP INLET PROTECTION (EA)	2	0
EROSION CONTROL MAT (SY)	13,516	0
MULCH WATTLE SED. BARRIER (LF)	437	0

* ALL EXISTING BMPs INCLUDING CONSTRUCTION ENTRANCE, SEDIMENT BARRIERS, SILT FENCE, CUT-OFF TRENCH, AND EROSION CONTROL MAT SHALL BE MAINTAINED AND REPAIRED IF NECESSARY.

**Brookfield Addition - Phase I
 MASS GRADING &
 EROSION CONTROL
 Storm Water Drain Improvements**

Baughman Company, P.A. 315 Ellis St. Wichita, KS 67211 P 316-262-7271 F 316-262-0149
 ENGINEERING | SURVEYING | PLANNING | LANDSCAPE ARCHITECTURE



<small>PROJECT NUMBER 468-85177</small>	<small>DESIGN AEG</small>	<small>DRAWN JAK</small>
<small>REVISIONS:</small>	<small>APPROVED</small>	<small>DATE 6/30/17</small>
	<small>SCALE Noted</small>	
	<small>SHEET</small>	8 OF 26

E:\Projects\Brookfield Addition_1664F190\Engineering\Phase I\SWD_1668E543\SWD PLANS.dwg

BENCHMARKS:
 RR spike in asphalt, SW COR., N1/2,
 SW1/4, Sec. 34, TWP. 26-S, R-2-E.
 Elev. = 1400.59 NAVD88

RR spike in E. face of power pole,
 174'± N. of S. line, N1/2, SW1/4 &
 49'± E. of W. line, SW1/4,
 Sec. 34, TWP. 26-S, R-2-E.
 Elev. = 1398.64 NAVD88

RR spike in S. face of power pole,
 294'± S. of N. line, SW1/4, &
 48'± E. of W. line, SW1/4,
 Sec. 34, TWP. 26-S, R-2-E.
 Elev. = 1386.14 NAVD88

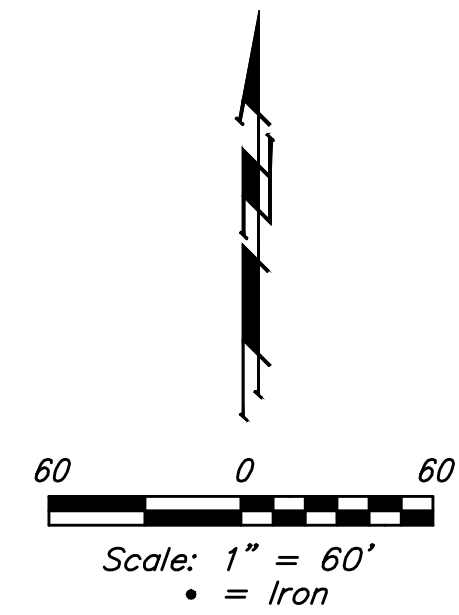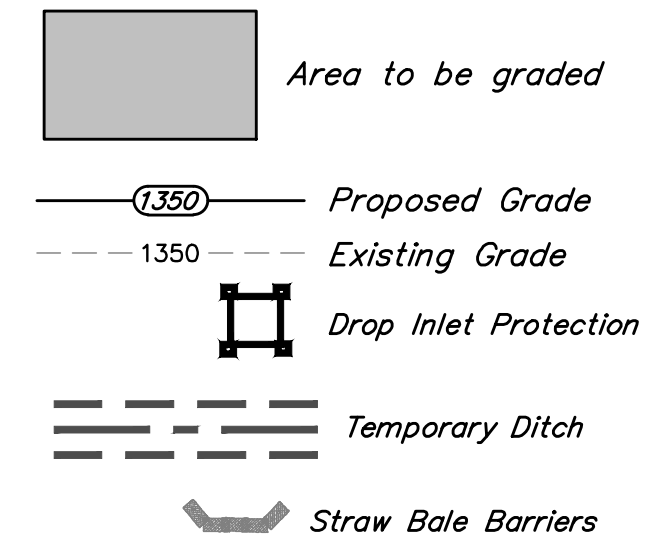

- NOTES:**
- Contractor shall make sure all erosion control is in place before project is accepted. This plan represents the minimum standard. Any additional erosion control measures shall be installed by the Contractor as needed.
 - This Plan is Not To Be Used As A Comprehensive Grading Plan. All Spot Elevations Are Proposed & Subject To Change.
 - All areas disturbed during construction shall be seeded, mulched, and fertilized as per Cover Sheet General Notes.
 - Street elevations are top of dirt at centerline.
 - Grade points around cul-de-sacs are located at 1' behind back of proposed curb.

Mass Grading General Notes:

- Excess material shall remain on-site and be spread evenly on lots outside of easements and right-of-ways. Earthwork quantities are unadjusted and are for reference only. All cost associated with mass grading shall be incidental to lump sum bid item "Mass Grading".
- Contractor to strip top 4-6" of soil within street right-of-way and Reserve "H" before mass grading and stockpile. Topsoil is to be spread over Reserve "H" above static water elevation and areas not under proposed pavement prior to seeding.
- Compaction of 95% Std. Proctor Density shall be obtained in all street R/W's, 90% in all other areas.
- It shall be the Contractor's responsibility to protect existing utilities during mass grading. Any damage done to these systems by Contractor or subcontractor shall be repaired at no additional cost to the project.
- All areas disturbed by construction shall be seeded as indicated in the cover sheet general notes.

Construct Temp. V-Ditch to drain sump area as indicated (See Detail, this sheet)


Install Straw Bale Ditch Check

Install Straw Bale Ditch Check

Construct Temp. V-Ditch to drain sump area as indicated (See Detail, this sheet)


Install Drop Inlet Protection

Install Straw Bale Ditch Check

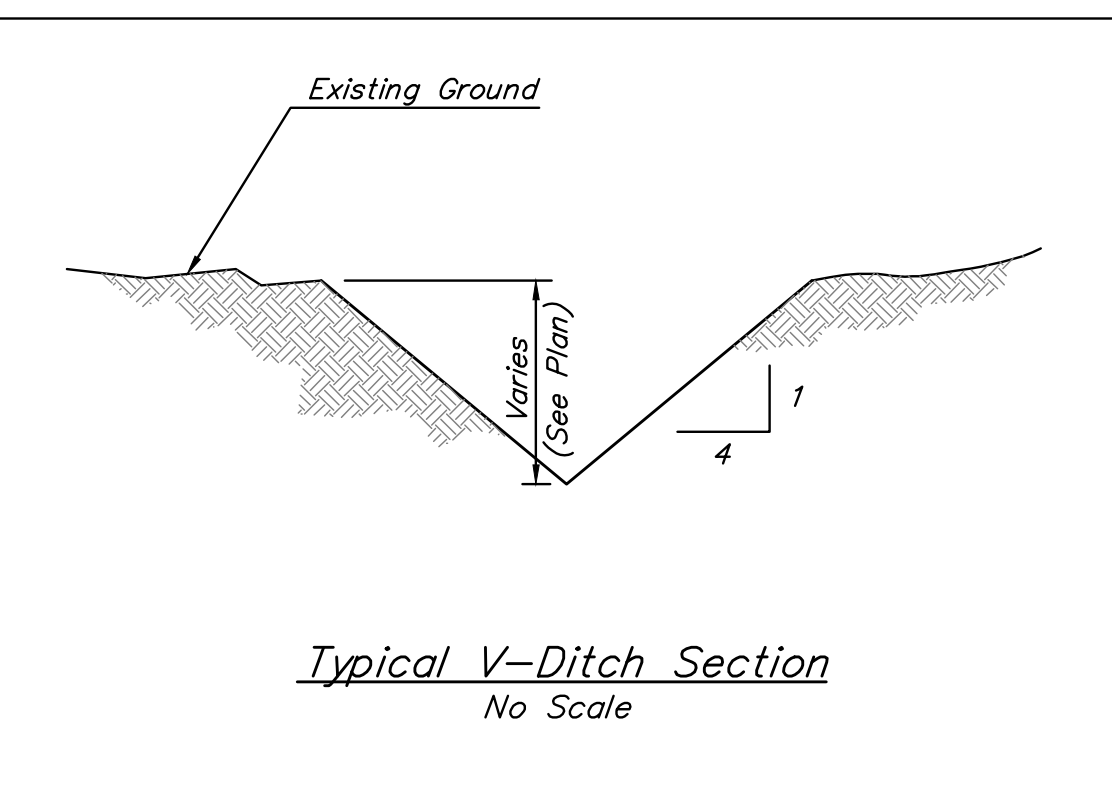

Typical V-Ditch Section
 No Scale

Baughman		Brookfield Addition - Phase I MASS GRADING & EROSION CONTROL Storm Water Drain Improvements	
Baughman Company, P.A. 315 Ellis St. Wichita, KS 67211 P 316-262-7271 F 316-262-0149 ENGINEERING SURVEYING PLANNING LANDSCAPE ARCHITECTURE			
PROJECT NUMBER 468-85177	DESIGN AEG	DRAWN JAK	DATE 6/30/17
REVISIONS:	APPROVED	SCALE Noted	SHEET
		9 OF 26	

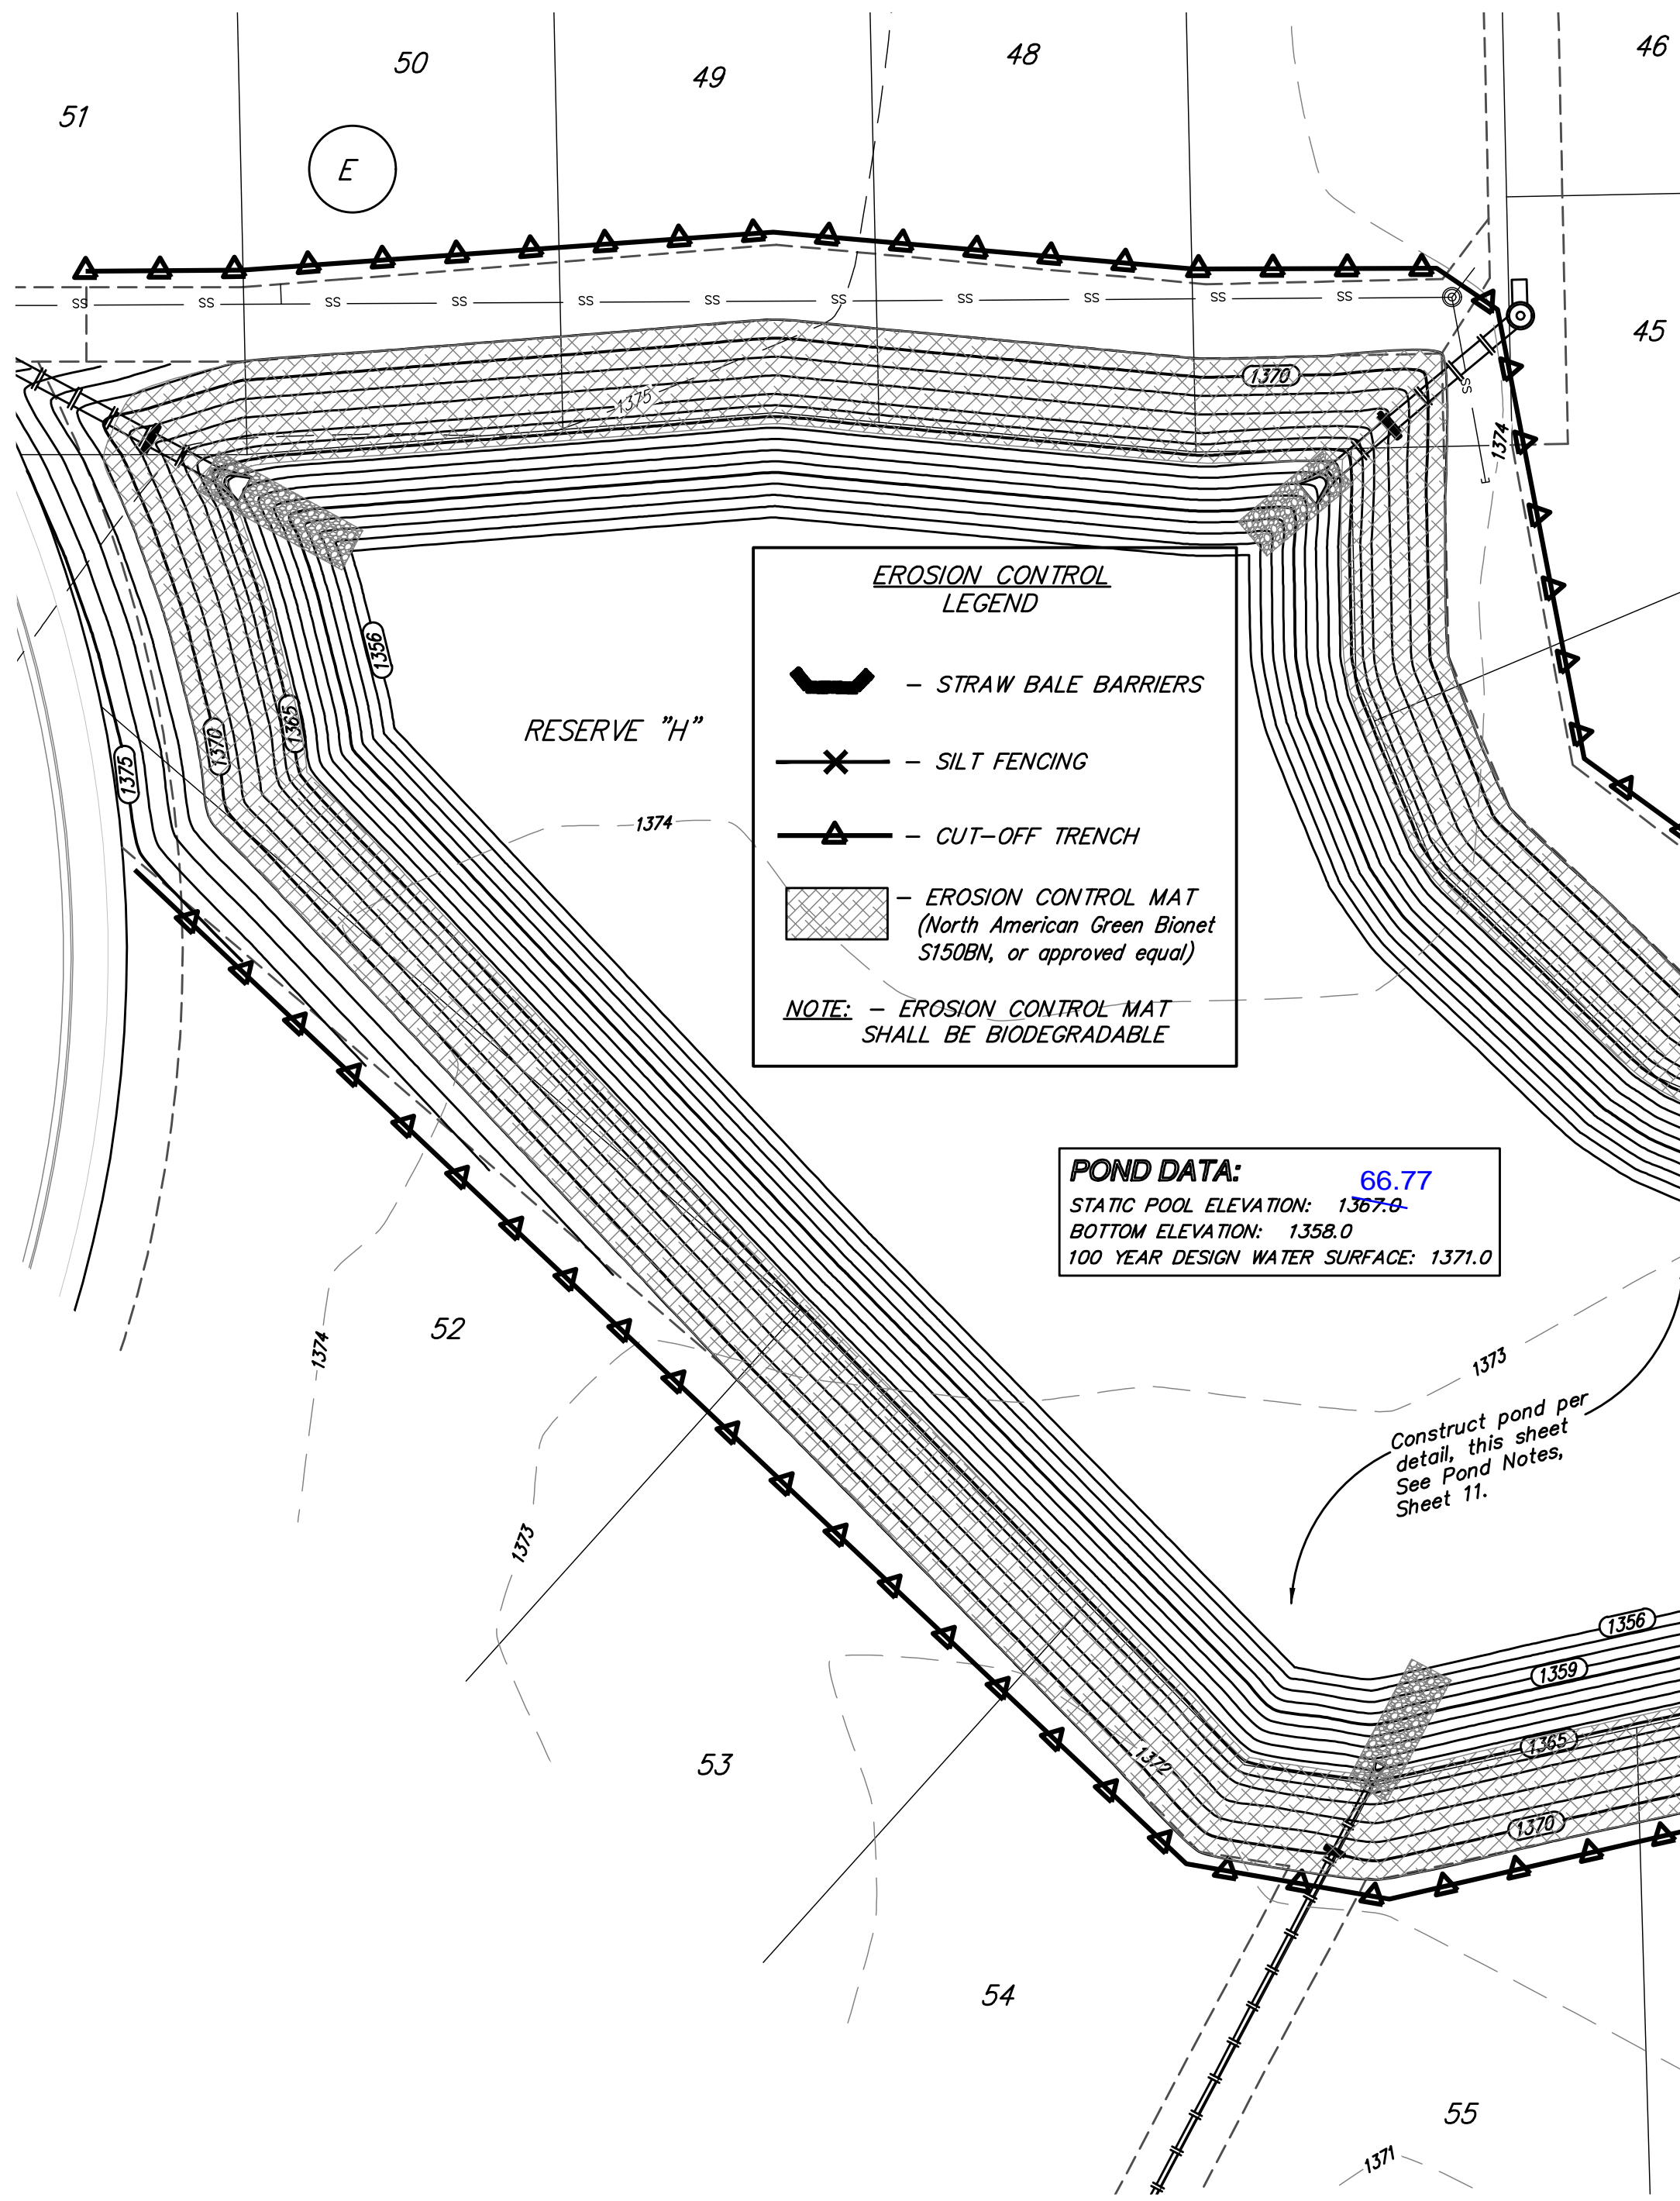


EROSION CONTROL LEGEND

- STRAW BALE BARRIERS
- SILT FENCING
- CUT-OFF TRENCH
- EROSION CONTROL MAT (North American Green Bionet S150BN, or approved equal)

NOTE: - EROSION CONTROL MAT SHALL BE BIODEGRADABLE


POND DATA: 66.77
 STATIC POOL ELEVATION: 1367.6
 BOTTOM ELEVATION: 1358.0
 100 YEAR DESIGN WATER SURFACE: 1371.0

SLOPE INSTALLATION

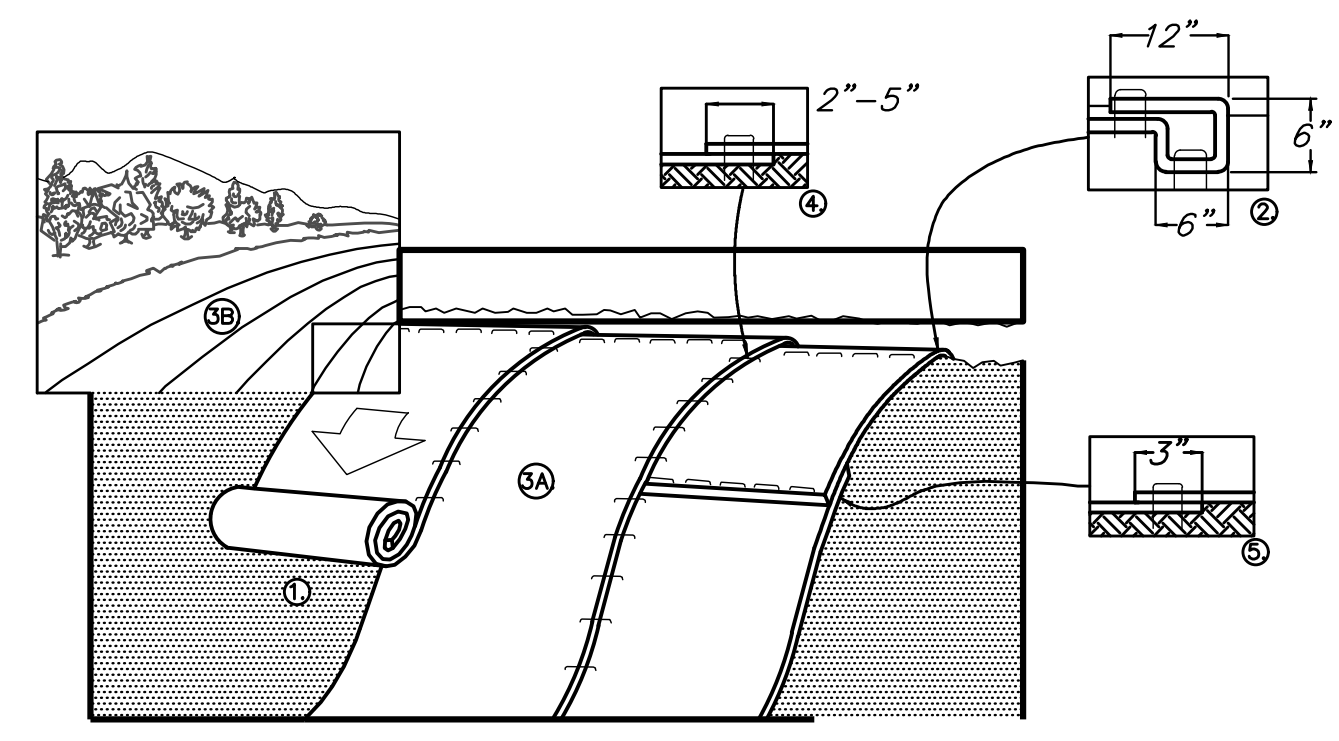

- NOTE: Erosion control mat shall be installed and anchored per manufacturer's specifications. Quantity is for information only and does not include excess material necessary for overlap and anchoring. All cost of matting shall be included in SY "Erosion Control Mat"
- PREPARE SOIL BEFORE INSTALLING BLANKETS, INCLUDING ANY NECESSARY APPLICATION OF LIME, FERTILIZER, AND SEED. NOTE: WHEN USING CELL-O-SEED DO NOT SEED PREPARED AREA. CELL-O-SEED MUST BE INSTALLED WITH PAPER SIDE DOWN.
 - BEGIN AT THE TOP OF THE SLOPE BY ANCHORING THE BLANKET IN A 6" (15cm) DEEP X 6" (15cm) WIDE TRENCH WITH APPROXIMATELY 12" (30cm) OF BLANKET EXTENDED BEYOND THE UP-SLOPE PORTION OF THE TRENCH. ANCHOR THE BLANKET WITH A ROW OF STAPLES/STAKES APPROXIMATELY 12" (30cm) APART IN THE BOTTOM OF THE TRENCH. BACKFILL AND COMPACT THE TRENCH AFTER STAPLING. APPLY SEED TO COMPACTED SOIL AND FOLD REMAINING 12" (30cm) PORTION OF BLANKET BACK OVER SEED AND COMPACTED SOIL. SECURE BLANKET OVER COMPACTED SOIL WITH A ROW OF STAPLES/STAKES SPACED APPROXIMATELY 12" (30cm) APART ACROSS THE WIDTH OF THE BLANKET.
 - ROLL THE BLANKETS (A) DOWN OR (B) HORIZONTALLY ACROSS THE SLOPE. BLANKETS WILL UNROLL WITH APPROPRIATE SIDE AGAINST THE SOIL SURFACE. ALL BLANKETS MUST BE SECURELY FASTENED TO SOIL SURFACE BY PLACING STAPLES/STAKES IN APPROPRIATE LOCATIONS AS SHOWN IN THE STAPLE PATTERN GUIDE. WHEN USING OPTIONAL DOT SYSTEM, STAPLES/STAKES SHOULD BE PLACED THROUGH EACH OF THE COLORED DOTS CORRESPONDING TO THE APPROPRIATE STAPLE PATTERN.
 - THE EDGES OF PARALLEL BLANKETS MUST BE STAPLED WITH APPROXIMATELY 2"-5" (5cm-12.5cm) OVERLAP DEPENDING ON BLANKET TYPE. TO ENSURE PROPER SEAM ALIGNMENT, PLACE THE EDGE OF THE OVERLAPPING BLANKET (BLANKET BEING INSTALLED ON TOP) EVEN WITH THE COLORED SEAM STRICH ON THE PREVIOUSLY INSTALLED BLANKET.
 - CONSECUTIVE BLANKETS SPLICED DOWN THE SLOPE MUST BE PLACED END OVER END (SHINGLE STYLE) WITH AN APPROXIMATE 3" (7.5cm) OVERLAP. STAPLE THROUGH OVERLAPPED AREA, APPROXIMATELY 12" (30cm) APART ACROSS ENTIRE BLANKET WIDTH.
- NOTE:
 *IN LOOSE SOIL CONDITIONS, THE USE OF STAPLE OR STAKE LENGTHS GREATER THAN 6" (15cm) MAY BE NECESSARY TO PROPERLY SECURE THE BLANKETS.
 SEEDING DIRECTLY BENEATH THE EROSION CONTROL MAT SHALL BE INCLUDED IN THE COST OF THE EROSION CONTROL MAT.
- 14649 HIGHWAY 41 NORTH, EVANSVILLE, INDIANA 47725
 USA 1-800-772-2040 CANADA 1-800-448-2040
 www.nogreen.com

BENCHMARKS:
 RR spike in asphalt, SW COR., N1/2, SW1/4, Sec. 34, TWP. 26-S, R-2-E. Elev. = 1400.59 NAVD88
 RR spike in E. face of power pole, 174± N. of S. line, N1/2, SW1/4 & 49± E. of W. line, SW1/4, Sec. 34, TWP. 26-S, R-2-E. Elev. = 1398.64 NAVD88
 RR spike in S. face of power pole, 294± S. of N. line, SW1/4, & 48± E. of W. line, SW1/4, Sec. 34, TWP. 26-S, R-2-E. Elev. = 1398.14 NAVD88

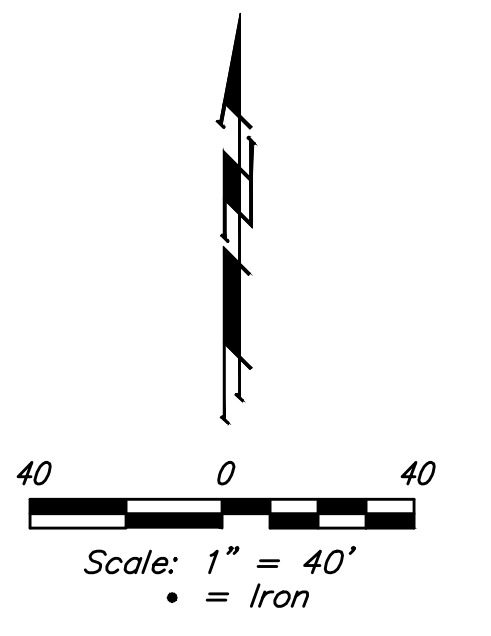

—(1350)— Proposed Grade
 - - - - - 1350 - - - - - Existing Grade


Construct Pond Slope per Section A-A, This Sheet.

Construct 1,440 L.F. Cutoff Trench and Berm (See Detail, This Sheet).

Construct 1,158 L.F. Cutoff Trench and Berm (See Detail, This Sheet).

Construct Pond Slope per Section B-B, This Sheet.

Construct Reinf. Conc. Weir with 22 SY Heavy Stone Rip-rap upstream and 39 SY Heavy Stone Rip-rap Downstream. See Detail, This Sheet.



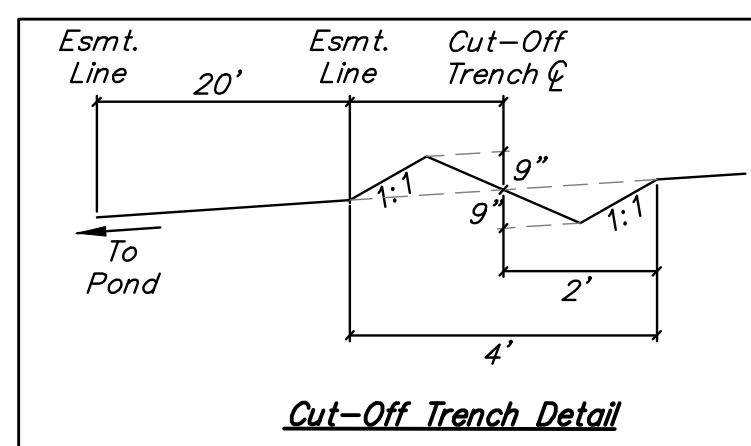


STAPLE PATTERN "D"
 3-1/2 staples per sq. yd. using 6-inch, 11 ga. wire "U" staples. 8-inch staples and longer may be used for loose soils. 9 ga. staples or heavier may be necessary in hard or rocky soils.

Contractor shall follow manufacturer's installation instructions regarding overlap dimensions. The overlap shall have a minimum dimension of three inches (3").

STAPLE PATTERN

See Sheet 11 for pond excavation and bentonite quantity information

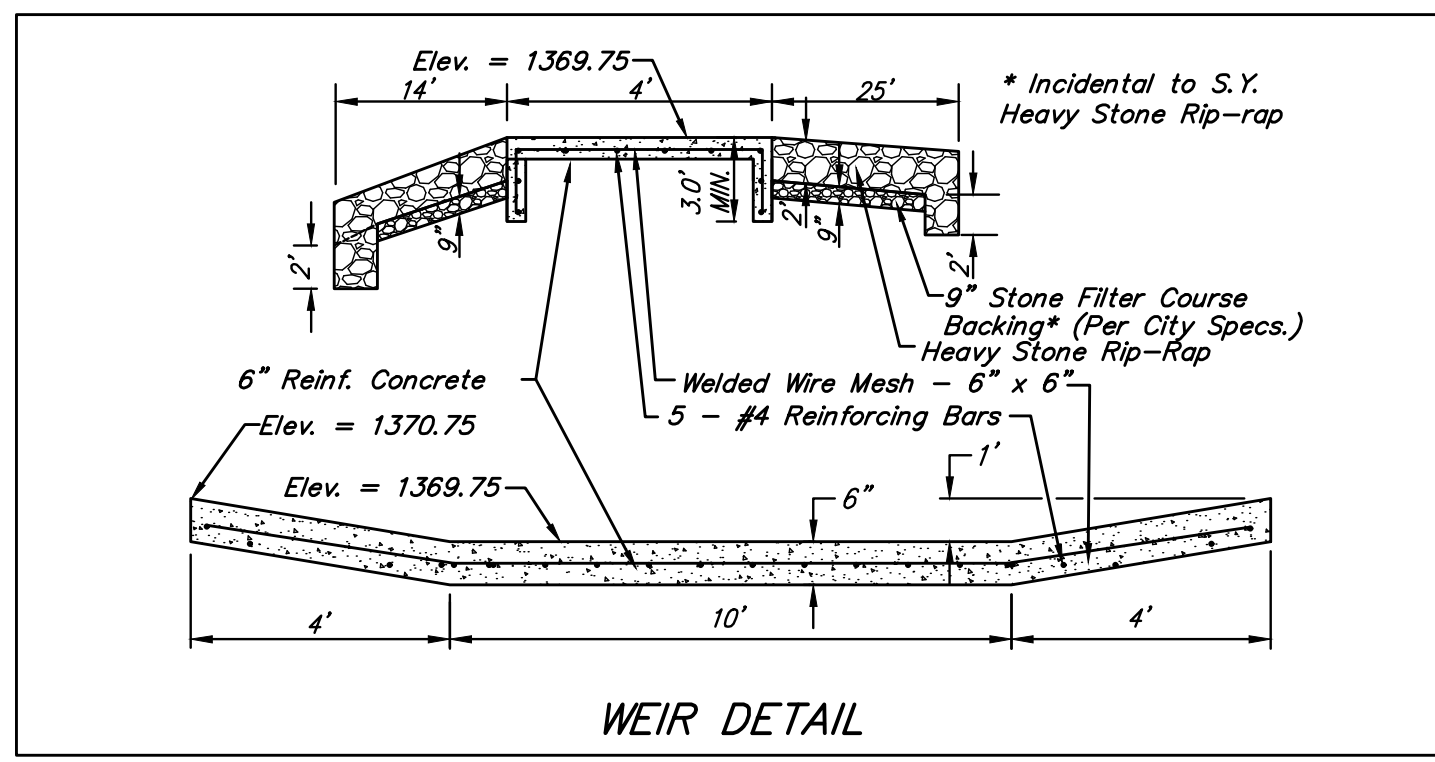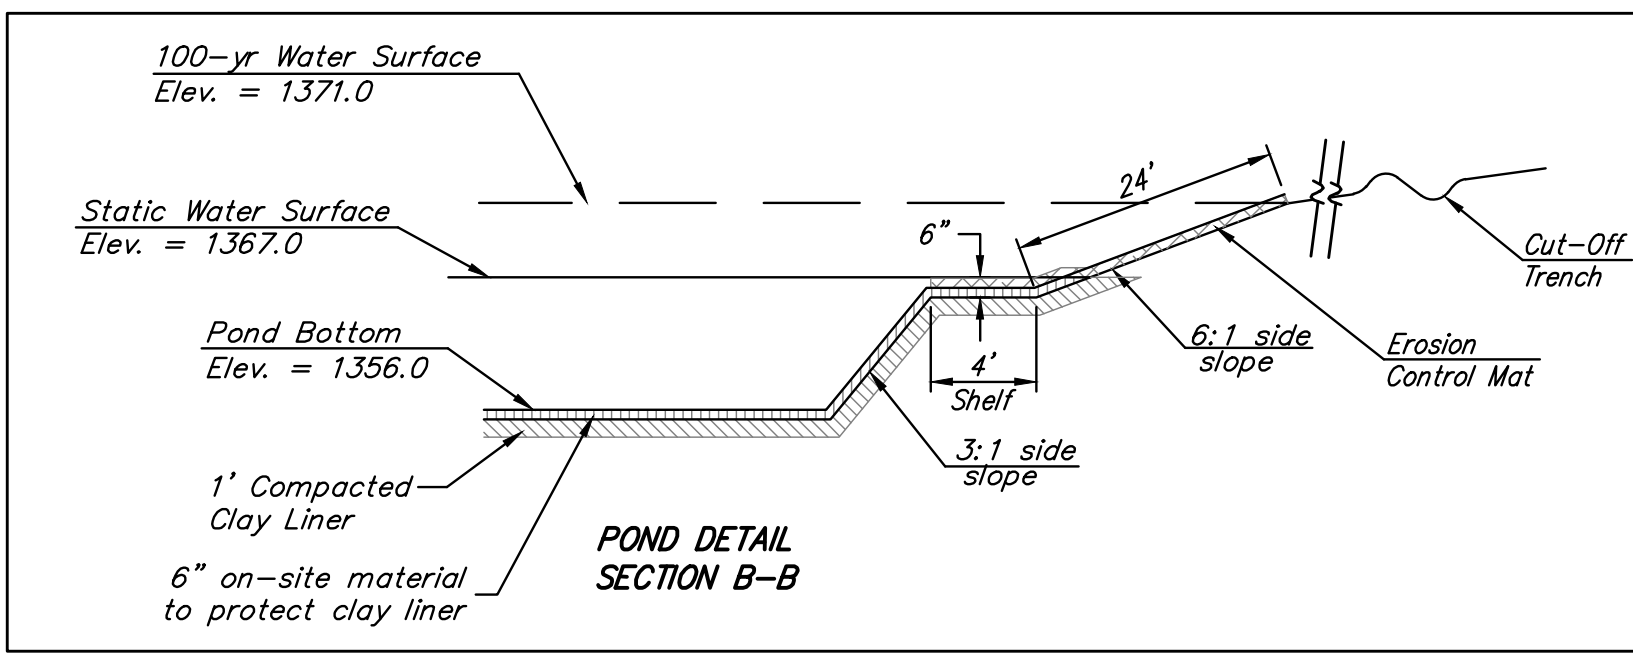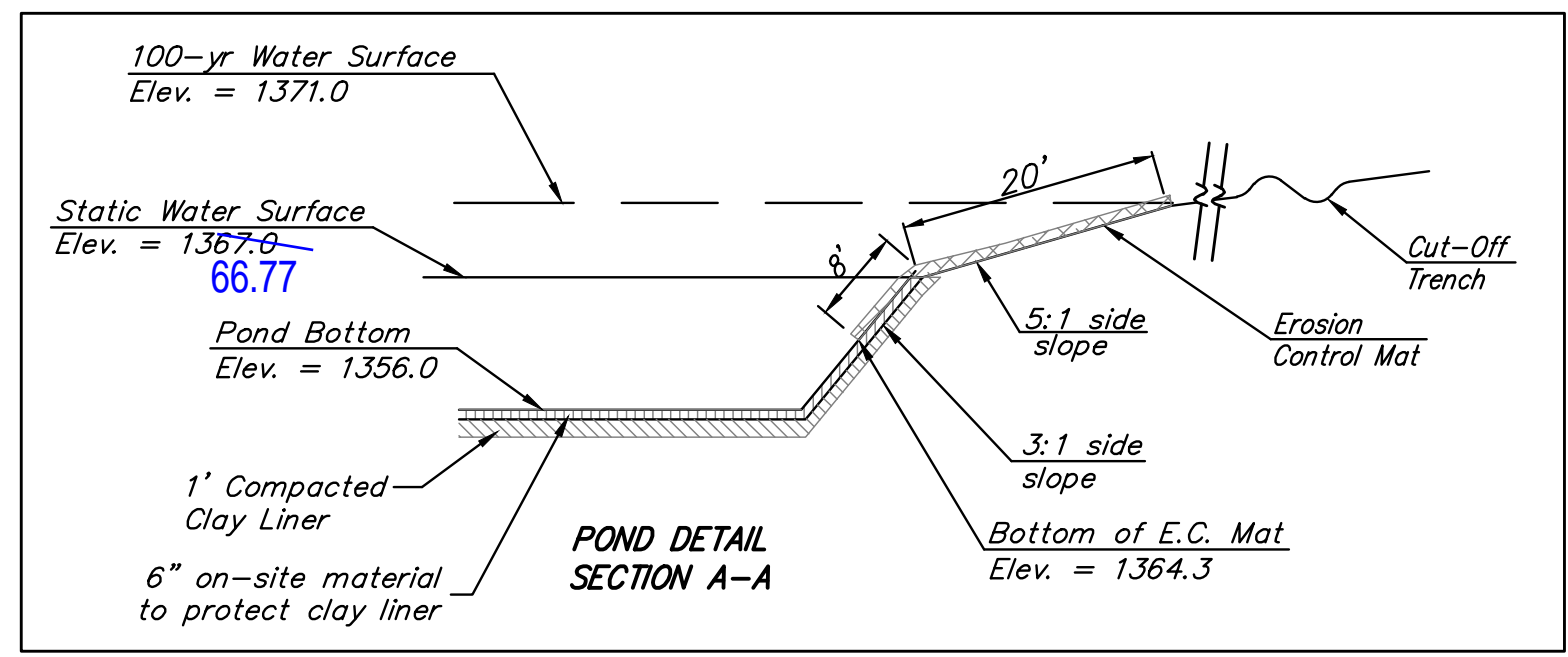


Baughman Brookfield Addition - Phase I
POND PLAN
 Storm Water Drain Improvements

Baughman Company, P.A. 315 Ellis St. Wichita, KS 67211 P 316-262-7271 F 316-262-0149
 ENGINEERING | SURVEYING | PLANNING | LANDSCAPE ARCHITECTURE

PROJECT NUMBER 468-85177	DESIGN AEG	DRAWN JAK
REVISIONS:	APPROVED	DATE 6/30/17
SCALE Noted		SHEET 10 OF 26

E:\Projects\Brookfield Addition_1664F190\Engineering\Phase I\SWD_1668E543\SWD PLANS.dwg

BENCHMARKS:
 RR spike in asphalt, SW COR., N1/2, SW1/4, Sec. 34, TWP. 26-S, R-2-E. Elev. = 1400.59 NAVD88
 RR spike in E. face of power pole, 174± N. of S. line, N1/2, SW1/4 & 49± E. of W. line, SW1/4, Sec. 34, TWP. 26-S, R-2-E. Elev. = 1398.64 NAVD88
 RR spike in S. face of power pole, 294± S. of N. line, SW1/4, & 48± E. of W. line, SW1/4, Sec. 34, TWP. 26-S, R-2-E. Elev. = 1386.14 NAVD88

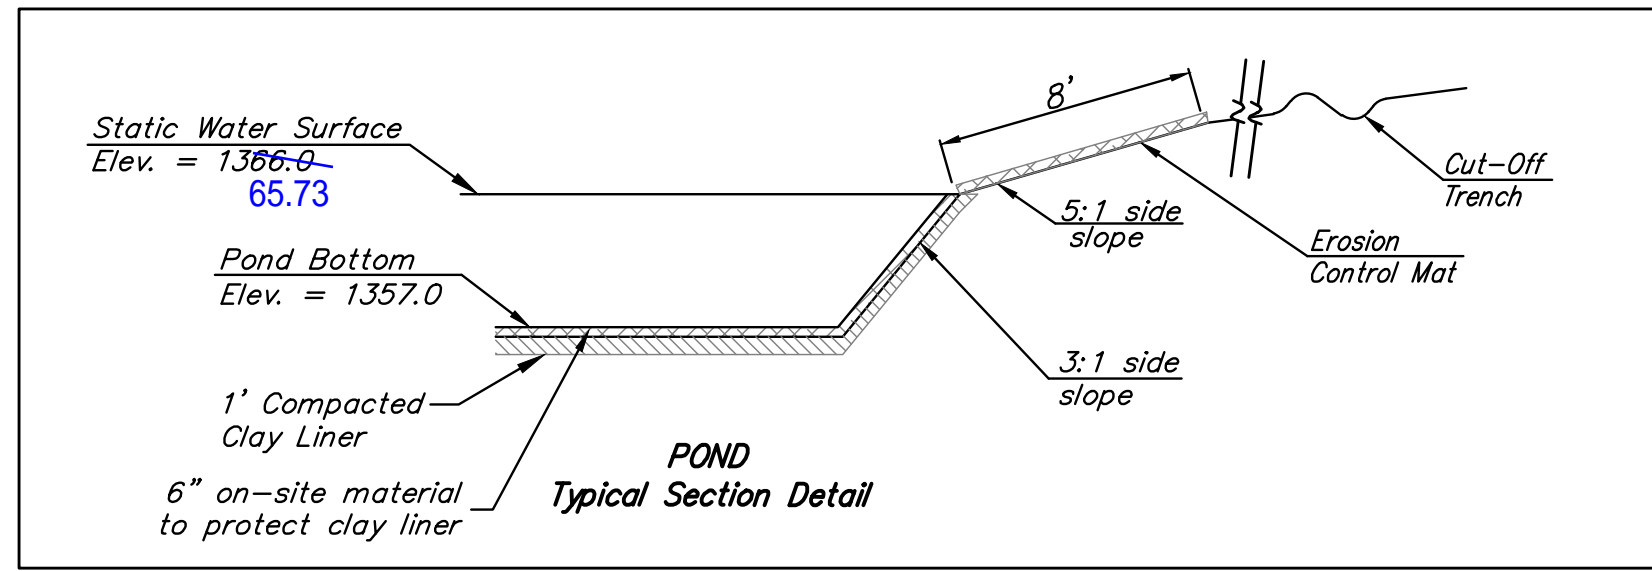

EARTH WORK TOTALS (Unadjusted)
(for information only)

	C.Y. Cut	C.Y. Fill
Mass Grading	25,433	199,422
Res. "H" Pond	106,155	0
Res. "J" Pond	84,669	0
Total Earthwork	216,257	199,422


Earthwork quantities are for reference only. All cost associated with earthwork shall be included in C.Y. "Unclassified Excavation" & L.S. "Earthwork"

Pond Liner Bentonite Treatment (For Information Only)

Res. "H"
 Treatment Area ~ 192,200 sq. ft.
 Bentonite ~ 211 tons spread at 2.2 lbs/sq. ft.

Res. "J" - (to be bid as add alternate)
 Treatment Area ~ 334,400 sq. ft.
 Bentonite ~ 368 tons spread at 2.2 lbs/sq. ft.
 (The treatment areas have been increased by 5% to account for the pond sideslopes.)


- POND NOTES:**
- Pond bottom and sideslopes below static pool elevation shall be over-excavated 18" and a 1' clay liner shall be compacted to 95% std. density. The top 6" of the clay liner shall be modified with Wyoming Bentonite Clay at a rate of 4%. An additional 6" of on-site material shall be placed over liner. The plasticity index (P.I.) shall be at least 27. The compaction and P.I. shall be verified during construction. P.I. determination and compaction testing shall be arranged by the contractor at the request of the inspector. Cost shall be incidental to "Testing". Cost of over-excavation to install Clay Liner shall be incidental to bid item "Unclassified Excavation"
 - All of 37th St. N. R/W, Res. "H", and Res. "J" above the static water surface disturbed by construction shall be seeded and mulched as follows:
 (Permanent Seeding)
SEED -- Kansas Premium Fescue Blend; 8#/1000 Sq. Ft.
 Rye grass (PLS); 3#/1000 Sq. Ft. and
FERTILIZER -- 12-24-12 Ratio at 350 Lbs./Ac.
MULCH -- 2 Tons Prairie Hay / Acre
 All other disturbed areas not in street R/W are to be seeded as follows: (Temporary Seeding)
SEED -- Rye grass (PLS)--5#/1000 Sq. Ft.
 All costs associated with seeding including perpetration of ground, seeding, fertilizing, mulching, etc. shall be including in the L.S. bid item "Seeding and Erosion Control"
 - Install Biodegradable Erosion Control Mat (North American Green Bionet S150BN or approved equal) around pond as indicated (cost to be including in "BMP, Erosion Control Mat."
 - Contractor to strip top 3" of soil within Reserve "H" and street R/W before mass grading and stockpile. Topsoil stockpile to be redistributed over Reserve "H" above water elevation prior to seeding (incidental to C.Y. "Unclassified Excavation").
 - Compaction of 95% shall be obtained in all street R/W's, 90% in all other areas.
 - Earthwork Quantities reflect the best available topography at time of design. The Contractor shall satisfy himself with the Earthwork Quantities associated with Bid Item "Unclassified Excavation" prior to bidding. No additional payments or change orders for earthwork will be accepted.

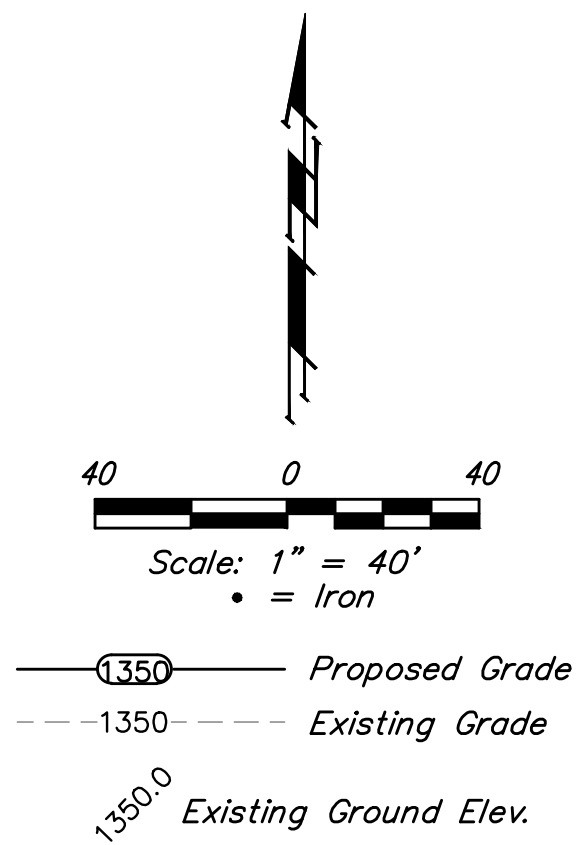

EROSION CONTROL LEGEND

- STRAW BALE BARRIERS
- SILT FENCING
- EROSION CONTROL MAT (North American Green Bionet S150BN, or approved equal)

NOTE: - EROSION CONTROL MAT SHALL BE BIODEGRADABLE

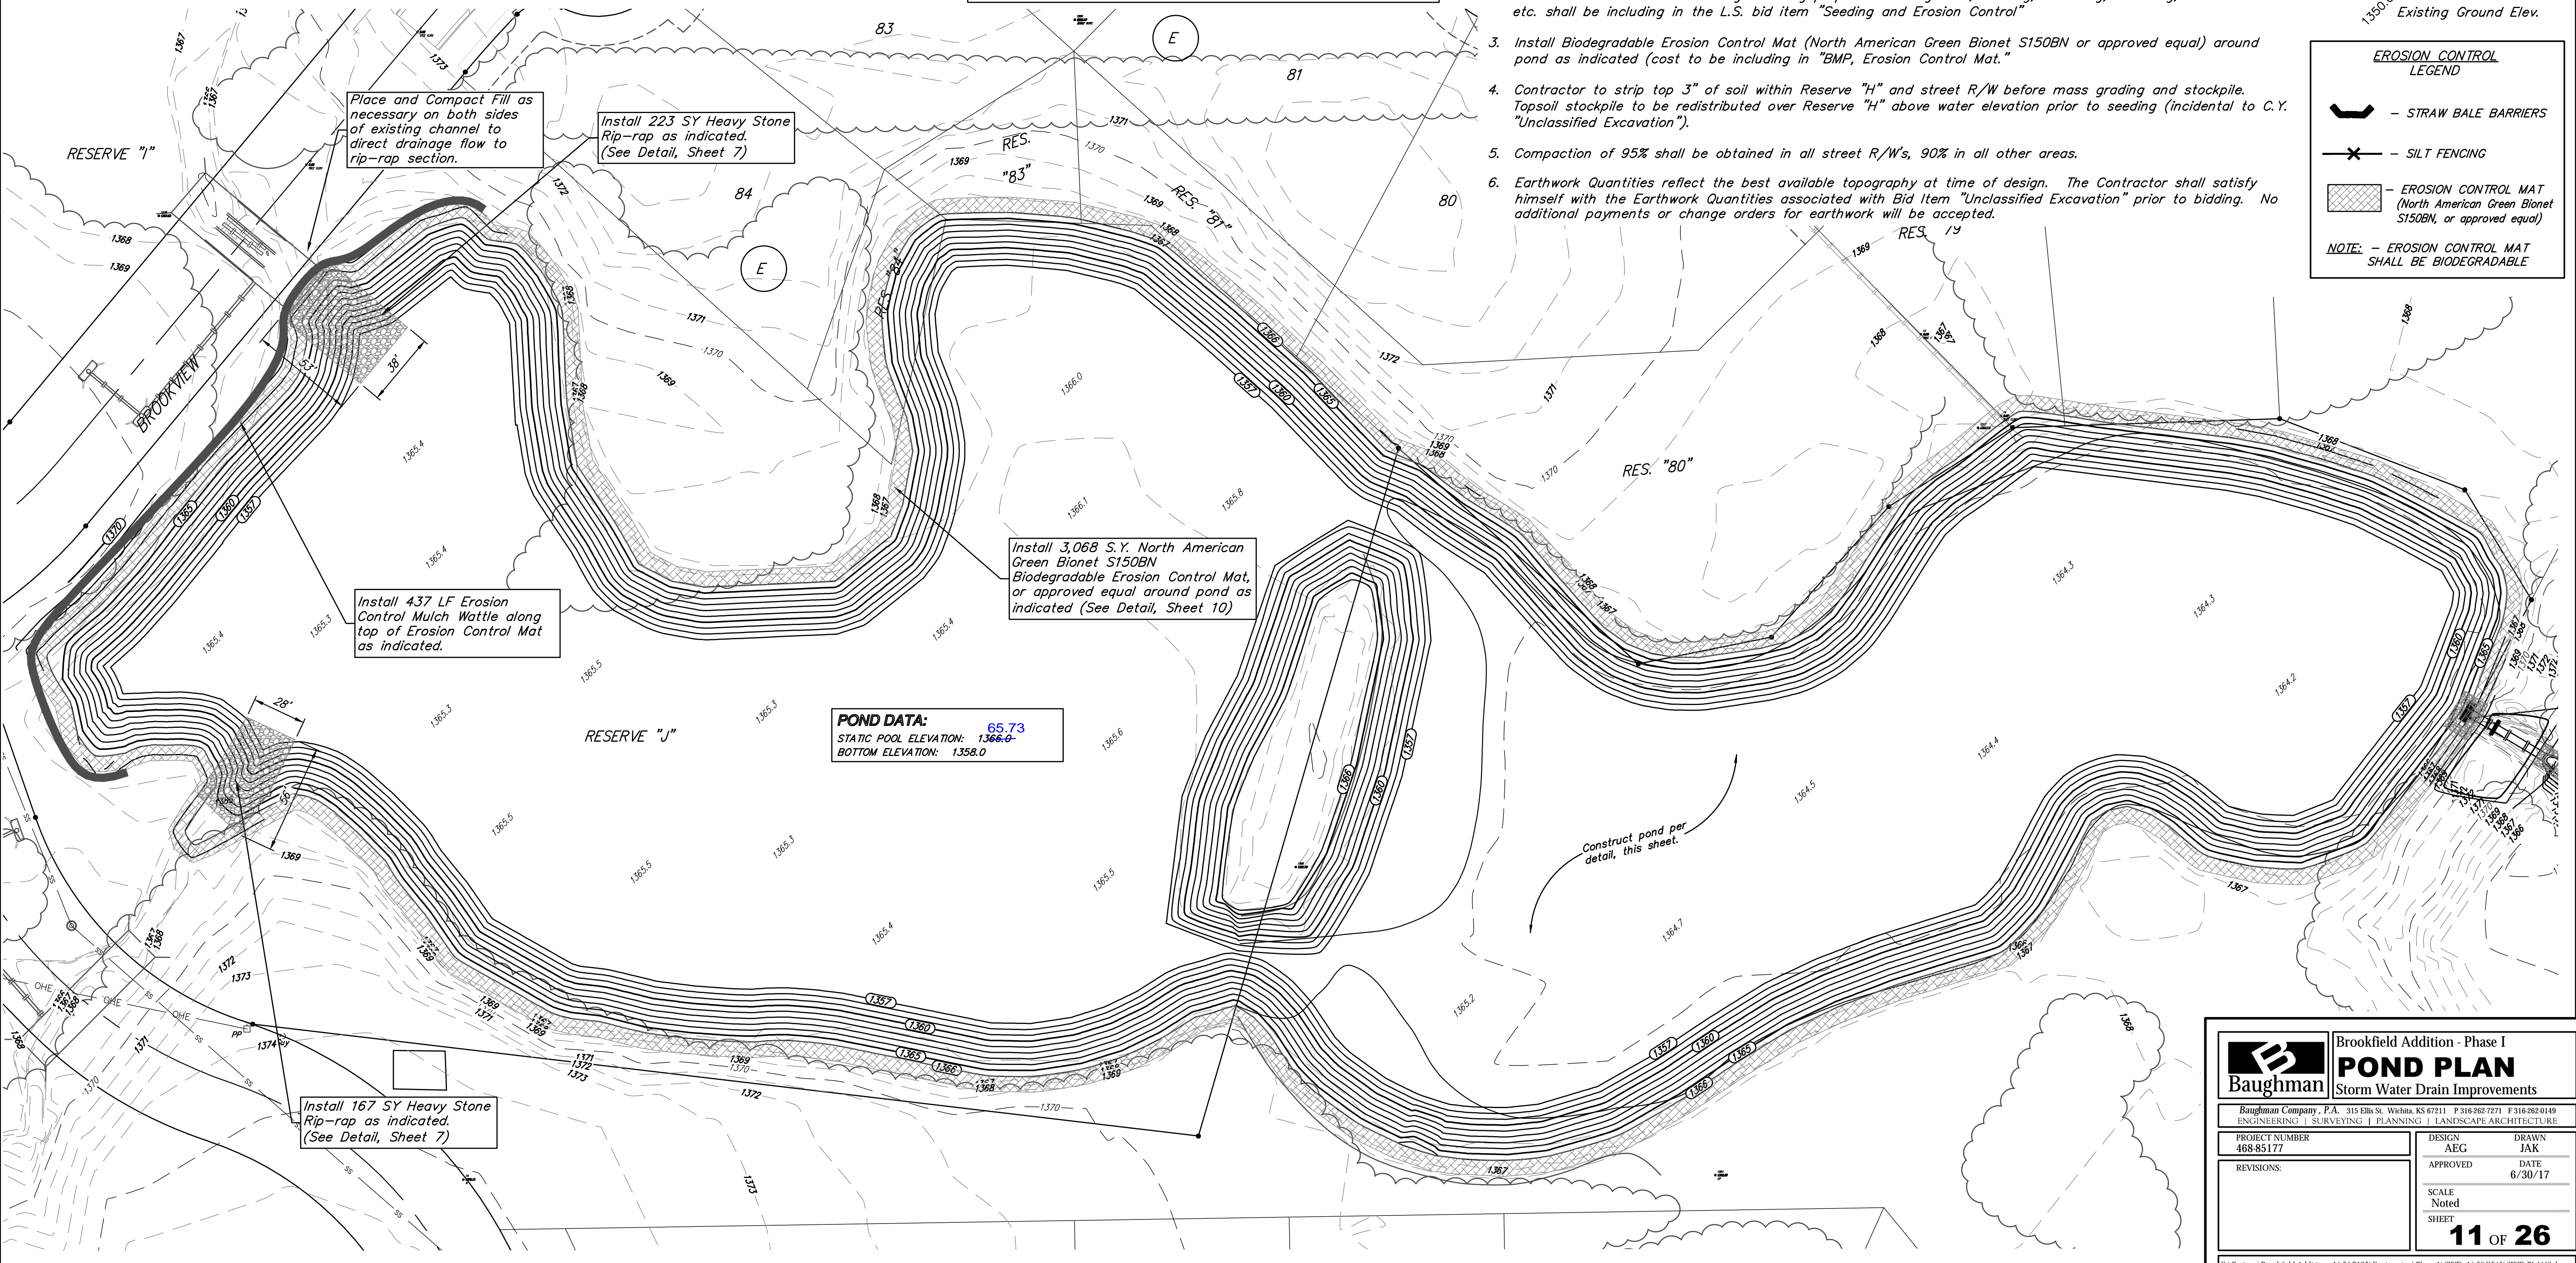

POND DATA:
 STATIC POOL ELEVATION: 1366.0
 BOTTOM ELEVATION: 1358.0

Baughman Brookfield Addition - Phase I
POND PLAN
 Storm Water Drain Improvements


Baughman Company, P.A. 315 Ellis St. Wichita, KS 67211 P 316-262-7271 F 316-262-0149
 ENGINEERING | SURVEYING | PLANNING | LANDSCAPE ARCHITECTURE

PROJECT NUMBER 468-85177	DESIGN AEG	DRAWN JAK
REVISIONS:	APPROVED	DATE 6/30/17
	SCALE Noted	SHEET 11 OF 26

E:\Projects\Brookfield Addition - 1664F190\Engineering\Phase I\SWD - 1668E543\SWD PLANS.dwg


TYPICAL MASS GRADING DETAIL

STREET R/W GRADING

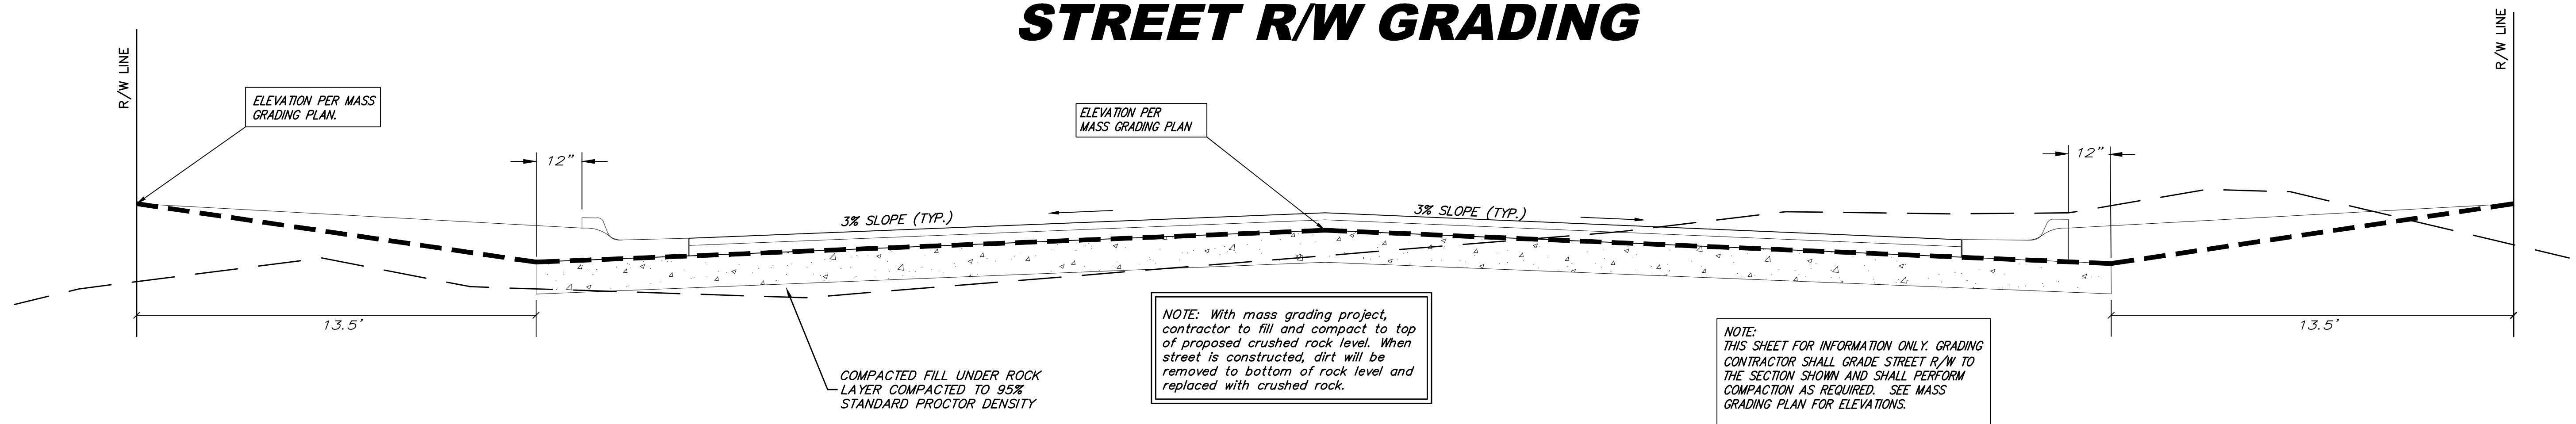


LOT FILL GRADING

INTERIOR PLATTED LOT SECTION

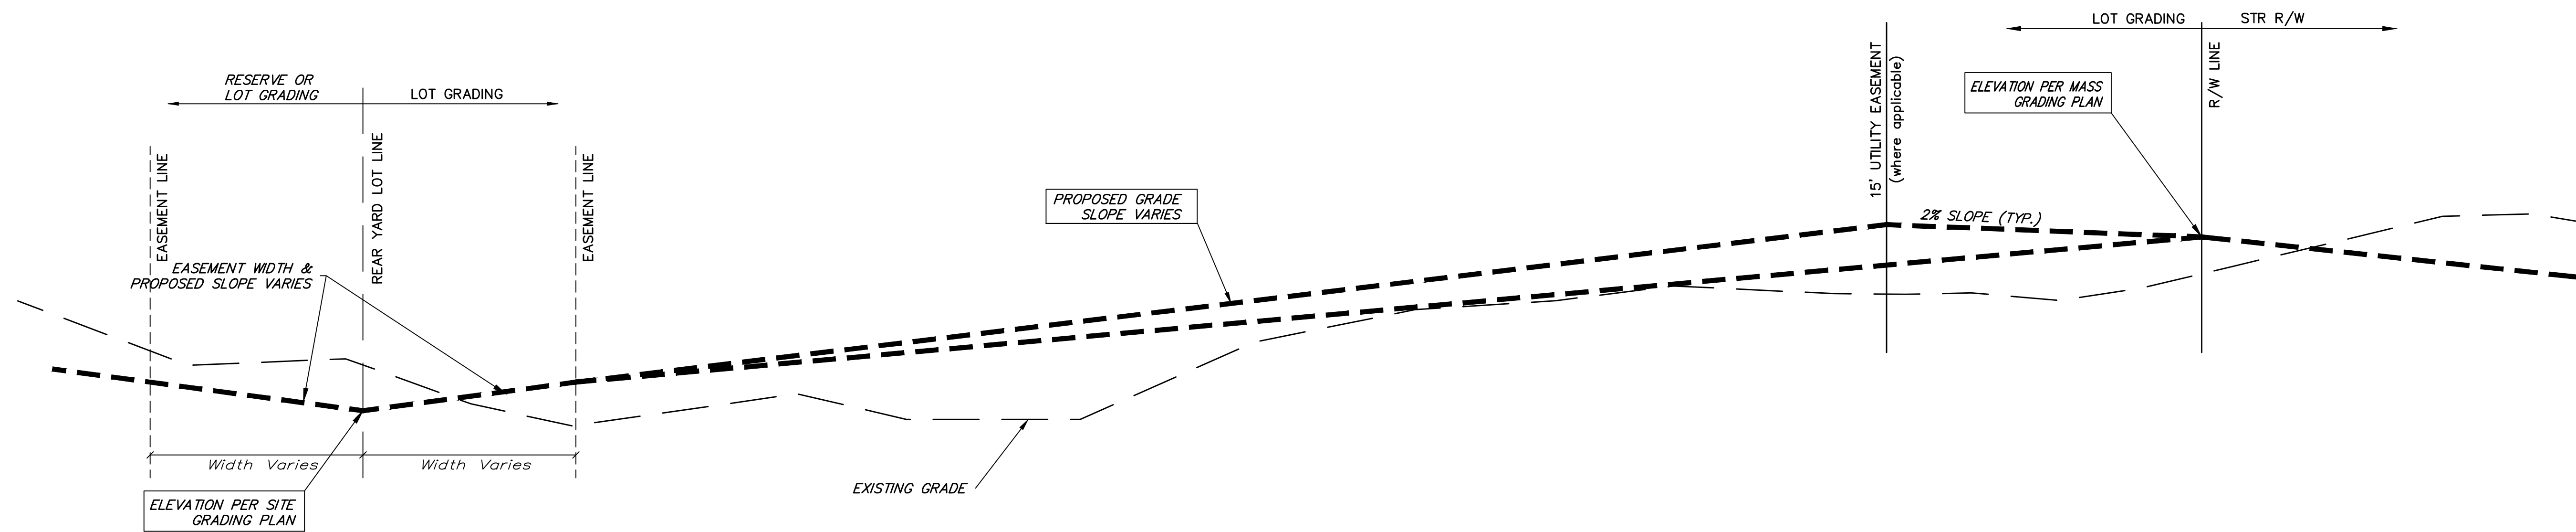

EXTERIOR PLATTED LOT SECTION

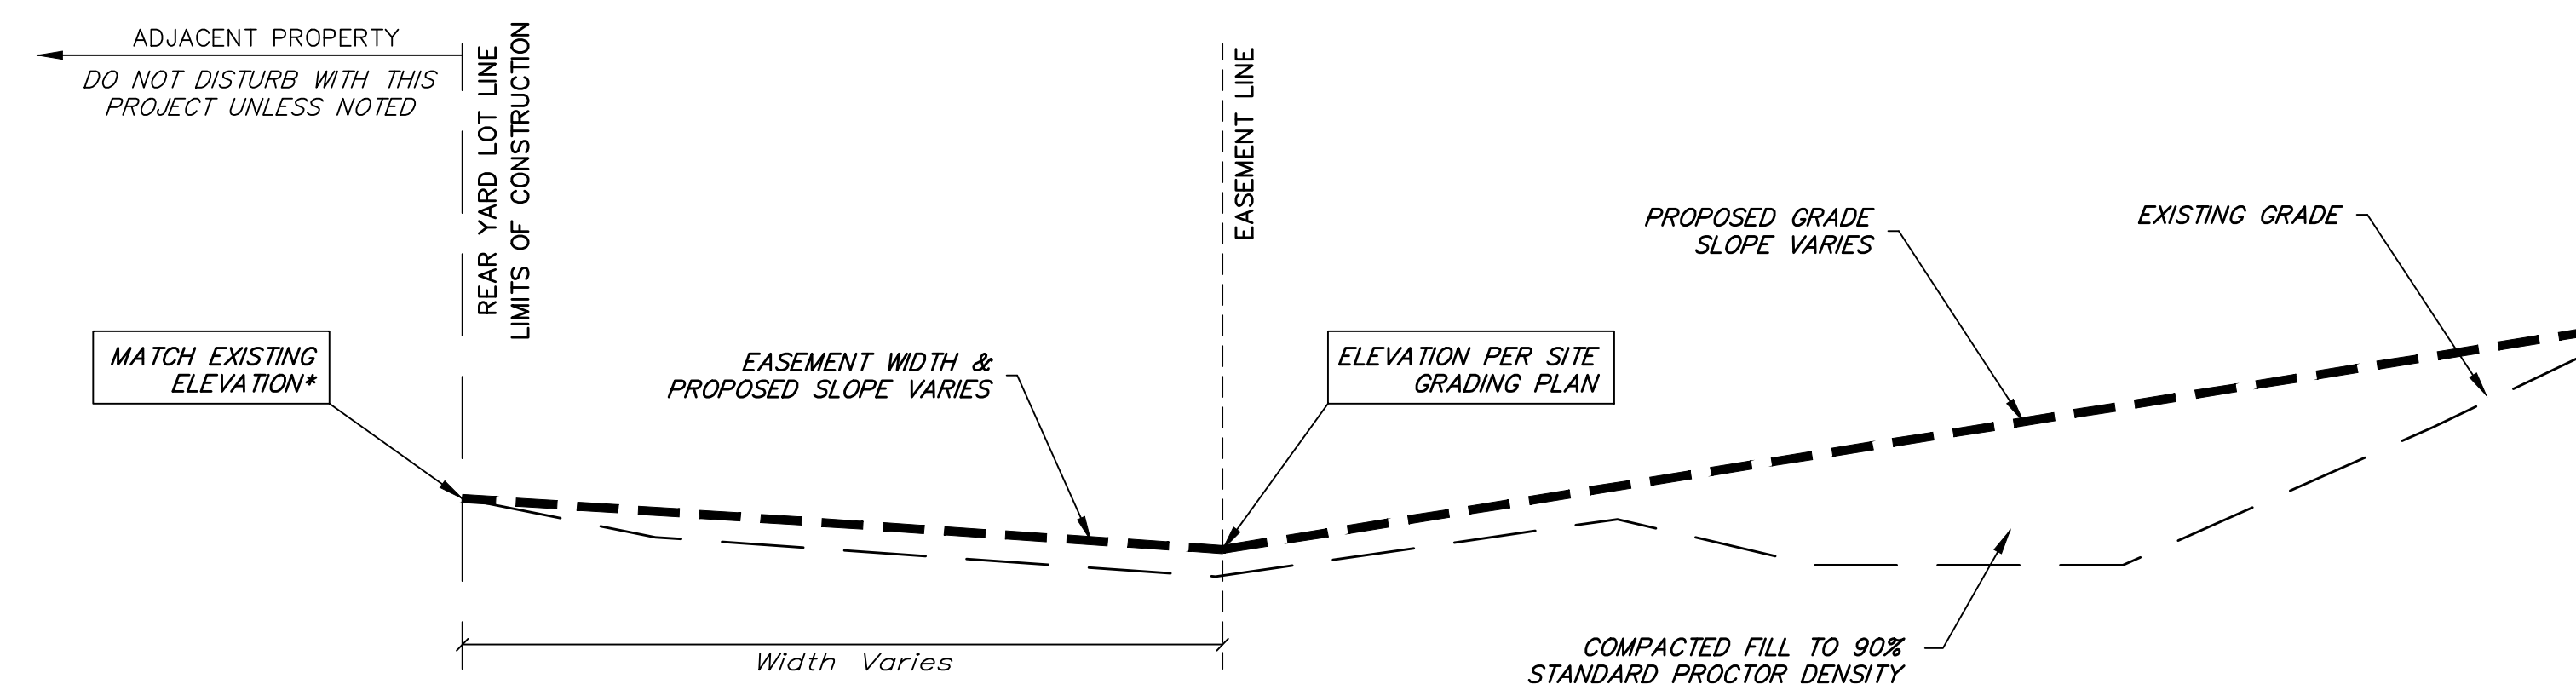



		Brookfield Addition - Phase I MASS GRADING TYPICAL SECTION	
		Baughman Company, P.A. 315 Ellis St. Wichita, KS 67211 P 316-262-7271 F 316-262-0149 ENGINEERING SURVEYING PLANNING LANDSCAPE ARCHITECTURE	
PROJECT NUMBER	DESIGN	AEG	DRAWN
REVISIONS:	APPROVED	DATE	JAK
	SCALE	Noted	6/17
	SHEET	17 OF 26	

BENCHMARKS:
 RR spike in asphalt, SW COR., N1/2, SW1/4, Sec. 34, TWP. 26-S, R-2-E. Elev. = 1400.59 NAVD88

RR spike in E. face of power pole, 174± N. of S. line, N1/2, SW1/4 & 49± E. of W. line, SW1/4, Sec. 34, TWP. 26-S, R-2-E. Elev. = 1398.64 NAVD88

RR spike in S. face of power pole, 294± S. of N. line, SW1/4, & 48± E. of W. line, SW1/4, Sec. 34, TWP. 26-S, R-2-E. Elev. = 1386.14 NAVD88

COORDINATE POINTS			
Point #	Northing	Easting	Description
7001	1708466.63	1687148.33	End Sec
7002	1708518.94	1687049.72	1/5 FC
7003	1708465.46	1687433.95	End Sec
7004	1708513.32	1687491.27	MH
7005	1708275.06	1687814.41	End Sec
7006	1708325.14	1687837.51	MH
7007	1708203.44	1688121.43	End Sec
7008	1708280.51	1688178.58	MH
7009	1708124.16	1687453.65	End Sec
7010	1708926.22	1687349.22	1/5 FC
7011	1709091.85	1687880.41	CEN INLET
7012	1708917.26	1687889.68	1/5 FC
7013	1708884.25	1687916.05	1/5 FC
7014	1708637.24	1687925.24	MH
7015	1708565.52	1687961.32	End Sec
7016	1708290.86	1687479.90	End Sec
7017	1708317.95	1687434.06	CEN INLET

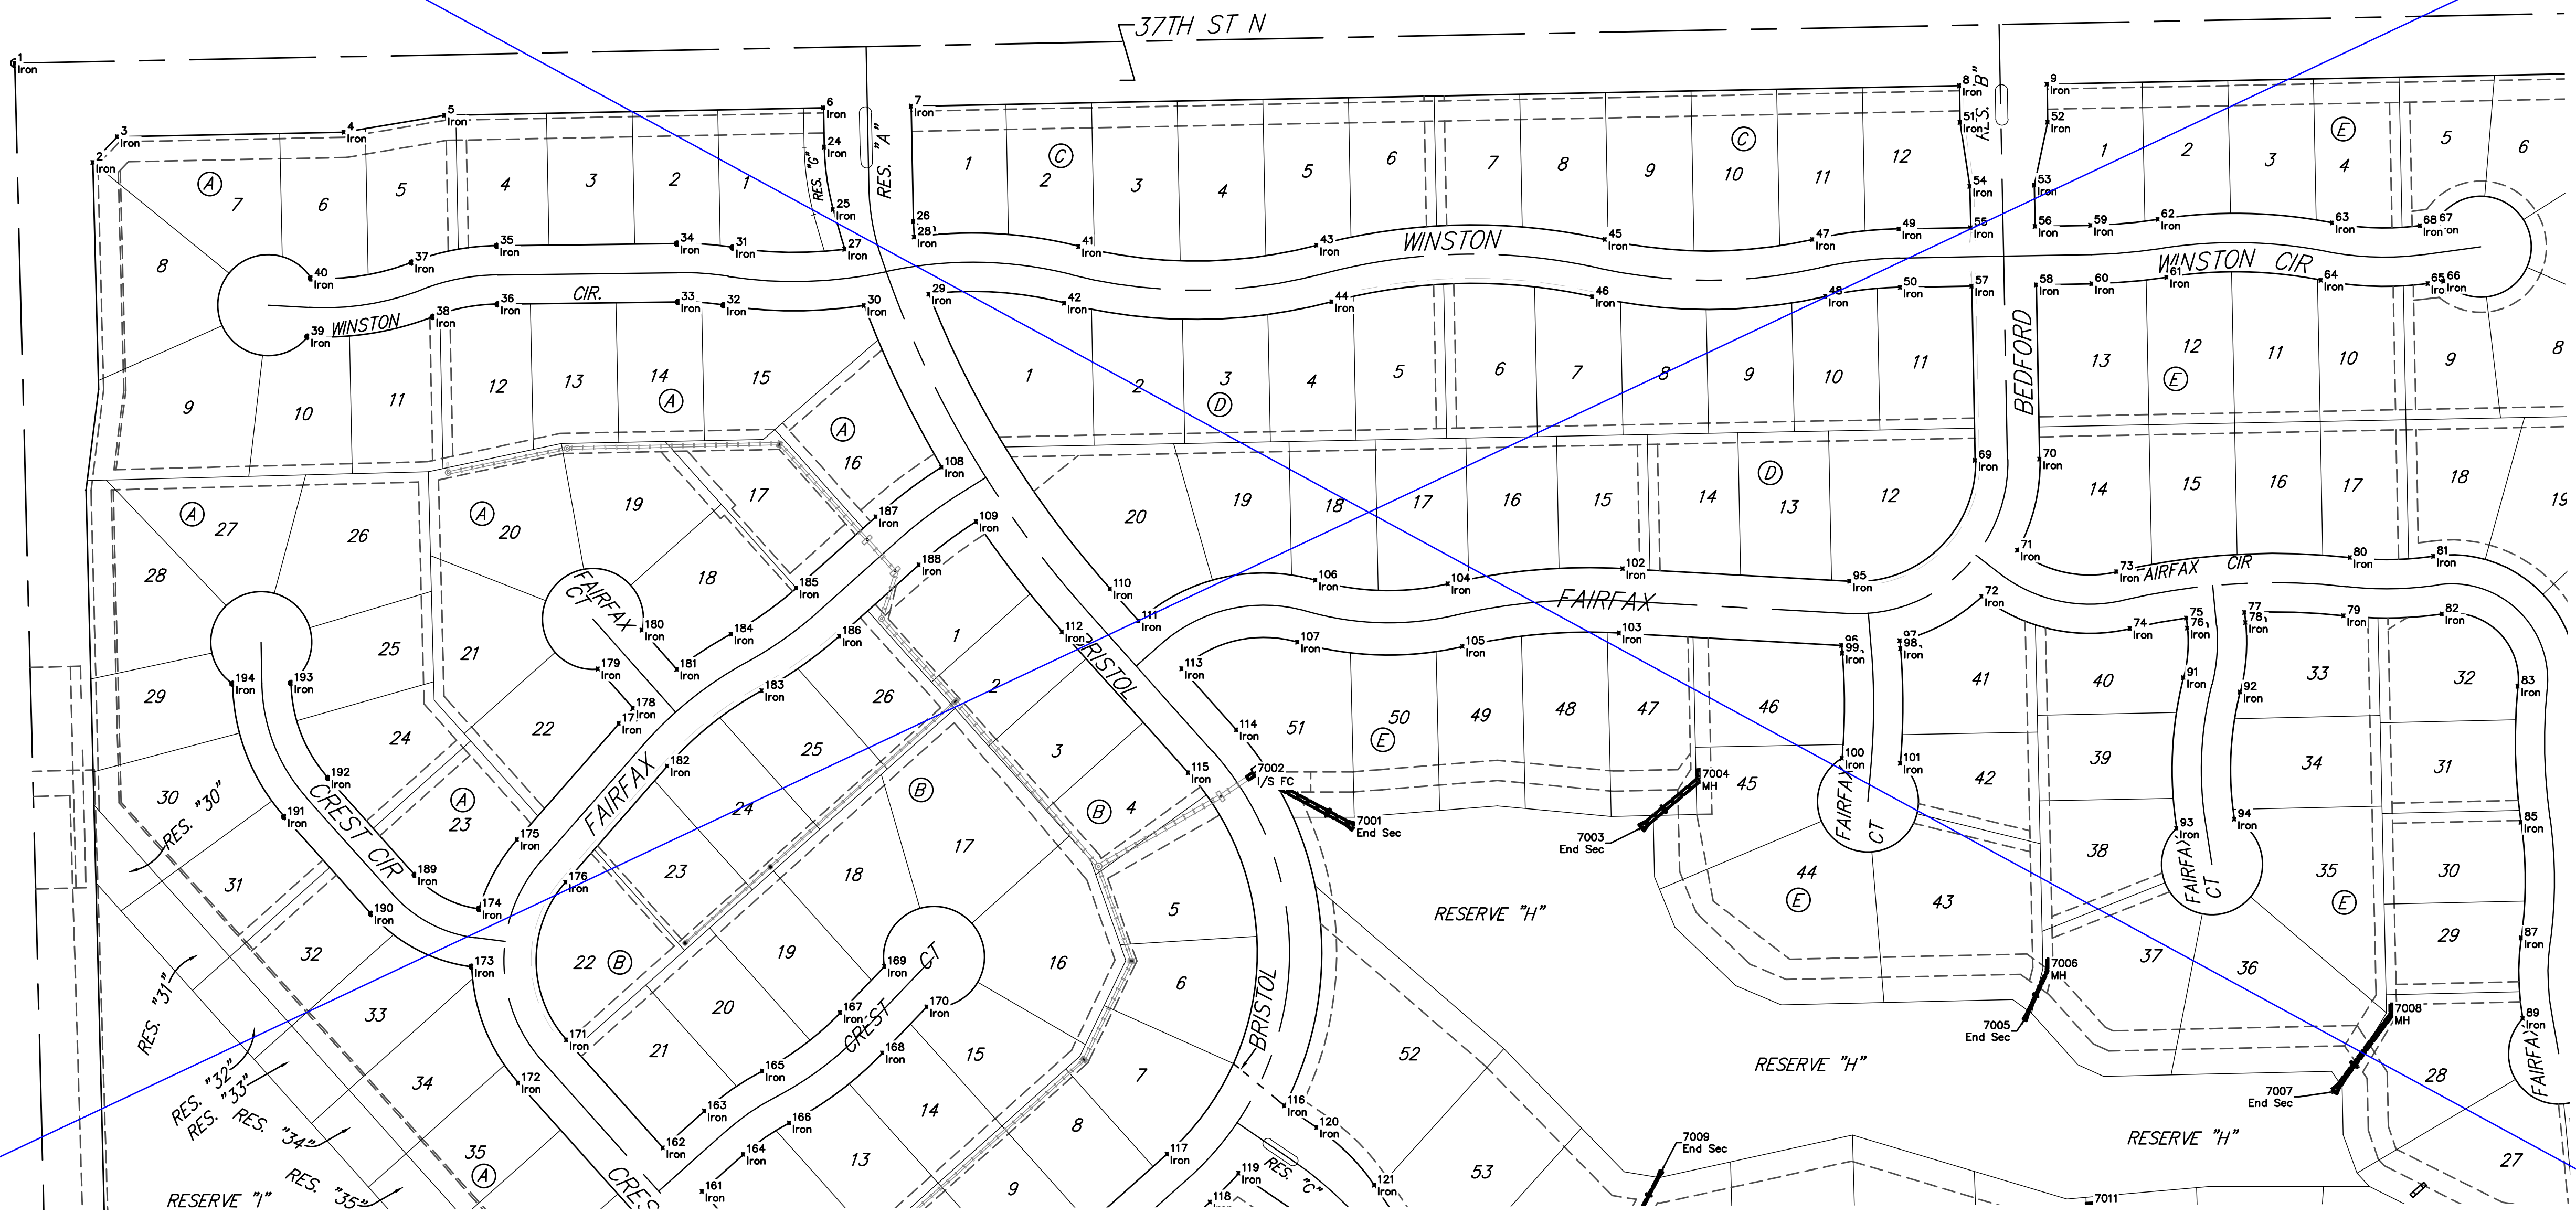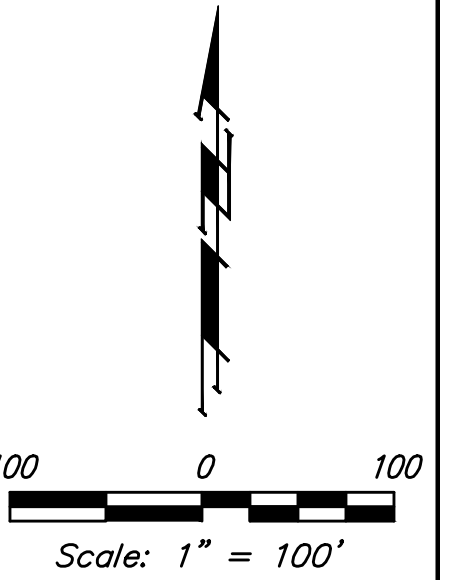

VOID - SEE SHEET 23R



	Brookfield Addition - Phase I COORDINATES Storm Water Drain Improvements	
	<small>Baughman Company, P.A. 315 Ellis St. Wichita, KS 67211 P 316-262-7271 F 316-262-0149 ENGINEERING SURVEYING PLANNING LANDSCAPE ARCHITECTURE</small>	
PROJECT NUMBER 468-85177	DESIGN AEG	DRAWN JAK
REVISIONS:	APPROVED DATE 6/30/17	SCALE Noted
		23 OF 26

BENCHMARKS:
 RR spike in asphalt, SW COR., N1/2,
 SW1/4, Sec. 34, TWP. 26-S, R-2-E.
 Elev. = 1400.59 NAVD88

RR spike in E. face of power pole,
 174± N. of S. line, N1/2, SW1/4 &
 49± E. of W. line, SW1/4,
 Sec. 34, TWP. 26-S, R-2-E.
 Elev. = 1398.64 NAVD88

RR spike in S. face of power pole,
 294± S. of N. line, SW1/4, &
 48± E. of W. line, SW1/4,
 Sec. 34, TWP. 26-S, R-2-E.
 Elev. = 1386.14 NAVD88

COORDINATE POINTS			
Point #	Northing	Easting	Description
7001	1708466.63	1687148.33	End Sec
7002	1708518.94	1687049.72	1/5 FC
7003	1708306.73	1687527.61	End Sec
7004	1708339.41	1687550.78	END PIPE
7005	1708274.50	1687808.88	End Sec
7006	1708313.66	1687836.72	MH
7007	1708204.30	1688156.14	End Sec
7008	1708270.24	1688155.05	END PIPE
7009	1708124.16	1687453.65	End Sec
7010	1708926.22	1687349.22	1/5 FC
7011	1708091.85	1687880.41	CEN INLET
7012	1708917.26	1687889.68	1/5 FC
7013	1708884.25	1687916.05	1/5 FC
7014	1708637.24	1687925.24	MH
7015	1708666.62	1687901.32	End Sec
7016	1708290.86	1687479.90	End Sec
7017	1708317.95	1687434.06	CEN INLET
7018	1708186.68	1688196.43	End Sec
7019	1708204.81	1688245.29	END PIPE

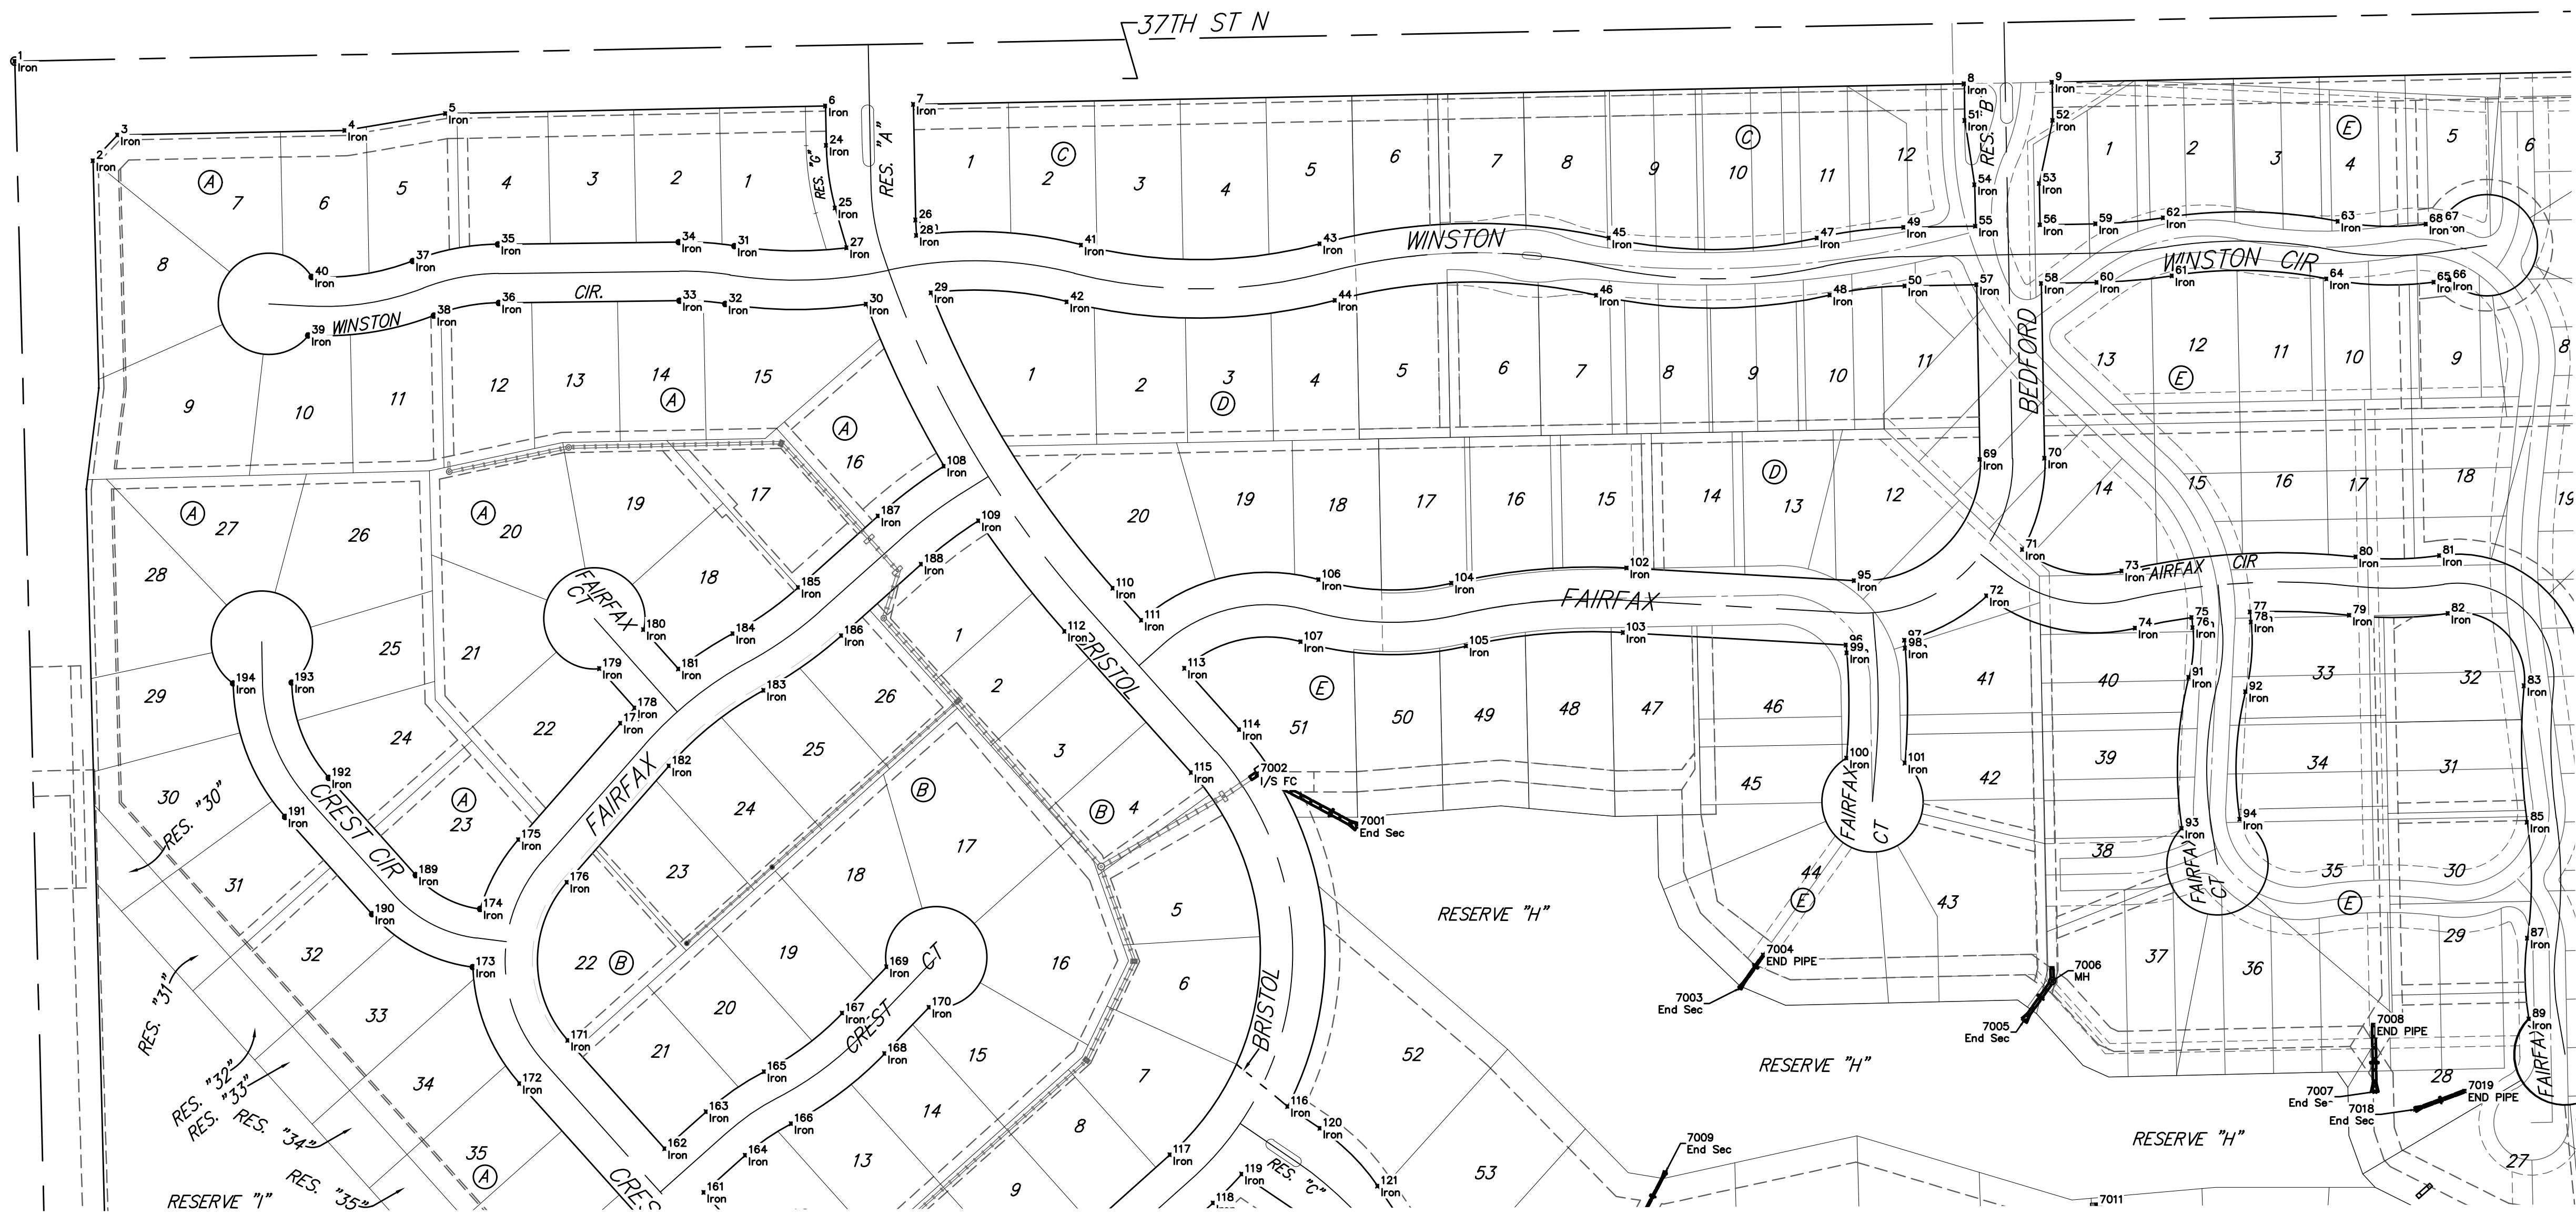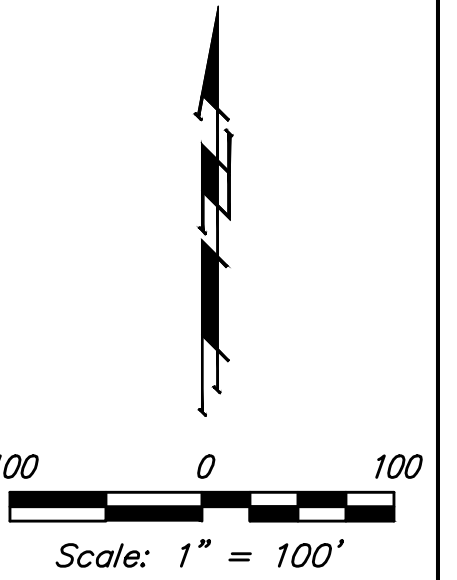

	Brookfield Addition - Phase I COORDINATES Storm Water Drain Improvements	
	<small>Baughman Company, P.A. 315 Ellis St. Wichita, KS 67211 P 316-262-7271 F 316-262-0149 ENGINEERING SURVEYING PLANNING LANDSCAPE ARCHITECTURE</small>	
PROJECT NUMBER 468-85177	DESIGN AEG	DRAWN JAK
REVISIONS: JAK	APPROVED AEG	DATE 6/30/17
7/18/17	SCALE Noted	SHEET 23R OF 26


I:\Projects\Brookfield Addition_1604P190\Engineering\Phase I\SWD_1608E543\SWD PLANS.dwg

BENCHMARKS:
 RR spike in asphalt, SW COR., N1/2, SW1/4, Sec. 34, TWP. 26-S, R-2-E.
 Elev. = 1400.59 NAVD88

RR spike in E. face of power pole,
 174± N. of S. line, N1/2, SW1/4 &
 49± E. of W. line, SW1/4,
 Sec. 34, TWP. 26-S, R-2-E.
 Elev. = 1398.64 NAVD88

RR spike in S. face of power pole,
 294± S. of N. line, SW1/4, &
 48± E. of W. line, SW1/4,
 Sec. 34, TWP. 26-S, R-2-E.
 Elev. = 1386.14 NAVD88

COORDINATE POINTS				COORDINATE POINTS				COORDINATE POINTS			
Point #	Northing	Easting	Description	Point #	Northing	Easting	Description	Point #	Northing	Easting	Description
1	1710224.38	1685819.67	Iron	71	1709740.93	1687807.27	Iron	141	1708853.87	1688246.77	Iron
2	1710125.87	1685893.20	Iron	72	1709695.04	1687771.79	Iron	142	1708781.60	1688237.28	Iron
3	1710151.35	1685921.56	Iron	73	1709719.62	1687905.73	Iron	143	1708945.64	1686744.27	Iron
4	1710153.73	1686146.52	Iron	74	1709663.17	1687919.07	Iron	144	1708918.08	1686809.45	Iron
5	1710172.68	1686246.20	Iron	75	1709673.70	1687974.93	Iron	145	1708866.33	1686747.13	Iron
6	1710180.00	1686262.34	Iron	76	1709663.74	1687975.87	Iron	146	1708832.81	1686775.72	Iron
7	1710181.69	1686709.32	Iron	77	1709679.12	1688032.68	Iron	147	1708885.36	1686837.35	Iron
8	1710201.95	1687749.63	Iron	78	1709669.17	1688033.61	Iron	148	1708847.94	1686855.01	Iron
9	1710203.64	1687836.61	Iron	79	1709675.94	1688131.06	Iron	149	1708808.60	1686812.40	Iron
10	1710276.41	1688491.69	Iron	80	1709733.58	1688137.52	Iron	150	1708749.89	1686891.88	Iron
11	1710216.42	1688493.01	Iron	81	1709735.01	1688220.16	Iron	151	1708731.01	16868910.66	Iron
12	1708434.40	1688532.32	Iron	82	1709677.63	1688228.63	Iron	152	1708766.75	1686939.86	Iron
13	1708314.79	1687434.98	Iron	83	1709606.06	1688303.96	Iron	153	1708723.63	1686901.07	Iron
14	1708375.36	1687466.71	Iron	84	1709600.55	1688361.70	Iron	154	1708814.43	1686848.00	Iron
15	1708431.69	1687432.50	Iron	85	1709471.00	1688306.89	Iron	155	1708862.69	1686596.15	Iron
16	1708468.12	1687337.71	Iron	86	1709478.01	1688364.33	Iron	156	1708833.33	1686588.56	Iron
17	1708463.53	1687202.91	Iron	87	1709356.24	1688307.11	Iron	157	1708905.42	1686648.63	Iron
18	1708423.09	1687137.52	Iron	88	1709348.44	1688364.58	Iron	158	1708886.85	1686655.46	Iron
19	1708356.21	1687077.37	Iron	89	1709276.17	1688308.79	Iron	159	1709012.21	1686594.45	Iron
20	1708342.53	1687009.18	Iron	90	1709286.37	1688365.88	Iron	160	1708969.53	1686536.76	Iron
21	1708452.99	1686886.36	Iron	91	1709614.43	1687972.08	Iron	161	1709104.48	1686501.89	Iron
22	1708327.13	1685927.82	Iron	92	1709600.26	1688028.33	Iron	162	1709147.71	1686463.21	Iron
23	1708413.61	1685925.62	Iron	93	1709465.01	1687965.29	Iron	163	1709184.38	1686504.20	Iron
24	1710141.15	1686623.10	Iron	94	1709474.02	1688022.59	Iron	164	1709141.16	1686542.87	Iron
25	1710079.18	1686631.93	Iron	95	1709710.07	1687640.79	Iron	165	1709224.06	1686561.64	Iron
26	1710067.22	1686711.55	Iron	96	1709646.42	1687632.83	Iron	166	1709172.58	1686588.37	Iron
27	1710039.71	1686664.43	Iron	97	1709651.10	1687690.64	Iron	167	1709282.02	1686639.00	Iron
28	1710051.74	1686712.48	Iron	98	1709643.31	1687691.26	Iron	168	1709241.91	1686680.89	Iron
29	1709995.10	1686726.94	Iron	99	1709638.68	1687633.45	Iron	169	1709327.86	1686682.89	Iron
30	1709983.85	1686662.70	Iron	100	1709534.39	1687633.28	Iron	170	1709287.74	1686724.78	Iron
31	1710041.37	1686532.22	Iron	101	1709529.57	1687691.08	Iron	171	1709255.02	1686367.19	Iron
32	1709984.06	1686523.25	Iron	102	1709722.68	1687415.67	Iron	172	1709212.35	1686319.50	Iron
33	1709987.30	1686477.84	Iron	103	1709558.78	1687412.09	Iron	173	1709327.60	1686273.23	Iron
34	1710045.30	1686477.10	Iron	104	1709707.66	1687242.19	Iron	174	1709385.13	1686280.55	Iron
35	1710043.00	1686298.19	Iron	105	1709645.33	1687256.69	Iron	175	1709453.79	1686318.37	Iron
36	1709985.01	1686298.94	Iron	106	1709711.10	1687110.71	Iron	176	1709411.56	1686366.46	Iron
37	1710026.60	1686213.67	Iron	107	1709649.60	1687092.97	Iron	177	1709568.84	1686419.39	Iron
38	1709972.54	1686234.68	Iron	108	1709823.40	1686739.62	Iron	178	1709584.09	1686433.50	Iron
39	1709952.90	1686110.33	Iron	109	1709769.33	1686773.86	Iron	179	1709623.06	1686398.77	Iron
40	1710010.80	1686113.64	Iron	110	1709702.65	1686906.88	Iron	180	1709661.65	1686442.08	Iron
41	1710042.43	1686875.70	Iron	111	1709671.01	1686935.20	Iron	181	1709622.68	1686478.80	Iron
42	1709986.21	1686861.45	Iron	112	1709659.98	1686859.19	Iron	182	1709526.61	1686467.49	Iron
43	1710043.68	1687111.90	Iron	113	1709623.32	1686877.87	Iron	183	1709601.55	1686561.24	Iron
44	1709987.61	1687126.74	Iron	114	1709562.76	1687032.06	Iron	184	1709657.77	1686530.65	Iron
45	1710049.25	1687398.10	Iron	115	1709520.08	1686984.36	Iron	185	1709703.41	1686595.38	Iron
46	1709992.64	1687385.46	Iron	116	1709189.64	1687079.94	Iron	186	1709655.72	1686638.08	Iron
47	1710049.39	1687604.10	Iron	117	1709141.65	1686963.34	Iron	187	1709774.09	1686674.37	Iron
48	1709992.80	1687616.82	Iron	118	1709093.96	1687006.02	Iron	188	1709726.39	1686717.05	Iron
49	1710059.76	1687689.85	Iron	119	1709122.65	1687034.40	Iron	189	1709418.63	1686716.77	Iron
50	1710001.77	1687690.98	Iron	120	1709168.02	1687111.74	Iron	190	1709379.96	1686733.55	Iron
51	1710165.70	1687750.33	Iron	121	1709110.68	1687168.96	Iron	191	1709476.23	1686807.41	Iron
52	1710165.79	1687837.35	Iron	122	1709070.69	1687110.84	Iron	192	1709514.91	16868130.63	Iron
53	1710103.38	1687824.06	Iron	123	1709028.22	1687155.19	Iron	193	1709609.21	1686803.87	Iron
54	1710102.13	1687760.07	Iron	124	1709074.77	1687193.25	Iron	194	1709608.44	1686835.88	Iron
55	1710061.14	1687760.87	Iron	125	1708988.72	1687279.34	Iron	195	1708748.79	1686821.37	Iron
56	1710062.38	1687824.86	Iron	126	1708940.67	1687246.85	Iron	196	1708727.05	1686854.17	Iron
57	1710003.15	1687762.00	Iron	127	1708942.55	1687347.63	Iron	197	1708678.90	1686857.50	Iron
58	1710004.40	1687825.99	Iron	128	1708894.50	1687315.14	Iron	198	1708675.31	1686843.89	Iron
59	1710063.46	1687879.85	Iron	129	1708897.73	1687529.40	Iron	199	1708645.70	1686808.32	Iron
60	1710005.47	1687880.98	Iron	130	1708840.08	1687535.82	Iron	200	1708686.76	1686839.22	Iron
61	1710011.94	1687855.56	Iron	131	1708803.76	1687583.57	Iron	201	1708466.44	1686174.99	Iron
62	1710069.26	1687946.68	Iron	132	1708822.02	1687600.46	Iron	202	1708413.12	1686213.83	Iron
63	1710065.77	1688119.66	Iron	133	1708832.97	1687698.82	Iron	203	1708429.72	1686131.81	Iron
64	1710008.86	1688108.48	Iron	134	1708818.87	1687719.31	Iron	204	1708362.21	1686153.87	Iron
65	1710006.68	1688214.63	Iron	135	1708823.84	1687763.90	Iron	205	1708330.02	1686041.74	Iron
66	1710007.80	1688230.32	Iron	136	1708866.20	1687770.32	Iron	206	1708412.28	1686048.00	Iron
67	1710065.27	1688222.56	Iron	137	1708824.52	1687985.37	Iron	207	1708415.22	1685989.19	Iron
68	1710063.16	1688206.87	Iron	138	1708866.84	1687979.31	Iron				
69	1709830.18	1687765.37	Iron	139	1708853.79	1688103.46	Iron				
70	1709831.43	1687829.35	Iron	140	1708911.47	1688109.52	Iron				

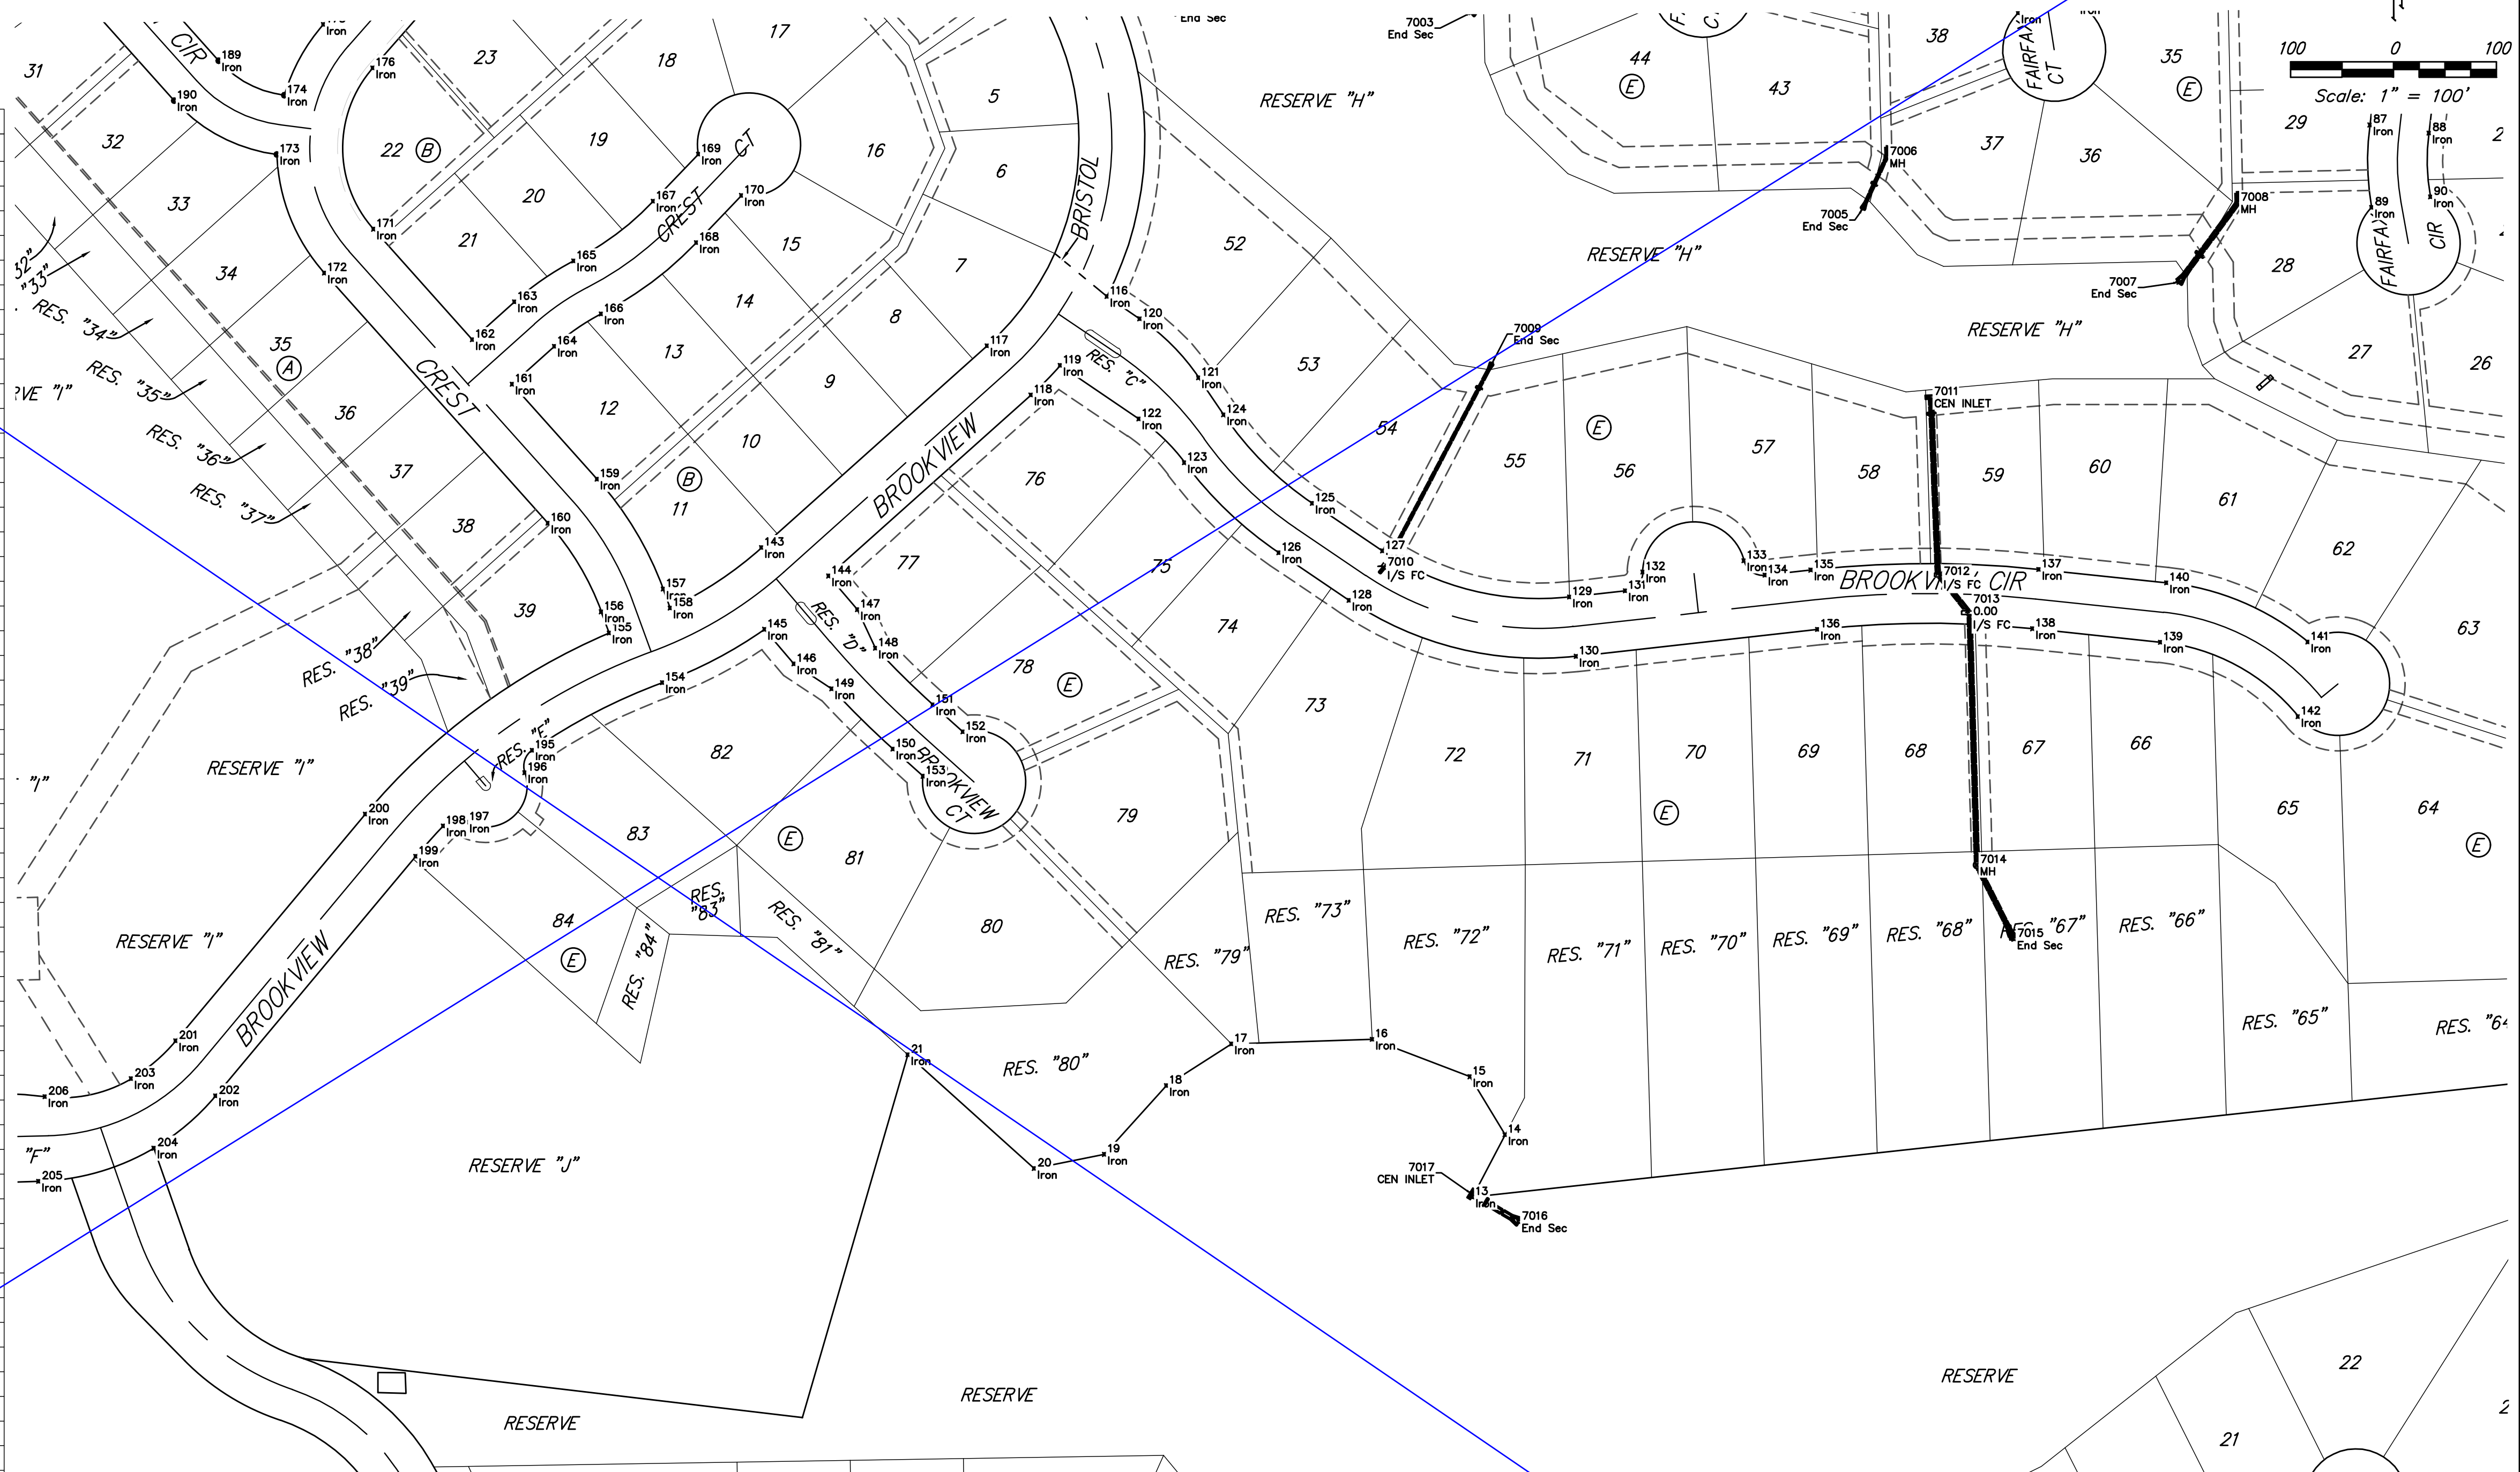

VOID - SEE SHEET 24R

	Brookfield Addition - Phase I COORDINATES Storm Water Drain Improvements	
	Baughman Company, P.A. 315 Ellis St. Wichita, KS 67211 P 316-262-7271 F 316-262-0149 ENGINEERING SURVEYING PLANNING LANDSCAPE ARCHITECTURE	
PROJECT NUMBER 468-85177	DESIGN AEG	DRAWN JAK
REVISIONS:	APPROVED	DATE 6/30/17
SCALE Noted		24 OF 26

E:\Projects\Brookfield Addition - 1664F190\Engineering\Phase I\SWD_1608E543\SWD PLANS.dwg

BENCHMARKS:
 RR spike in asphalt, SW COR., N1/2, SW1/4, Sec. 34, TWP. 26-S, R-2-E.
 Elev. = 1400.59 NAVD88

RR spike in E. face of power pole,
 174± N. of S. line, N1/2, SW1/4 &
 49± E. of W. line, SW1/4,
 Sec. 34, TWP. 26-S, R-2-E.
 Elev. = 1398.64 NAVD88

RR spike in S. face of power pole,
 294± S. of N. line, SW1/4, &
 48± E. of W. line, SW1/4,
 Sec. 34, TWP. 26-S, R-2-E.
 Elev. = 1386.14 NAVD88

COORDINATE POINTS				COORDINATE POINTS				COORDINATE POINTS			
Point #	Northing	Easting	Description	Point #	Northing	Easting	Description	Point #	Northing	Easting	Description
1	1710224.38	1685819.67	Iron	71	1709740.93	1687807.27	Iron	141	1708853.87	1688246.77	Iron
2	1710125.87	1685829.20	Iron	72	1709695.04	1687771.79	Iron	142	1708781.60	1688237.28	Iron
3	1710151.35	1685921.56	Iron	73	1709719.62	1687905.73	Iron	143	1708945.64	1686744.27	Iron
4	1710153.73	1686146.52	Iron	74	1709663.17	1687919.07	Iron	144	1708918.08	1686809.45	Iron
5	1710172.68	1686246.20	Iron	75	1709673.70	1687974.93	Iron	145	1708866.33	1686747.13	Iron
6	1710180.00	1686262.34	Iron	76	1709663.74	1687975.87	Iron	146	1708832.81	1686775.72	Iron
7	1710181.69	1686709.32	Iron	77	1709679.12	1688032.68	Iron	147	1708885.36	1686837.35	Iron
8	1710201.95	1687749.63	Iron	78	1709669.17	1688033.61	Iron	148	1708847.94	1686855.01	Iron
9	1710203.64	1687836.61	Iron	79	1709675.94	1688131.06	Iron	149	1708808.60	1686812.40	Iron
10	1710276.41	1688491.69	Iron	80	1709733.58	1688137.52	Iron	150	1708749.89	1686871.88	Iron
11	1710216.42	1688493.01	Iron	81	1709735.01	1688220.16	Iron	151	1708830.01	1686910.66	Iron
12	1708434.40	1688532.32	Iron	82	1709677.63	1688228.63	Iron	152	1708766.75	1686939.86	Iron
13	1708314.79	1687434.98	Iron	83	1709606.06	1688303.96	Iron	153	1708723.63	1686901.07	Iron
14	1708375.36	1687466.71	Iron	84	1709600.55	1688361.70	Iron	154	1708814.43	1686848.00	Iron
15	1708431.69	1687432.50	Iron	85	1709471.00	1688306.89	Iron	155	1708862.69	1686596.15	Iron
16	1708468.12	1687337.71	Iron	86	1709478.01	1688364.33	Iron	156	1708833.33	1686588.56	Iron
17	1708463.53	1687202.91	Iron	87	1709356.24	1688307.11	Iron	157	1708905.42	1686648.63	Iron
18	1708423.09	1687137.52	Iron	88	1709348.44	1688364.58	Iron	158	1708866.85	1686655.46	Iron
19	1708356.21	1687077.37	Iron	89	1709276.17	1688308.79	Iron	159	1709012.21	1686594.45	Iron
20	1708342.53	1687009.18	Iron	90	1709286.37	1688365.88	Iron	160	1708969.53	1686536.76	Iron
21	1708452.99	1686886.36	Iron	91	1709614.43	1687972.08	Iron	161	1709104.48	16868501.89	Iron
22	1708327.13	1685927.82	Iron	92	1709600.26	1688028.33	Iron	162	1709147.71	1686463.21	Iron
23	1708413.61	1685925.62	Iron	93	1709465.01	1687965.29	Iron	163	1709184.38	1686504.20	Iron
24	1710141.15	1686623.10	Iron	94	1709474.02	1688022.59	Iron	164	1709141.16	1686542.87	Iron
25	1710079.18	1686631.93	Iron	95	1709710.07	1687640.79	Iron	165	1709224.06	1686561.64	Iron
26	1710067.22	1686711.55	Iron	96	1709646.42	1687632.83	Iron	166	1709172.58	1686588.37	Iron
27	1710039.71	1686643.43	Iron	97	1709651.10	1687690.64	Iron	167	1709282.02	1686639.00	Iron
28	1710051.74	1686712.48	Iron	98	1709643.31	1687691.26	Iron	168	1709241.91	1686680.89	Iron
29	1709995.10	1686726.94	Iron	99	1709638.68	1687633.45	Iron	169	1709327.86	1686682.89	Iron
30	1709983.85	1686662.70	Iron	100	1709534.39	1687633.28	Iron	170	1709287.74	1686724.78	Iron
31	1710041.37	1686532.22	Iron	101	1709529.57	1687691.08	Iron	171	1709255.02	1686367.19	Iron
32	1709994.06	1686523.25	Iron	102	1709722.68	1687415.67	Iron	172	1709212.35	1686319.50	Iron
33	1709987.30	1686477.84	Iron	103	1709558.78	1687412.09	Iron	173	1709327.60	1686273.23	Iron
34	1710045.30	1686477.10	Iron	104	1709707.66	1687242.19	Iron	174	1709385.13	1686280.55	Iron
35	1710043.00	1686298.19	Iron	105	1709645.33	1687256.69	Iron	175	1709453.79	1686318.37	Iron
36	1709985.01	1686298.94	Iron	106	1709711.10	1687110.71	Iron	176	1709411.56	1686366.46	Iron
37	1710026.60	1686213.67	Iron	107	1709649.60	1687092.97	Iron	177	1709568.84	1686419.39	Iron
38	1709972.54	1686234.68	Iron	108	1709823.40	1686739.62	Iron	178	1709594.09	1686433.50	Iron
39	1709952.90	1686110.33	Iron	109	1709769.33	1686773.86	Iron	179	1709623.06	1686398.77	Iron
40	1710010.80	1686113.64	Iron	110	1709702.65	1686906.88	Iron	180	1709661.65	1686442.08	Iron
41	1710042.43	1686875.70	Iron	111	1709671.01	1686935.20	Iron	181	1709622.68	1686478.80	Iron
42	1709986.21	1686861.45	Iron	112	1709659.98	1686859.19	Iron	182	1709526.61	1686467.49	Iron
43	1710043.68	1687111.90	Iron	113	1709623.32	1686877.87	Iron	183	1709601.55	1686561.24	Iron
44	1709987.61	1687126.74	Iron	114	1709562.76	1687032.06	Iron	184	1709657.77	1686530.65	Iron
45	1710049.25	1687398.10	Iron	115	1709520.08	1686984.36	Iron	185	1709703.41	1686595.39	Iron
46	1709992.64	1687385.46	Iron	116	1709189.64	1687079.94	Iron	186	1709655.72	1686638.08	Iron
47	1710049.39	1687604.10	Iron	117	1709141.65	1686963.34	Iron	187	1709774.09	1686674.37	Iron
48	1709992.80	1687616.82	Iron	118	1709093.96	1687006.02	Iron	188	1709726.39	1686717.05	Iron
49	1710059.76	1687689.85	Iron	119	1709122.65	1687034.40	Iron	189	1709418.63	1686216.77	Iron
50	1710001.77	1687690.98	Iron	120	1709168.02	1687111.74	Iron	190	1709379.96	1686173.55	Iron
51	1710165.70	1687750.33	Iron	121	1709110.68	1687168.96	Iron	191	1709476.23	1686087.41	Iron
52	1710165.79	1687837.35	Iron	122	1709070.69	1687110.84	Iron	192	1709514.91	1686130.63	Iron
53	1710103.38	1687824.06	Iron	123	1709028.22	1687155.19	Iron	193	1709609.21	1686093.87	Iron
54	1710102.13	1687760.07	Iron	124	1709074.77	1687193.25	Iron	194	1709608.44	1686035.88	Iron
55	1710061.14	1687760.87	Iron	125	1708988.72	1687279.34	Iron	195	1708748.79	1686521.37	Iron
56	1710062.38	1687824.86	Iron	126	1708940.67	1687246.85	Iron	196	1708727.05	1686514.17	Iron
57	1710003.15	1687762.00	Iron	127	1708942.55	1687347.63	Iron	197	1708678.90	1686457.50	Iron
58	1710004.40	1687825.99	Iron	128	1708894.50	1687315.14	Iron	198	1708675.31	1686434.89	Iron
59	1710063.46	1687879.85	Iron	129	1708897.73	1687529.40	Iron	199	1708645.70	1686408.32	Iron
60	1710005.47	1687880.98	Iron	130	1708840.08	1687535.82	Iron	200	1708686.76	1686359.22	Iron
61	1710011.94	1687955.56	Iron	131	1708903.76	1687583.57	Iron	201	1708466.44	1686174.99	Iron
62	1710069.26	1687946.68	Iron	132	1708922.02	1687600.46	Iron	202	1708413.12	1686213.83	Iron
63	1710065.77	1688119.66	Iron	133	1708932.97	1687698.82	Iron	203	1708429.72	1686131.81	Iron
64	1710008.86	1688108.48	Iron	134	1708918.87	1687719.31	Iron	204	1708362.21	1686153.87	Iron
65	1710005.68	1688214.63	Iron	135	1708923.84	1687763.90	Iron	205	1708330.02	1686041.74	Iron
66	1710007.80	1688230.32	Iron	136	1708866.20	1687770.32	Iron	206	1708412.28	1686048.00	Iron
67	1710065.27	1688222.56	Iron	137	1708924.52	1687985.37	Iron	207	1708415.22	1685989.19	Iron
68	1710063.16	1688206.87	Iron	138	1708866.84	1687979.31	Iron				
69	1709830.18	1687765.37	Iron	139	1708853.79	1688103.46	Iron				
70	1709831.43	1687829.35	Iron	140	1708911.47	1688109.52	Iron				



		Brookfield Addition - Phase I COORDINATES Storm Water Drain Improvements	
		<small>Baughman Company, P.A. 315 Ellis St. Wichita, KS 67211 P 316-262-7271 F 316-262-0149 ENGINEERING SURVEYING PLANNING LANDSCAPE ARCHITECTURE</small>	
PROJECT NUMBER 468-85177	DESIGN AEG	DRAWN JAK	
REVISIONS: 7/18/17 JAK	APPROVED 	DATE 6/30/17	
SCALE Noted			
		24R OF 26	

BROOKFIELD ADDITION WICHITA, SEDGWICK COUNTY, KANSAS

State of Kansas) SS We, Baughman Company, P.A., Surveyors in
Sedgwick County) and state do hereby certify that we have surveyed and
platted "BROOKFIELD ADDITION", Wichita, Sedgwick County, Kansas and that
the accompanying plat is a true and correct exhibit of the property
surveyed, described as that part of the Northwest Quarter of Section 34,
Township 26 South, Range 2 East of the Sixth Principal Meridian, Sedgwick
County, Kansas described as follows: Beginning at the northwest corner
of said Northwest Quarter; thence N88°33'05"E along the north line of
said Northwest Quarter, 2672.52 feet to the northeast corner of said
Northwest Quarter; thence S01°15'49"E along the east line of said
Northwest Quarter, 1842.45 feet; thence S83°46'45"W, 1103.84 feet; thence
N27°38'26"E, 68.38 feet; thence N31°16'05"W, 63.90 feet; thence
N68°58'44"W, 101.55 feet; thence S88°04'39"W, 136.87 feet; thence
S57°28'11"W, 75.19 feet; thence S41°58'08"W, 89.95 feet; thence
S78°39'05"W, 69.55 feet; thence N48°01'52"W, 165.19 feet; thence
S16°13'44"W, 366.95 feet; thence N83°15'09"W, 487.82 feet to the point of
curvature of a non-tangent curve to the right; thence westerly and
northwesterly along said curve, having a central angle of 54°23'40" and a
radius of 168.00 feet, an arc distance of 159.49 feet, (having a chord
length of 153.57 feet bearing N46°24'30"W), to the point of tangency of
said curve; thence N19°12'40"W, 104.14 feet to a point on a non-tangent
curve to the right; thence southwesterly and westerly along said curve,
through a central angle of 29°07'25" and having a radius of 232.00 feet,
an arc distance of 117.93 feet, (having a chord length of 116.66 feet
bearing S73°59'06"W), to the point of tangency of said curve; thence
S88°32'49"W, 173.96 feet to a point on the west line of said Northwest
Quarter; thence N01°27'11"W along the west line of said Northwest Quarter,
1899.38 feet to the point of beginning, all being subject to road
rights-of-way of record.

Existing public easements, building setbacks,
access controls, and dedications, if any, being
voted by virtue of K.S.A. 12-512b, as amended.
Baughman Company, P.A.



Michael G. Conrey, Surveyor
Michael G. Conrey

Know all men by these presents that we, the
undersigned, have caused the land in the surveyors certificate to be platted into
Lots, Blocks, Streets, and Reserves to be known as "BROOKFIELD ADDITION",
Wichita, Sedgwick County, Kansas. The utility easements are hereby granted
as indicated for the construction and maintenance of all public utilities.
The drainage and utility easements are hereby granted as indicated for drainage
purposes and for the construction and maintenance of all public utilities. No
signs, light poles, private drainage systems, masonry trash enclosures or other
structures shall be located within public utility easements. The drainage
easements are hereby granted as indicated for drainage purposes. The wall
easements are hereby granted as indicated for the construction and maintenance
of private screening walls and utility main lines and service lines shall be allowed
to cross these easements. The streets are hereby dedicated to and for the use
of the public. Reserves "A", "B", "C", "D", "E", and "F" are hereby reserved for
open space, landscaping, drainage purposes, entry monuments, utilities, and
streets. Reserve "G" is hereby reserved for open space, landscaping, drainage
purposes, entry monuments, screening walls, and utilities as confined to
easement. Reserve "H" is hereby reserved for open space, landscaping, drainage
purposes, lakes, and utilities as confined to easements. Reserve "I" is hereby
reserved for open space, landscaping, drainage purposes, entry monuments,
sidewalks, floodplain, a sanitary sewer lift station as confined to easement,
utilities as confined to easements, and water lines as confined to easement.
Reserve "J" is hereby reserved for open space, landscaping, drainage purposes,
sidewalks, floodplain, and lakes. No fill, change of grade, creation of channel, or
any other work shall be carried on within said Reserves "I" and "J" without the
permission of the Engineer for the appropriate governing body. Reserves "A", "B",
"C", "D", "E", "F", "G", "H", "I", and "J" shall be owned and maintained by the
homeowners association for the addition provided, however, that the undersigned,
or the homeowners association, as the undersigned's successor in interest, may,
in their discretion, deed a parcel of a Reserve to an owner or owners of an
adjacent lot, subject to the obligation to maintain such deeded parcel of a
Reserve in compliance with the provisions hereof and in compliance with the
maintenance covenants or any applicable restrictive covenants and/or regulations.
Reserves "6", "31", "32", "33", "34", "35", "36", "64", "65", "66", "67", "68",
"69", "70", "71", "72", "73", "79", "80", "81", "83", and "84" are hereby
reserved for open space, landscaping, drainage reserve purposes, and floodplain.
Reserve "30" is hereby reserved for open space, landscaping, drainage reserve
purposes, floodplain, and water lines as confined to easement. Reserves "37",
"38", and "39" are hereby reserved for open space, landscaping, drainage reserve
purposes, floodplain, and utilities as confined to easement. No fill, change of
grade, creation of channel, or any other work shall be carried on within said
floodplain without the permission of the Engineer for the appropriate governing
body. Reserves "6", "30", "31", "32", "33", "34", "35", "36", "37", "38", "39",
"64", "65", "66", "67", "68", "69", "70", "71", "72", "73", "79", "80", "81", "83",
and "84" shall be owned and maintained by the owners of the corresponding
adjacent lots and shall be the responsibility of said corresponding adjacent lot
owners until such time as the appropriate governing body elects to assume the
responsibility for maintenance and improvements to the drainage. FEMA
floodplain and regulatory floodway boundaries are subject to periodic change and
such change may affect the intended land use within the subdivision. Access
controls shall be as depicted on the face of the plat and are hereby granted to
the City of Wichita, Kansas. The Minimum Building Pad Elevations for the lowest
opening to the structures shall be as indicated on the face of the plat.

37th & Greenwich, LLC,
a Kansas limited liability company

Kevin M. Mullen, President of
Ritchie Development Corporation,
a Kansas corporation

We, the undersigned holders of a mortgage on the
above described property, do hereby consent to this plat of "BROOKFIELD
ADDITION", Wichita, Sedgwick County, Kansas.
INTRUST Bank, N.A.

Debra J. Allison
Debra J. Allison
* Senior Comm'l. R.E. Lending Relationship Mgr.

State of Kansas) SS The foregoing instrument acknowledged before
me, this 16th day of January, 2017, by Debra J. Allison,
* of INTRUST Bank, N.A., on behalf of the bank.
* Senior Comm'l. R.E. Lending Relationship Mgr.


Susan K. Cook
SUSAN K. COOK
Notary Public
My App't. Exp. 11/13/20

My App't. Exp. 11/13/20



This plat of "BROOKFIELD ADDITION", Wichita,
Sedgwick County, Kansas has been submitted to and approved by the
Wichita-Sedgwick County Metropolitan Area Planning Commission, Wichita,
Kansas.

Dated this 21st day of September, 2016,
Wichita-Sedgwick County Metropolitan Area Planning Commission

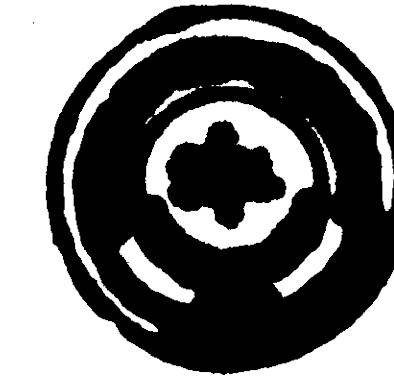


David W. Foster, Chair
Dale Miller, Secretary
Dale Miller

This plat approved and all dedications
shown hereon accepted by the City Council of the City of Wichita,
Kansas, this 14th day of February, 2017.


Jeff Longwell, Mayor
Karen Sublett, City Clerk
Jeff Longwell
Karen Sublett

Reviewed in accordance with K.S.A. 58-2005
on this 10th day of January, 2017.

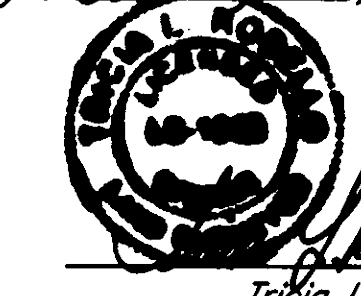

Tricia L. Robello, L.S. #1246
Deputy County Surveyor
Sedgwick County, Kansas


Entered on transfer record this 16th day
of February, 2017.

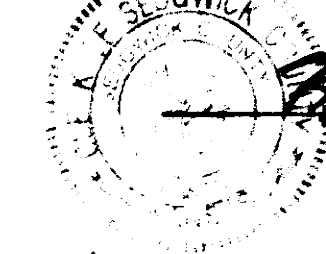

Kelly B. Arnold, County Clerk



State of Kansas) SS The foregoing instrument acknowledged before
me, this 17th day of January, 2017, by Kevin M. Mullen, President
of Ritchie Development Corporation, a Kansas corporation, as Manager of
37th & Greenwich, LLC, a Kansas limited liability company.

Judith M. Terhune
JUDITH M. TERHUNE
Notary Public - State of Kansas
My App't. Expires 11-7-17
Judith M. Terhune
JUDITH M. TERHUNE
Notary Public
My App't. Exp. 11-7-17

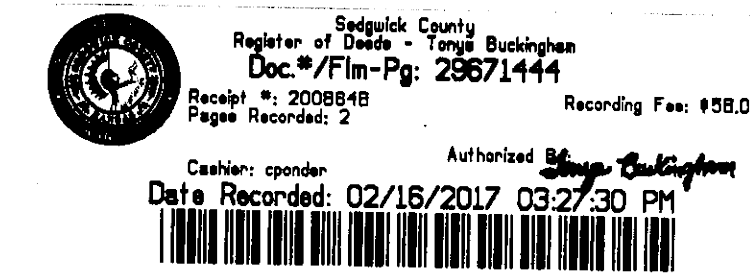

State of Kansas) SS This is to certify that this plat has been
filed for record in the office of the Register of Deeds, this 16th day
of February, 2017 at 03:27:30 clock P.M. and is duly recorded.

Tonya Buckingham, Register of Deeds
Judy J. Paget, Deputy
Tonya Buckingham
Judy J. Paget

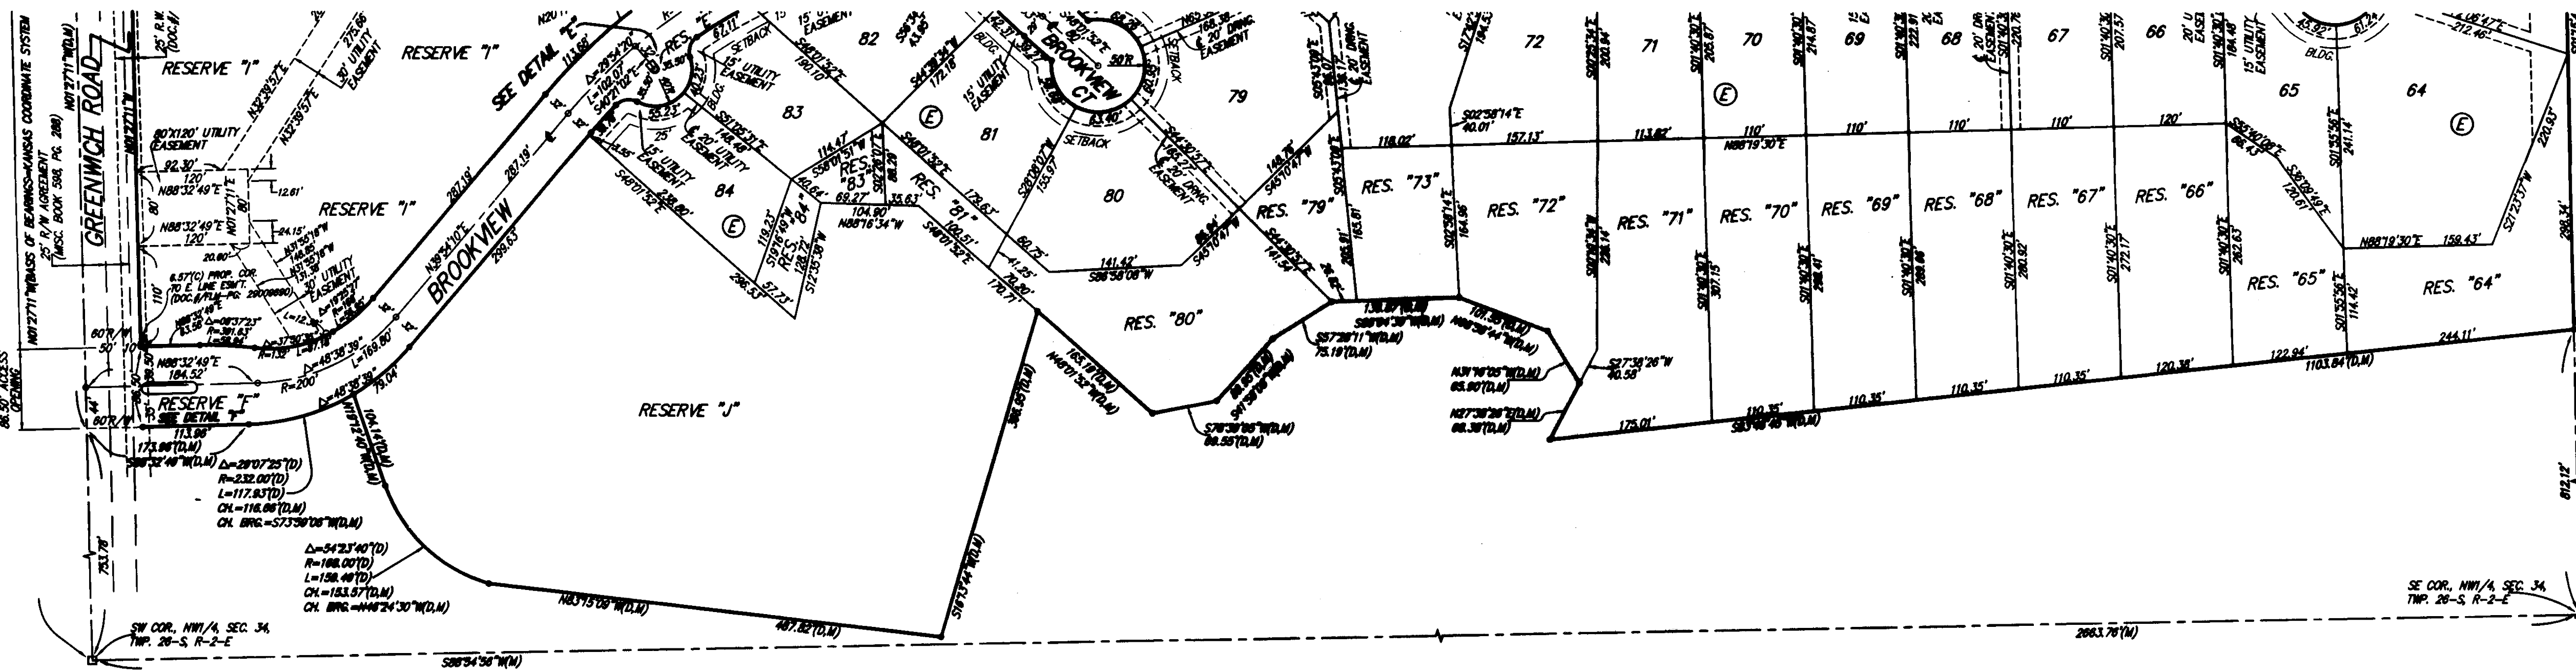
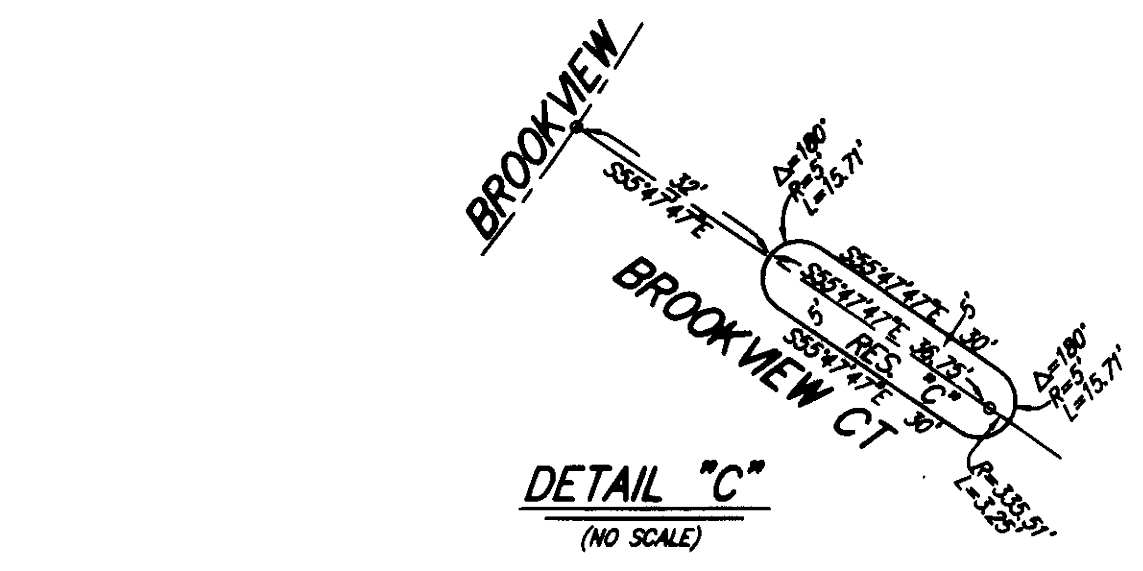


MINIMUM BUILDING PAD ELEVATIONS FOR LOWEST OPENING TO THE STRUCTURES		
LOT	BLOCK	ELEVATION
15-19	A	1376.0
20-22	A	1375.5
23-25	A	1375.0
5-7	F	1377.0
26-28	F	1372.8
35-37	F	1372.0
43-45	F	1372.0
47-51	F	1372.0
52-61	F	1372.0
62	F	1372.5
63-66	F	1370.0
67-71	F	1372.0
72-73	F	1372.7
79-80	F	1373.0
81-84	F	1373.5

NOTE:
A drainage plan has been developed for the plat and
all drainage easements, rights-of-way, or reserve shall
remain at established grades or as modified with the
approval of the applicable City or County Engineer and
unobstructed to allow for the conveyance of stormwater.

BROOKFIELD ADDITION WICHITA, SEDGWICK COUNTY, KANSAS

- #4 REBAR W/ "BAUGHMAN" CAP (SET)
 - = 1" IRON PIPE (FOUND)
 - ◇ = 2" ALUMINUM "SEDGWICK COUNTY" CAP (FOUND)
 - △ = STONE (FOUND)
 - = #6 REBAR (FOUND)
- (M) = MEASURED
(D) = DESCRIBED
(P) = PLATTED
- BENCHMARK:
CHISELED SQUARE ON E. SIDE OF SCHOOL SIGNAL POLE BASE, W. SIDE OF GREENWICH ROAD, 302' S. & 21.5' W. OF THE SW COR., NW1/4, SEC. 34, TWP. 26-S, R-2-E. ELEV. = 1373.80 NAVD88.
- TOP OF 1" IRON PIPE AT NW COR., NW1/4, SEC. 34, TWP. 26-S, R-2-E. ELEV. = 1380.04 NAVD88.

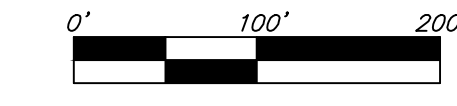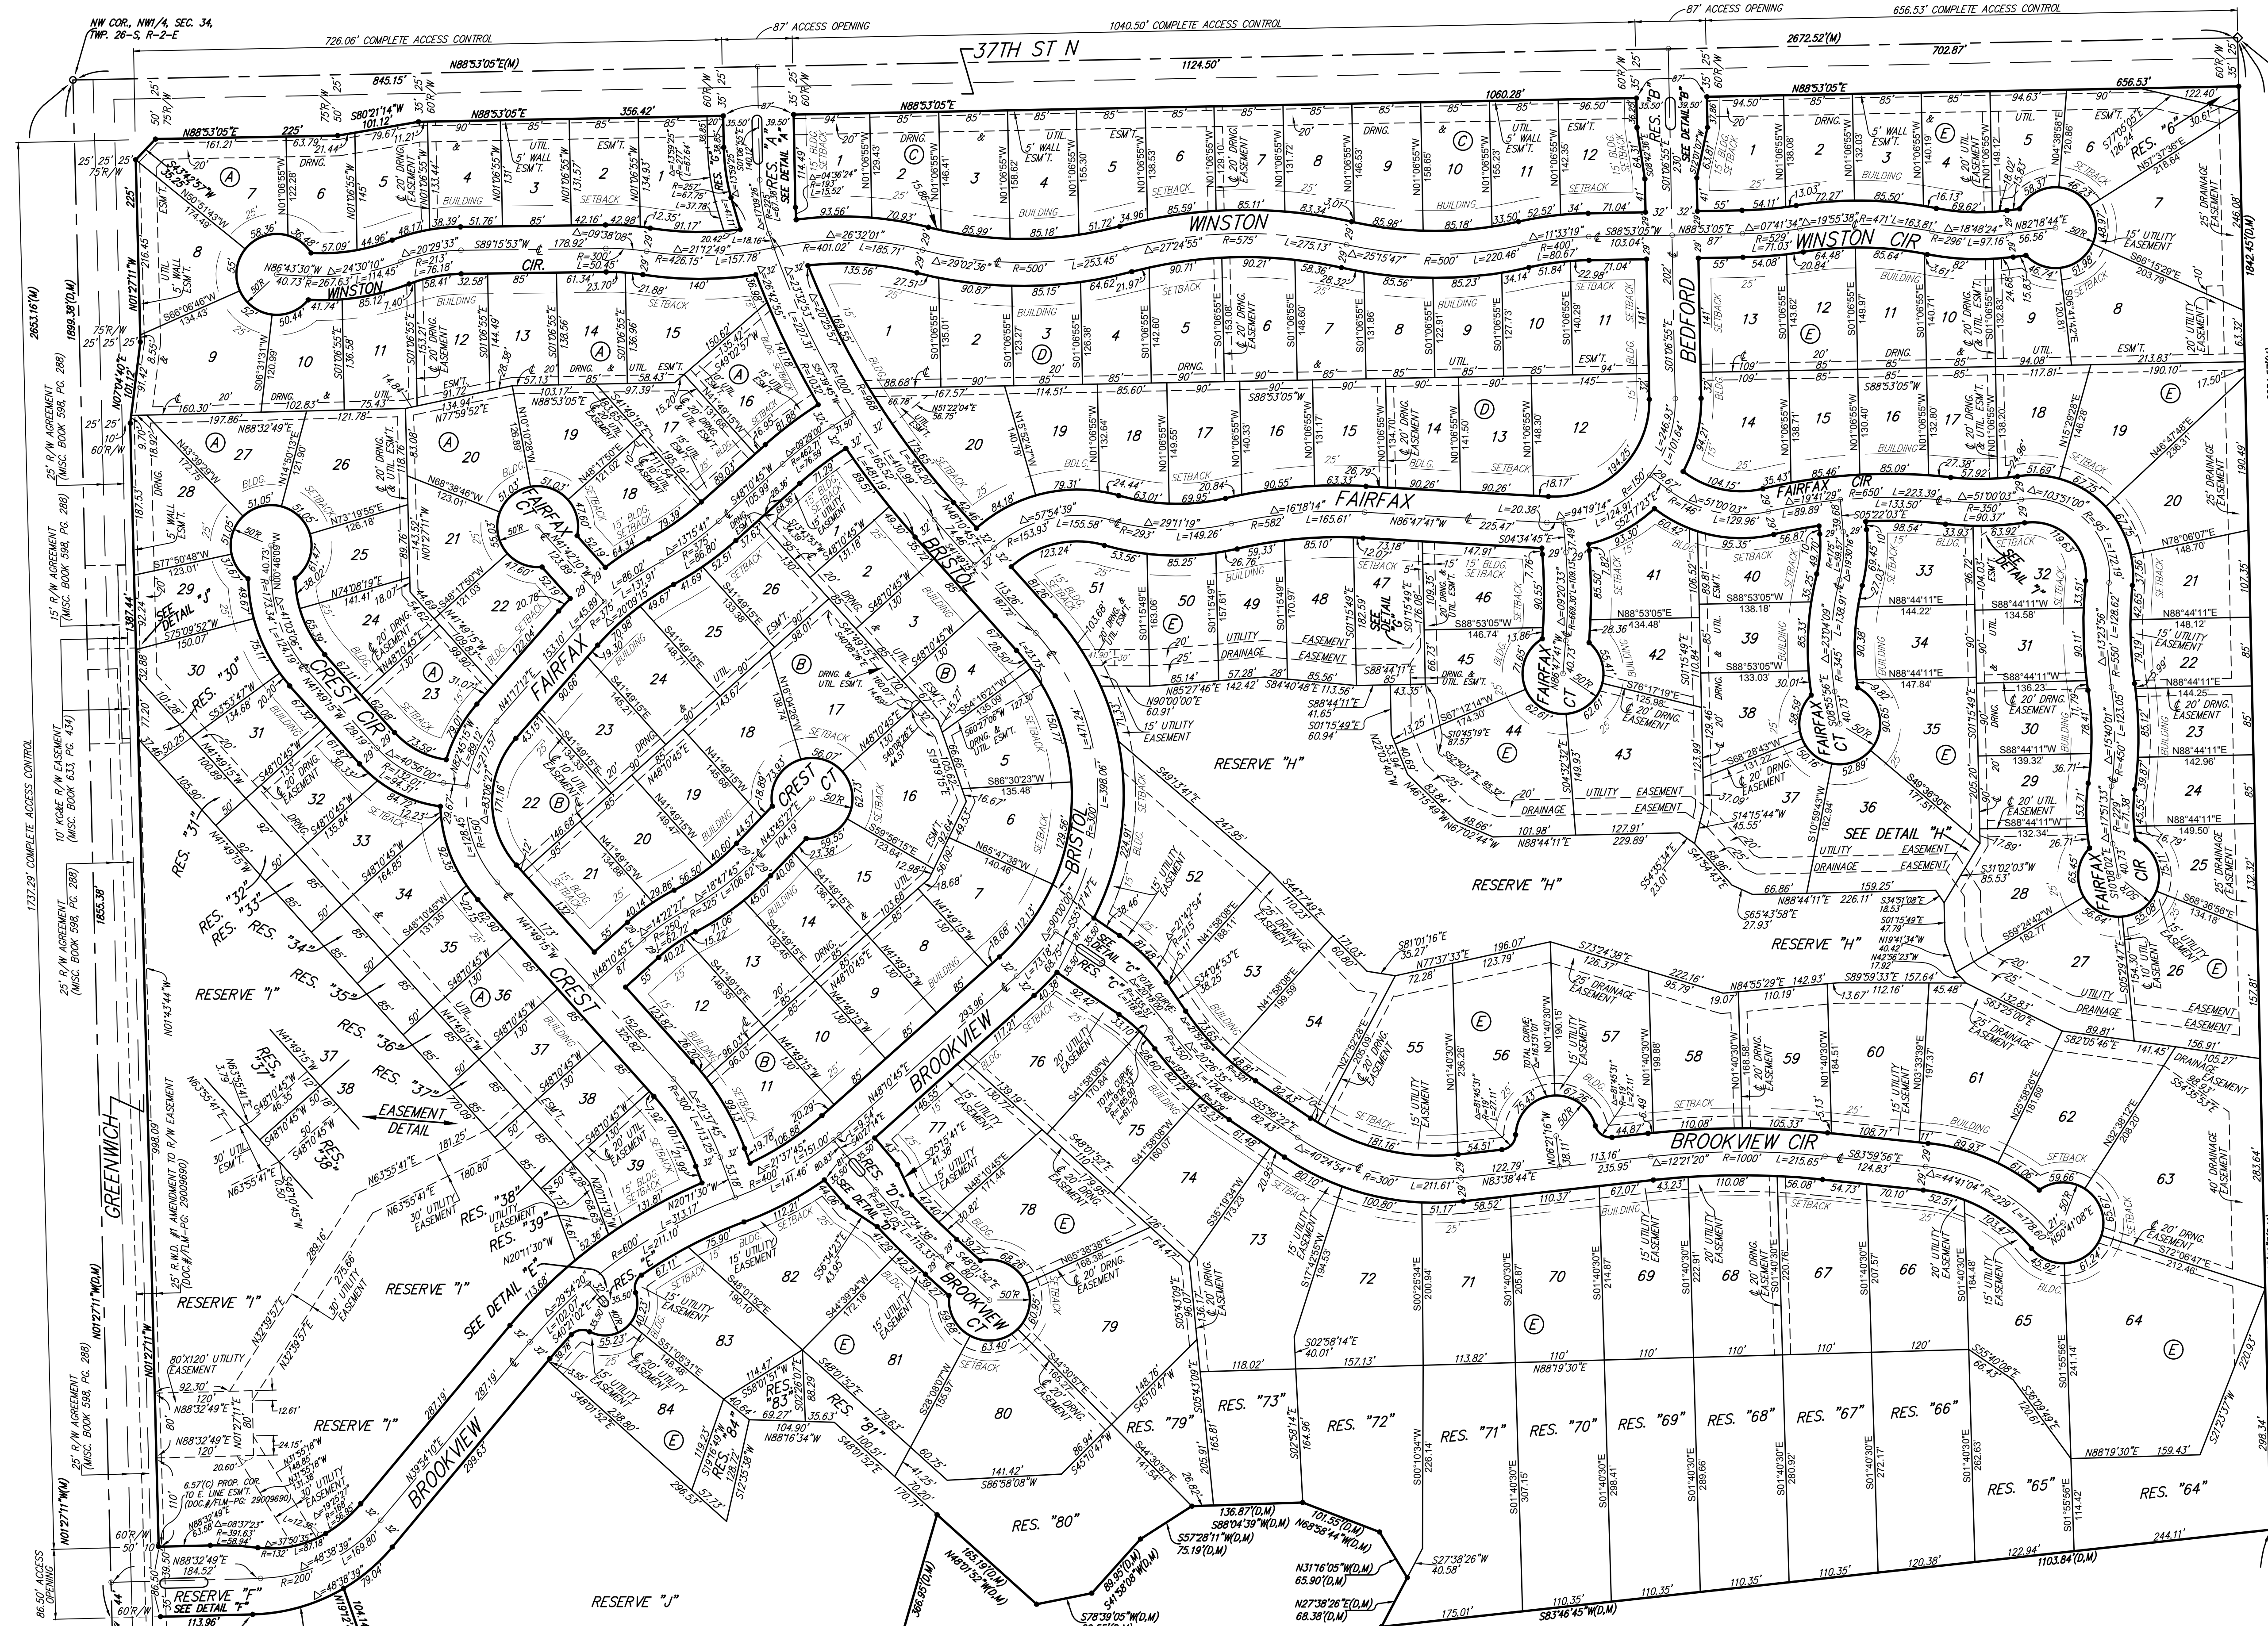

37TH ST N

MINIMUM BUILDING PAD ELEVATIONS FOR LOWEST OPENING TO THE STRUCTURES

LOT	BLOCK	ELEVATION NAVD88
15-19	A	1376.0
20-22	A	1375.5
23-25	A	1375.0
5-7	F	1377.0
26-28	F	1372.8
30-37	F	1372.5
43-45	F	1372.8
47-51	F	1372.7
52-61	F	1373.0
62	F	1372.5
63-66	F	1370.8
67-71	F	1372.0
72-73	F	1372.7
79-80	F	1373.0
81-84	F	1373.5

DETAIL "B" BEDFORD
(NO SCALE)

DETAIL "F"
(NO SCALE)

DETAIL "H"
(NO SCALE)

DETAIL "G"
(NO SCALE)

DETAIL "I"
(NO SCALE)

DETAIL "J"
(NO SCALE)

DETAIL "D"
(NO SCALE)

DETAIL "E"
(NO SCALE)

DETAIL "A"
(NO SCALE)

DETAIL "C"
(NO SCALE)

DETAIL "K"
(NO SCALE)

DETAIL "L"
(NO SCALE)

DETAIL "M"
(NO SCALE)

DETAIL "N"
(NO SCALE)

DETAIL "O"
(NO SCALE)

DETAIL "P"
(NO SCALE)

NOTE:
A drainage plan has been developed for the plat and all drainage easements, rights-of-way, or reserves shall remain at established grades or as modified with the approval of the applicable City or County Engineer and unobstructed to allow for the conveyance of stormwater.