



**LOWER RETAINING WALL**

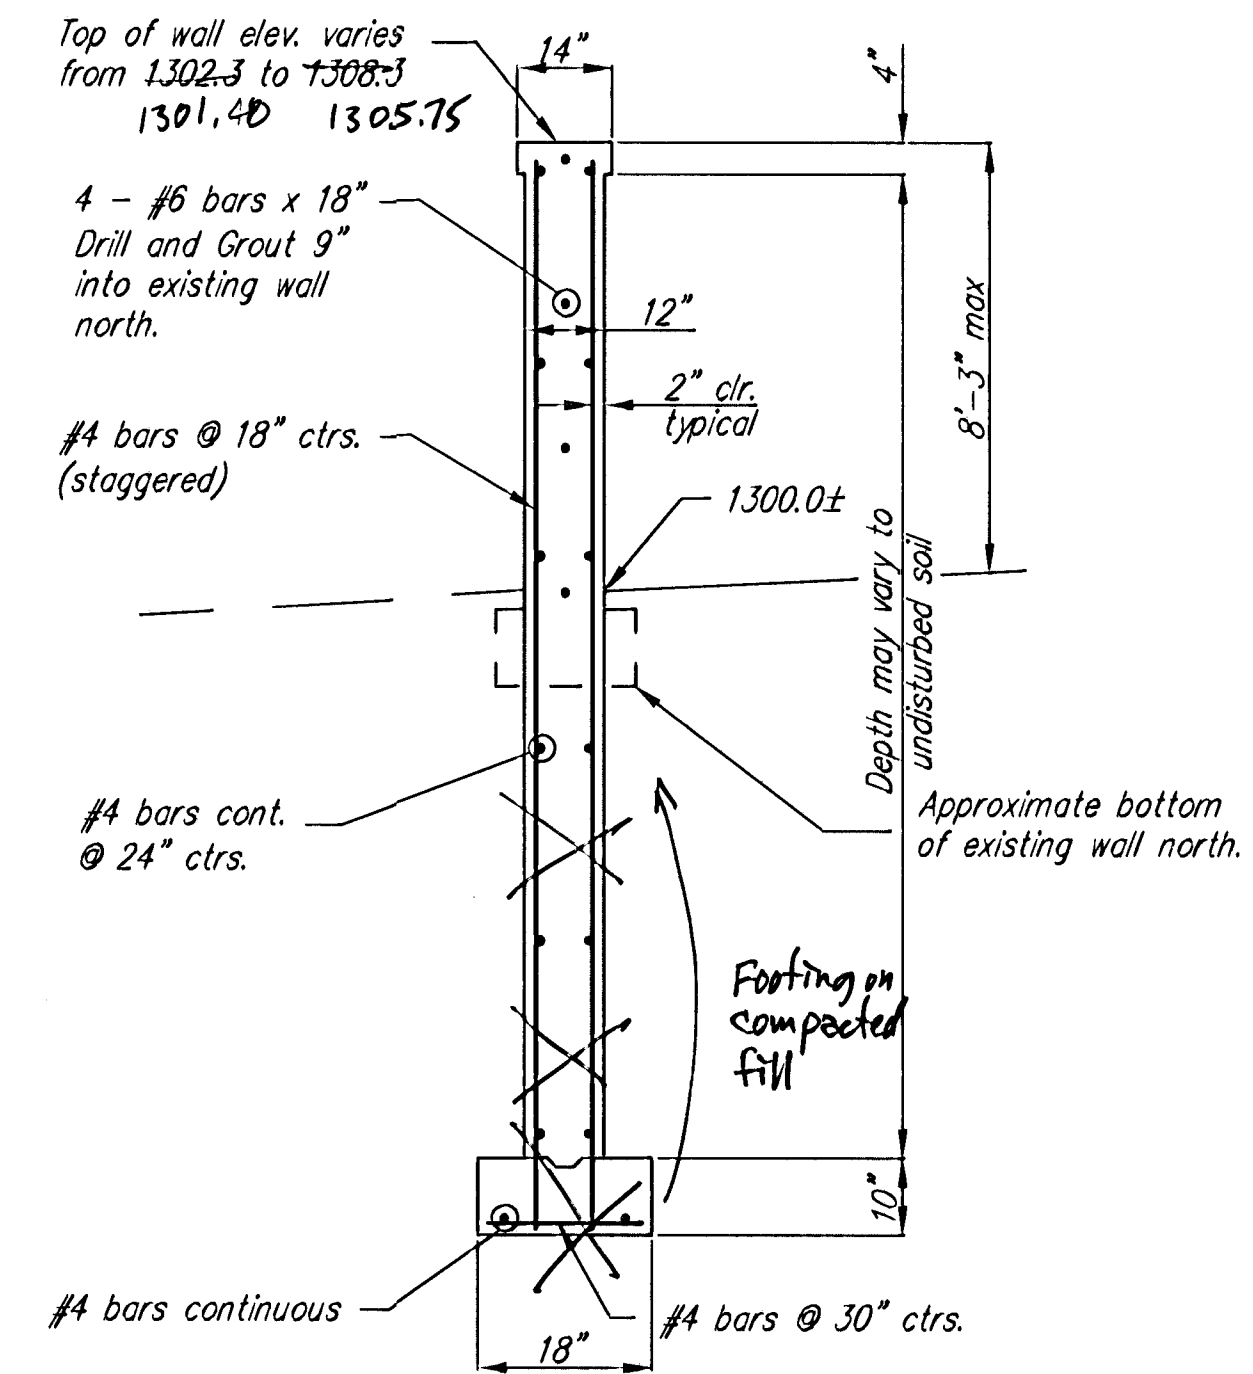

**UPPER RETAINING WALL**

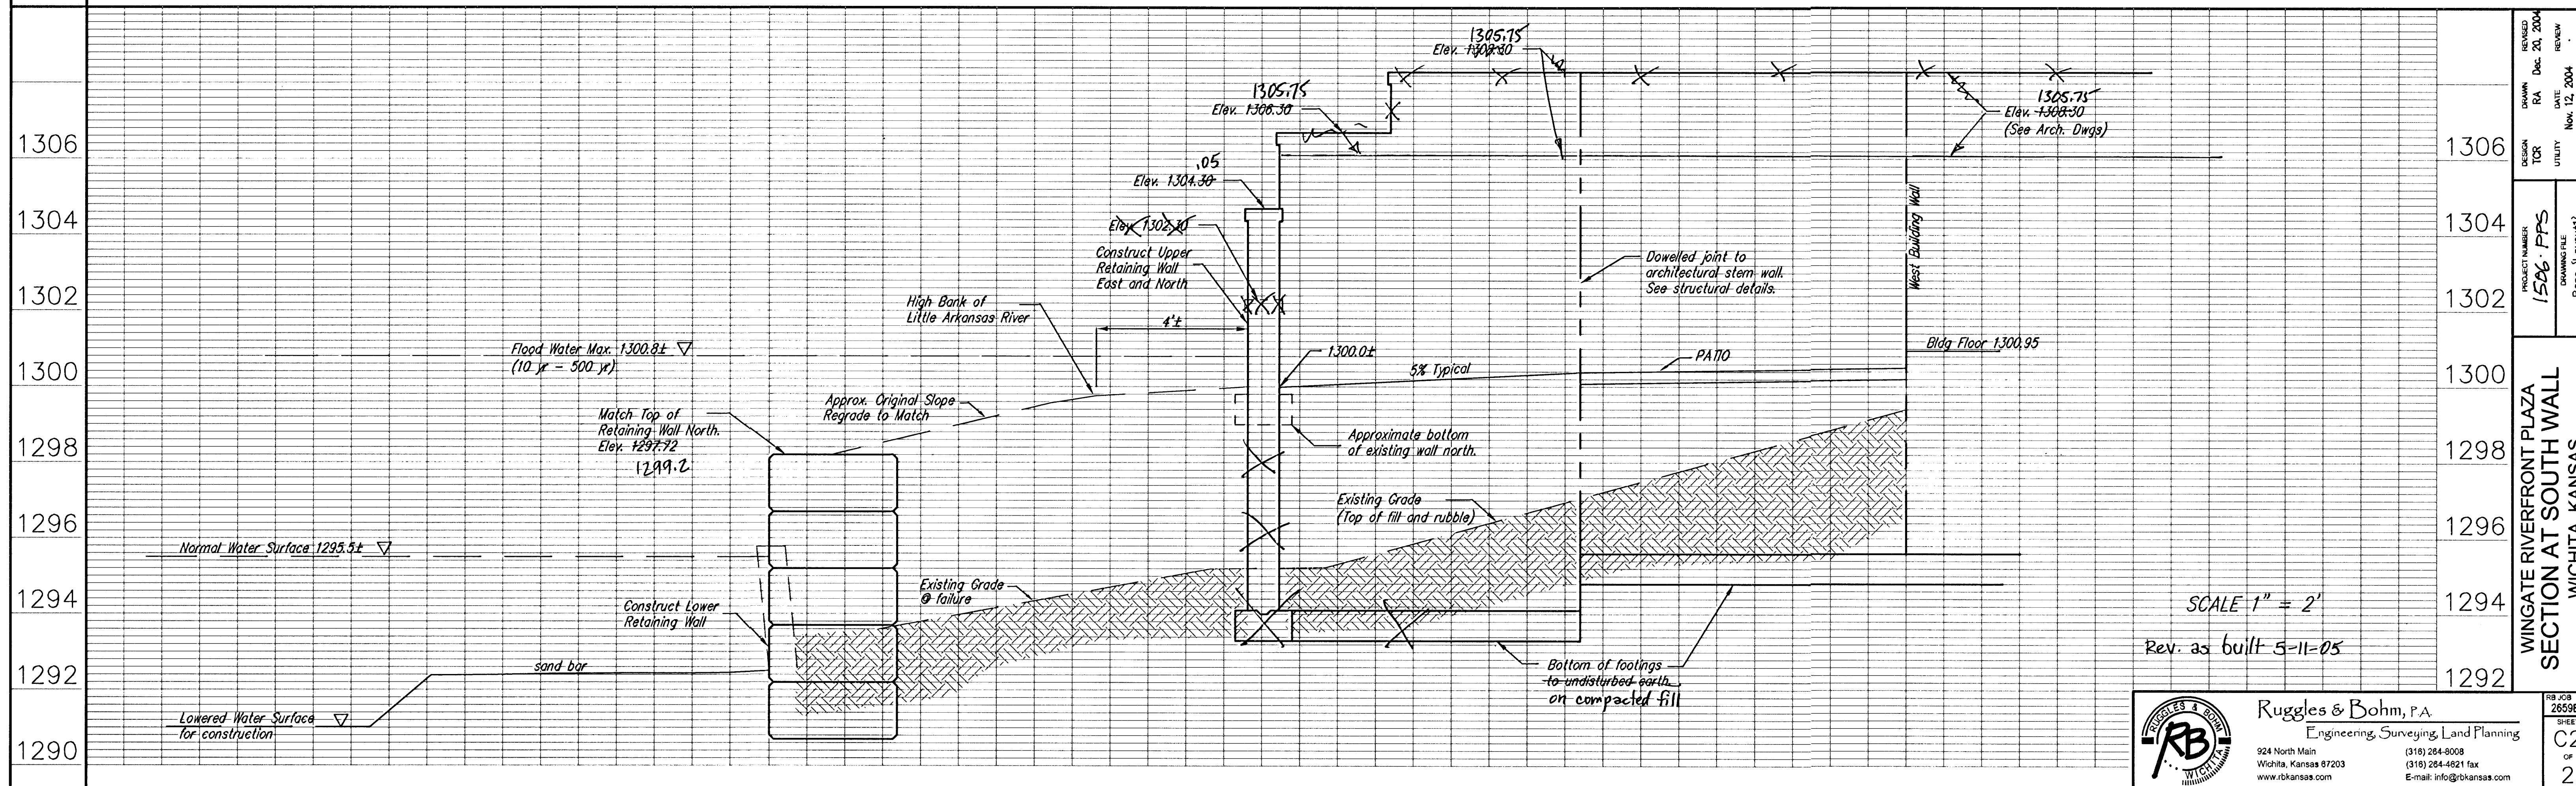

SCALE 1" = 2'  
Rev. as built 5-11-05

	<b>Ruggles &amp; Bohm, P.A.</b> Engineering, Surveying, Land Planning		RB JOB 2659E
	924 North Main Wichita, Kansas 67203 www.rbkansas.com		SHEET C2 OF 2
(316) 264-8008 (316) 264-4621 fax E-mail: info@rbkansas.com			

WINGATE RIVERFRONT PLAZA SECTION AT SOUTH WALL WICHITA, KANSAS  
 PROJECT NUMBER 1506-PPS  
 DRAWING FILE Base {Layout1}  
 DESIGN FOR UTILITY  
 DRAWN RA  
 CHECKED RA  
 DATE Nov. 12, 2004  
 REVIEW