
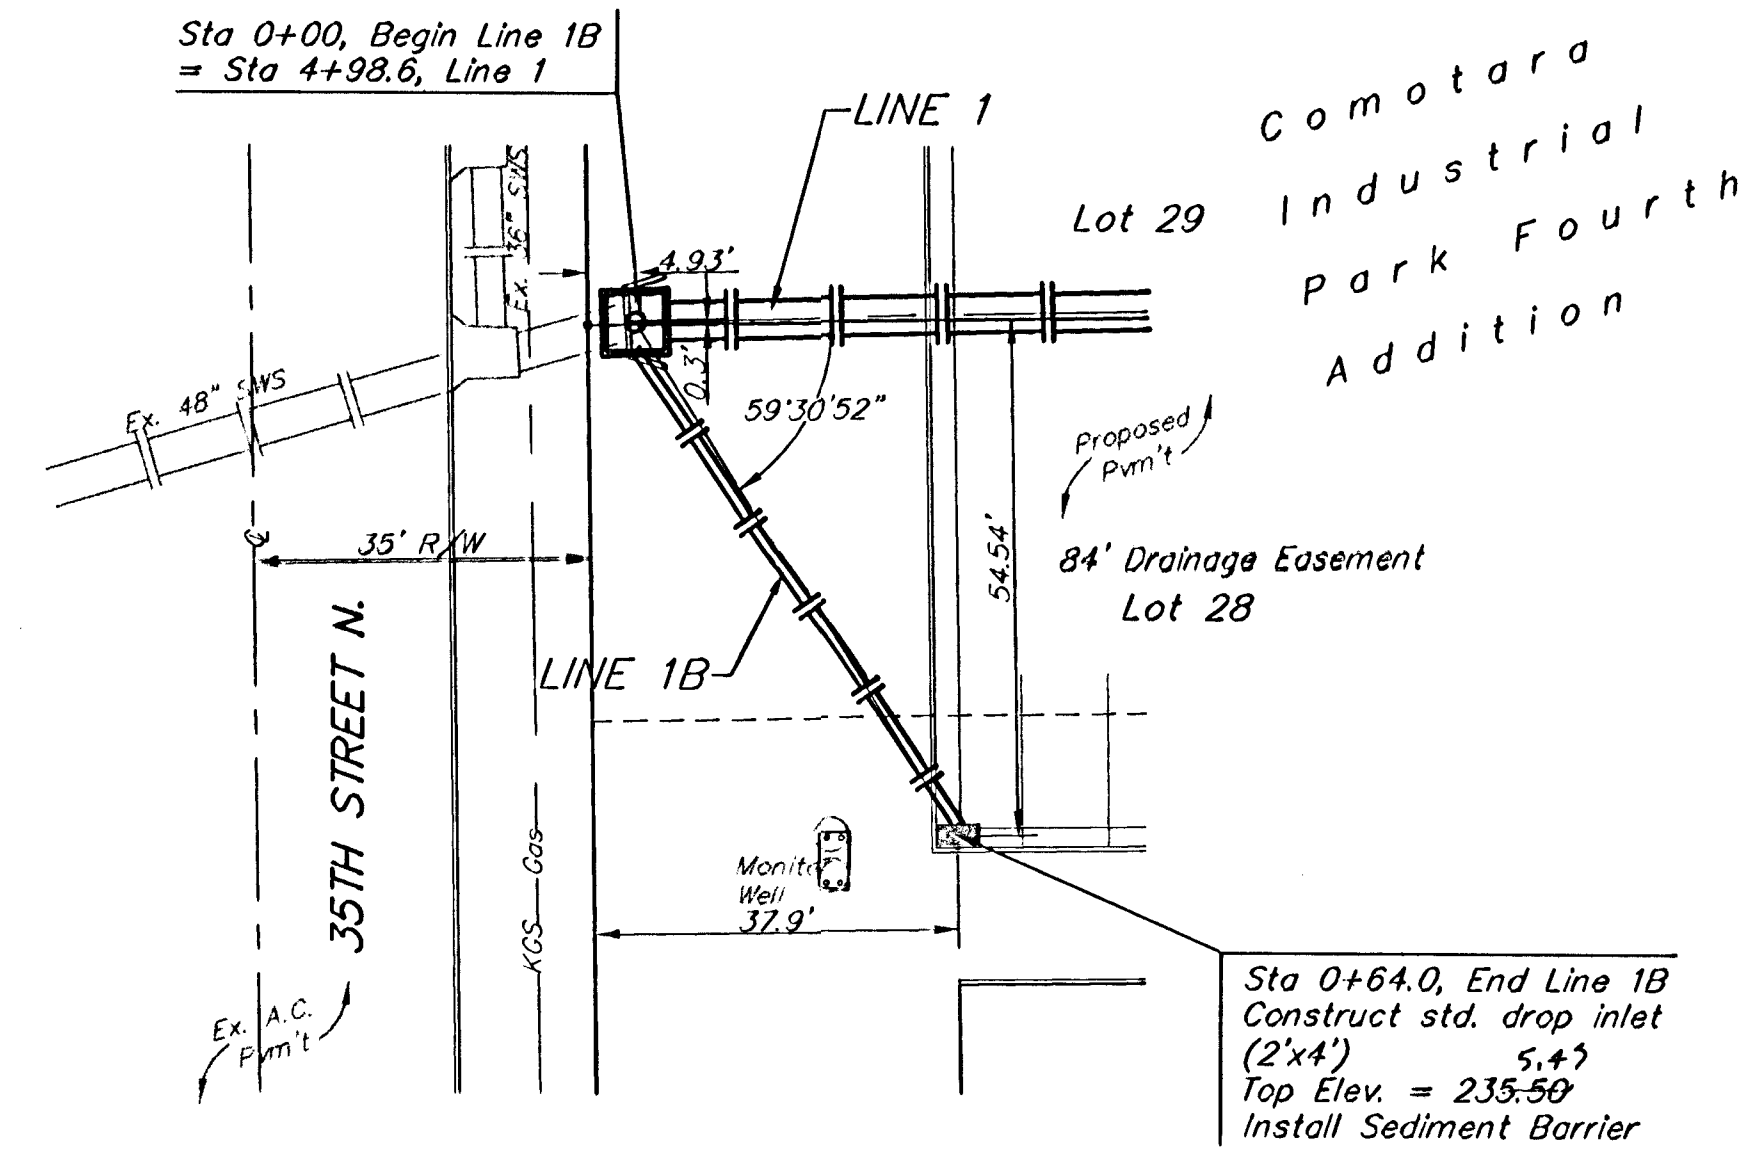



BENCHMARK:

#1 City of Wichita Bench Mark at Webb Road and 37th Street North, Northwest corner of intersection, 53.00 Ft. North of center line and 38.00 Ft. West of center line.
Elev. = 1414.92 M.S.L.
Elev. = 227.52 City Datum

#2 Railroad Spike Set In The South Face of Power Pole, 80.60' West and 7.13 North of Northwest Corner of Lot 6, Comotara Industrial Park 4th Addition, Wichita, Sedgwick County, Kansas.
Elev. = 1424.69 M.S.L.
Elev. = 237.29 City Datum

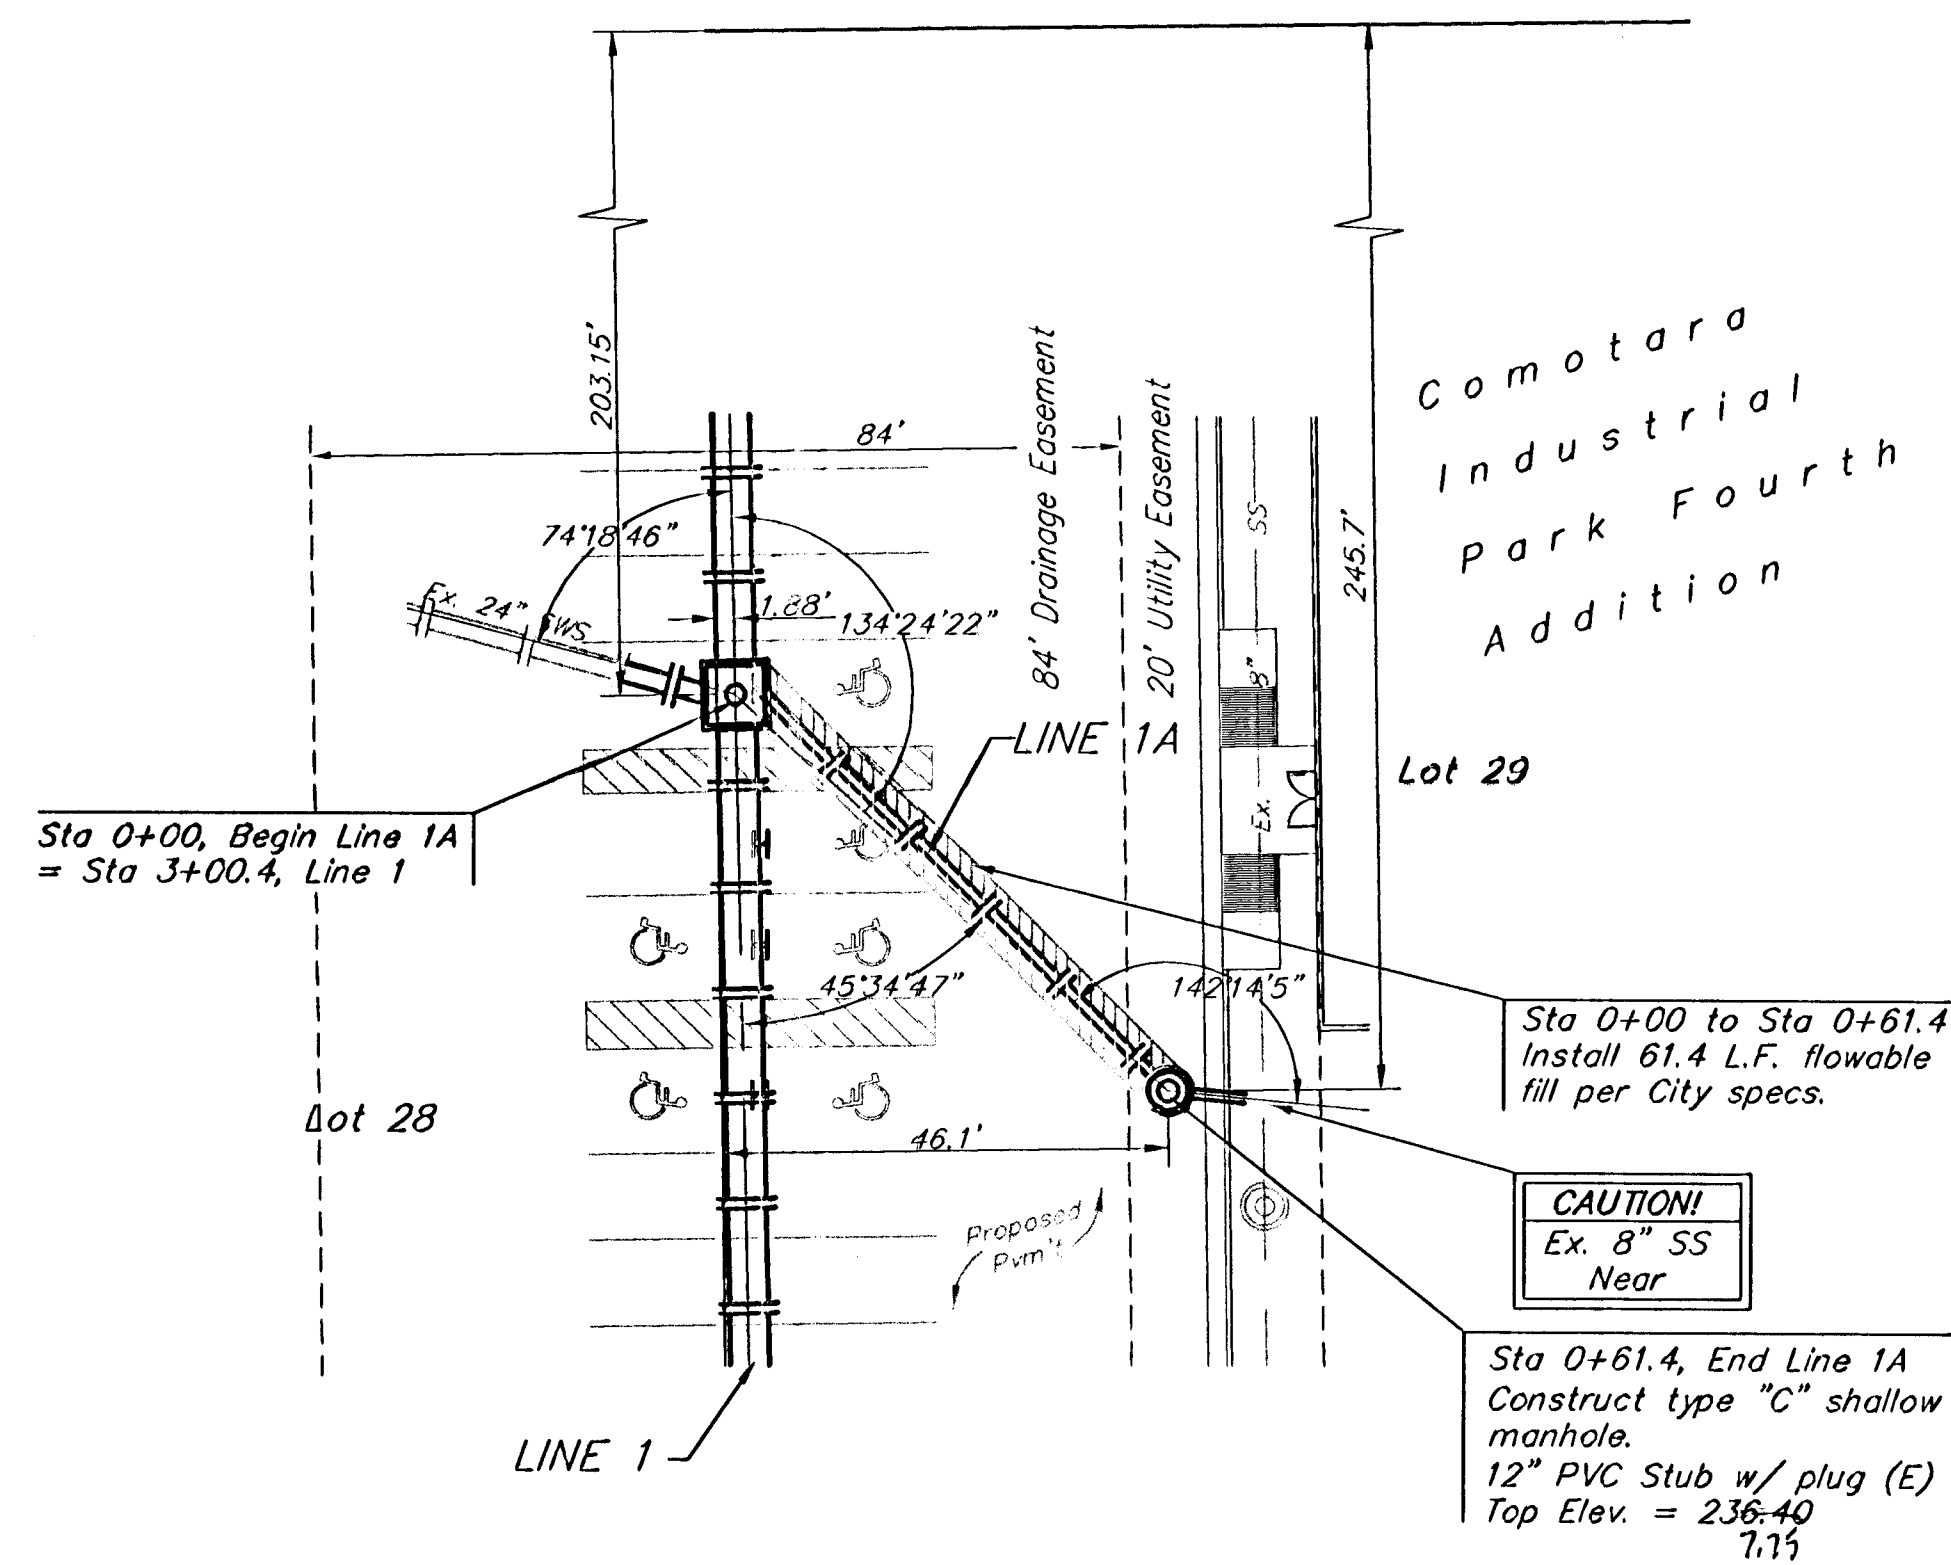

Scale: 1" = 20' Horizontal
1" = 5' Vertical
• = Iron

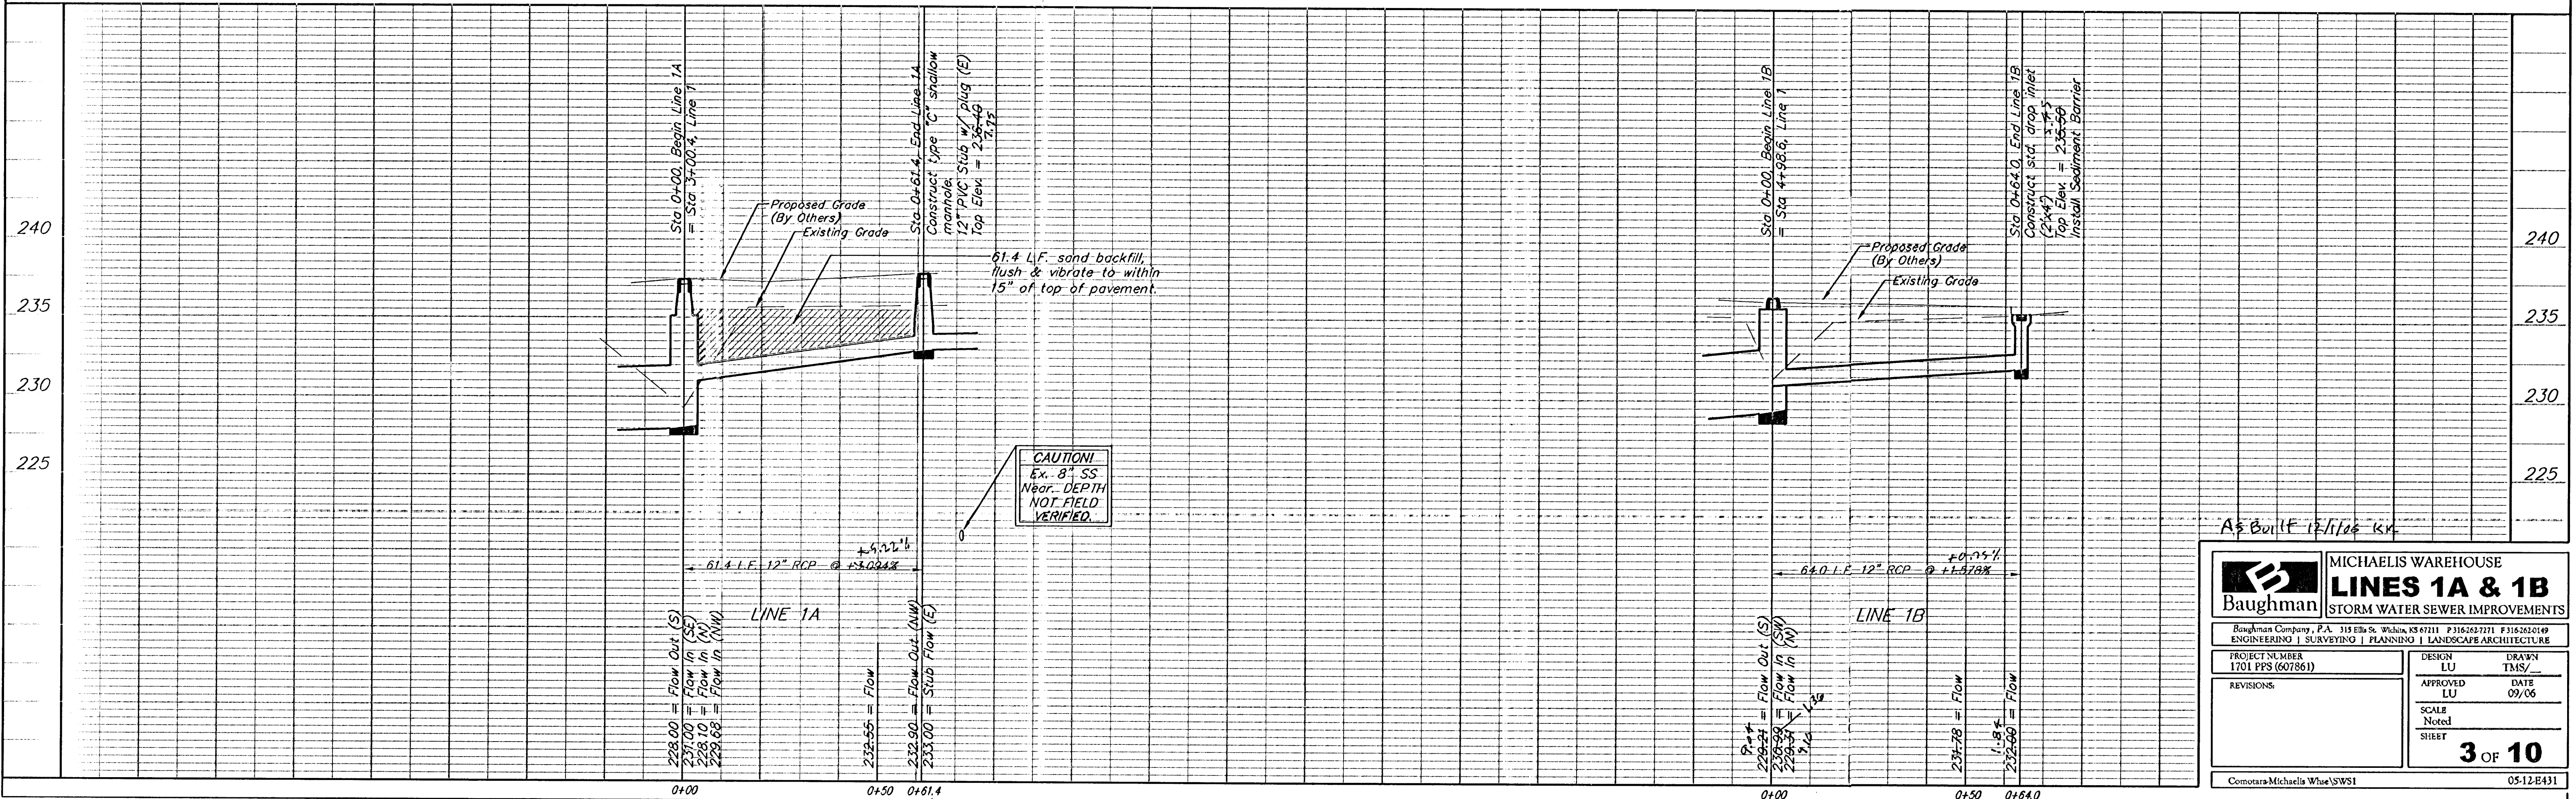

AS BUILT 12/1/06 KS

Baughman MICHAELIS WAREHOUSE
LINES 1A & 1B
STORM WATER SEWER IMPROVEMENTS

Baughman Company, P.A. 315 Ellis St. Wichita, KS 67211 P316323721 P316323721
ENGINEERING | SURVEYING | PLANNING | LANDSCAPE ARCHITECTURE

PROJECT NUMBER 1701 PPS (607861) DESIGN LU DRAWN TMS/
APPROVED LU DATE 09/06
SCALE Noted
SHEET 3 OF 10

Comotara-Michaelis Warehouse/SWS1 05-12-E431