



Bench Mark

R.R. Spike in HLP located at the N.E.
Corner Lot 30, Block 1 Bay Country.
Elev. = 154.44 (City Datum)

"□" Cut in Top of Curb located at the
N.W. Corner Lot 45, Block 1 Bay Country.
Elev. = 153.87 (City Datum)

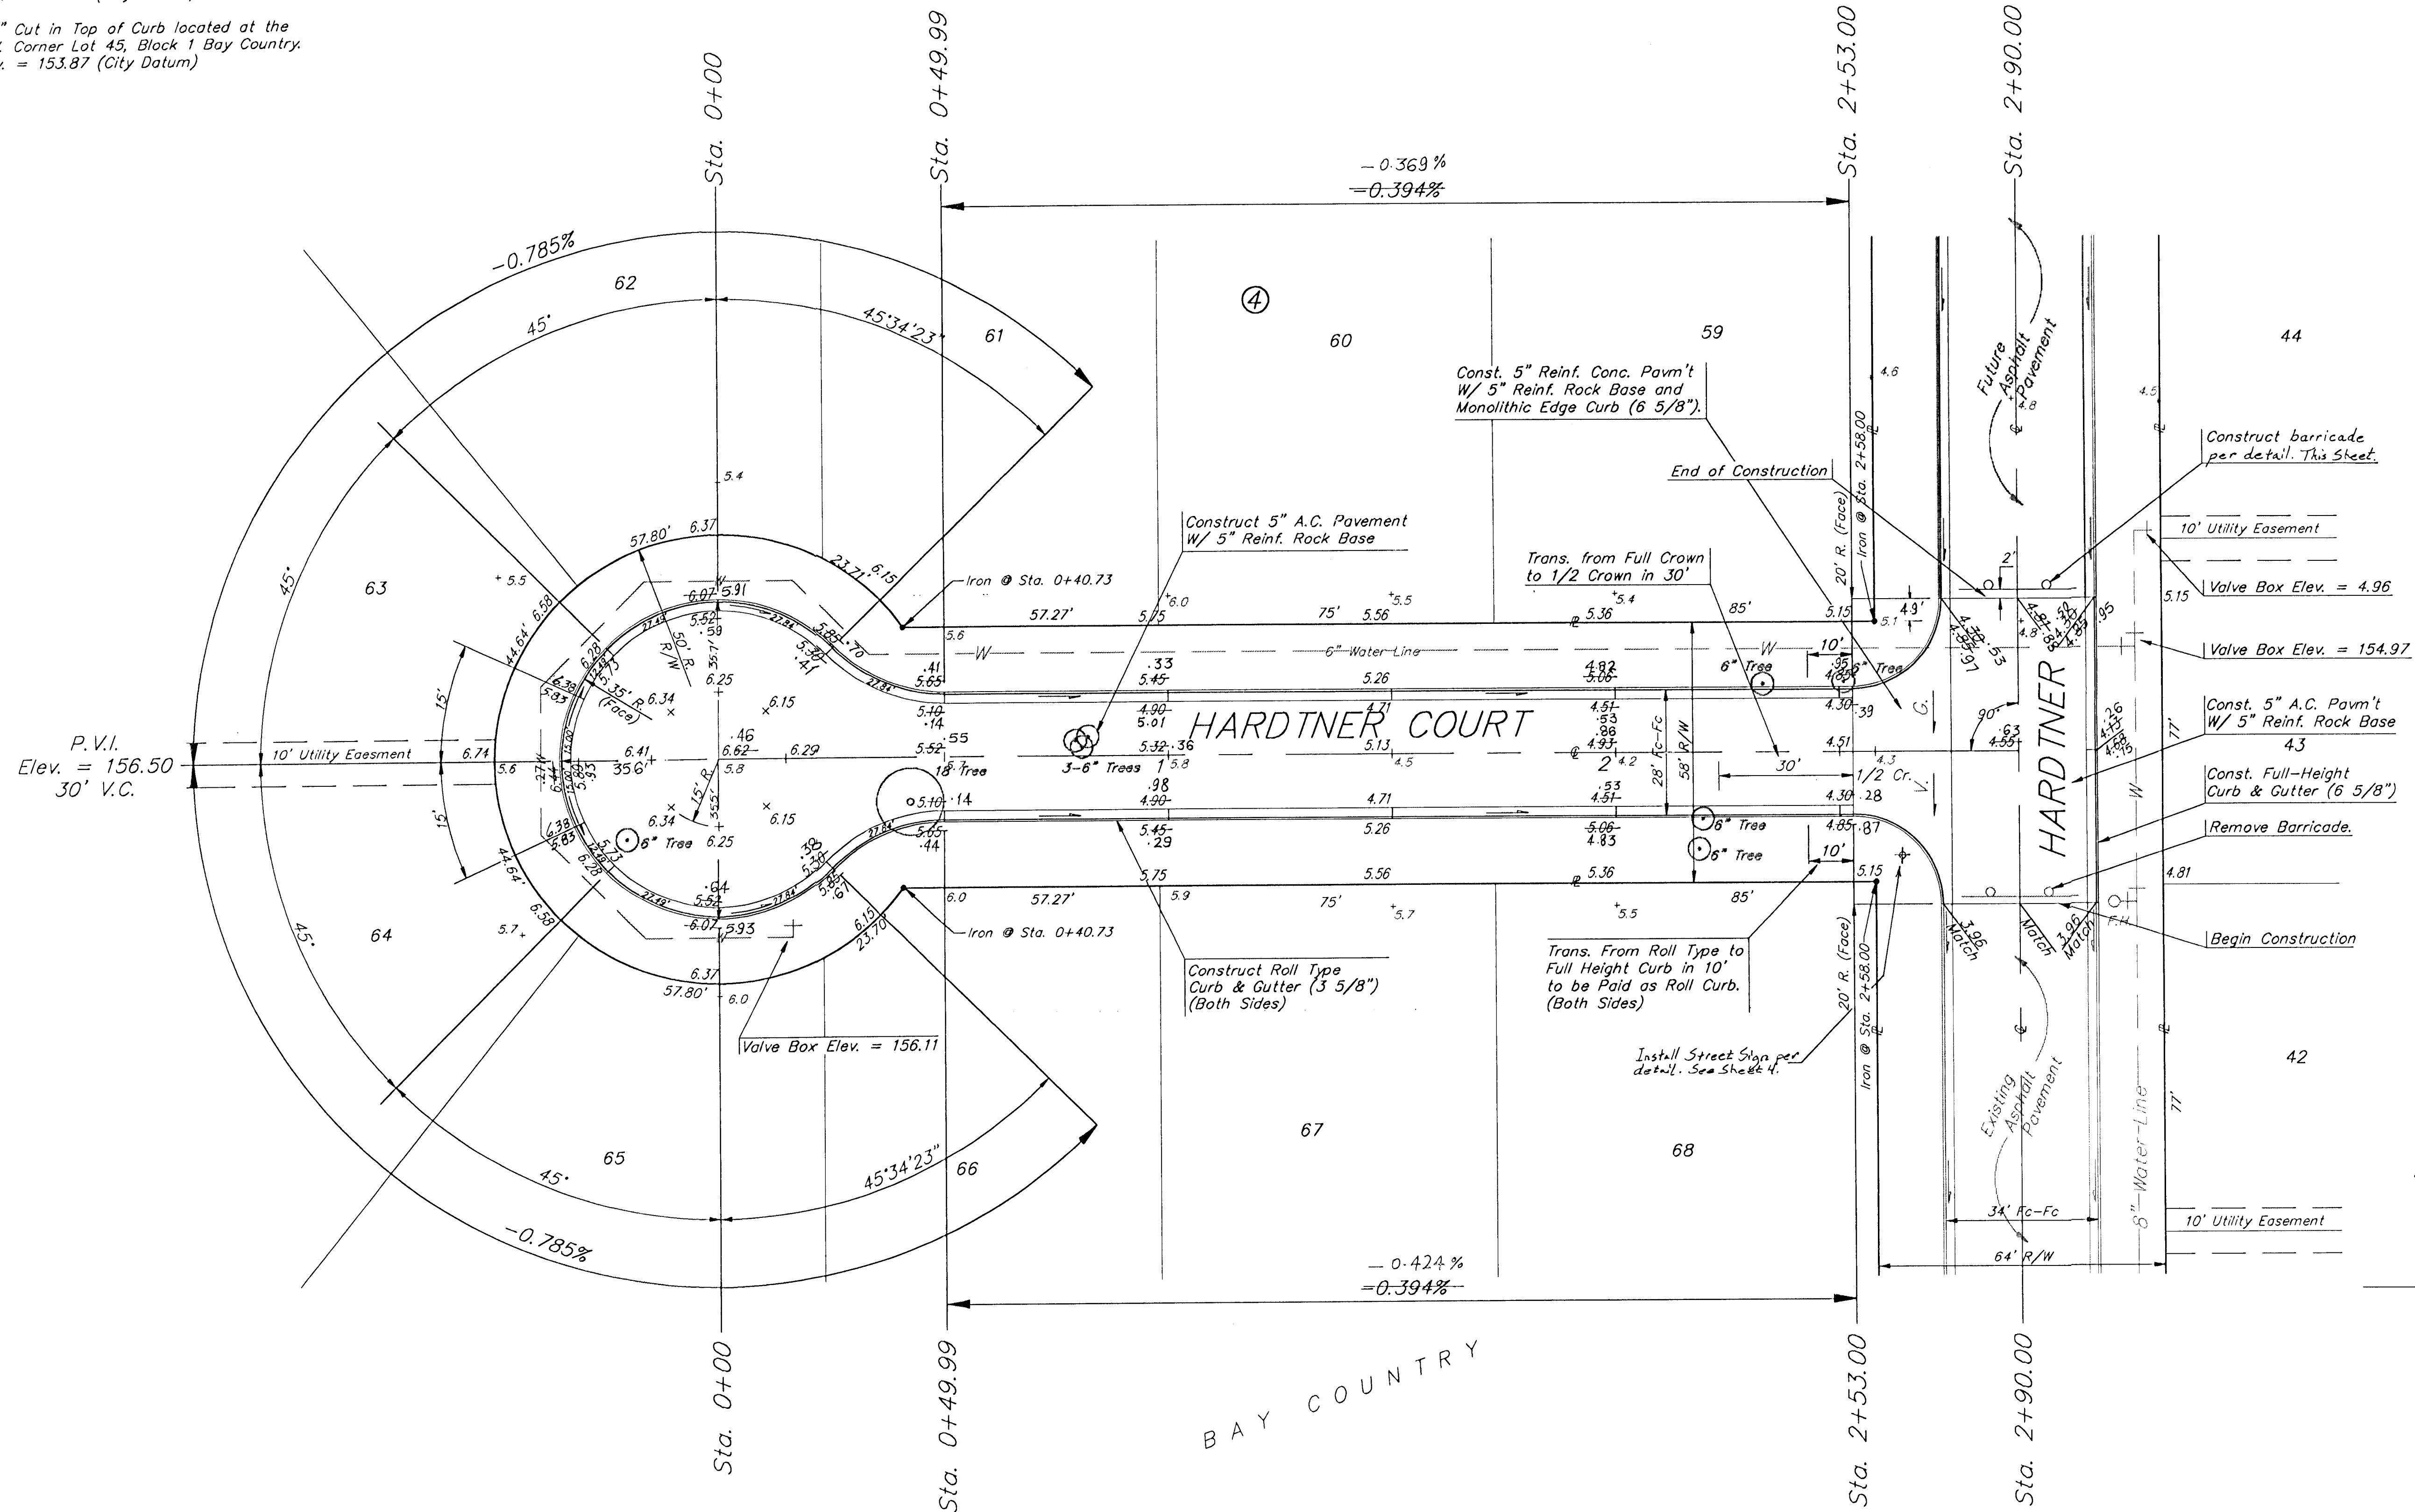

Scale: 1" = 20'-0"
• = Iron

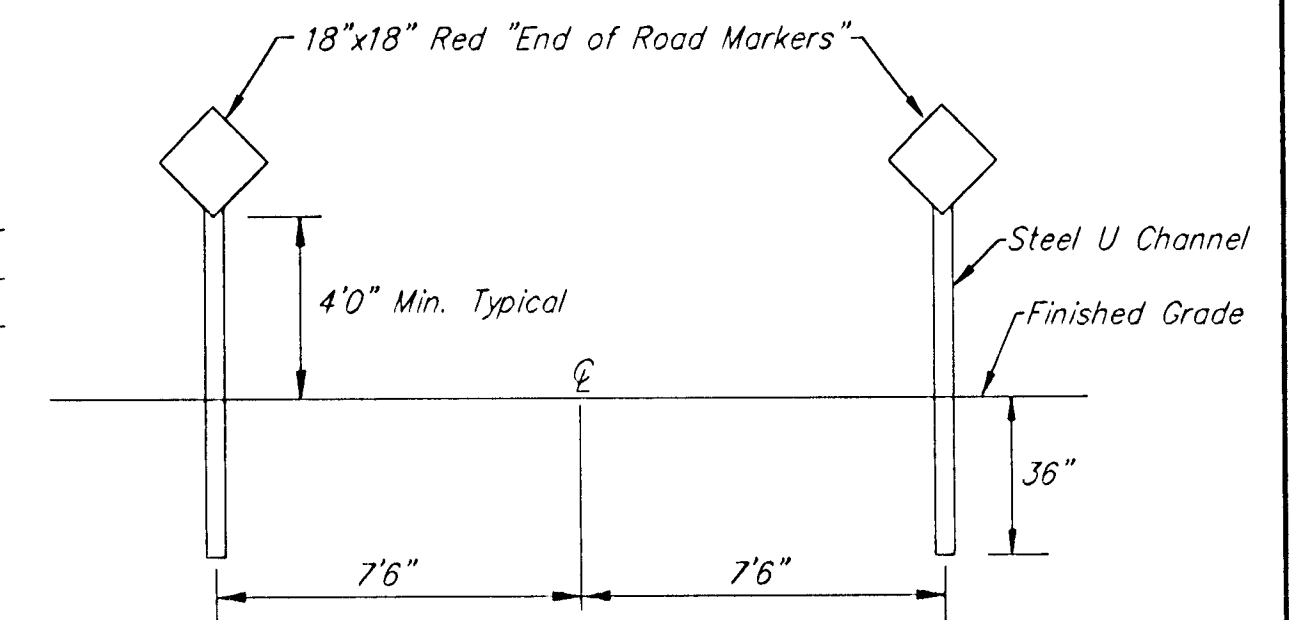

As Built 8-20-93

BAY COUNTRY - PHASE II HARDTNER COURT



BAUGHMAN COMPANY P. A.
ENGINEERING & SURVEYING
316/262-7271 • 315 ELLIS • WICHITA, KANSAS 67211

PROJECT NUMBER
077 PPP (607879)

DESIGN B.P.	DRAWN M.S.P.	UTIL. CHECK'D	DATE April 1993	SCALE 1" = 20'-0"
----------------	-----------------	---------------	--------------------	----------------------

SHEET
3
OF
4