
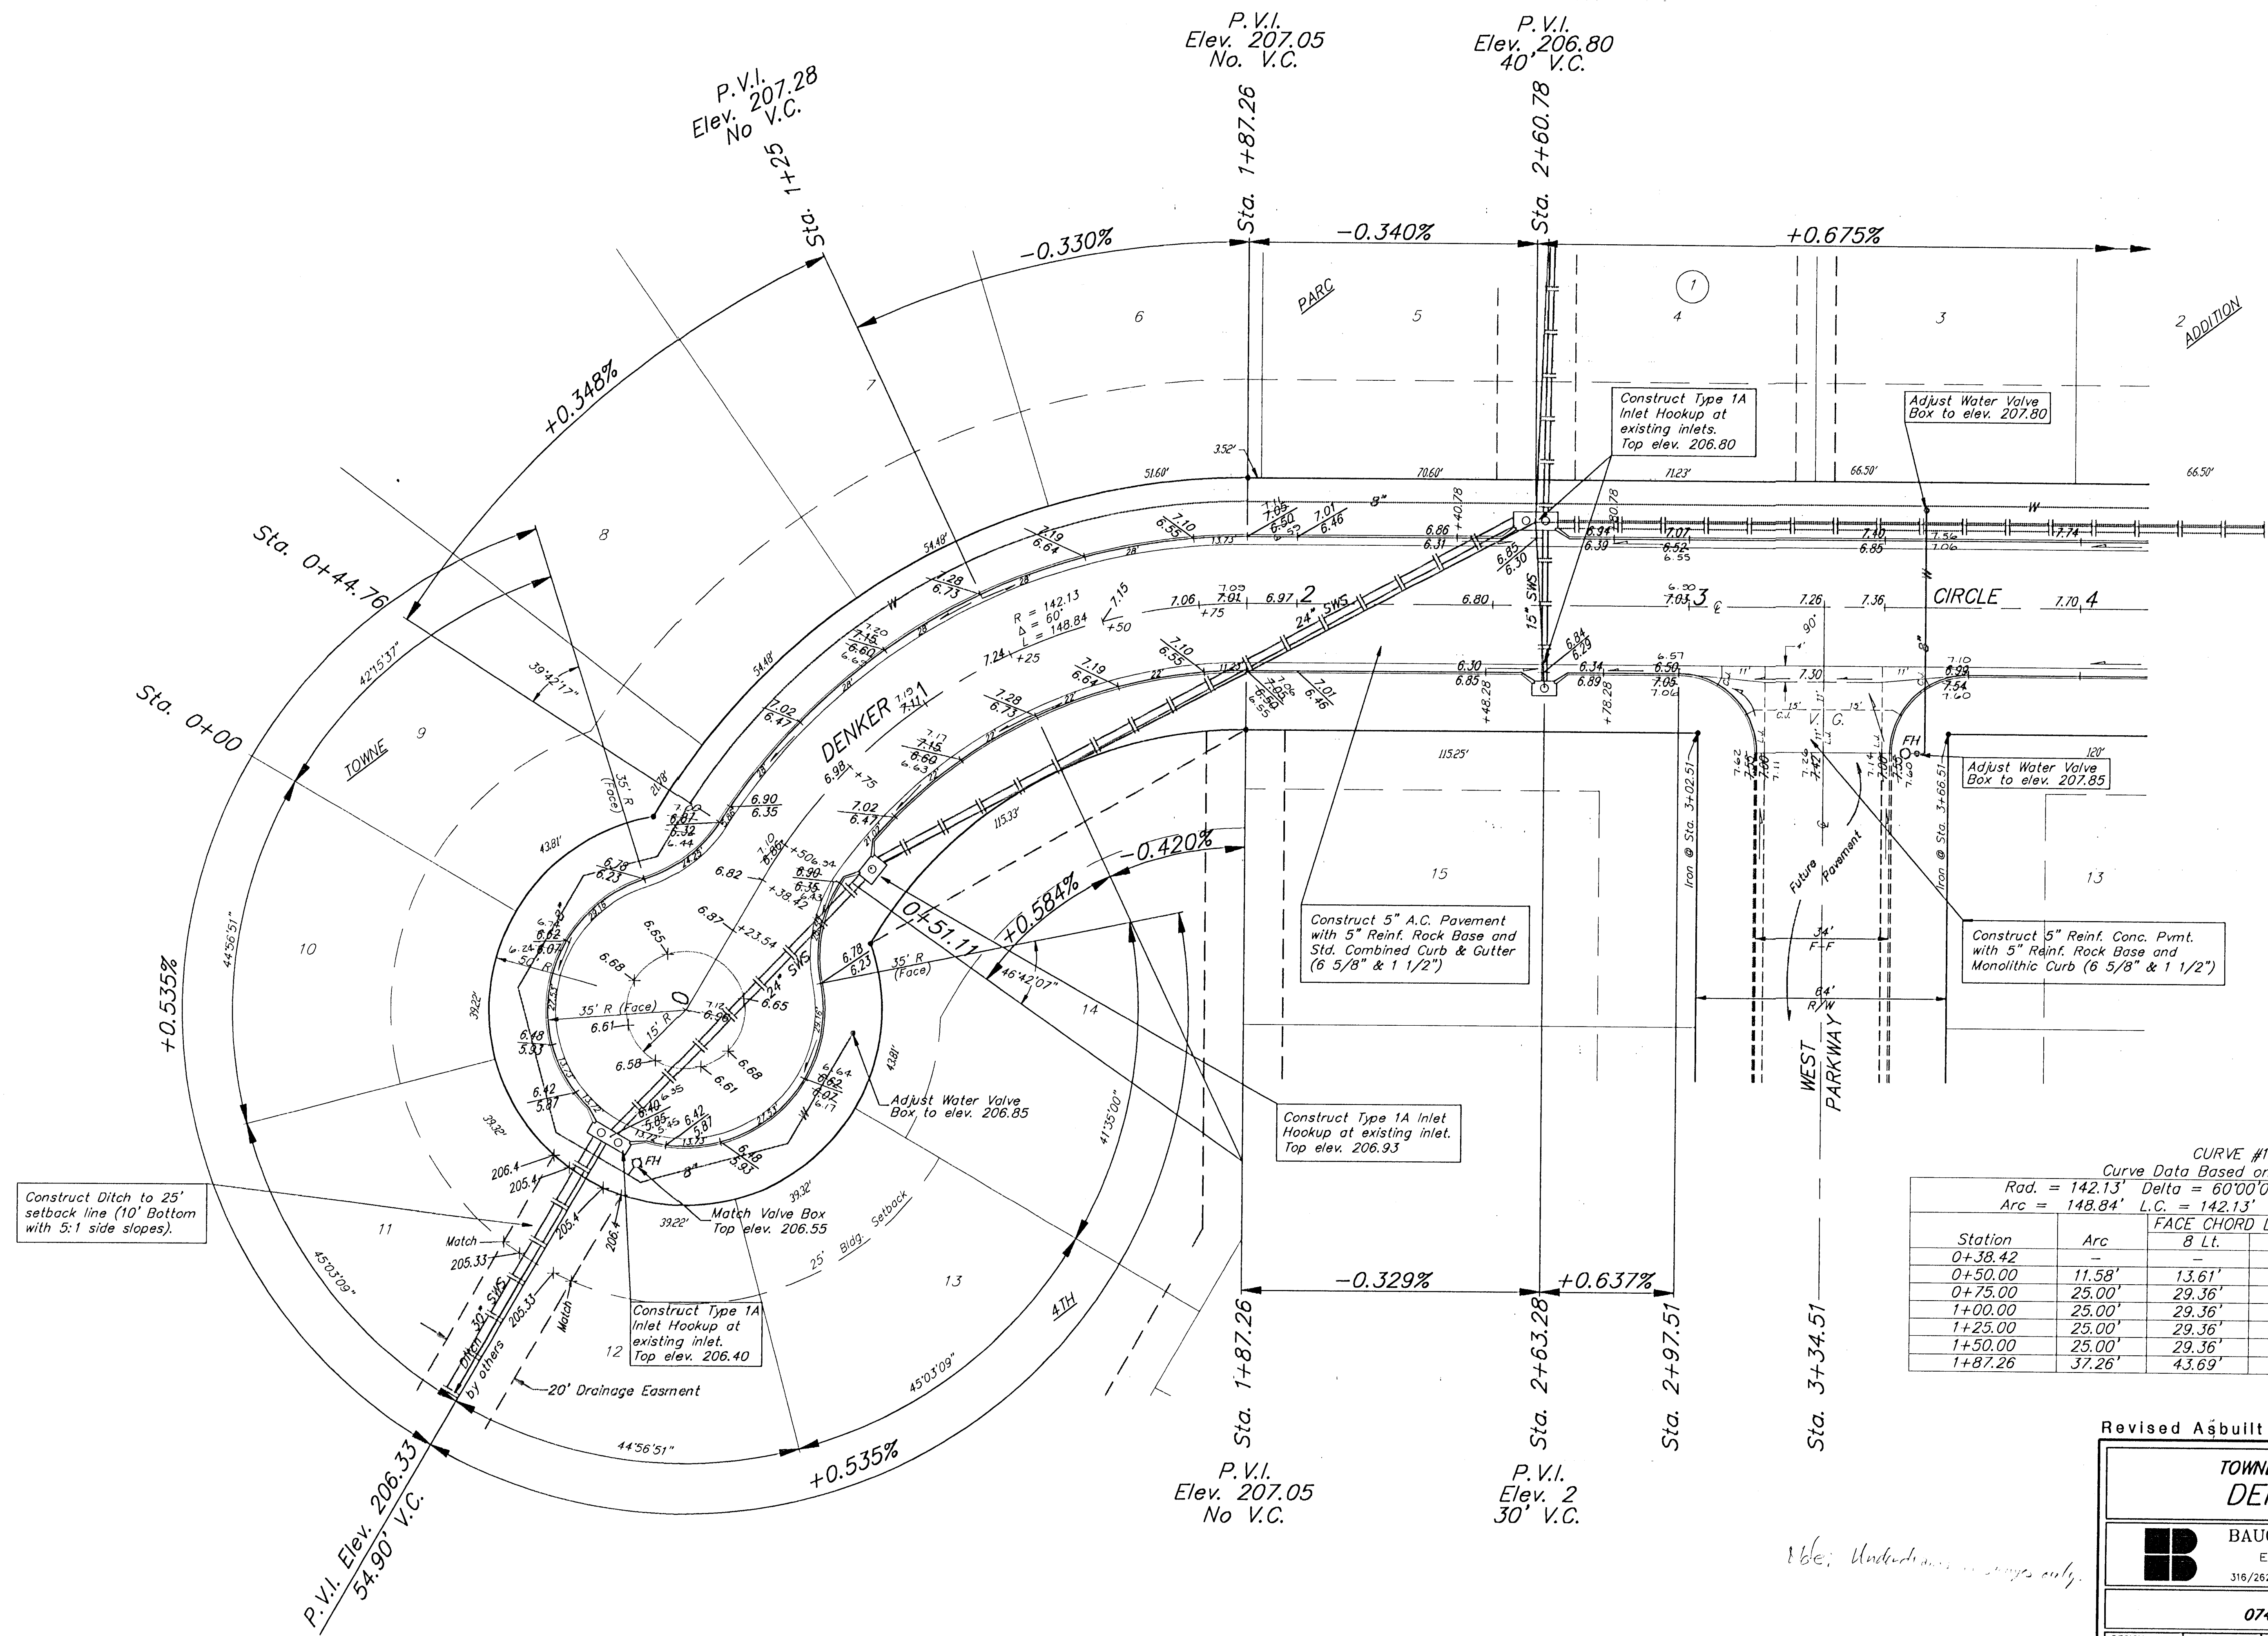


SCALE
1" = 20'

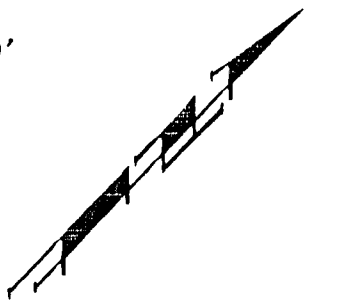

CURVE #1
Curve Data Based on Centerline

Rad. = 142.13' Delta = 60°00'00" Tangent = 82.06'
Arc = 148.84' L.C. = 142.13' Def/Ft. = 12.09352 Min.

Station	Arc	FACE CHORD LENGTHS			
		B Lt.	B Rt.	Def.	T. Def.
0+38.42	-	-	-	0°00'00"	0°00'00"
0+50.00	11.58'	13.61'	9.54'	2°20'02"	2°20'02"
0+75.00	25.00'	29.36'	20.58'	5°02'20"	7°22'23"
1+00.00	25.00'	29.36'	20.58'	5°02'20"	12°24'43"
1+25.00	25.00'	29.36'	20.58'	5°02'20"	17°27'03"
1+50.00	25.00'	29.36'	20.58'	5°02'20"	22°29'24"
1+87.26	37.26'	43.69'	30.62'	7°30'36"	30°00'00"

Revised Asbuilt 3-6-93

**TOWNE PARC 4TH ADDITION
DENKER CIRCLE**

BAUGHMAN COMPANY P. A.
ENGINEERING & SURVEYING
316/262-7271 • 315 ELLIS • WICHITA, KANSAS 67211

PROJECT NUMBER
074 PPP 607879

DESIGN TCR DRAWN GLD UTIL. CHECK'D TCR DATE 10-1-92 SCALE 1" = 20' SHEET 5 OF 11

166: Underdrains in ranges only.