


SCALE
1" = 20'

Construct 5" Reinf. Conc. Pavement
w/5" Reinf. Rock Base) and
Monolithic Curbs (6 5/8").

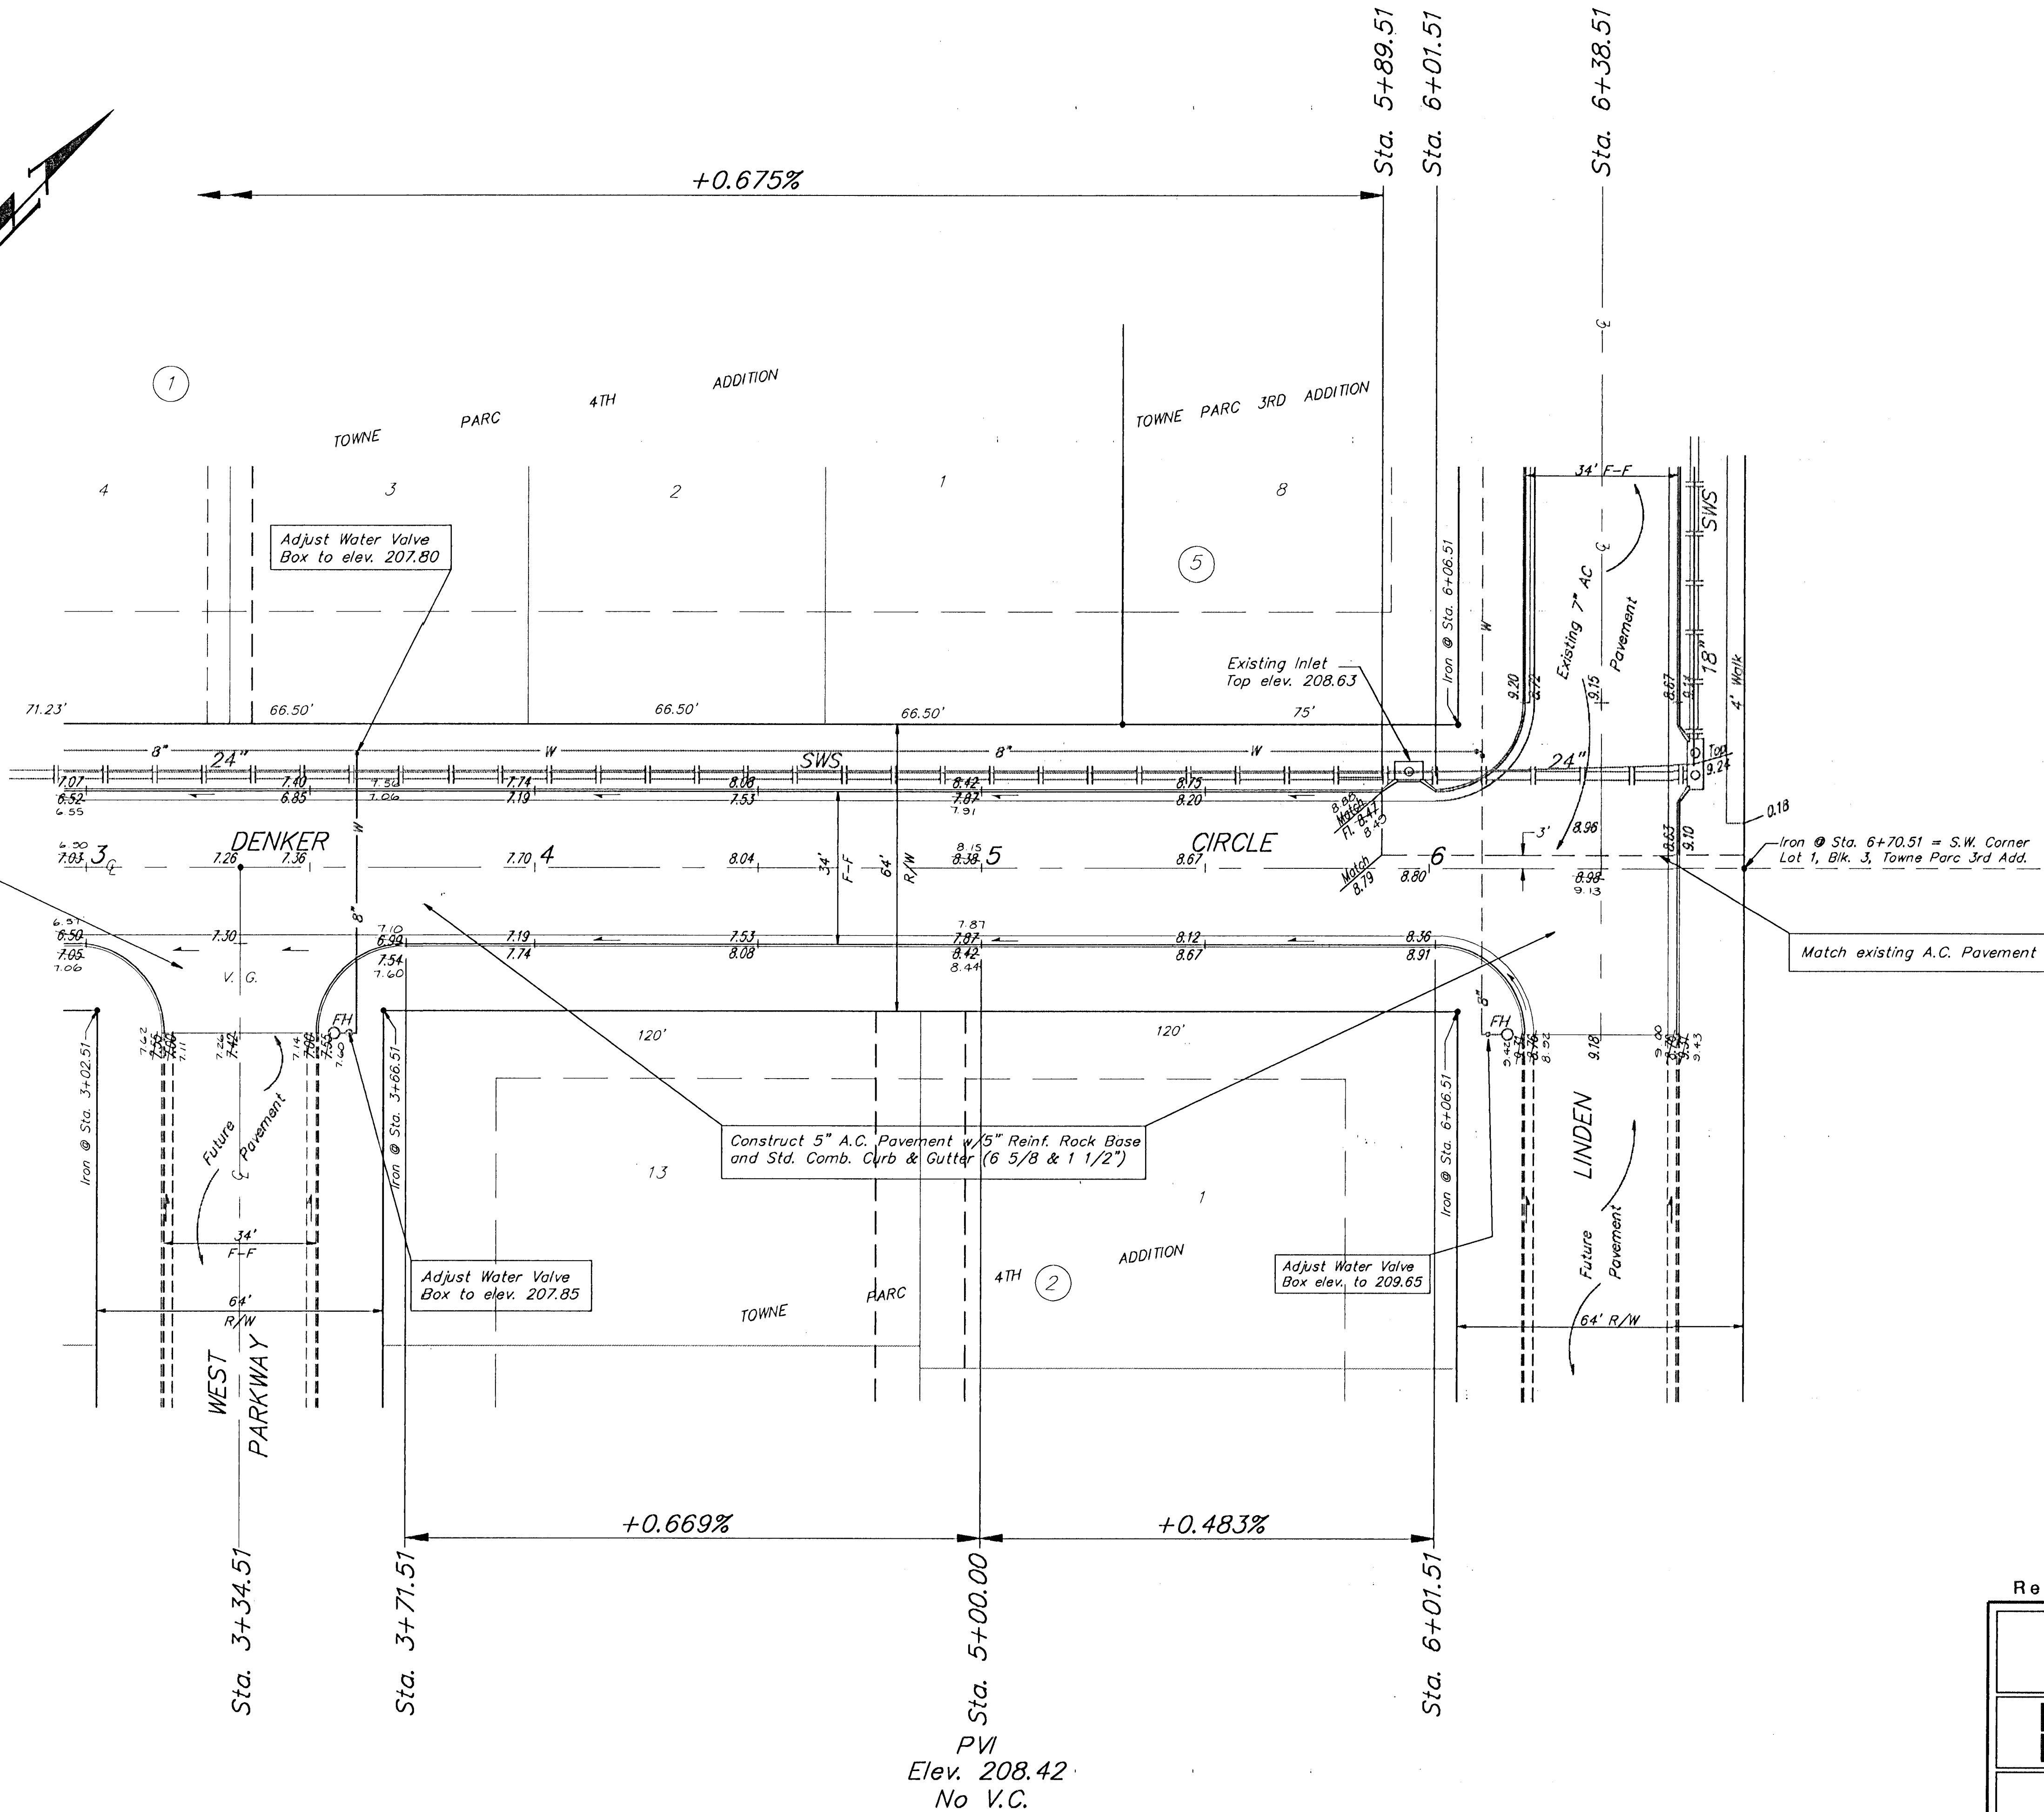

Revised Asbuilt 3-6-93

TOWNE PARC 4TH ADDITION
DENKER CIRCLE



BAUGHMAN COMPANY P. A.
ENGINEERING & SURVEYING
316/262-7271 • 315 ELLIS • WICHITA, KANSAS 67211

PROJECT NUMBER
074 PPP 607879

DESIGN	DRAWN	UTIL. CHECK'D	DATE	SCALE	SHEET
TCR	GLD	TCR	10-1-92	1" = 20'	6

OF
11