

CITY OF WICHITA, KANSAS
NEIL D. CABLE, P.E., CITY ENGINEER
STREET IMPROVEMENTS

INDEX OF SHEETS

- 1. TITLE SHEET
- 2-4. PLAT
- 5-6. TYPICAL SECTIONS
- 7-10. PAVING PLANS - CRANBROOK(Revised)
- 11-12. PAVING PLANS - 19TH ST. N.
- 13-14. PAVING PLANS - 19TH CT. N.
- 15-16. PAVING PLANS - CHURCHILL
- 17. PAVING PLANS - SHADYBROOK
- 18-19. VALLEY GUTTER PLANS AND DETAILS
- 20. MISCELLANEOUS PAVING DETAILS
- 21. CRANBROOK ENTRANCE TYPICAL SECTION AND VALLEY GUTTER PLAN
- 22. STANDARD DRIVE ENTRANCES
- 23. SWS LINE NO. 2
- 24-25. SWS LINE NO. 4
- 26. SWS LINE NO. 5
- 27. STANDARD TYPE 1A CURB INLET (L=5'-0")
- 28. STANDARD AREA INLET AND RIPRAP DETAILS
- 29. TYPE C AREA INLET DETAILS
- 30. FOUR CORNER LOT GRADING PLAN(Revised)
- 31-34. EROSION CONTROL DETAILS
- 35. SIGNING DETAILS
- 36-50. CROSS SECTIONS

CRANBROOK - FROM THE S.L. OF 21st ST. N. TO THE S.L. OF LOT 1, BLOCK 6
CHURCHILL/SHADYBROOK - FROM THE WESTERLY LINE OF CRANBROOK TO
THE W.L. OF LOT 4, BLOCK 1

19th STREET N. - FROM THE W.L. OF 19TH CT. N. TO THE E.L. OF LOT 1, BLOCK 6
19th COURT N. - FROM THE SOUTH LINE OF 19th ST. N. TO AND INCL. THE CUL-DE-SAC
SIDEWALK - ALONG THE W.L. OF CRANBROOK AND S.L. OF 19th STREET N.

GENERAL NOTES

UNDERGROUND UTILITY SERVICE LINES AND OVERHEAD UTILITY POLE LINES ARE TO BE ADJUSTED AS NECESSARY BY OTHERS PRIOR TO CONSTRUCTION UNLESS THE PLANS SPECIFICALLY CALL FOR THEIR ADJUSTMENT BY THE CONTRACTOR. EXISTING UTILITIES AND THEIR LOCATION, AS SHOWN ON THE PLANS, REPRESENT THE BEST INFORMATION OBTAINABLE FOR DESIGN. LOCATION INFORMATION HAS BEEN OBTAINED FROM THE VARIOUS UTILITY COMPANIES AND IS EITHER FROM COMPANY RECORD DRAWINGS OR COMPANY PROVIDED FIELD LOCATIONS. THE CONTRACTOR WILL BE REQUIRED TO WORK AROUND EXISTING UTILITIES WITHIN THE RIGHT-OF-WAY WHICH DO NOT CONFLICT WITH PROPOSED

TREES AND SHRUBS IN PUBLIC RIGHT-OF-WAY WHICH ARE IN DIRECT CONFLICT WITH PROPOSED NEW CONSTRUCTION SHALL BE REMOVED BY THE CONTRACTOR WITH THE ENGINEER'S APPROVAL. TREES AND SHRUBS WHICH ARE NOT IN DIRECT CONFLICT WITH PROPOSED NEW CONSTRUCTION SHALL BE SAVED AND PROTECTED FROM DAMAGE.

BOBBELBROOK. THE REMOVAL OF MISCELLANEOUS STRUCTURES SHALL BE DISPOSED OF ON SITES TO BE PROVIDED BY THE CONTRACTOR AND APPROVED AS NOTED BELOW.

ALL DISPOSAL SITES MUST BE APPROVED BY THE KANSAS DEPARTMENT OF HEALTH AND ENVIRONMENT. MATERIAL EITHER STOCKPILED OR DISPOSED OF IN A FLOOD PLAIN WOULD REQUIRE A KANSAS STATE BOARD OF AGRICULTURE PERMIT. ANY MATERIAL DUMPED IN WATERS OF THE UNITED STATES OR WETLANDS IS SUBJECT TO U.S. CORPS OF ENGINEERS PERMITTING REGULATIONS. ANY MATERIAL BURIED OR STOCKPILED BEYOND APPROVED CONSTRUCTION LIMITS WOULD REQUIRE ADDITIONAL ARCHEOLOGICAL INVESTIGATIONS UNLESS BURIED IN A PREVIOUSLY APPROVED BORROW LOCATION.

CONTRACTOR SHALL SATISFY HIMSELF OF SURFACE AND SUBSURFACE CONDITIONS PRIOR TO BIDDING.

TEMPORARY SURFACING MATERIAL (ROCK, ASPHALT, ETC.) MAY HAVE BEEN PLACED WITHIN STREET RIGHTS-OF-WAY FOR HAUL ROADS AND TEMPORARY ACCESS. CONTRACTOR SHALL FIELD VERIFY EXISTING CONDITIONS TO DETERMINE EXTENT, IF ANY, OF SUCH SURFACING. CONTRACTOR SHALL REMOVE SAID TEMPORARY SURFACING IN THE SAME MANNER AS NOTED ABOVE FOR RUBBLE. THIS REMOVAL SHALL BE SUBSIDIARY TO "EXCAVATION".

CONTRACTOR SHALL PROVIDE A MINIMUM FORTY-FOUR (48) HOUR ADVANCE NOTICE (EXCLUDING WEEKENDS AND HOLIDAYS) PRIOR TO BEGINNING ANY EXCAVATION, TO KANSAS ONE-CALL SYSTEM, A UTILITY LOCATION SERVICE, AT (316) 687-2470 TO REQUEST THE FOLLOWING UTILITY COMPANIES TO LOCATE ALL EXISTING LINES WITHIN THE PROJECT AREA: PEOPLES NATURAL GAS, WESTAR ENERGY, SOUTHWESTERN BELL TELEPHONE, COX COMMUNICATIONS, CITY OF WICHITA SEWER MAINTENANCE AND CITY OF WICHITA WATER DEPARTMENT.

THE CONTRACTOR SHALL BE RESPONSIBLE FOR PRESERVING PROPERTY IRONS. THE CONTRACTOR WILL BE REQUIRED TO RE-ESTABLISH ANY PROPERTY IRONS WHICH ARE DAMAGED OR DESTROYED BY HIS CONSTRUCTION OPERATIONS. SUCH IRONS SHALL BE RE-ESTABLISHED BY A LICENSED LAND SURVEYOR IN ACCORDANCE WITH STATE LAWS.

THE WATER DEPARTMENT SHALL FIELD LOCATE WATER VALVES ONE TIME DURING CONSTRUCTION WHEN REQUESTED BY THE CONTRACTOR. IT SHALL BE THE CONTRACTOR'S RESPONSIBILITY TO PRESERVE SUCH FIELD LOCATIONS DURING THE CONSTRUCTION PROCESS. WATER VALVES, WATER VALVE BOXES OR FIRE HYDRANTS DAMAGED DURING CONSTRUCTION SHALL BE REPAIRED BY THE CONTRACTOR AT HIS OWN EXPENSE.

THE CONTRACTOR SHALL ADJUST WATER VALVE BOXES AS DIRECTED BY THE ENGINEER. THIS WORK TO BE SUBSIDIARY TO OTHER BID ITEMS.

INLET HOOKUPS SHALL BE BID PER EACH REGARDLESS OF INLET SIZE.

THE CONTRACTOR SHALL APPLY TEMPORARY SEED AND MULCH TO ALL UNPAVED AREAS DISTURBED BY HIS CONSTRUCTION OPERATIONS IN ACCORDANCE WITH THE CITY OF WICHITA SPECIFICATIONS. THIS WORK SHALL BE PAID FOR AT THE CONTRACT LUMP SUM PRICE BID FOR "TEMPORARY SEEDING".

THE CONTRACTOR SHALL APPLY PERMANENT SEED, FERTILIZER, AND MULCH TO THE STREET RIGHT-OF-WAYS, AND UTILITY EASEMENTS IN ACCORDANCE WITH STANDARD SPECIFICATIONS. SEED SHALL BE K-31 FESCUE APPLIED AT THE RATE OF 350 LBS. PER ACRE. FERTILIZER SHALL BE 12-24-12 APPLIED AT THE RATE OF 350 LBS. PER ACRE. MULCH SHALL BE PRAIRIE HAY APPLIED AT THE RATE OF 15 BALES PER ACRE. THIS WORK SHALL BE PAID FOR AT THE CONTRACT PRICE BID PER ACRE FOR "PERMANENT SEEDING".

EROSION CONTROL (BMP'S)
THE CONTRACTOR SHALL INSTALL AND/OR MAINTAIN EROSION CONTROL METHODS AS SPECIFIED ON SHEET 31. THE FOLLOWING QUANTITIES ARE ESTIMATED, AND SHOULD BE CONSIDERED THE MINIMUM EFFORT REQUIRED. INSTALLATION OF THESE BMP'S DOES NOT RELIEVE THE CONTRACTOR OF THE RESPONSIBILITY OF ABATING SOIL EROSION.

INLET PROTECTION	8 EACH
SILT FENCE BARRIER	2000 L.F.
CONSTRUCTION ENTRANCE	1 EACH
BACK OF CURB PROTECTION	7600 L.F.

LOT GRADING AND COORDINATION
THE CONTRACTOR SHALL BE REQUIRED TO WORK AROUND HOUSE CONSTRUCTION CONCURRENTLY UNDERWAY AND COORDINATE WITH THE HOME BUILDERS AND DEVELOPER ON ACCES AND LOT GRADING ISSUES.

BENCHMARK LIST

- BM #1 - "I" POST IN EAST-WEST TREE ROW NEAR THE SOUTHEAST CORNER OF LOT 12, BLOCK 4, REMINGTON PLACE. ELEV. = 205.595
- BM #2 - "I" POST 40' NORTH AND 6' WEST OF THE SOUTHEAST CORNER OF LOT 7, BLOCK 6, REMINGTON PLACE. ELEV. = 209.525
- BM #4 - "I" POST 75' NORTH AND 12' EAST OF LOT 6, BLOCK 3, REMINGTON PLACE. ELEV. = 210.405
- BM #1-A - "I" POST 5' EAST OF THE NORTHWEST CORNER OF LOT 1, BLOCK 4, REMINGTON PLACE. ELEV. = 209.92
- BM #1-B - "I" POST 5' EAST OF THE EAST RIGHT-OF-WAY OF CRANBROOK AND 110' SOUTH OF THE SOUTH RIGHT-OF-WAY OF 21ST STREET NORTH. ELEV. = 209.645
- BM #6-4 - SET "I" POST IN LOT 6, BLOCK 4, REMINGTON PLACE. 5' WEST OF NORTHEAST CORNER LOT 6, BLOCK 4, REMINGTON PLACE. ELEV. = 203.21
- BM #14-7 - SET "I" POST IN LOT 14, BLOCK 7, REMINGTON PLACE. 10' WEST OF P.C. COURT. ELEV. = 206.155
- BM #17-3 - FOUND CITY OF WICHITA STREET CURB DISC IN LOT 17, BLOCK 3, REMINGTON PLACE, ON TOP BACK OF CURB AT EAST END OF EXISTING STREET. ELEV. = 209.33
- BM #49-7 - SET "I" POST IN LOT 49, BLOCK 7, REMINGTON PLACE, 10' NORTH OF P.C. COURT. ELEV. = 211.085
- BM "L" - SET "I" POST IN RESERVE "L", 35' NORTHWEST OF WEST CORNER LOT 4, BLOCK 5, REMINGTON PLACE AND NORTHEASTERLY 10' OF CRANBROOK RIGHT-OF-WAY. ELEV. = 212.56

SUBDIVISION BENCH MARK (SBM)				
NO.	STREET AND STATION	FROM &	DESCRIPTION	ELEVATION
1	19TH CT. N. STA. 50+37	14' RT.	TOP OF CURB ON W. SIDE 19TH CT. N. AT P.T. OF RETURN, 37' S. OF & 19TH ST. N.	209.61
2	19TH CT. N. STA. 55+43.77	14' RT.	TOP OF CURB ON W. SIDE 19TH CT. N. AT P.C. OF CURB TO CUL-DE-SAC, 544± S. OF & 19TH ST. N.	209.69
3	CRANBROOK STA. 42+32.42	17' LT.	TOP OF CURB ON W. SIDE CRANBROOK AT P.C. OF RETURN	211.13
4	CRANBROOK STA. 48+44	17' RT.	TOP OF CURB ON E. SIDE CRANBROOK AT SWS CURB INLET	214.82
5	CRANBROOK STA. 54+15	17' RT.	TOP OF CURB ON E. SIDE CRANBROOK AT SWS CURB INLET	210.93
6	CHURCHILL STA. 95+78.72	14' LT.	TOP OF CURB ON S. SIDE CHURCHILL AT P.T. OF RETURN	214.25

THE COST OF THE BENCH MARK DISC, INCLUDING INSTALLATION, SHALL BE INCIDENTAL TO THE CURB.

EARTHWORK

EXCAVATION 22,711 CU. YDS.
COMPACTED FILL 6,269 CU. YDS.
BORROW EXCAVATION 18,200 CU. YDS.
(ON-SITE, FROM RESERVE "L")


PROJECT LENGTH = 4,047 L.F.

28,147 C.Y. REQUIRED FOR LOOSE FILL WITHIN R/W AND FOR LOT GRADING. ALL FILL TO BE COMPACTED TO 90% STD. DENSITY.

11,705 C.Y. BORROW EXCAVATION TO BE TAKEN FROM RESERVE "L", ON-SITE FUTURE POND LOCATION, AND TO BE USED FOR LOT GRADING WITHIN THE IMPROVEMENT DISTRICT BOUNDARY. 6,495 C.Y. BORROW EXCAVATION TO BE TAKEN FROM RESERVE "L" FOR LOT FILL WITHIN C.O.W. PROJECT NO. 472-83377. SEE CROSS SECTIONS AND SH. NO. 30

SEE SH. NO. 30 FOR LOT GRADING PLAN.


REMINGTON PLACE - PHASE 2
CITY OF WICHITA PROJECT NO. 472-83376
OCA NO. 765763

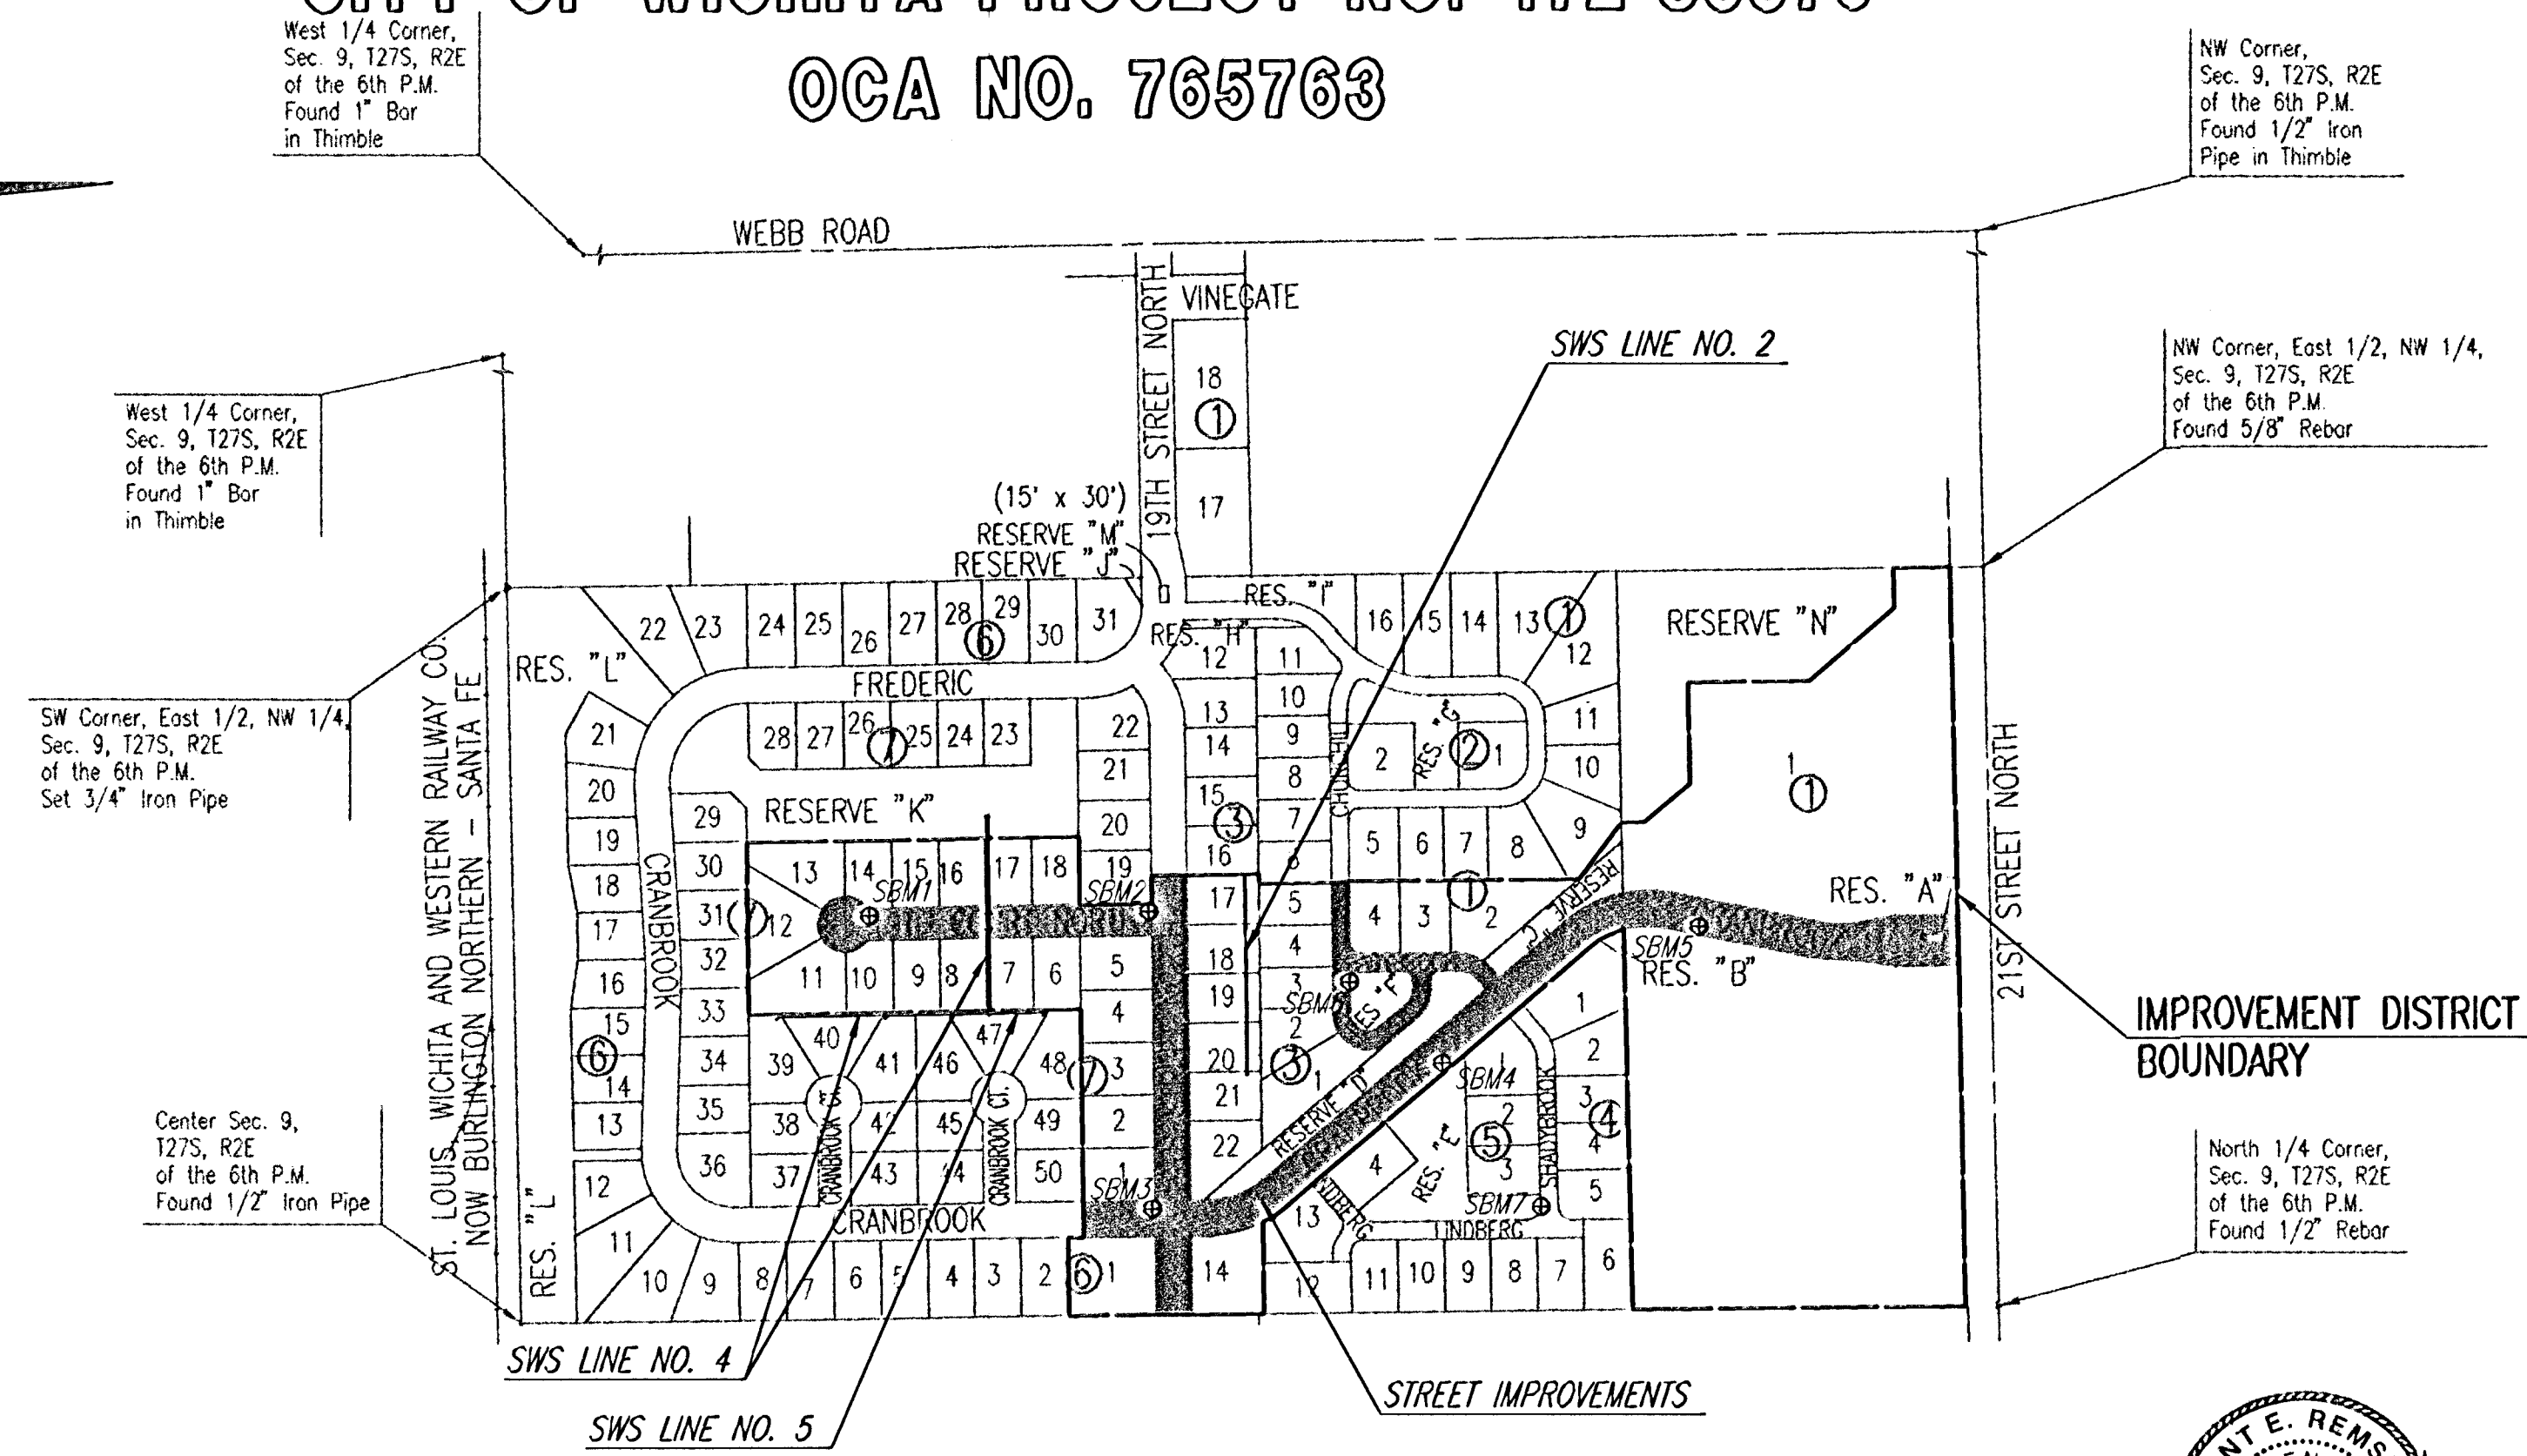

DECEMBER, 2002

PLANS PREPARED BY

PROFESSIONAL ENGINEERING CONSULTANTS, P.A.
ENGINEERS
WICHITA, KANSAS

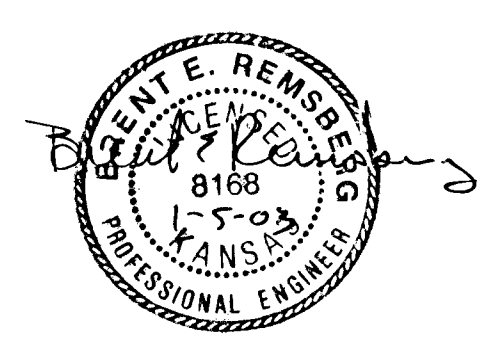

RECORD DRAWING

24 NOV 03

