
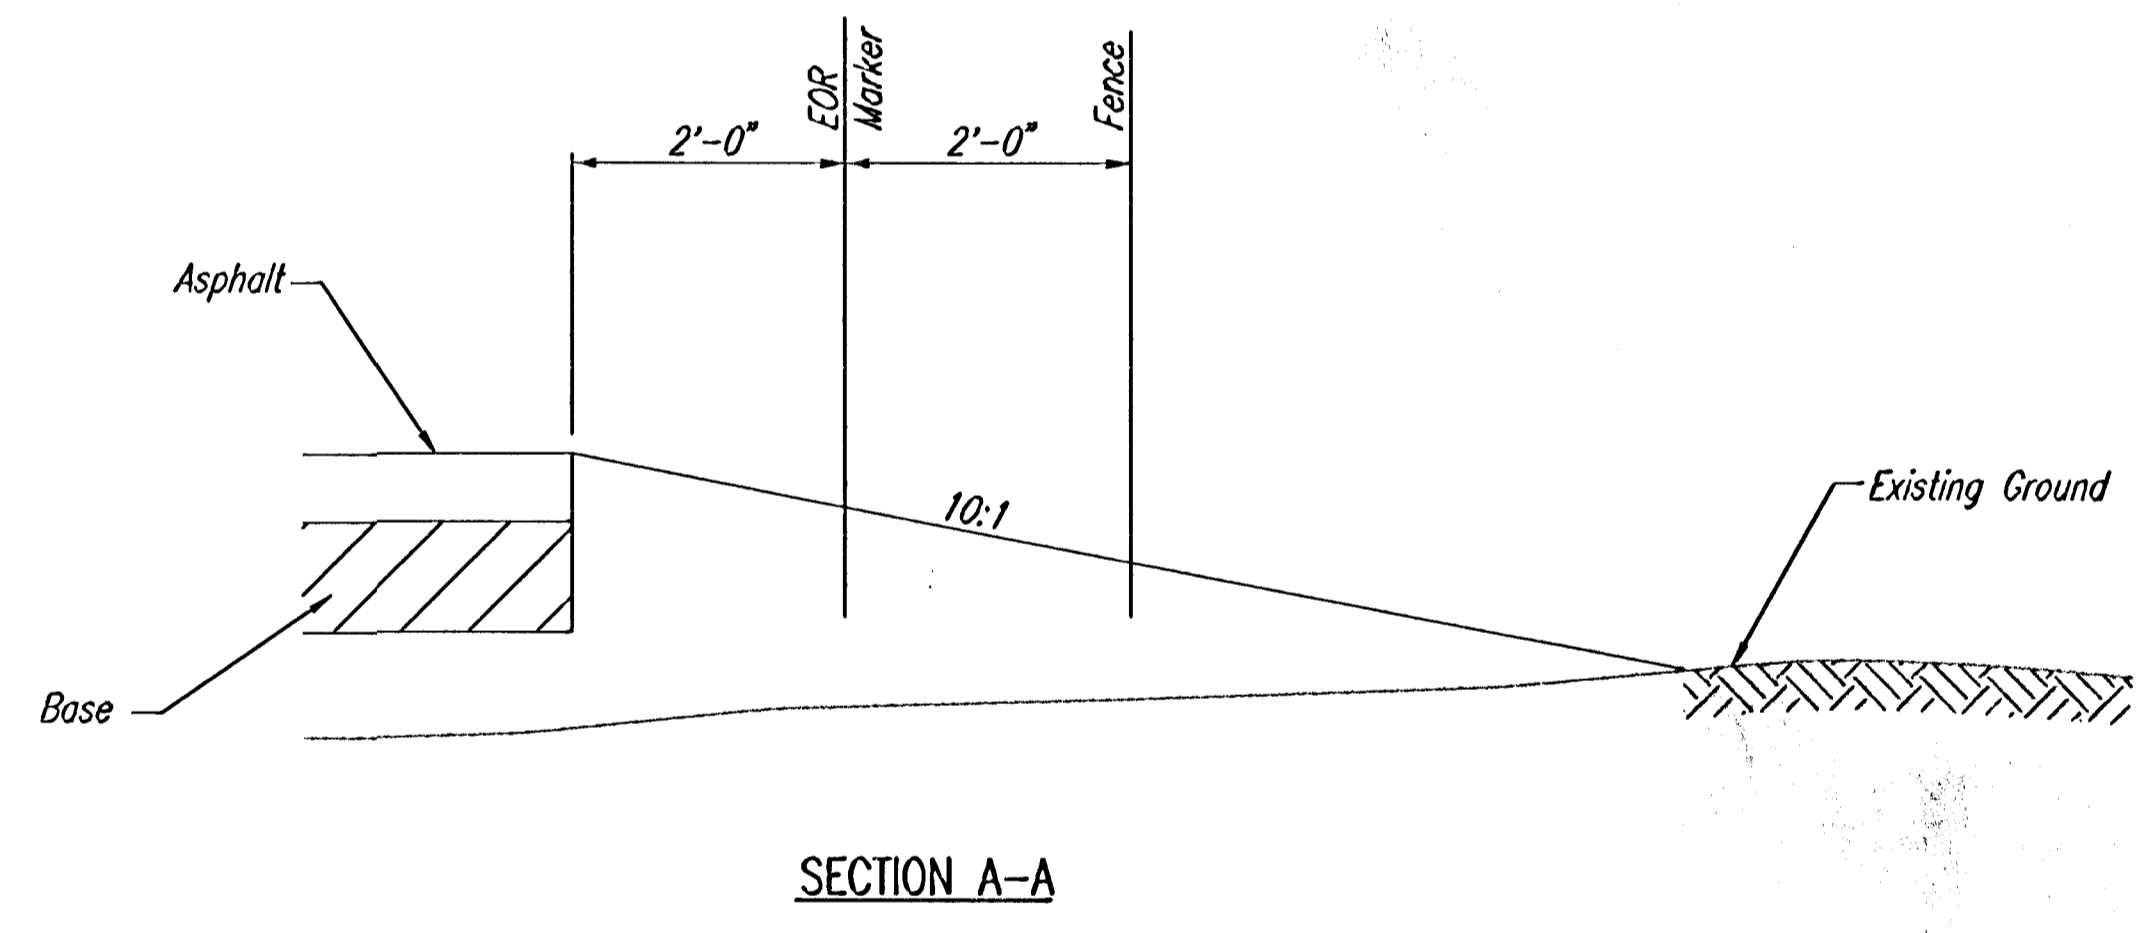


PROJECT NO.	SHEET NO.	TOTAL SHEETS
472-83376	12	50

WATER VALVE BOX ELEVATIONS			
STREET	STATION	OFFSET	PROPOSED ELEVATION
19TH STREET NORTH	70+41.25	29.0'LL	212.1
19TH STREET NORTH	71+67.44	26.0'LL	212.1
19TH STREET NORTH	71+87.44	26.0'LL	210.9

SCALE: 1"=20'

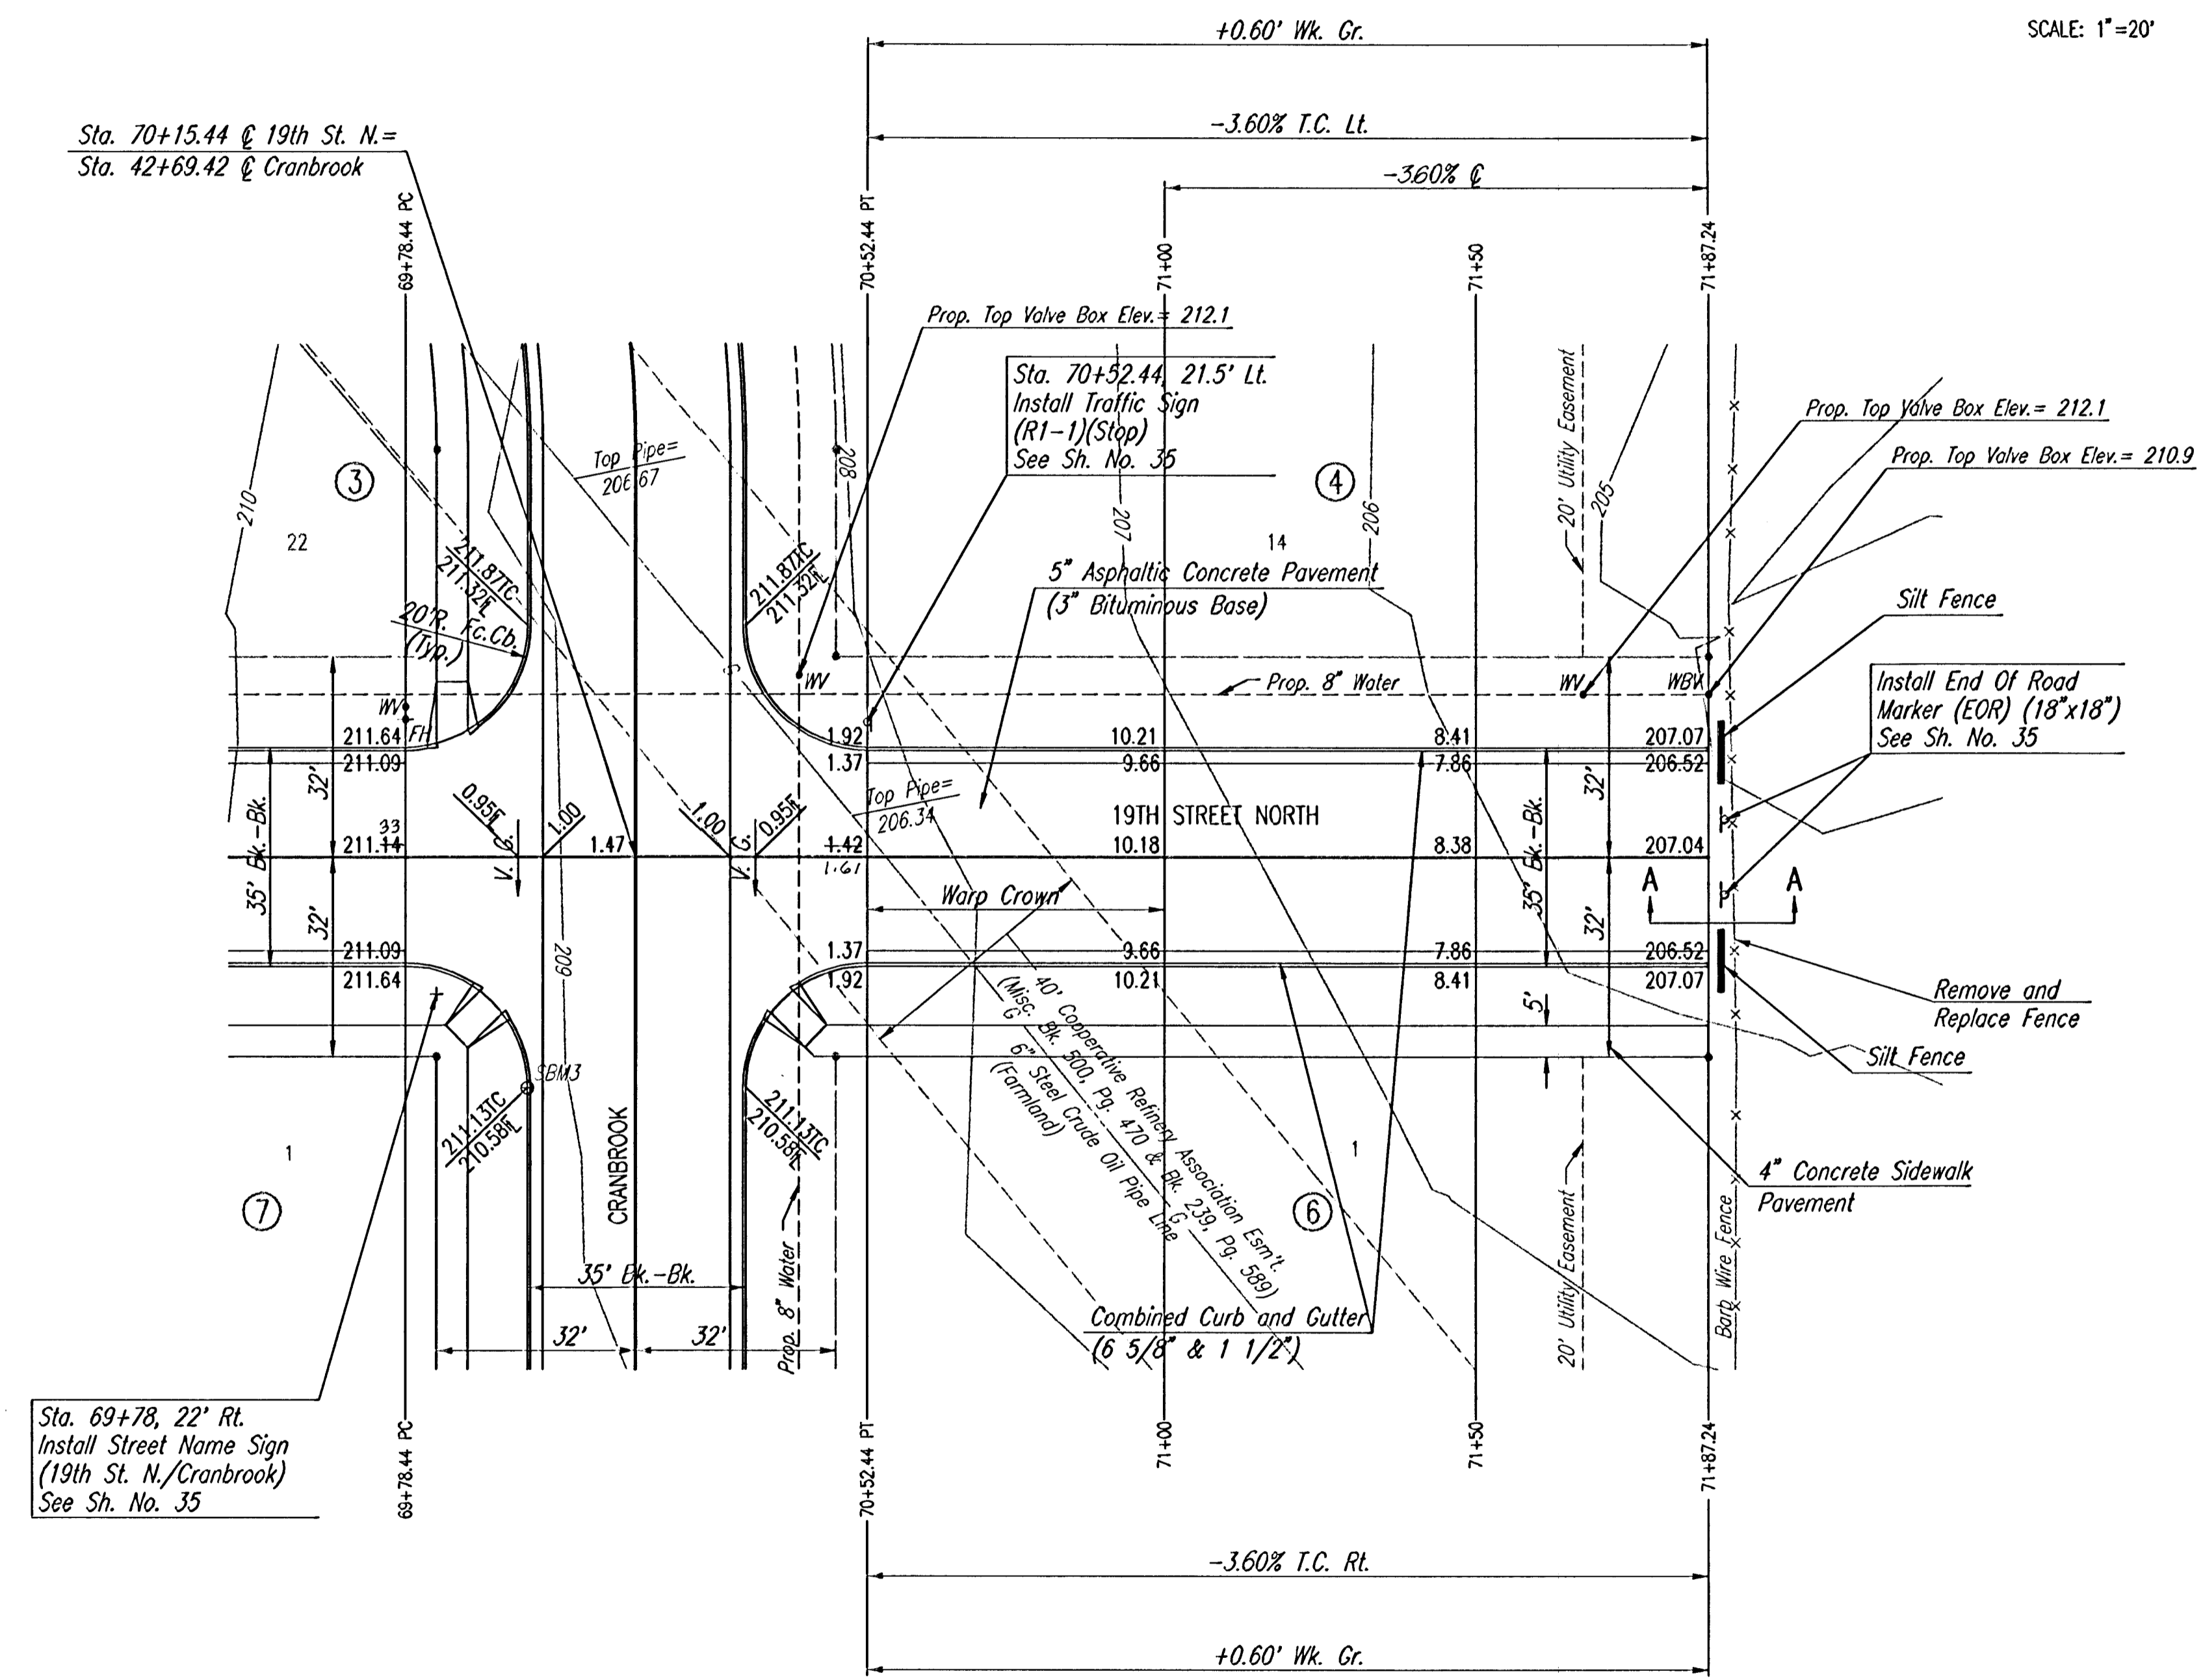

DSNR: S:\D OPER: S\O SCALE: 1"=20.00  
 C:\2002\02398\000\19THS2 01-13-2003 12:21:49 am

**RECORD DRAWING**

*Bud Egan* 24 NOV 03  
 REMINGTON PLACE - PHASE 2

**19TH STREET NORTH**  
 STA. 69+78.44 TO STA. 71+87.24

**Professional Engineering Consultants, P.A.**  
 303 S. TOPEKA • WICHITA, KANSAS 67202  
 316-262-2691 • FAX 316-262-3003

Designed by	BER	Checked by	
Drawn by	DEP	Date	DEC., 2002
		Job No.	02398