


PROJECT NO.	SHEET NO.	TOTAL SHEETS
472-83376	14	50

WATER VALVE BOX ELEVATIONS			
STREET	STATION	OFFSET	PROPOSED ELEVATION
19TH STREET COURT	55+87	39.73' RL	210.2

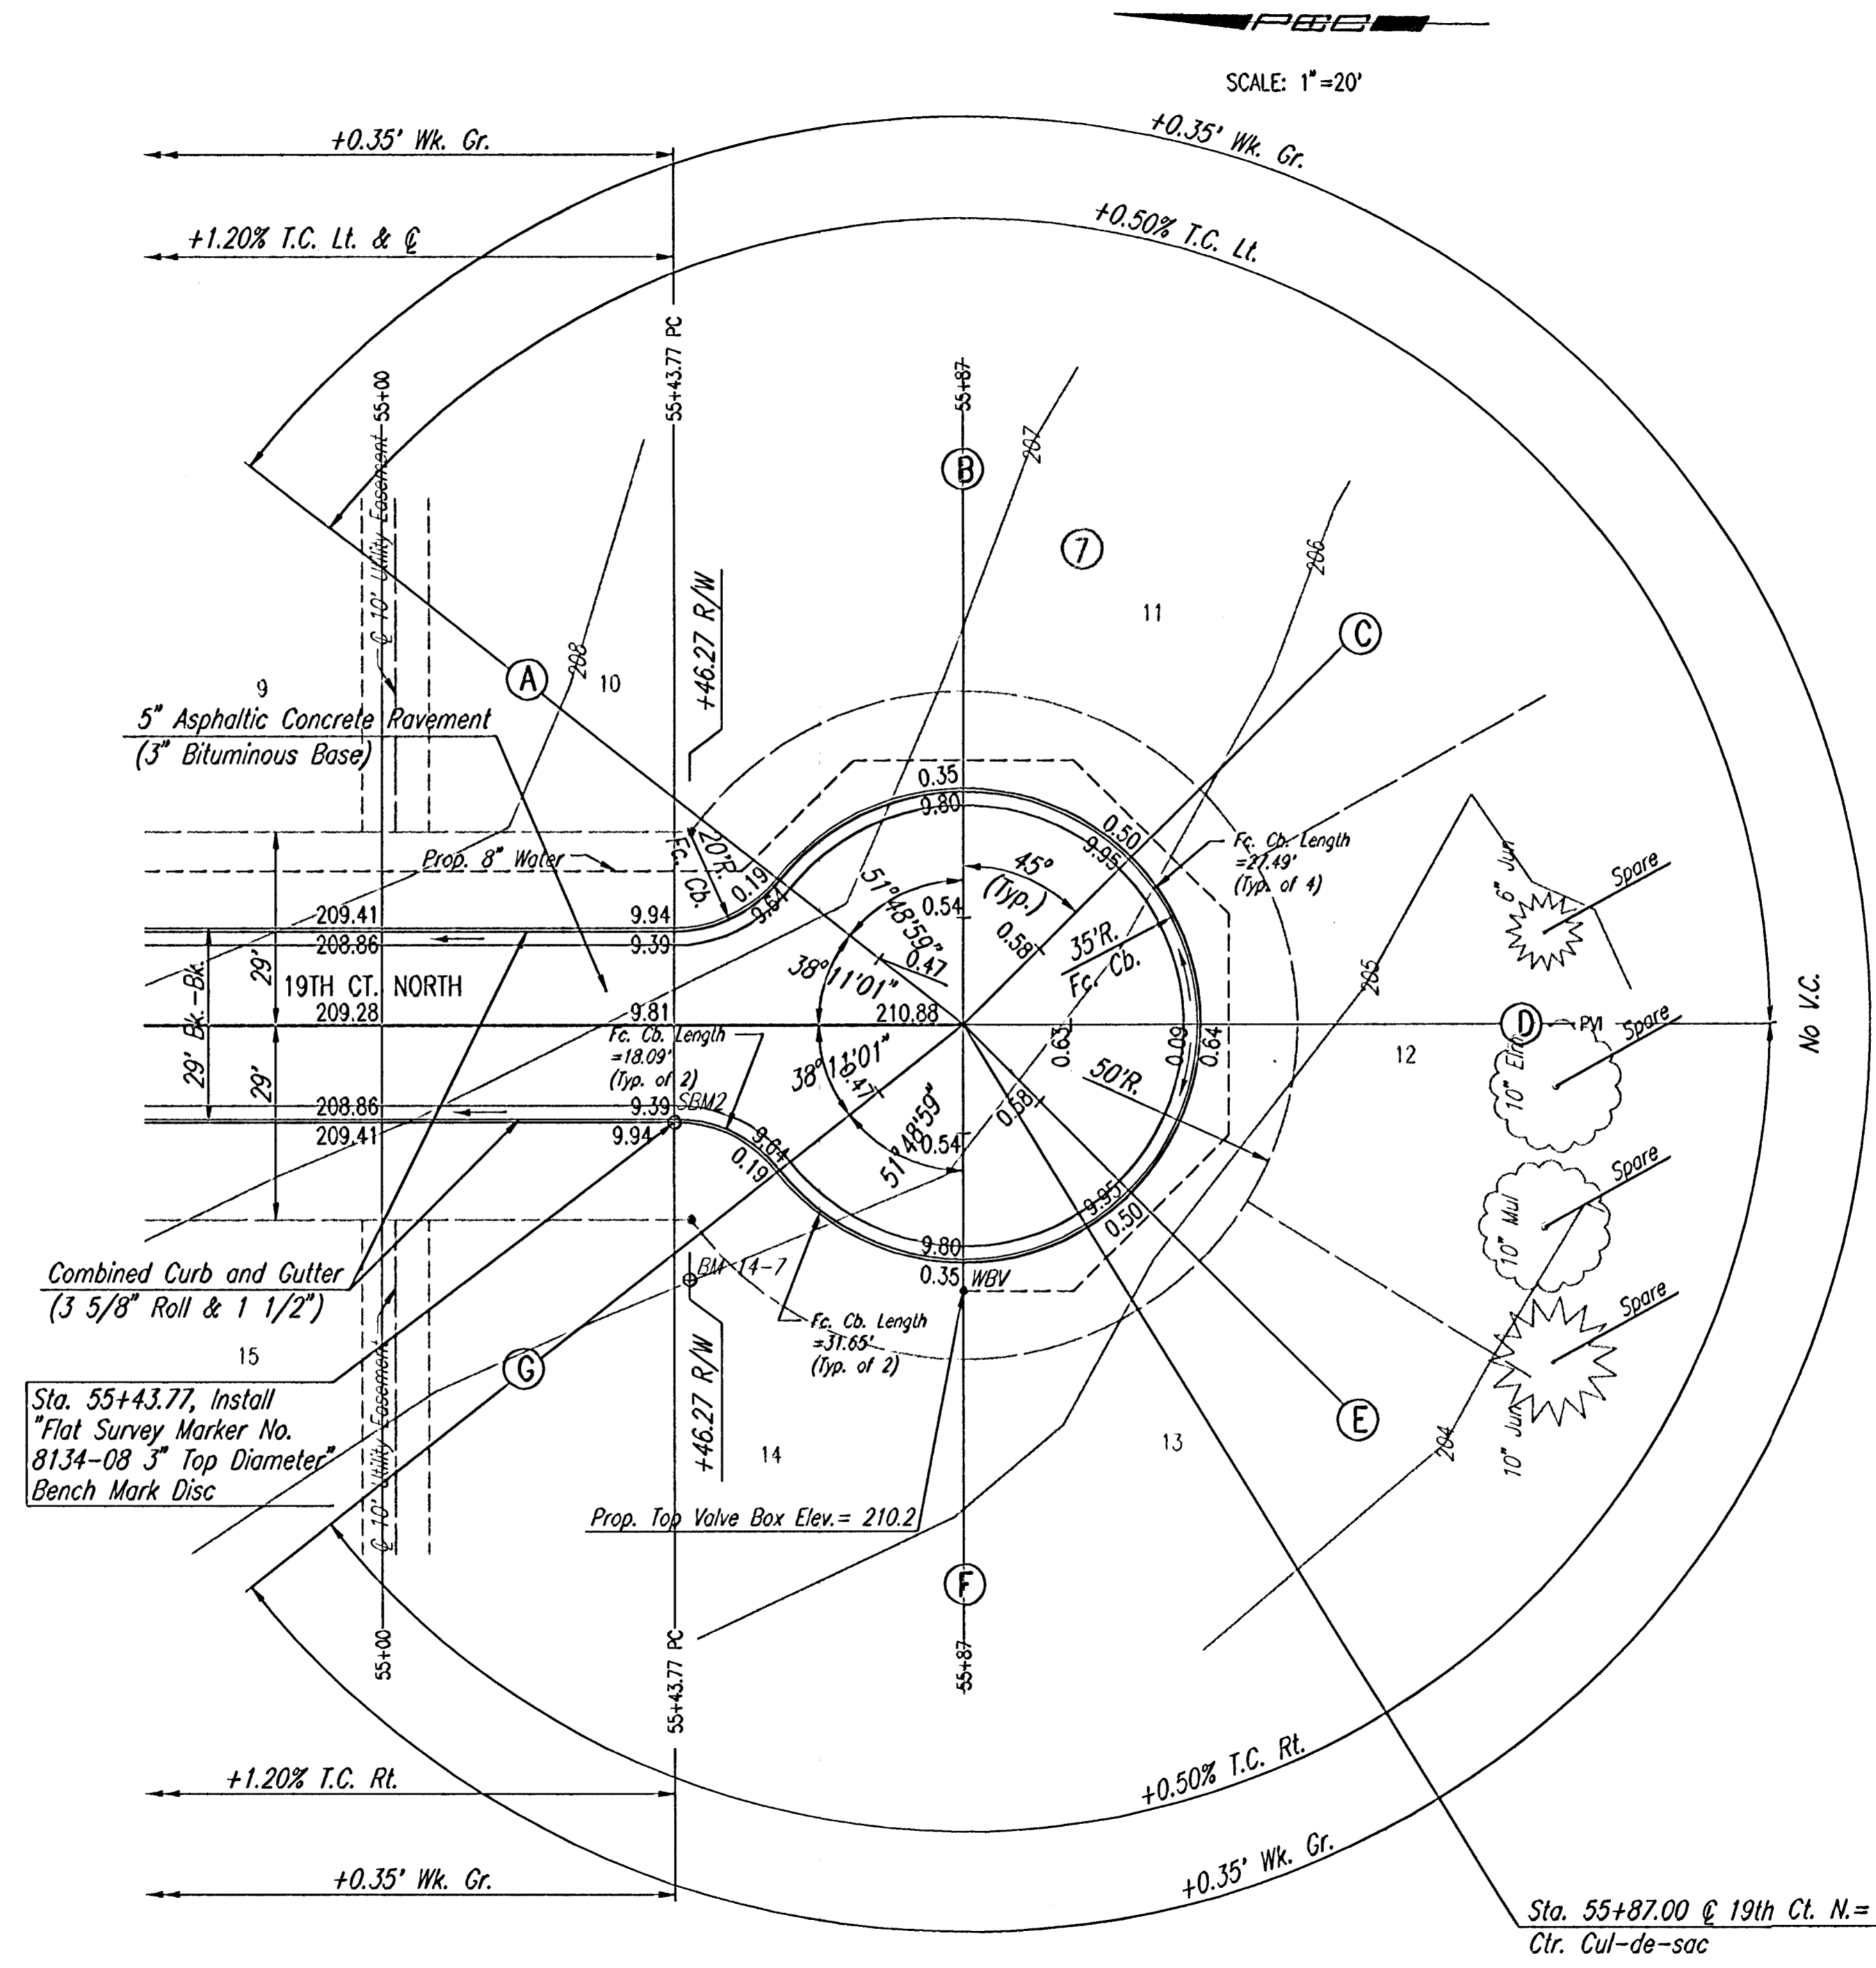

Sta. 55+43.77, Install "Flat Survey Marker No. 8134-08 3" Top Diameter" Bench Mark Disc

Sta. 55+87.00 @ 19th Ct. N.=
Clr. Cul-de-sac

NOTE: THIS STREET TO BE CONSTRUCTED WITH ROLL-TYPE CURB. TOP OF CURB ELEVATIONS GIVEN ARE FOR FULL HEIGHT CURB.

RECORD DRAWING
Sub E 21 NOV 03

REMINTON PLACE - PHASE 2
19TH COURT NORTH
STA. 55+00.00 TO STA. 55+87.00

Professional Engineering Consultants, P.A.
303 S. TOPEKA • WICHITA, KANSAS 67202
316-262-2691 • FAX 316-262-3003

Designed by	BER	Checked by	
Drawn by	DEP	Date	DEC, 2002
		Job No.	02398

DSNR: DEP OPER: DEP SCALE: 1"=20'00'
 CA: 2002\02\368\000\19THCTS2 12-03-2002 03:14:07 pm