
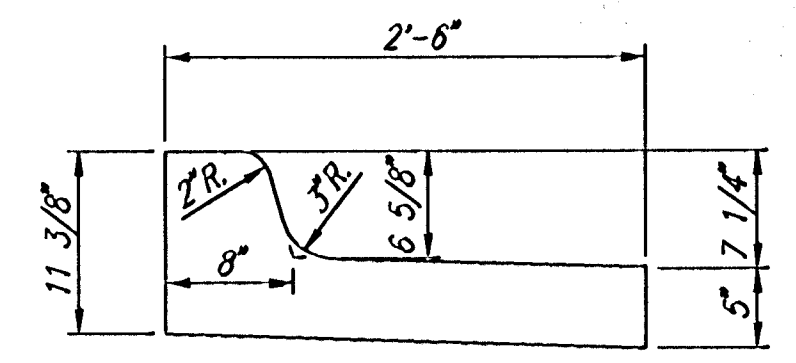


**TYPICAL SECTION**  
Sta. 56+90.37 to Sta. 58+75.85

- ① Varies from 32'-0" at Sta. 56+90.37 to 45'-0" at Sta. 57+73.60  
See Plan
- ② Varies from 15'-0" at Sta. 57+04.84 to 28'-0" at Sta. 58+06.64  
See Plan
- ③ Varies from 0'-0" at Sta. 57+04.84 to 13'-0" at Sta. 58+06.64  
See Plan
- ④ No Median Sta. 57+04.84 to Sta. 58+06.64  
See Plan

◆ LEFT FACE OF CURB STATION

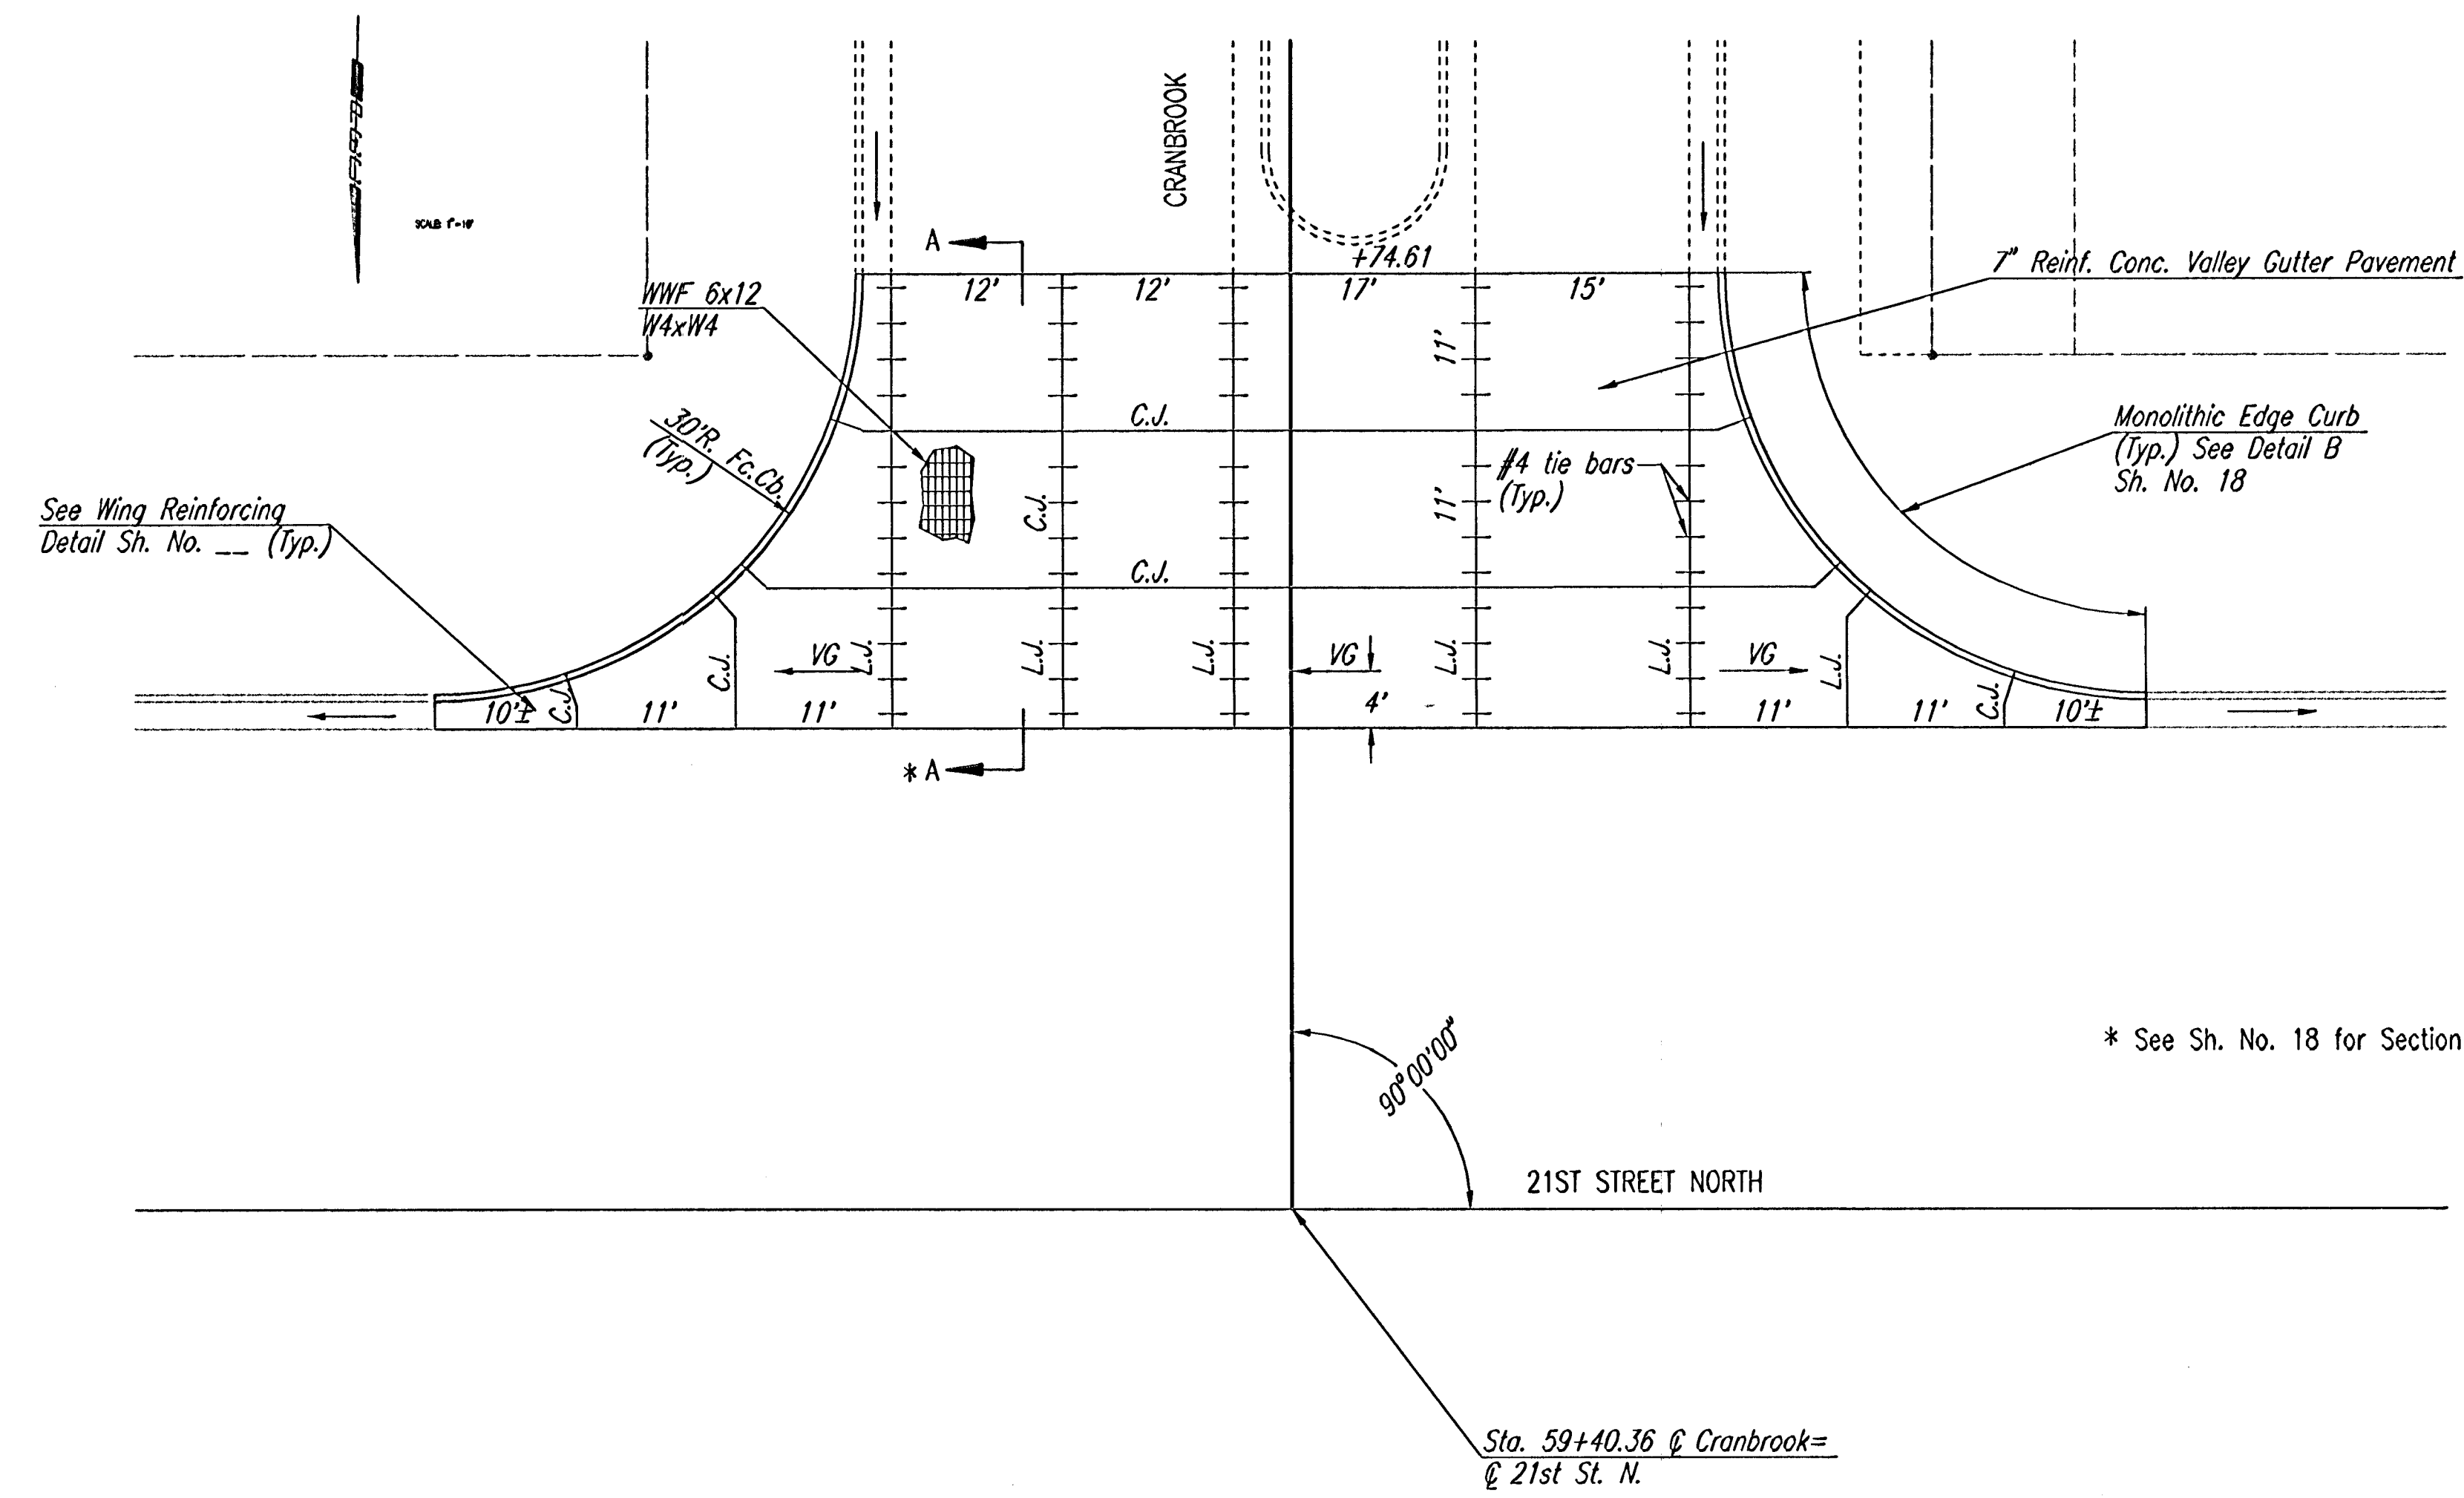

**MEDIAN COMBINED CURB & GUTTER**  
(6 5/8")

**RECORD DRAWING**

*Bob [Signature]* 20 NOV 03

REMINOTON PLACE - PHASE 2

**CRANBROOK ENTRANCE  
TYPICAL SECTION AND  
VALLEY GUTTER PLAN**

Professional Engineering Consultants, P.A.  
303 S. TOPEKA • WICHITA, KANSAS 67202  
316-262-2691 • FAX 316-262-3003

Designed by	BER	Checked by	
Drawn by	DEP	Date	DEC., 2002
		Job No.	02398

DSNR: S4D OPER: DEP SCALE: 1=10.00  
 Q:\2002\02398\000\ENTDITL 12-03-2002 03:10:14 pm