

SCALE: 1"=20'


COORDINATE LIST		
POINT	NORTH	EAST
112	385,894.9075	2,370,657.3608
113	385,897.4814	2,370,843.3604
114	385,899.4151	2,371,019.3498

(114) = COORDINATE POINT NO.

RECORD DRAWING

Handwritten signature and date: 21 10 03

DSNR: SLD OPER: DEP SCALE: 1"=20.00
 C: 2002 02:38 0001 SWS LINE 2 12-03-2002 05:09:10 pm

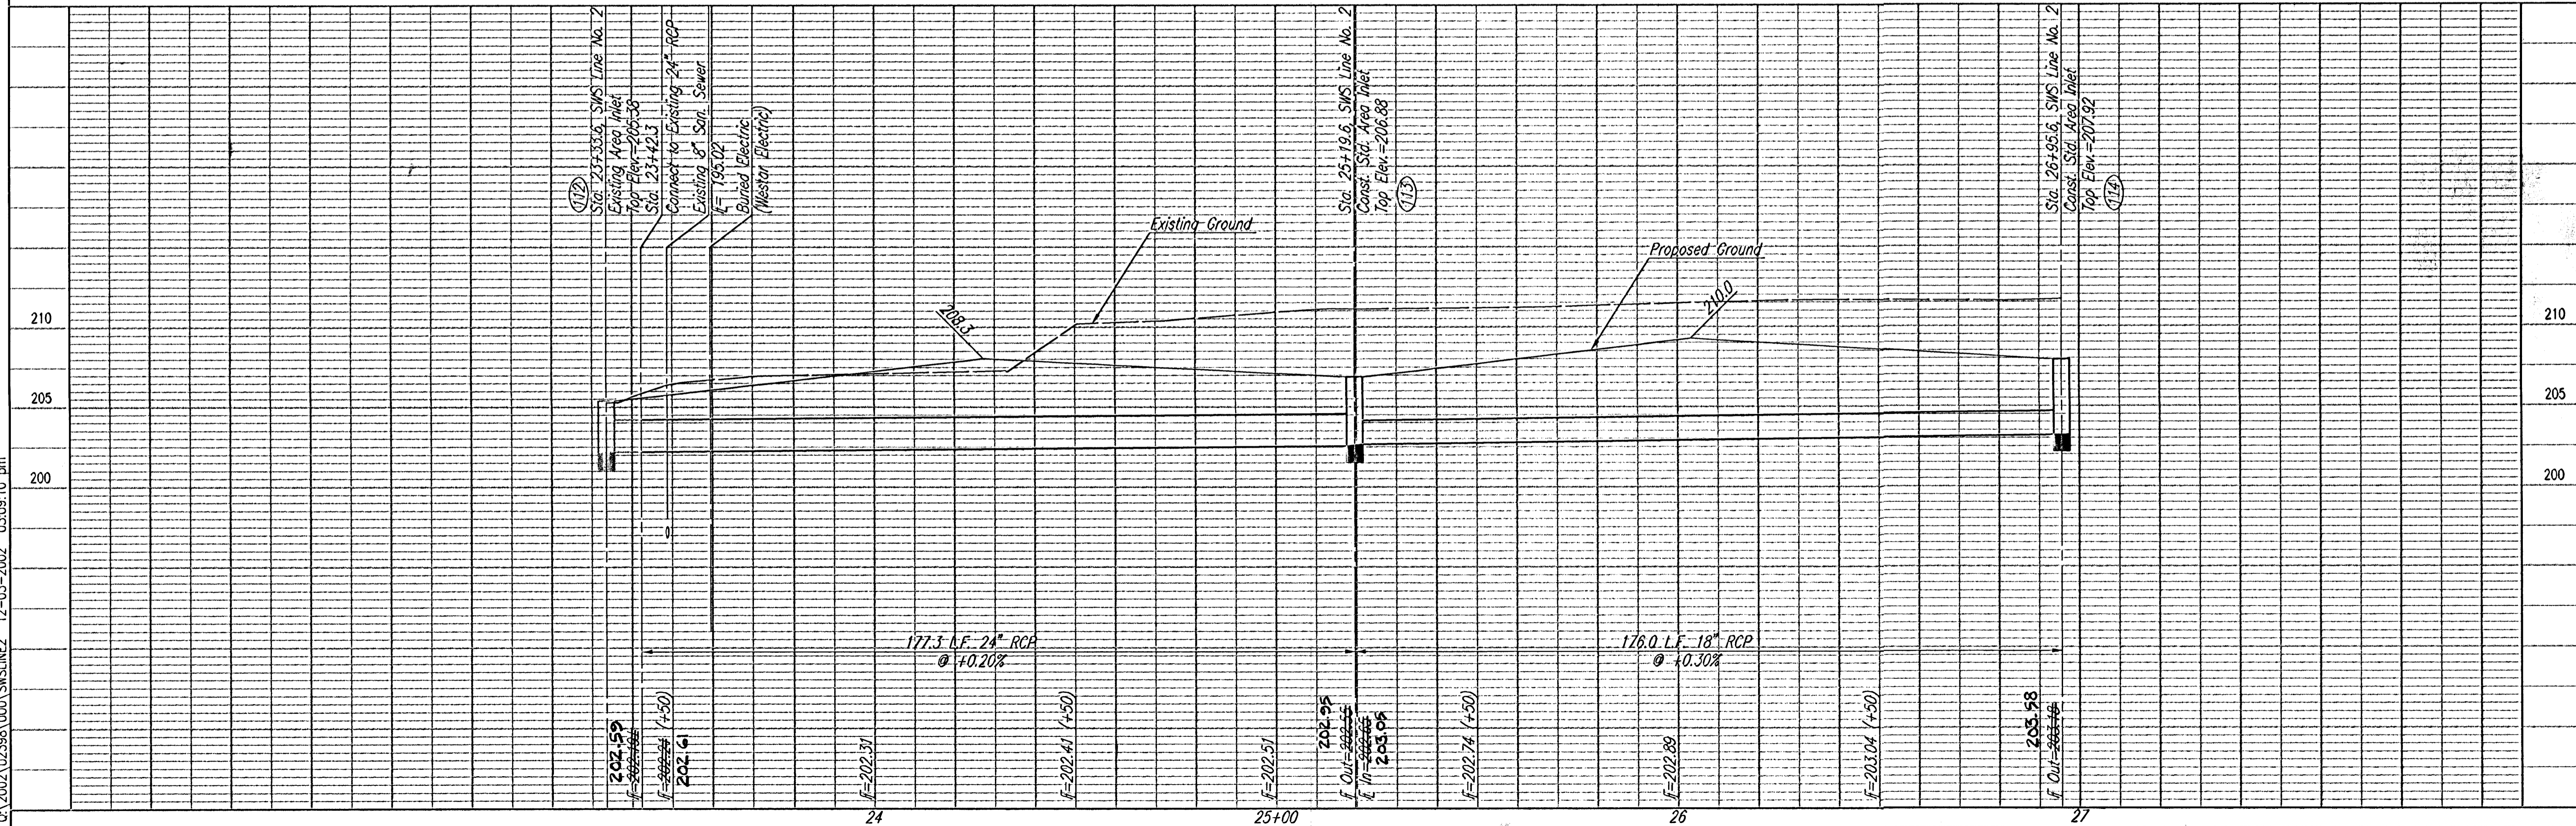

REMAINING PAGE - PHASE 2

SWS LINE NO. 2
 STA. 23+33.6 TO STA. 26+95.6

C.O.W. PROJ. NO. 472-53376

Professional Engineering Consultants, P.A.
 303 S. TOPEKA • WICHITA, KANSAS 67202
 316-262-2691 • FAX 316-262-3003

Designed by: BBR
 Drawn by: SW

Job No. 02386
 Date DEC., 2002

Sheet 23 of 50