


DSNR, S&D OPER. DEP. SCALE: 1"=20.00
01/2002/02398/000/SWSLINES 12-03-2002 03:01:27 pm

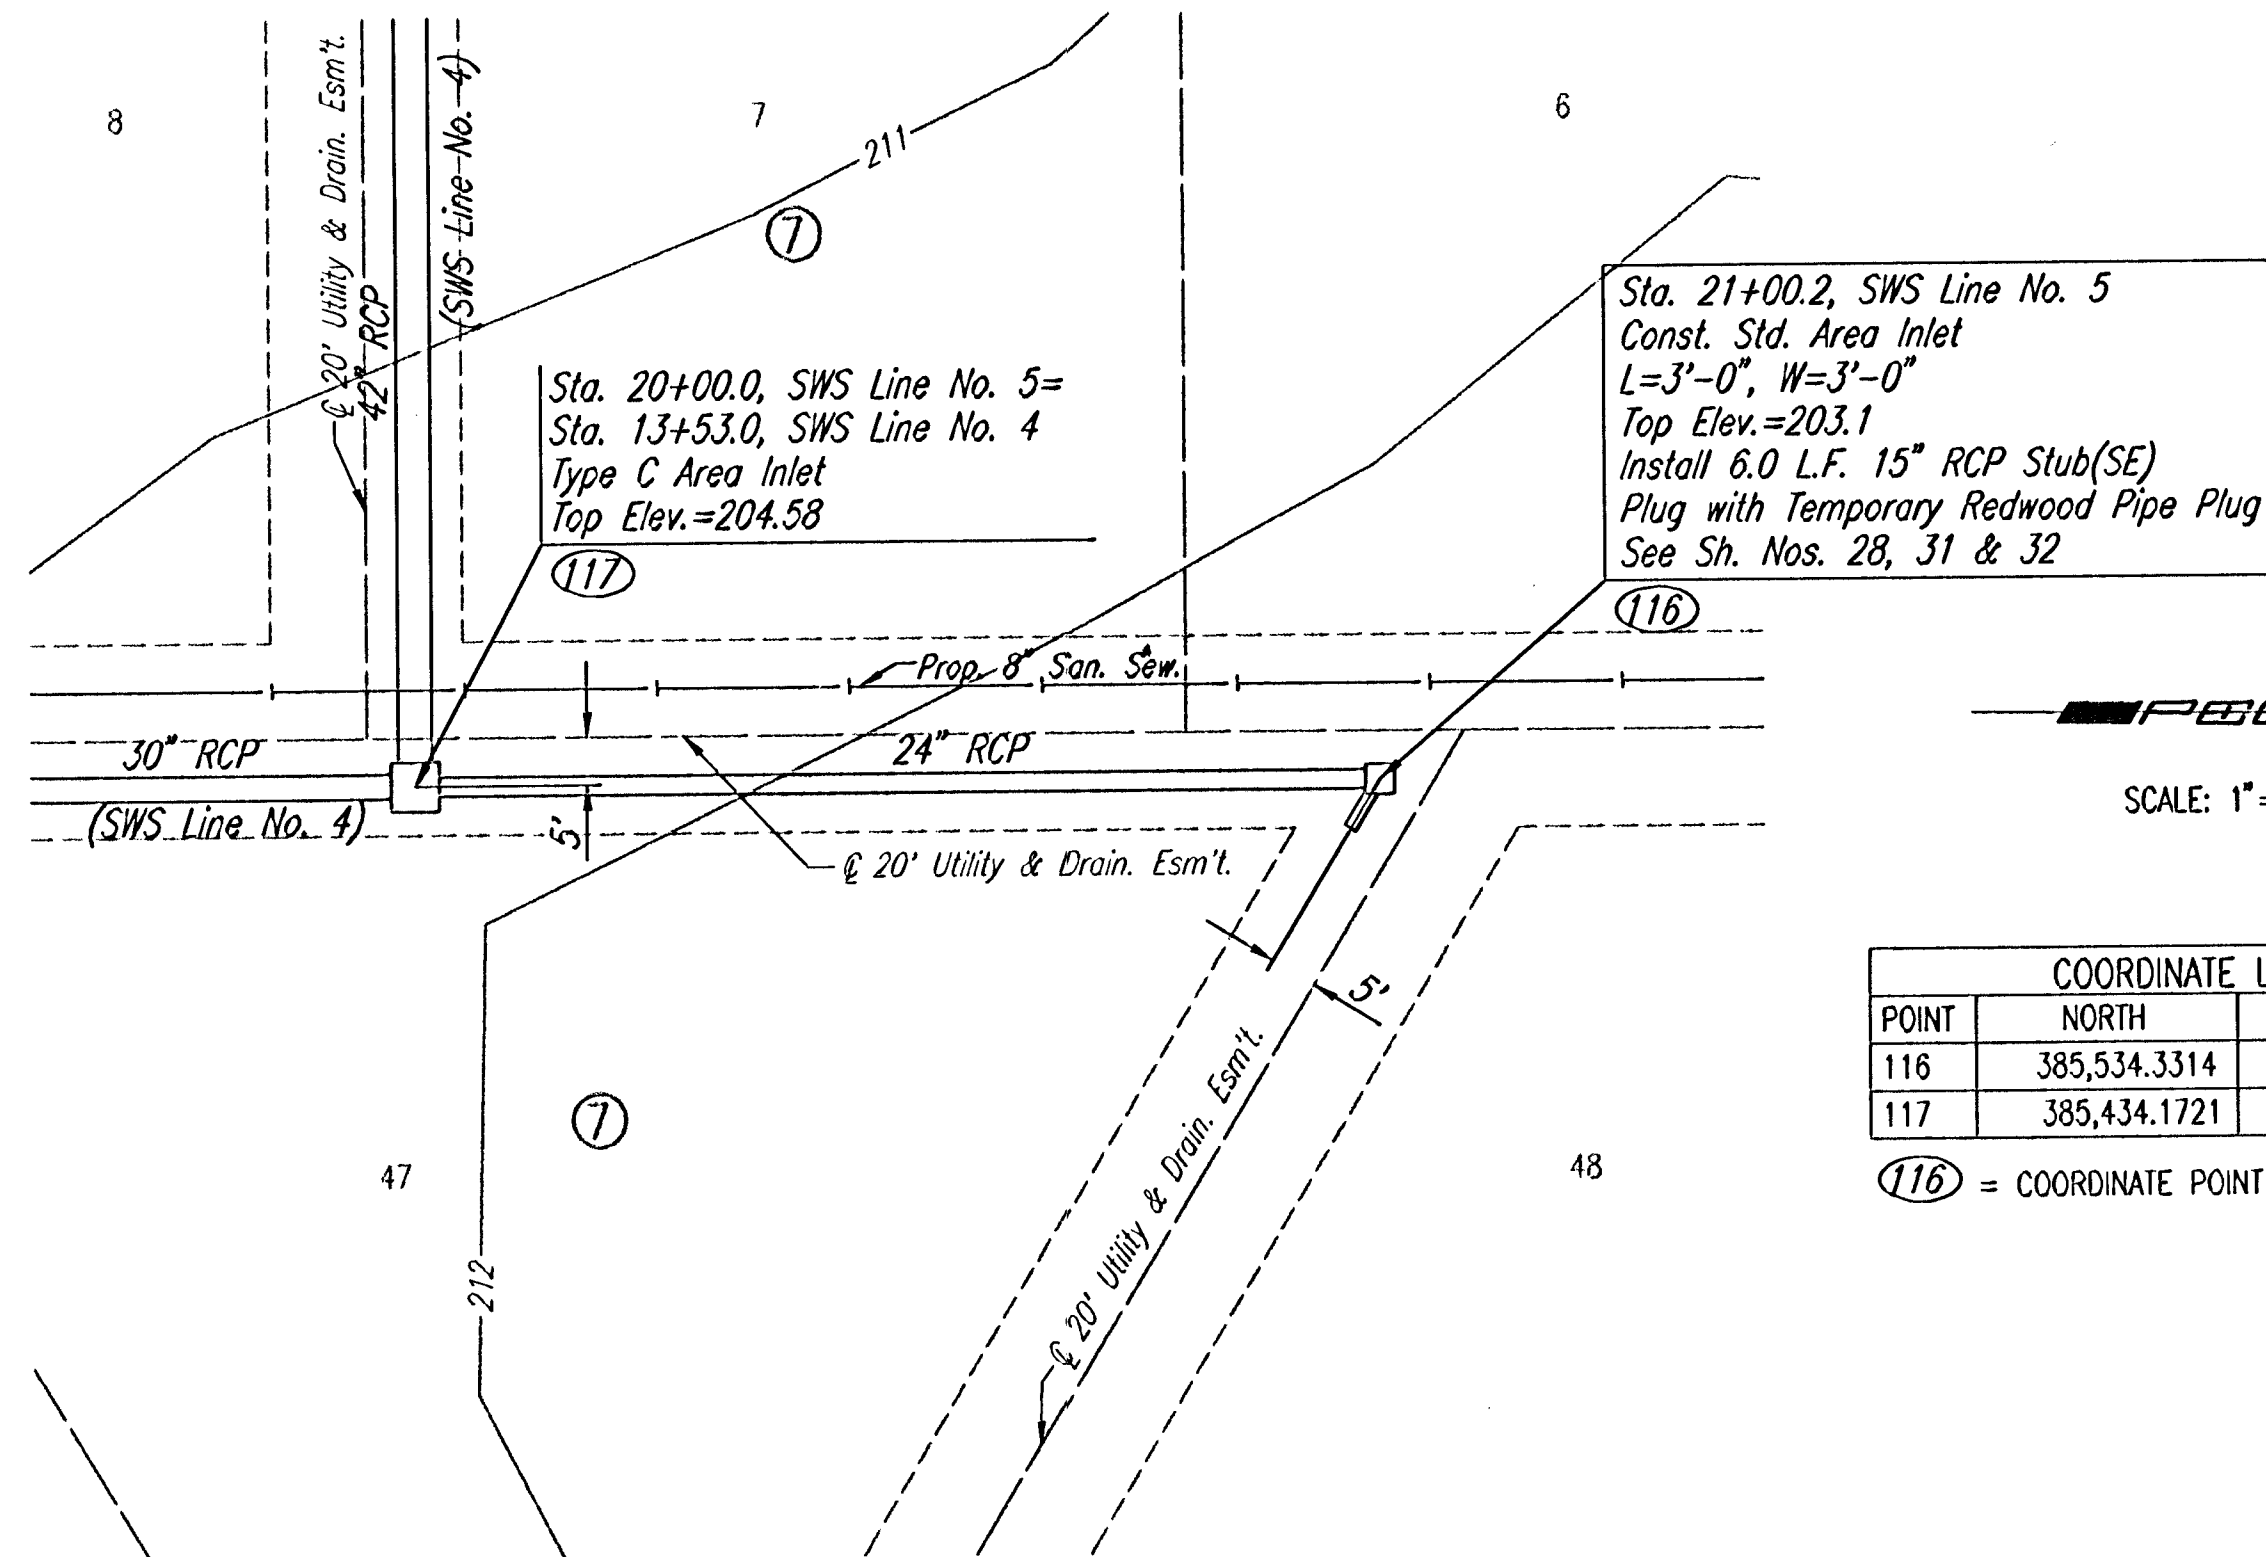


SCALE: 1"=20'

RECORD DRAWING

Proctor/Esteban 24 NOV 03

SWS LINE NO. 5

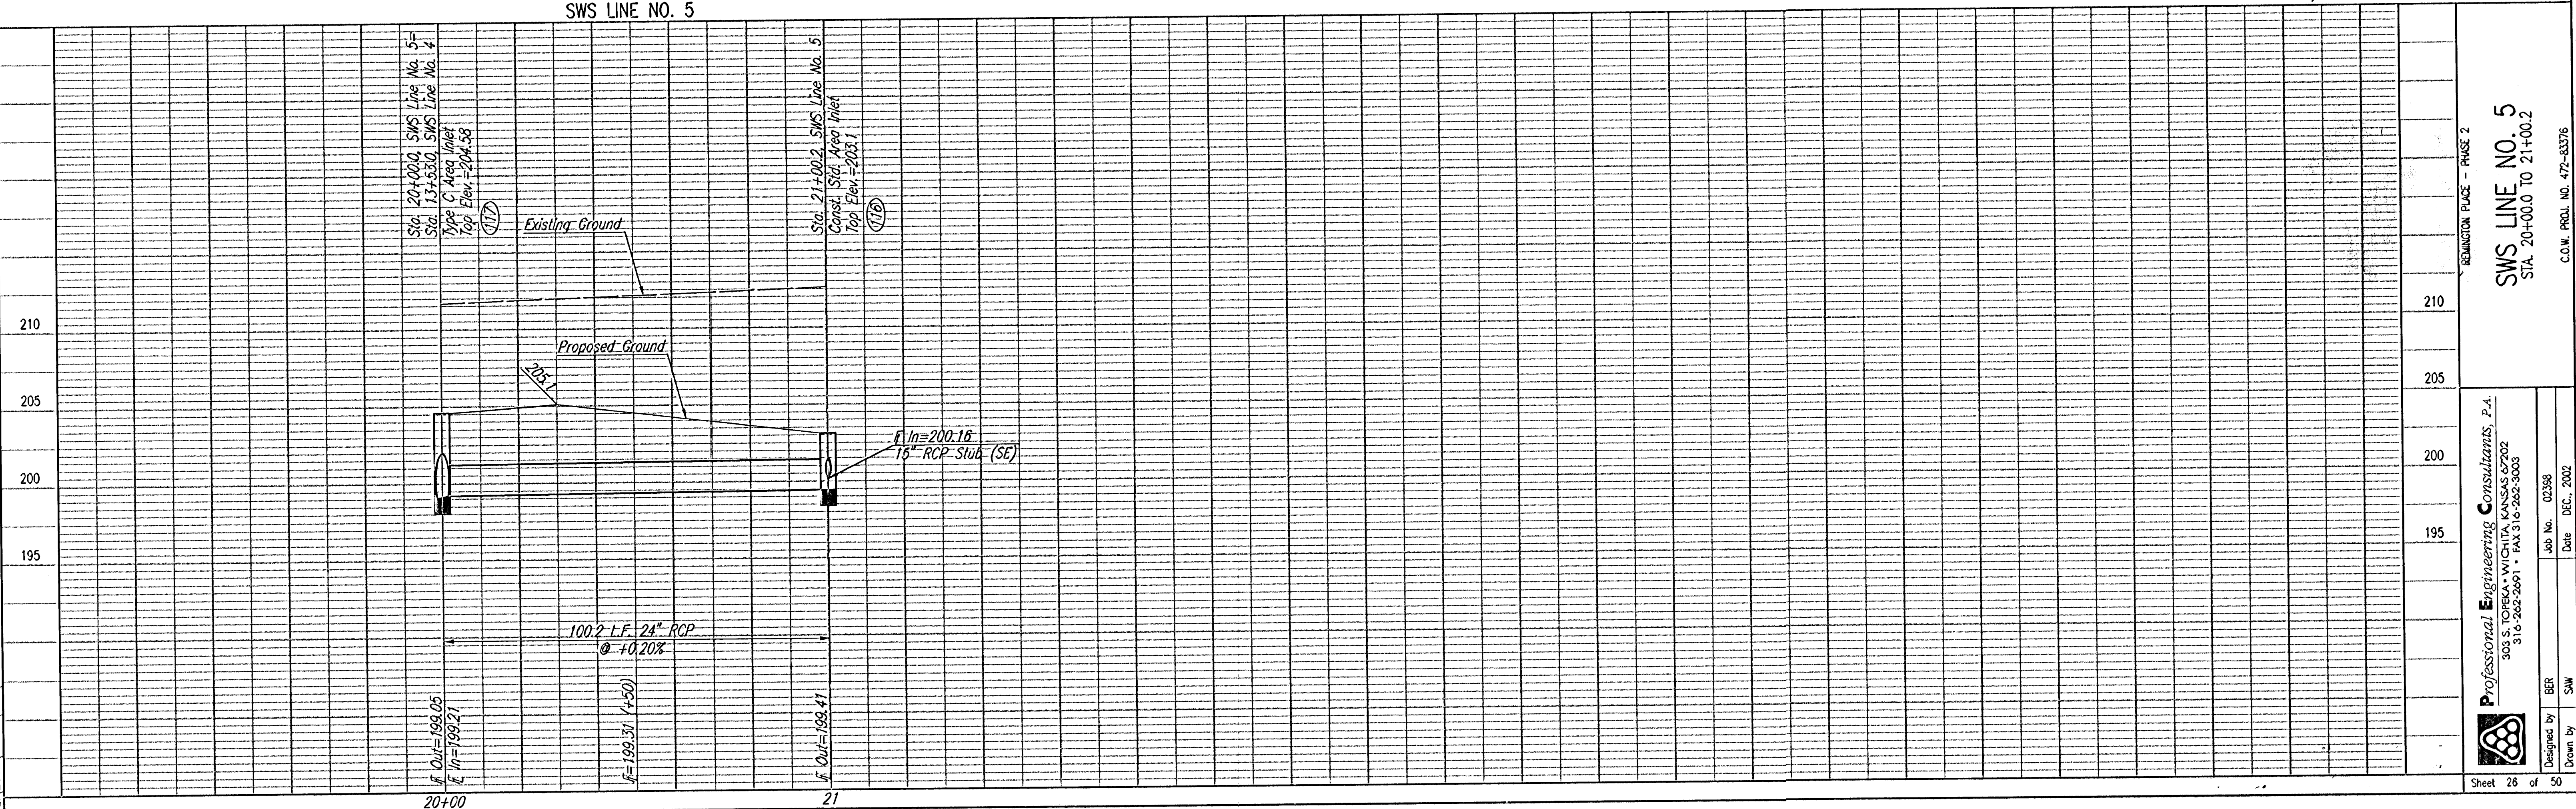

REVISION PLACE - PHASE 2
SWS LINE NO. 5
STA 20+00.0 TO 21+00.2
C.O.M. PROJ. NO. 472-83376

Professional Engineering Consultants, P.A.
303 S. TOPEKA AVENUE, SUITE 200
316-262-2091 • FAX 316-262-3003
Designed by BER
Job No. 02388
Date DEC. 2002
Drawn by SW