
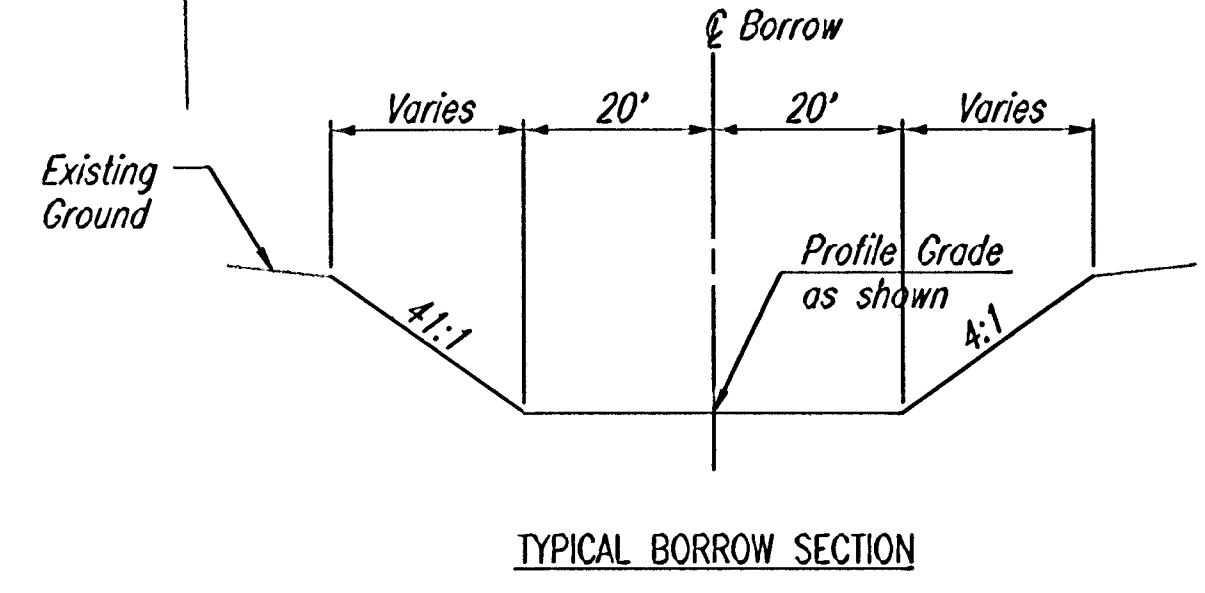
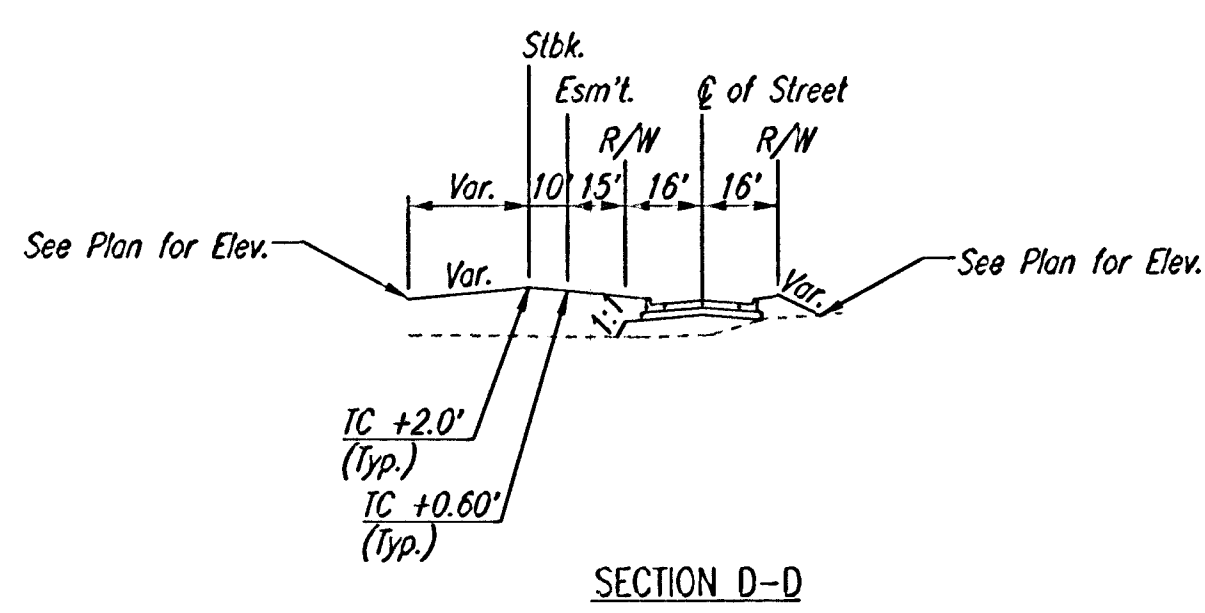
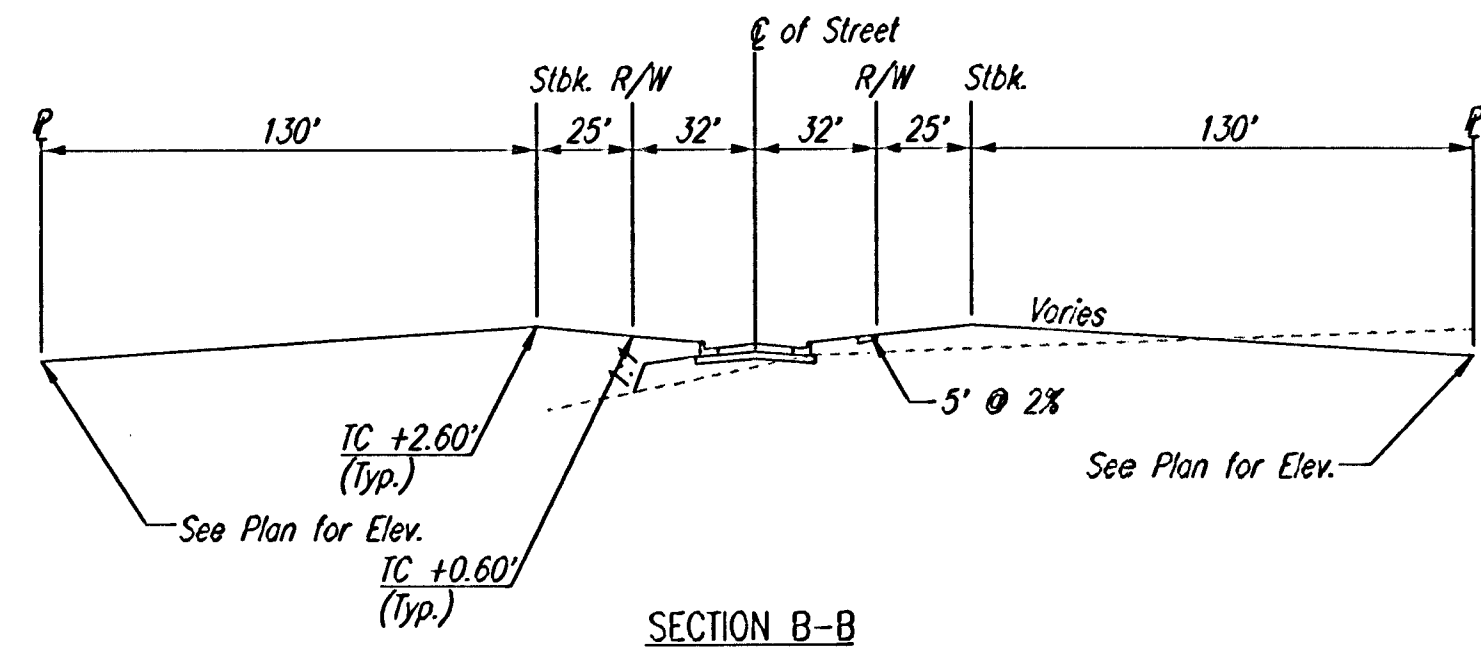
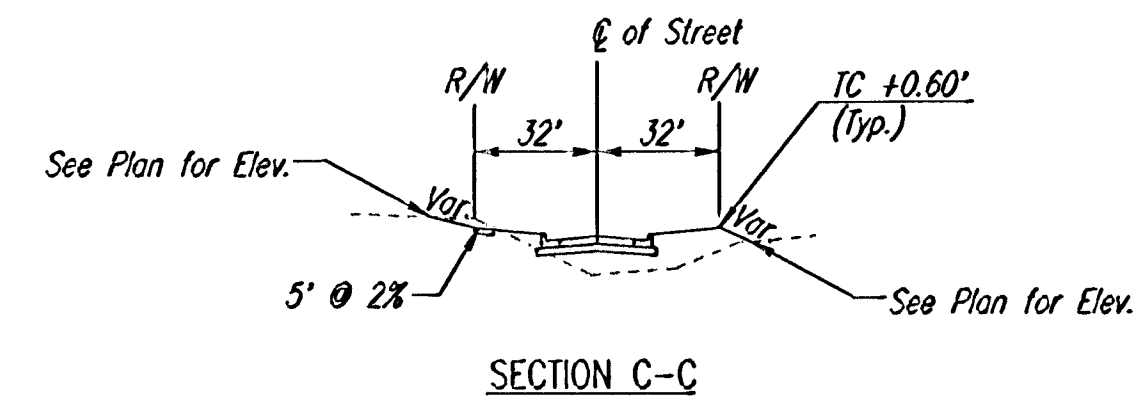
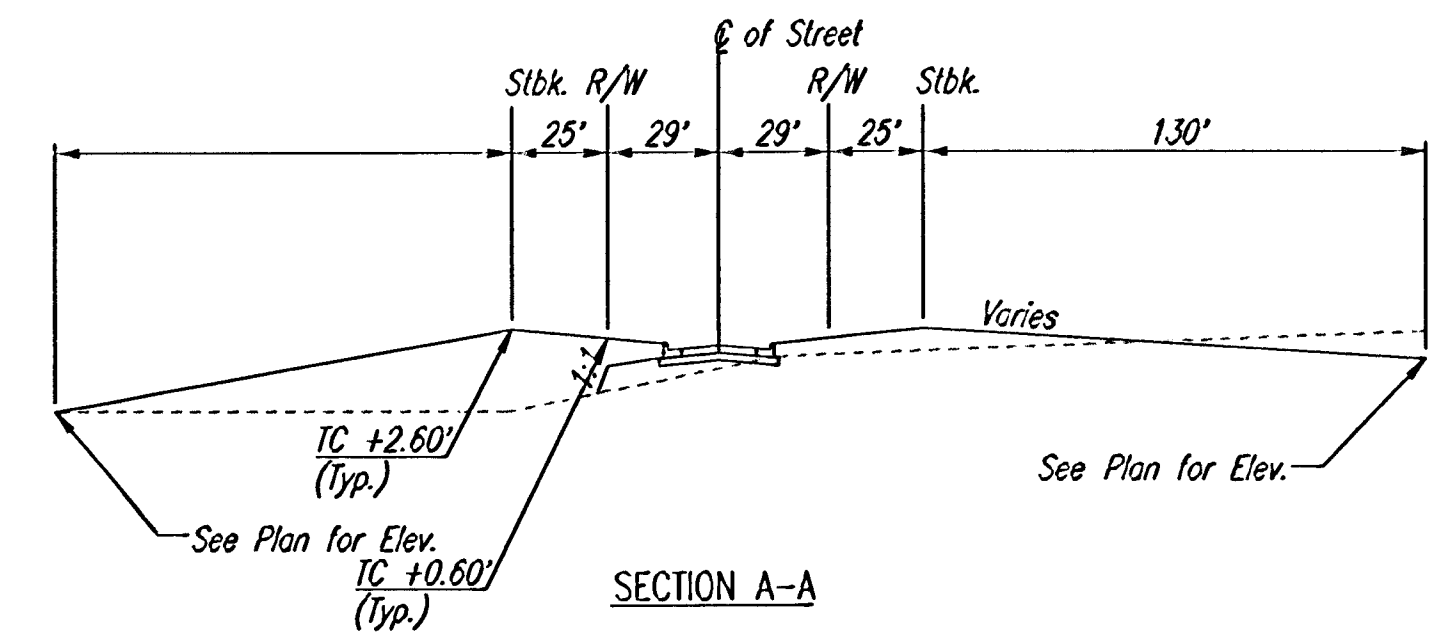


DSNR: SAW OPER. ILS SCALE: 1"=100.00
Q:\2002\02398\000\CHANGE ORDER\05-13-03\4CORNER 11-21-2003 08:21:38 am

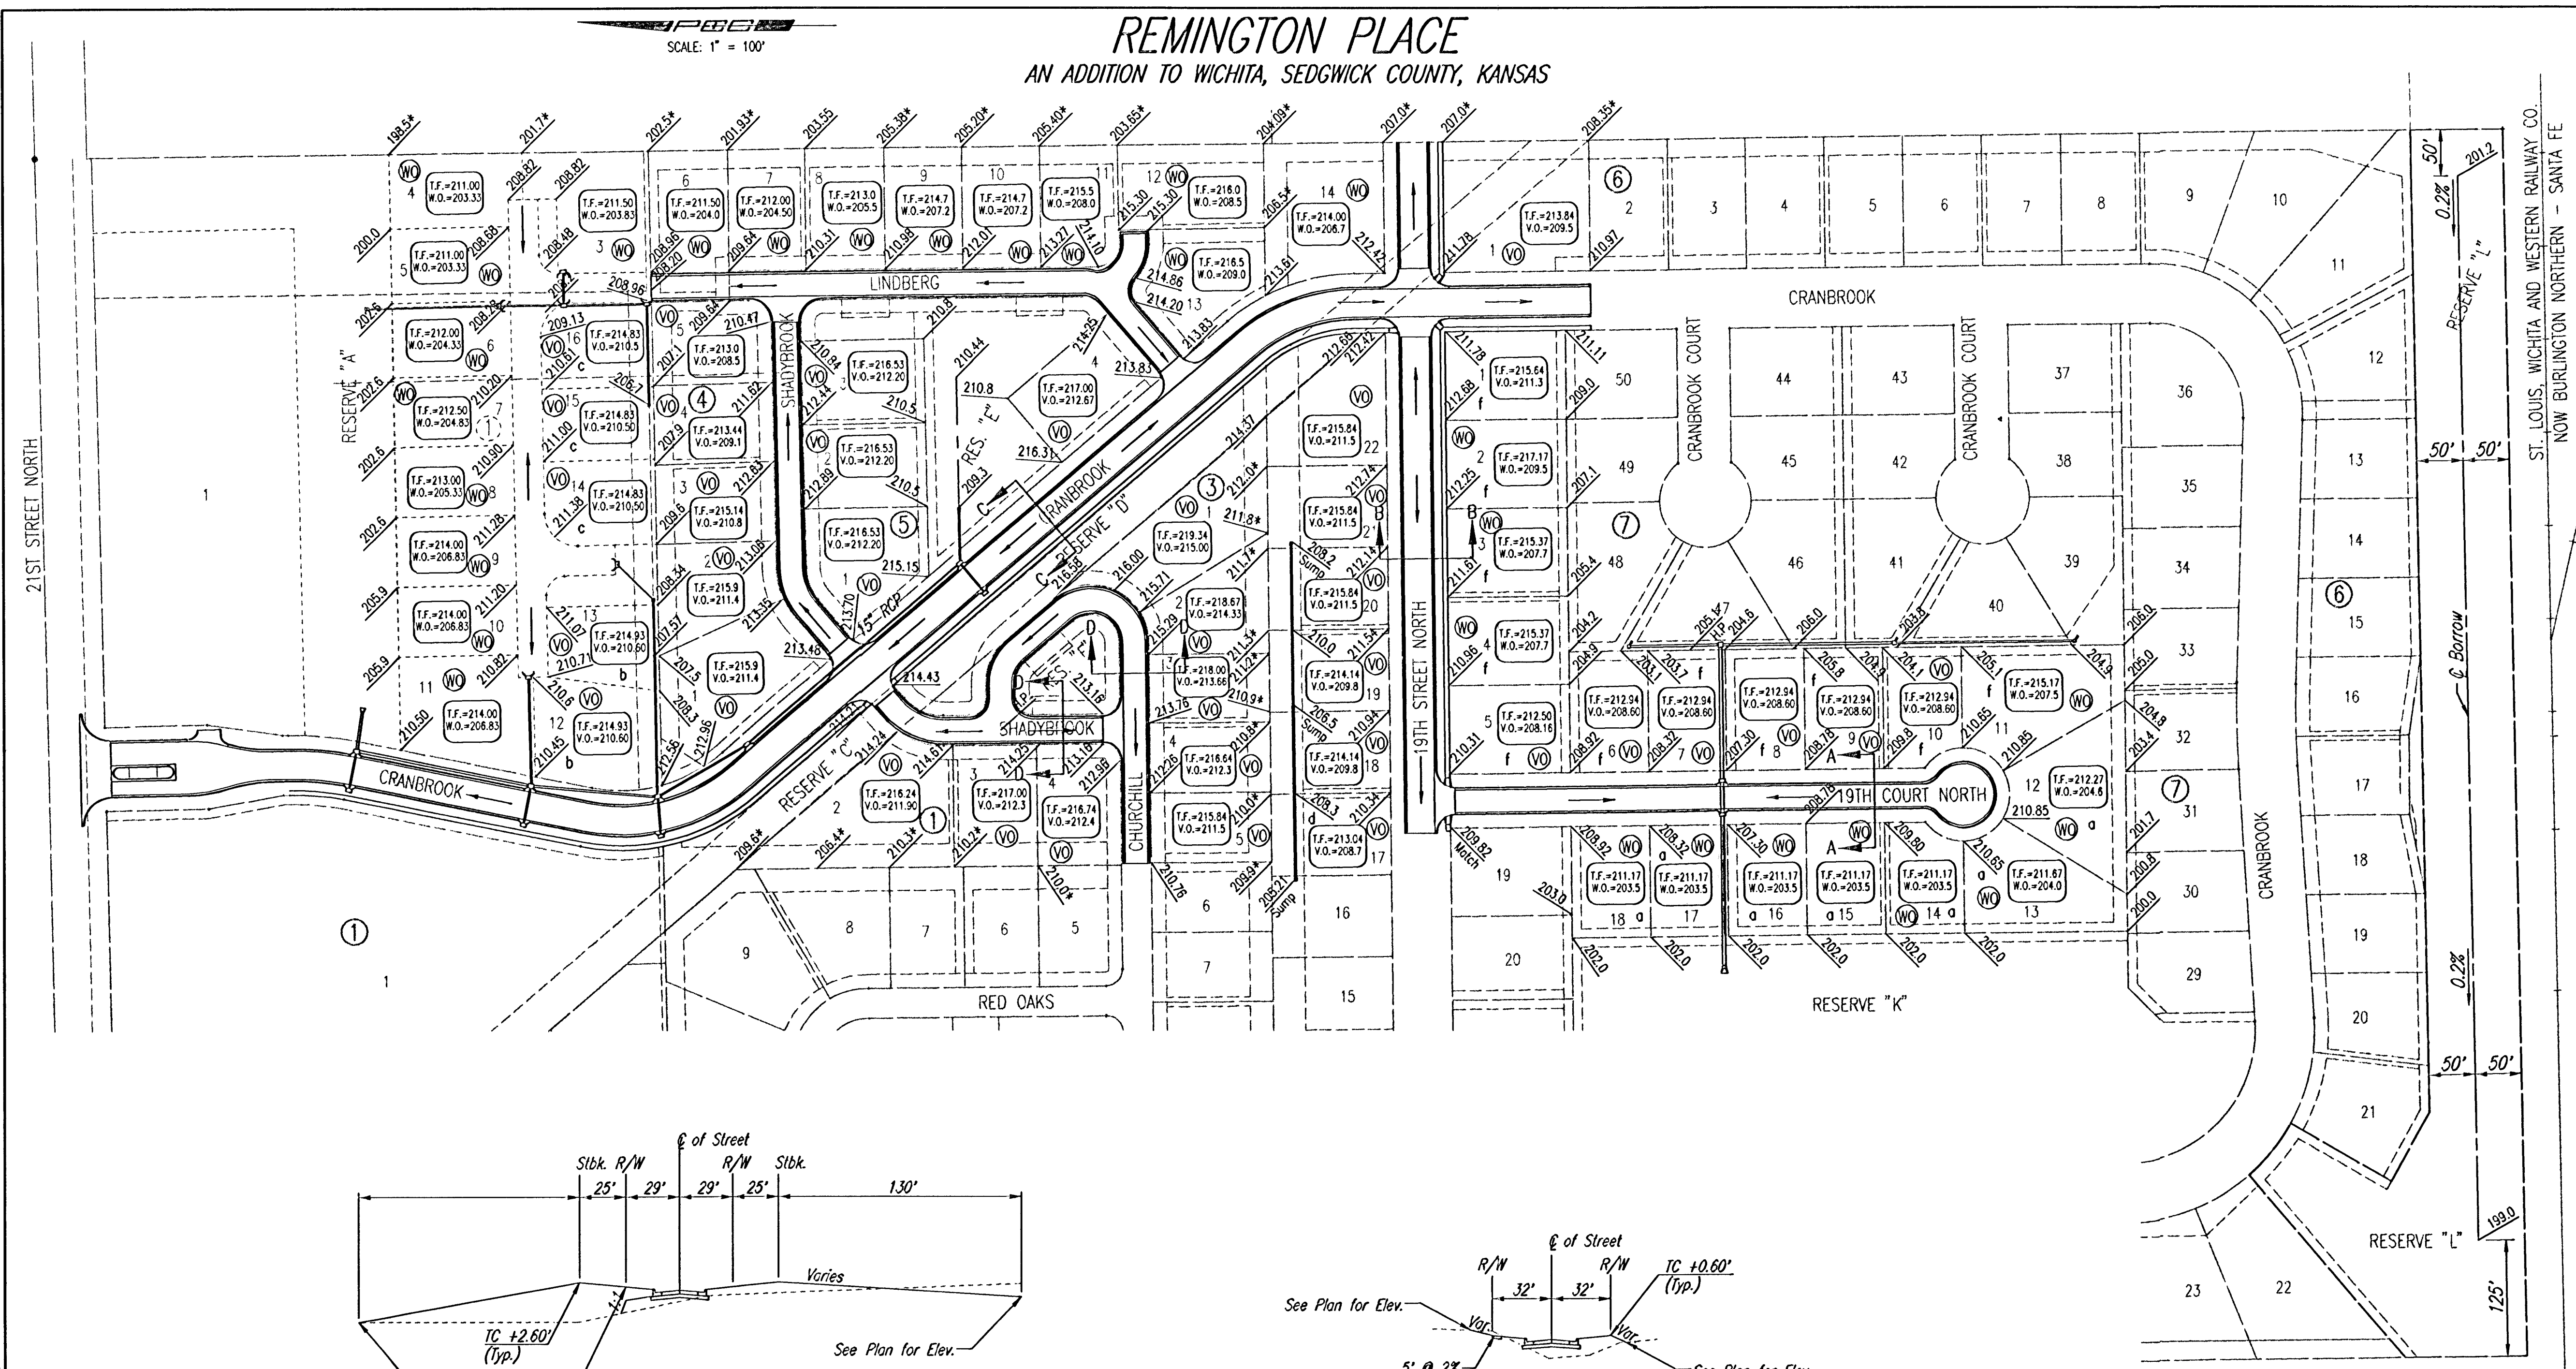

- a MINIMUM OPENING= 203.5
 - b MINIMUM OPENING= 210.6
 - c MINIMUM OPENING= 210.5
 - d MINIMUM OPENING= 208.7
 - f MINIMUM OPENING= 207.5
- (X) STD. BASEMENT
 - (VO) VIEW-OUT BASEMENT
 - (WO) WALK-OUT BASEMENT
 - * MATCH EXISTING

RECORD DRAWING
Professional Engineering Consultants, P.A.
24 NOV 03
REVISED 05/13/03

PROJECT NO.	SHEET NO.	TOTAL SHEETS
472-83376	30	50

REMININGTON PLACE - PHASE 2	
FOUR CORNER LOT GRADING	
Professional Engineering Consultants, P.A. 303 S. TOPEKA • WICHITA, KANSAS 67202 316-262-2691 • FAX 316-262-3003	
Designed by	BER
Drawn by	SAW
Checked by	
Date	DEC., 2002
Job No.	02398