


NOTE BOOK	TEMPLATE	AREAS	CHECKED
NO.			

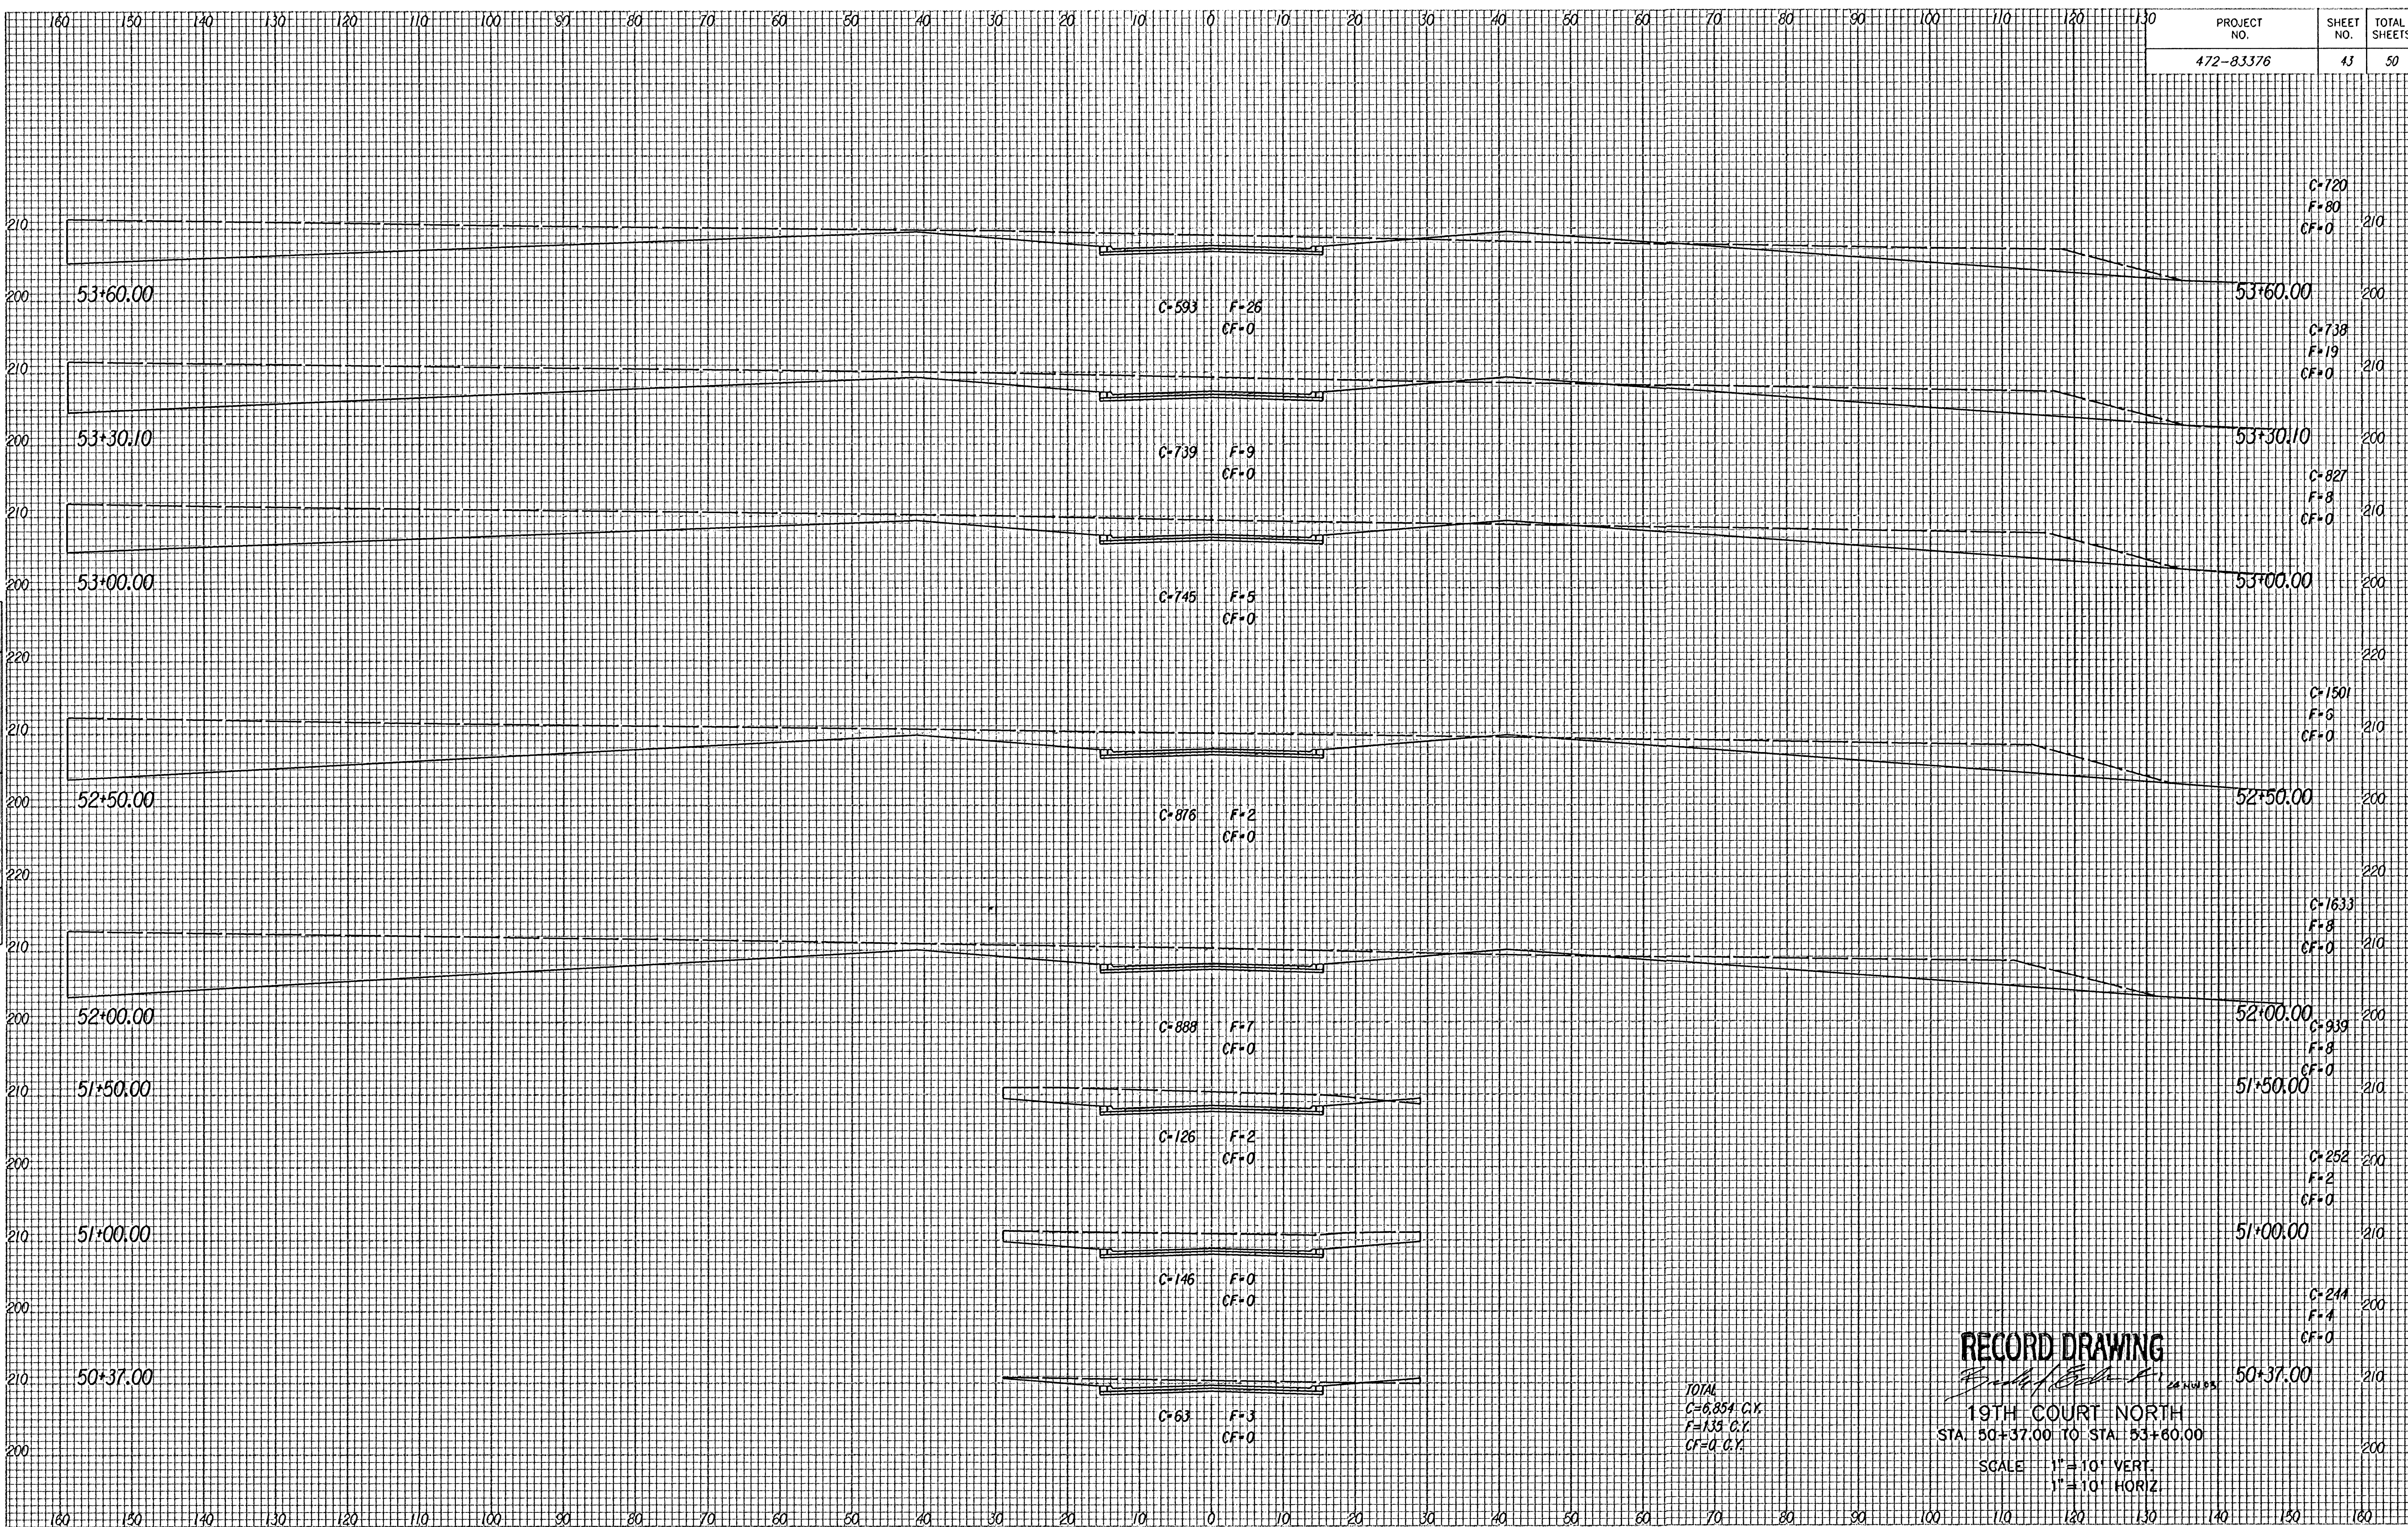

PROJECT NO.	SHEET NO.	TOTAL SHEETS
472-83376	43	50

RECORD DRAWING
[Signature]
 19TH COURT NORTH
 STA. 50+37.00 TO STA. 53+60.00
 SCALE 1"=10' VERT.
 1"=10' HORIZ.

TOTAL
 C=6,854 C.Y.
 F=133 C.Y.
 CF=0 C.Y.