
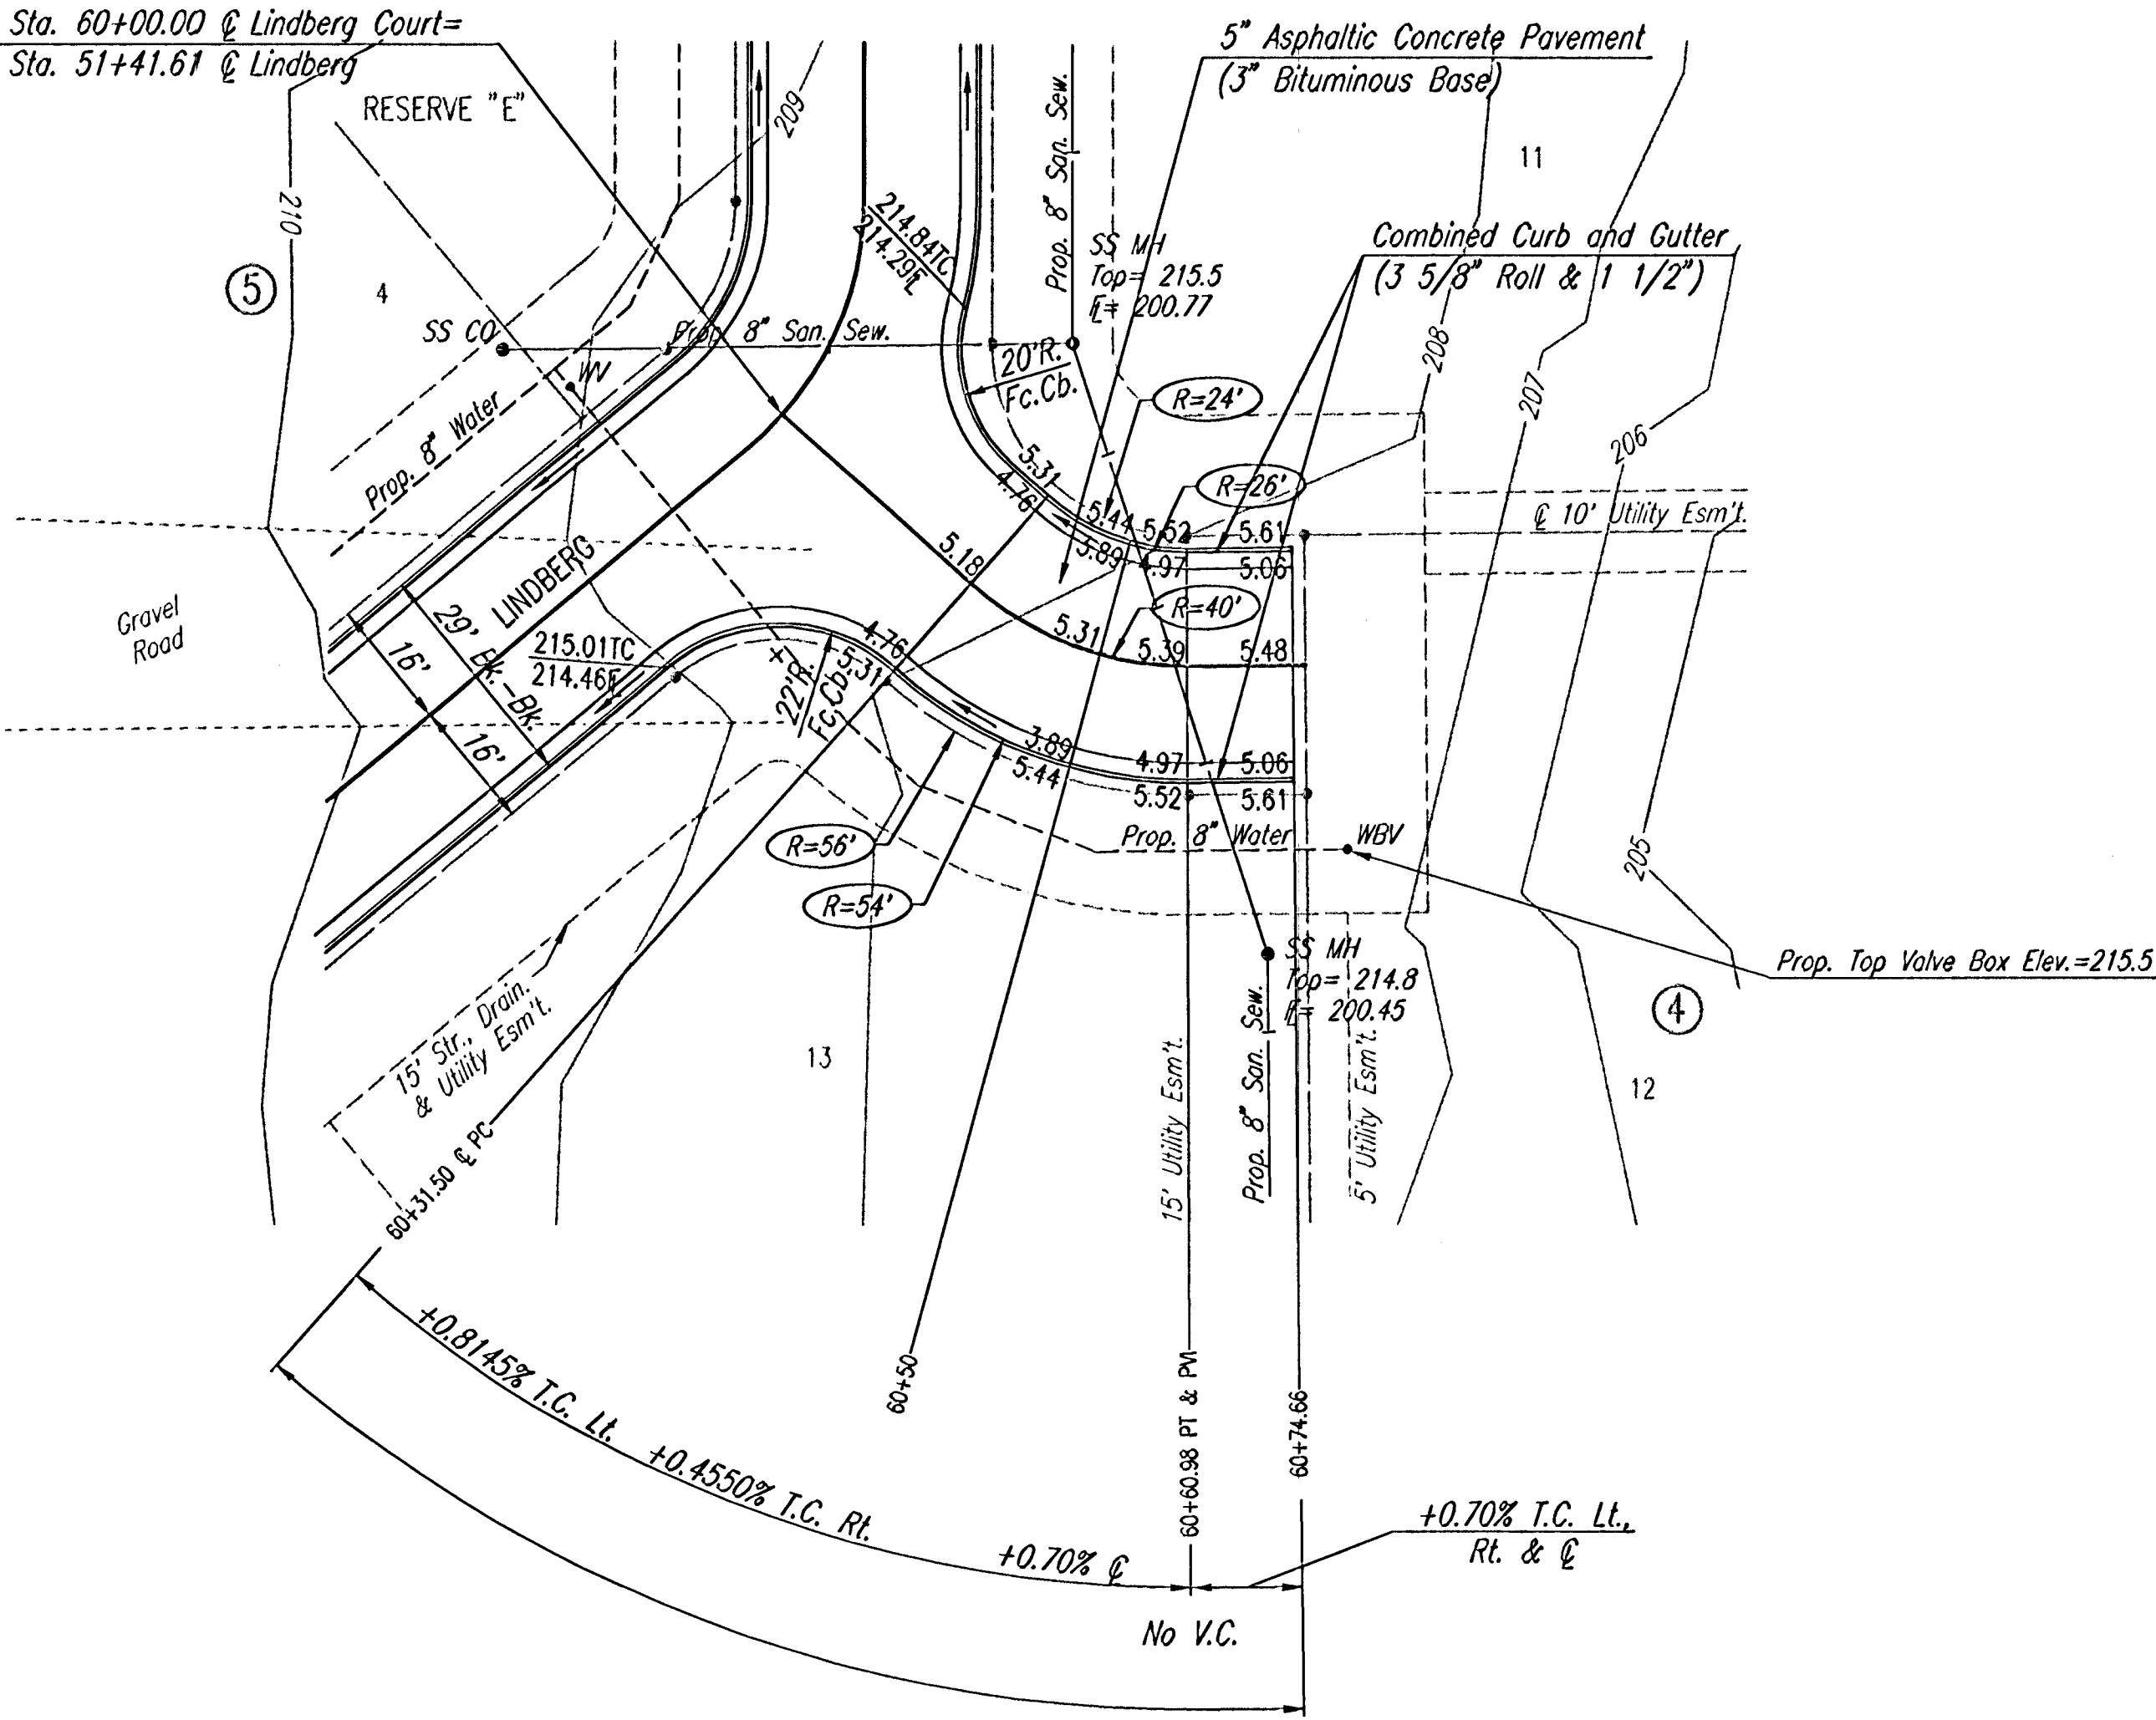


WATER VALVE BOX ELEVATIONS			
STREET	STATION	OFFSET	PROPOSED ELEVATION
LINDBERG COURT	60+80.67	23.0' RL	2145.5

PROJECT NO.	SHEET NO.	TOTAL SHEETS
472-83377	8	23

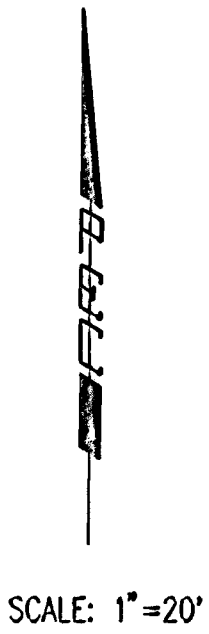

CURVE DATA							
$\Delta=42^{\circ}13'16''$		$D=143^{\circ}14'22''$		$R=40.00'$		$L=29.48'$	
$E=2.88'$		$T=15.44'$		$\Delta/2=21^{\circ}06'38''$			
STATION	ARC LENGTH	FACE CURB LENGTH		CHORD LENGTH		DEFLECTION ANGLE	TOTAL DEFLECTION
		LEFT CURB	RIGHT CURB	8' OFF LEFT FACE CURB	8' OFF RIGHT FACE CURB		
60+31.50						0°00'00"	0°00'00"
60+50	18.50'	12.03'	24.98'	8.25'	28.42'	13°14'59"	13°14'59"
60+60.98	10.98'	7.13'	14.82'	4.92'	16.96'	7°51'39"	21°06'38"
TOTAL	29.48'	19.16'	39.80'	Defl./ft.=42.965853 min.			

NOTE: THIS STREET TO BE CONSTRUCTED WITH ROLL-TYPE CURB. TOP OF CURB ELEVATIONS GIVEN ARE FOR FULL HEIGHT CURB.

RECORD DRAWING
Barbara J. Schuler 24 NOV 03
 REMINGTON PLACE - PHASE 3

LINDBERG COURT
 STA. 60+00.00 TO STA. 60+74.66

Professional Engineering Consultants, P.A.
 303 S. TOPEKA • WICHITA, KANSAS 67202
 316-262-2691 • FAX 316-262-3003

Designed by	BER	Checked by	
Drawn by	DEP	Date	DEC., 2002
		Job No.	02398-004