
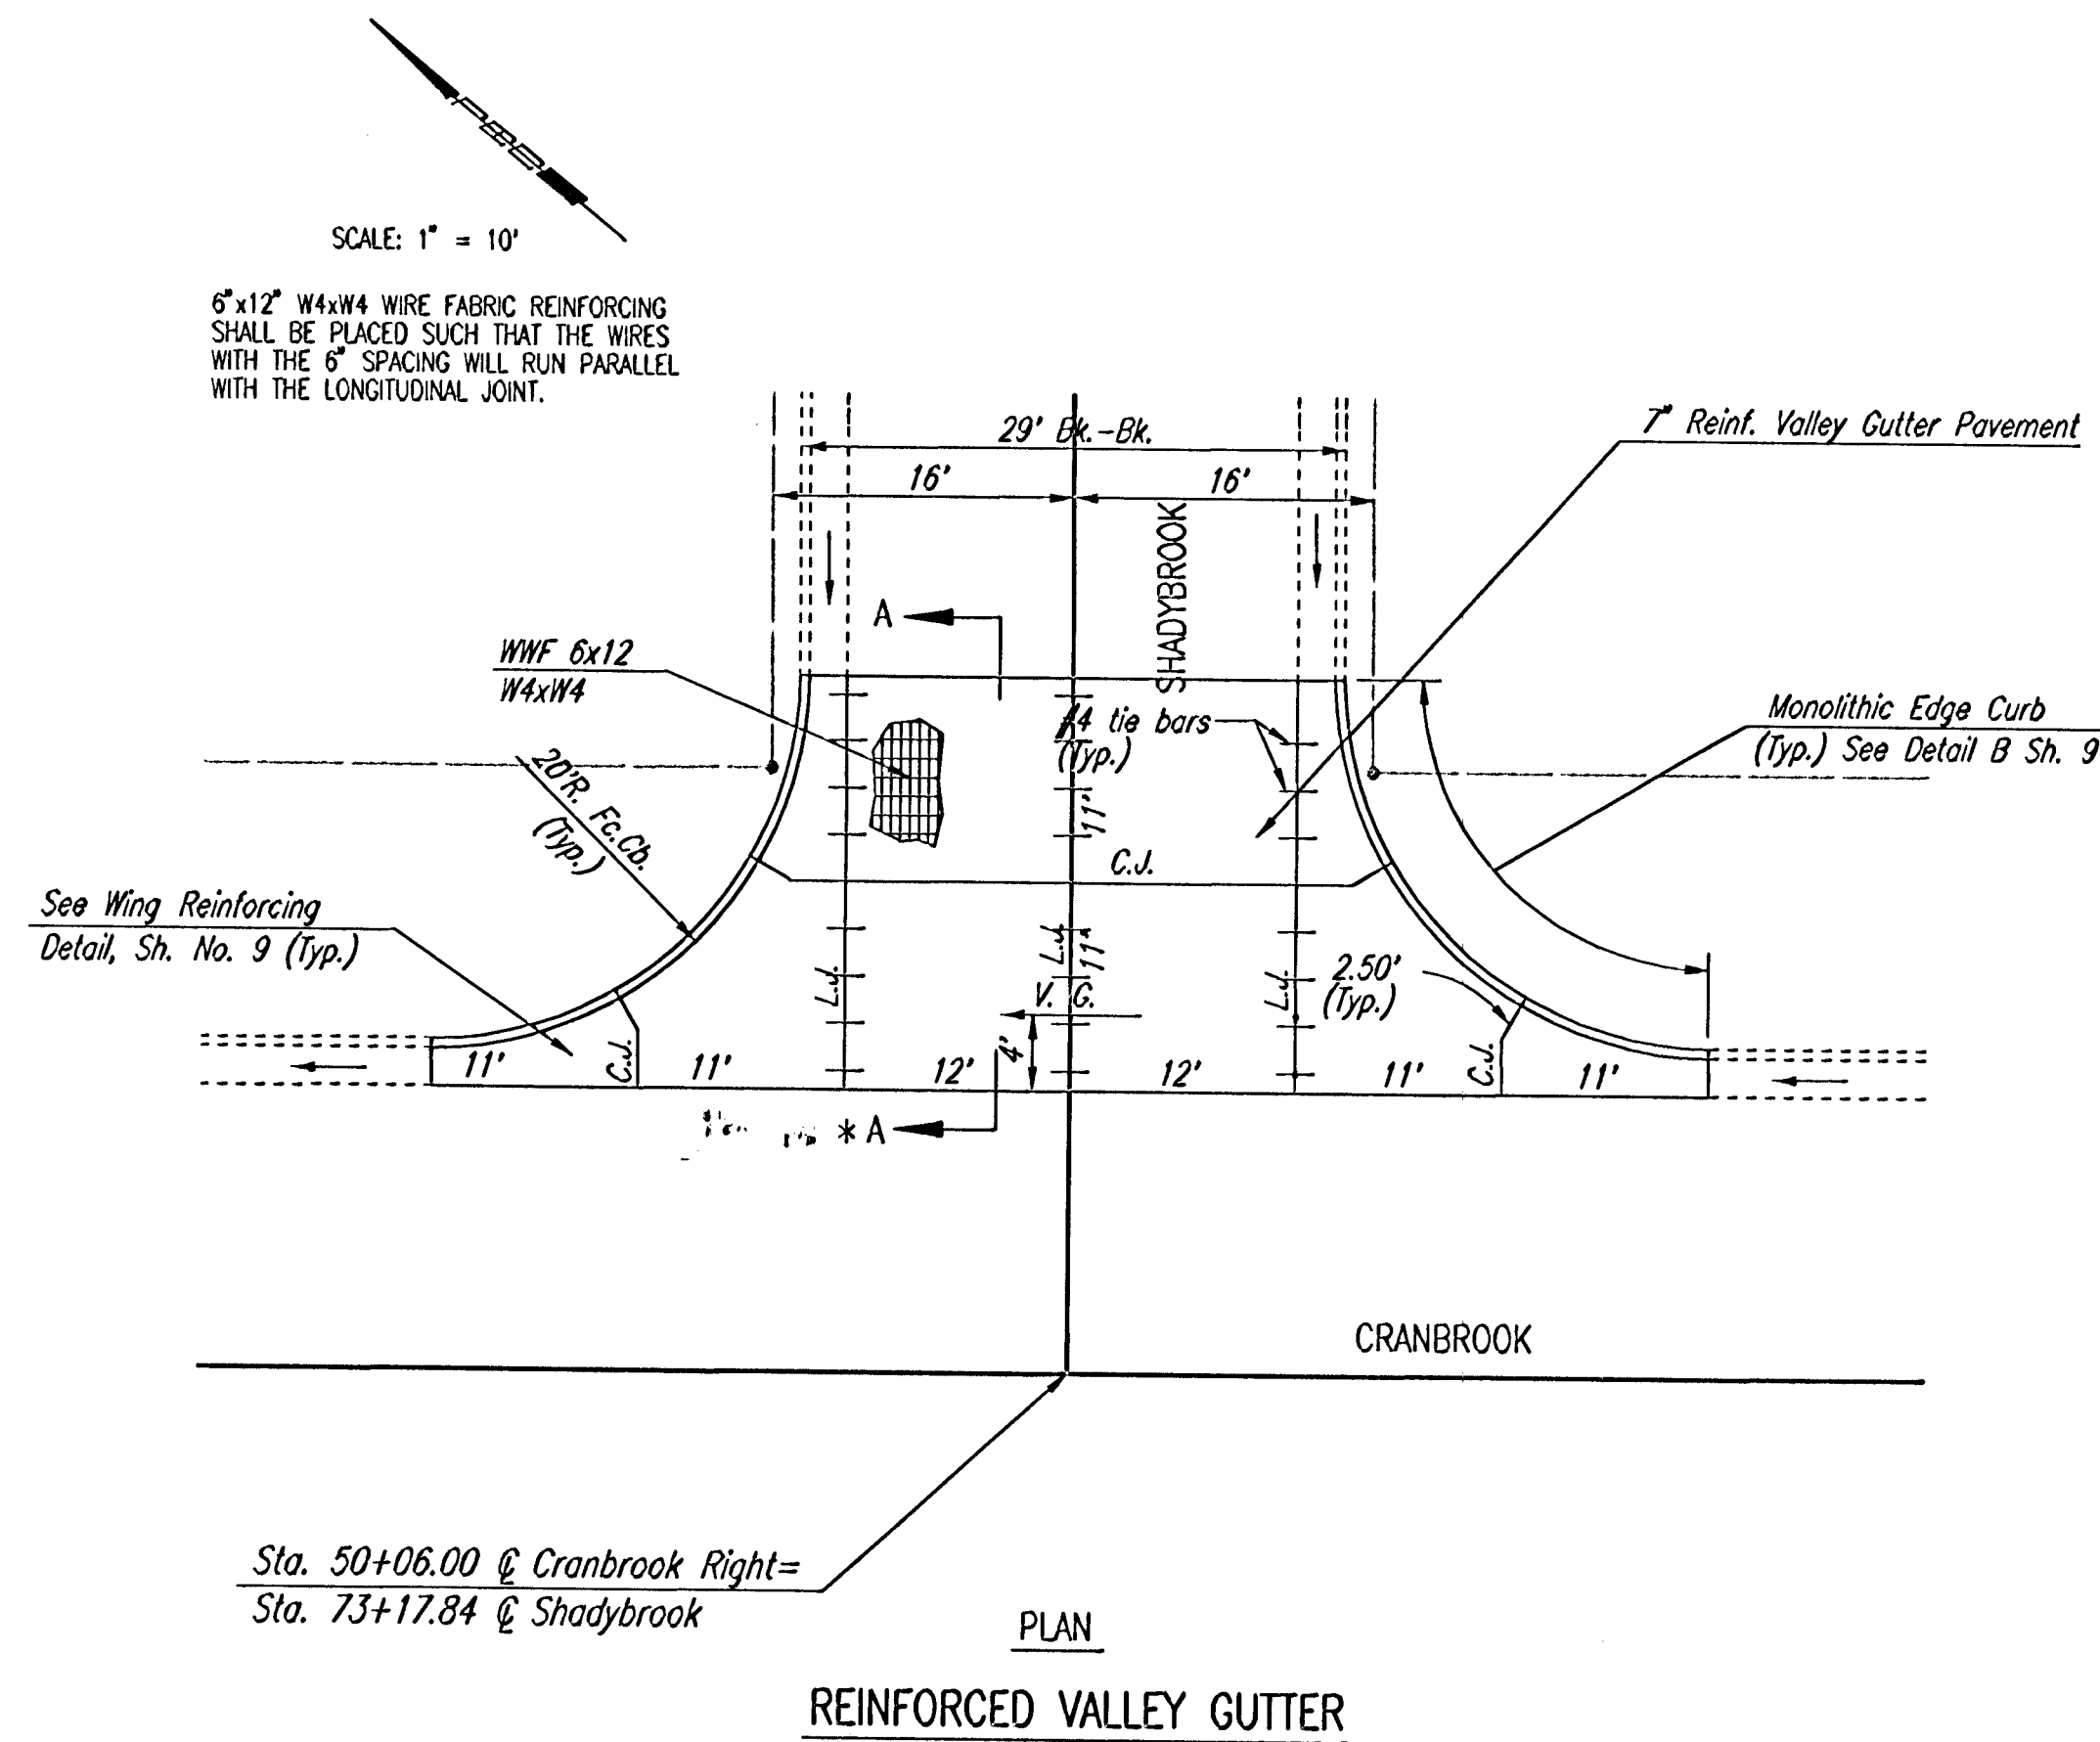
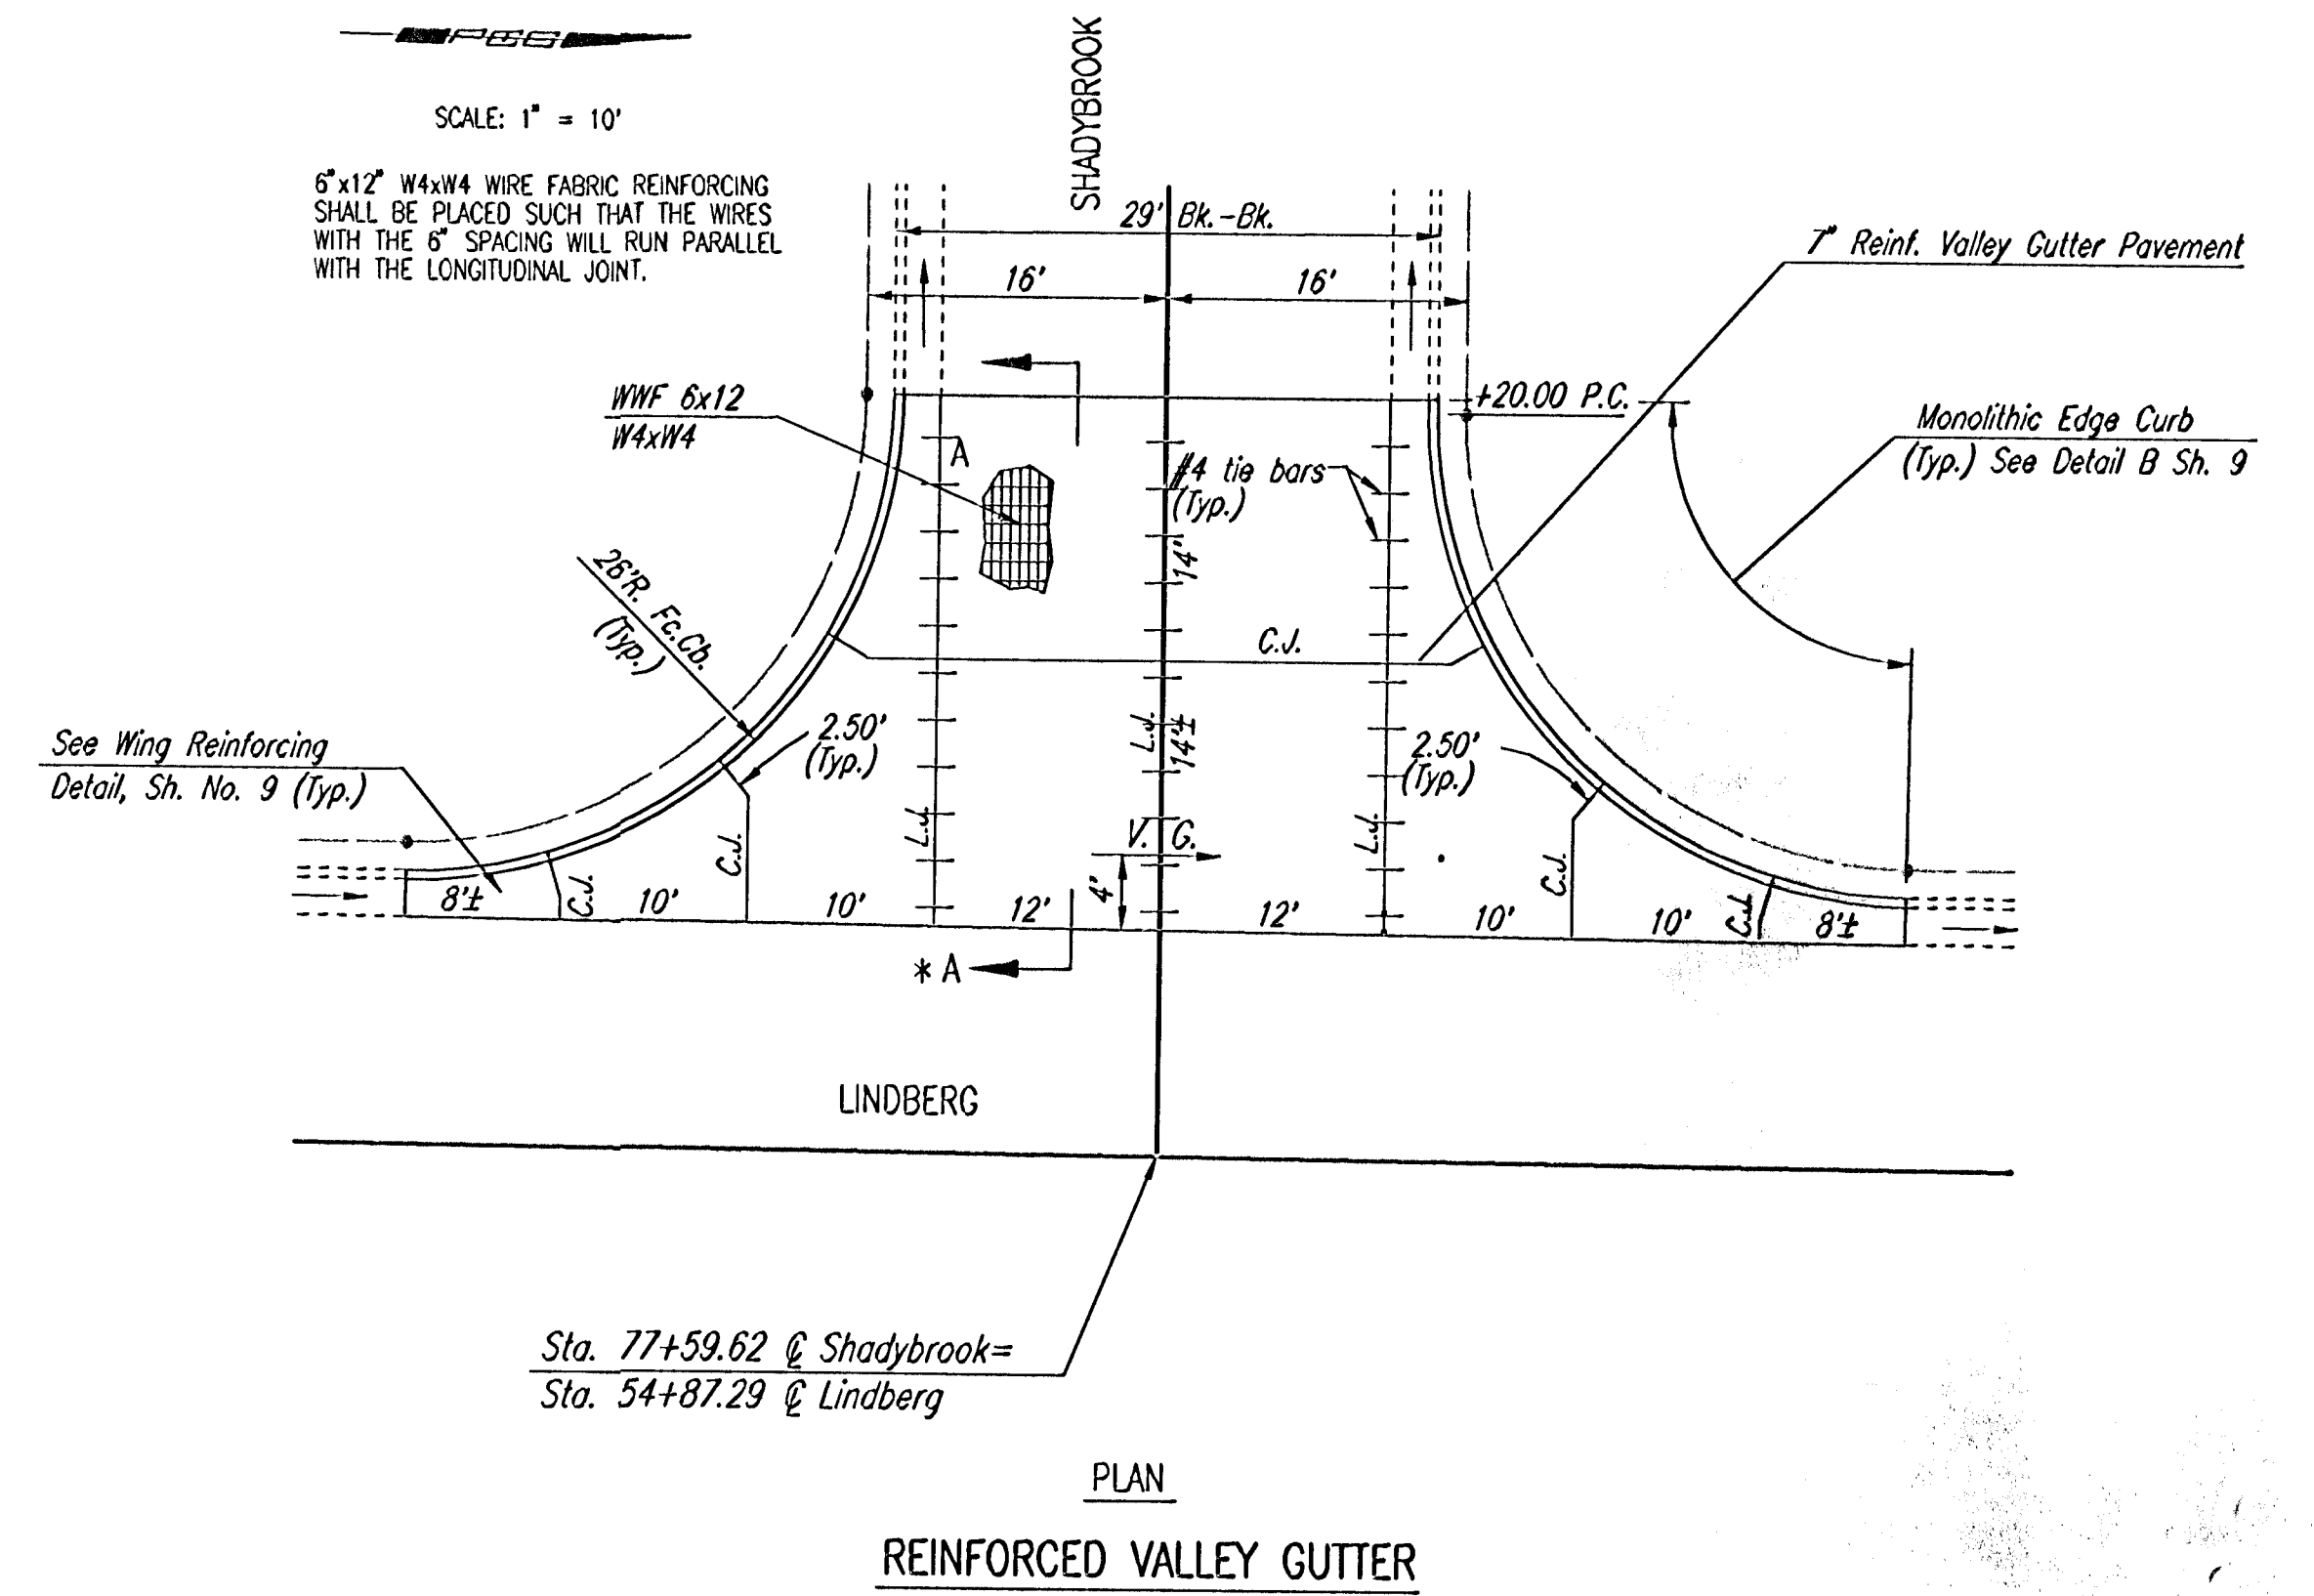


PROJECT NO.	SHEET NO.	TOTAL SHEETS
472-83377	10	23

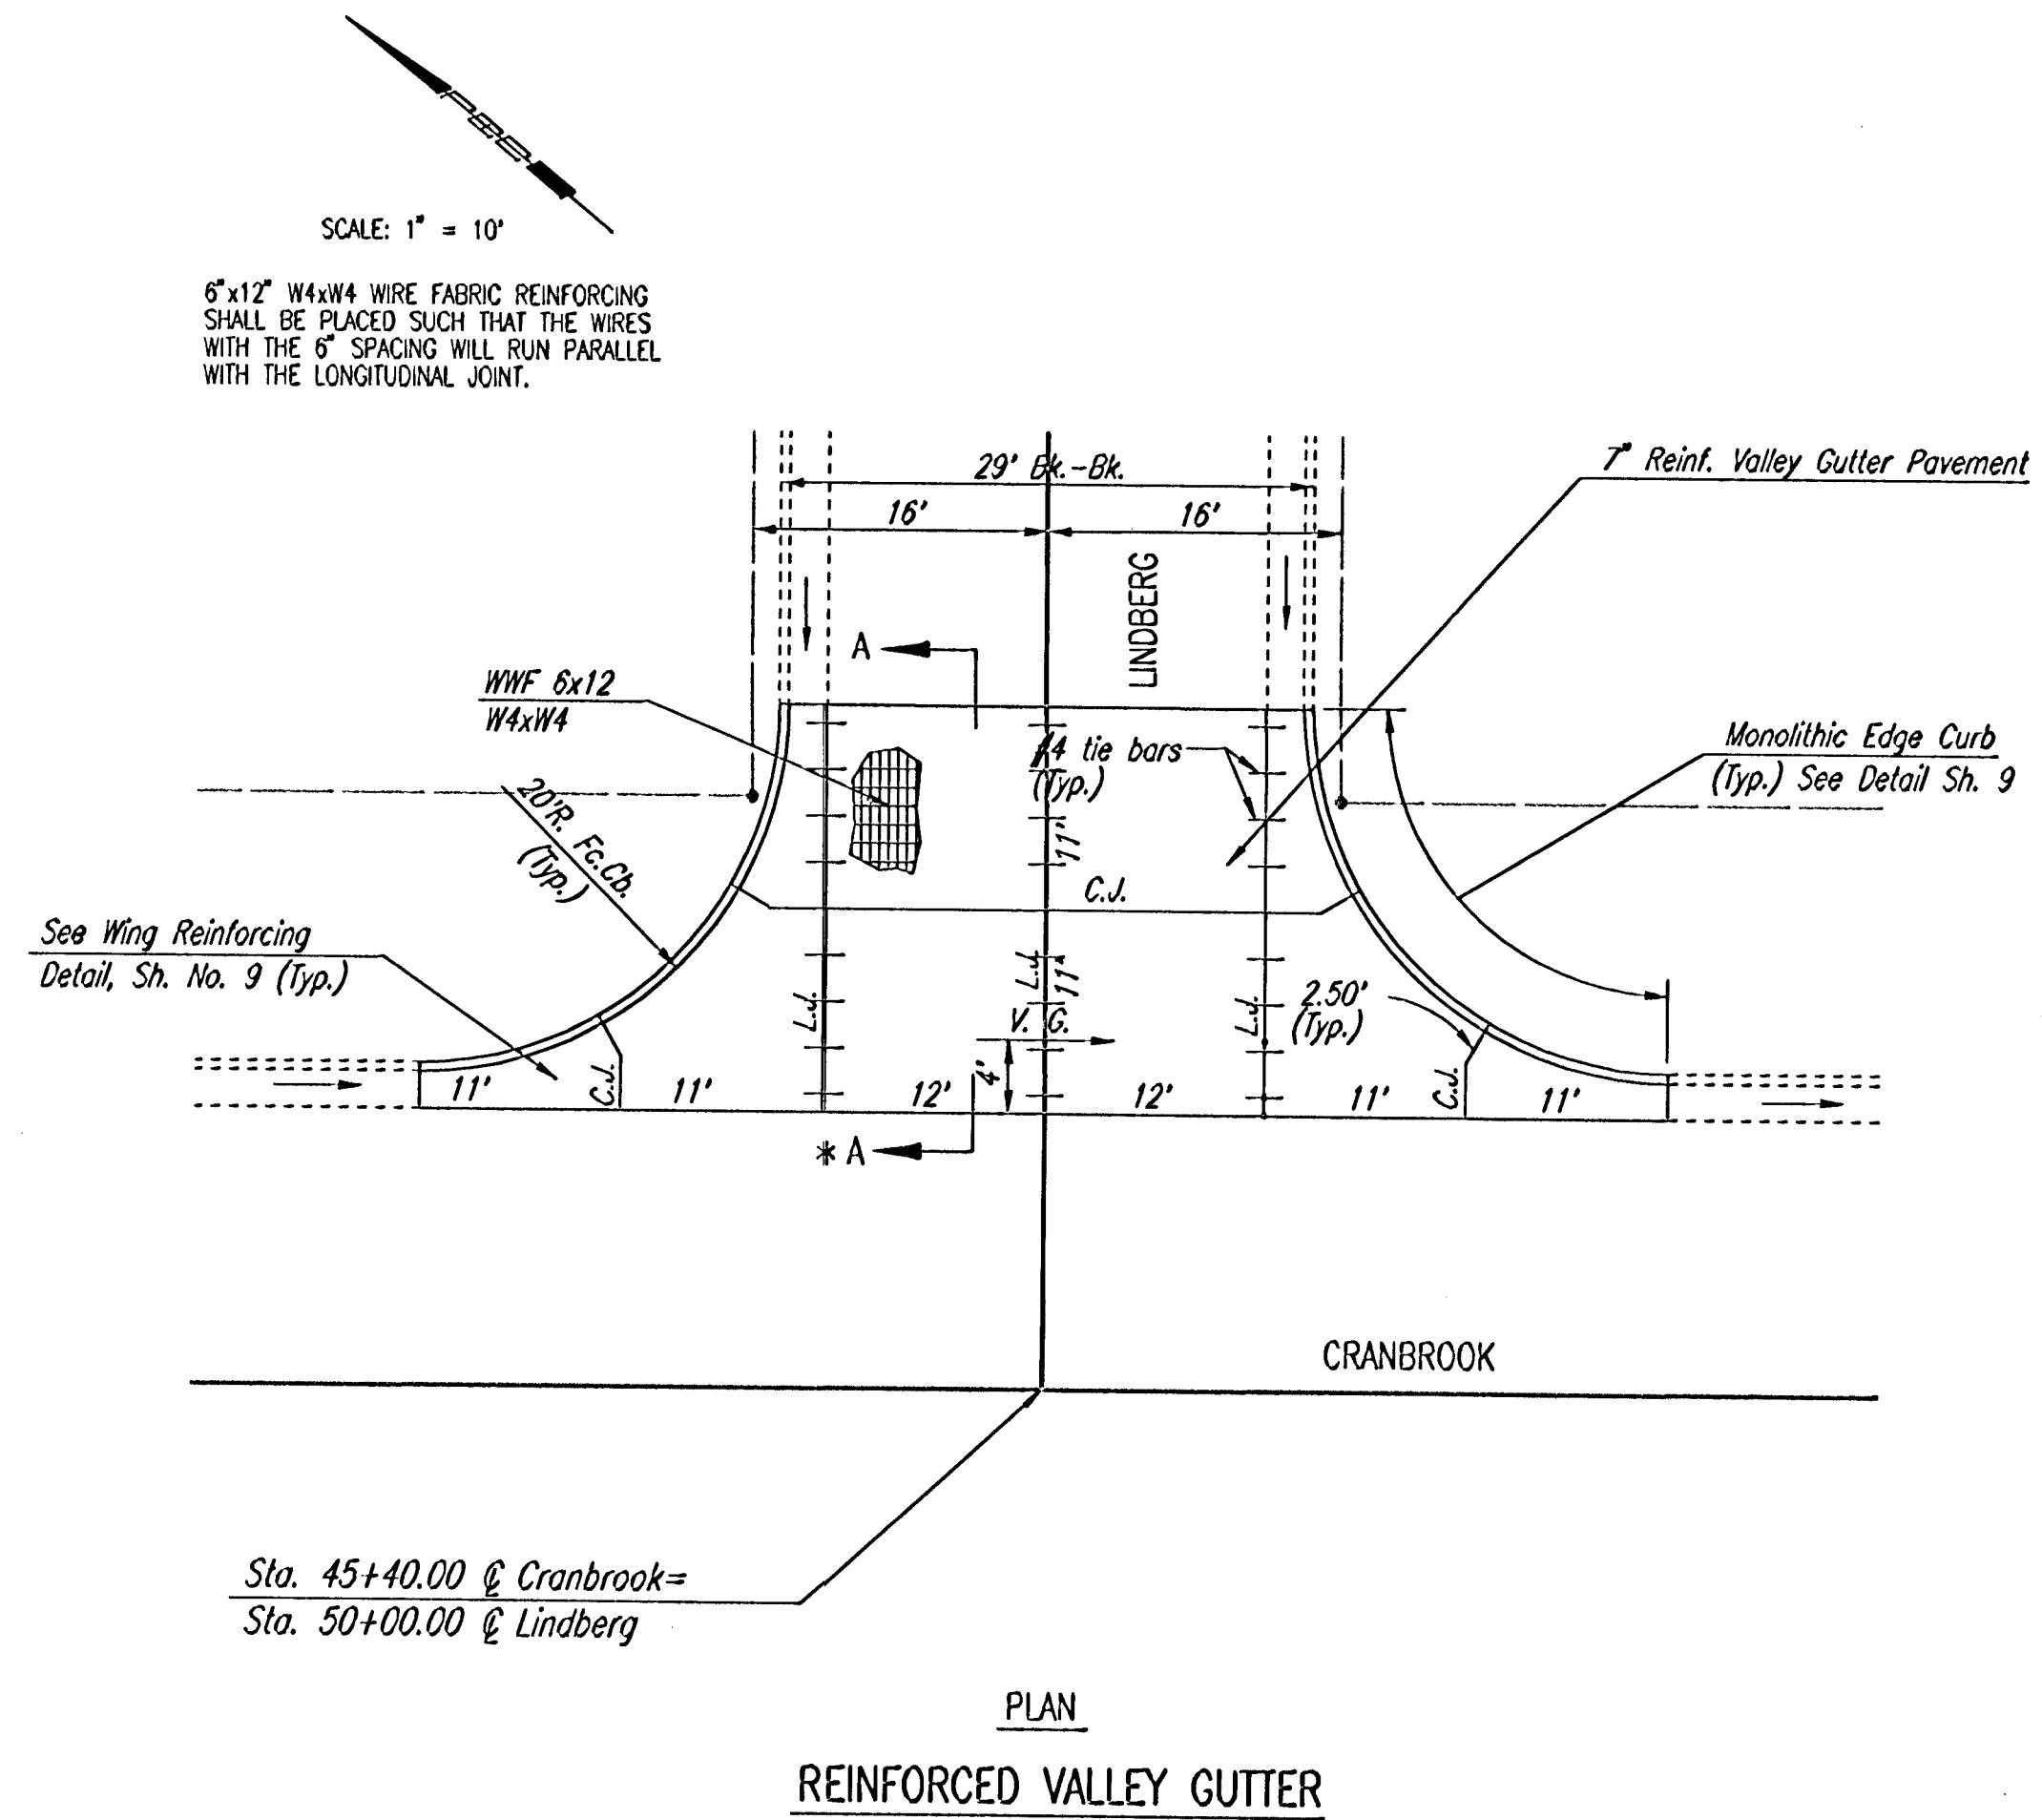

RECORD DRAWING

24 NOV 03

REMINGTON PLACE - PHASE 3

VALLEY GUTTER PLANS



Professional Engineering Consultants, P.A.
303 S. TOPEKA • WICHITA, KANSAS 67202
316-262-2691 • FAX 316-262-3003

Designed by BER
Drawn by DEP

Checked by
Date DEC, 2002

Job No. 02398-004

* See Sh. No. 9 for Section A-A