


NOTE BOOK TEMPLATE
AREAS CHECKED
NO.

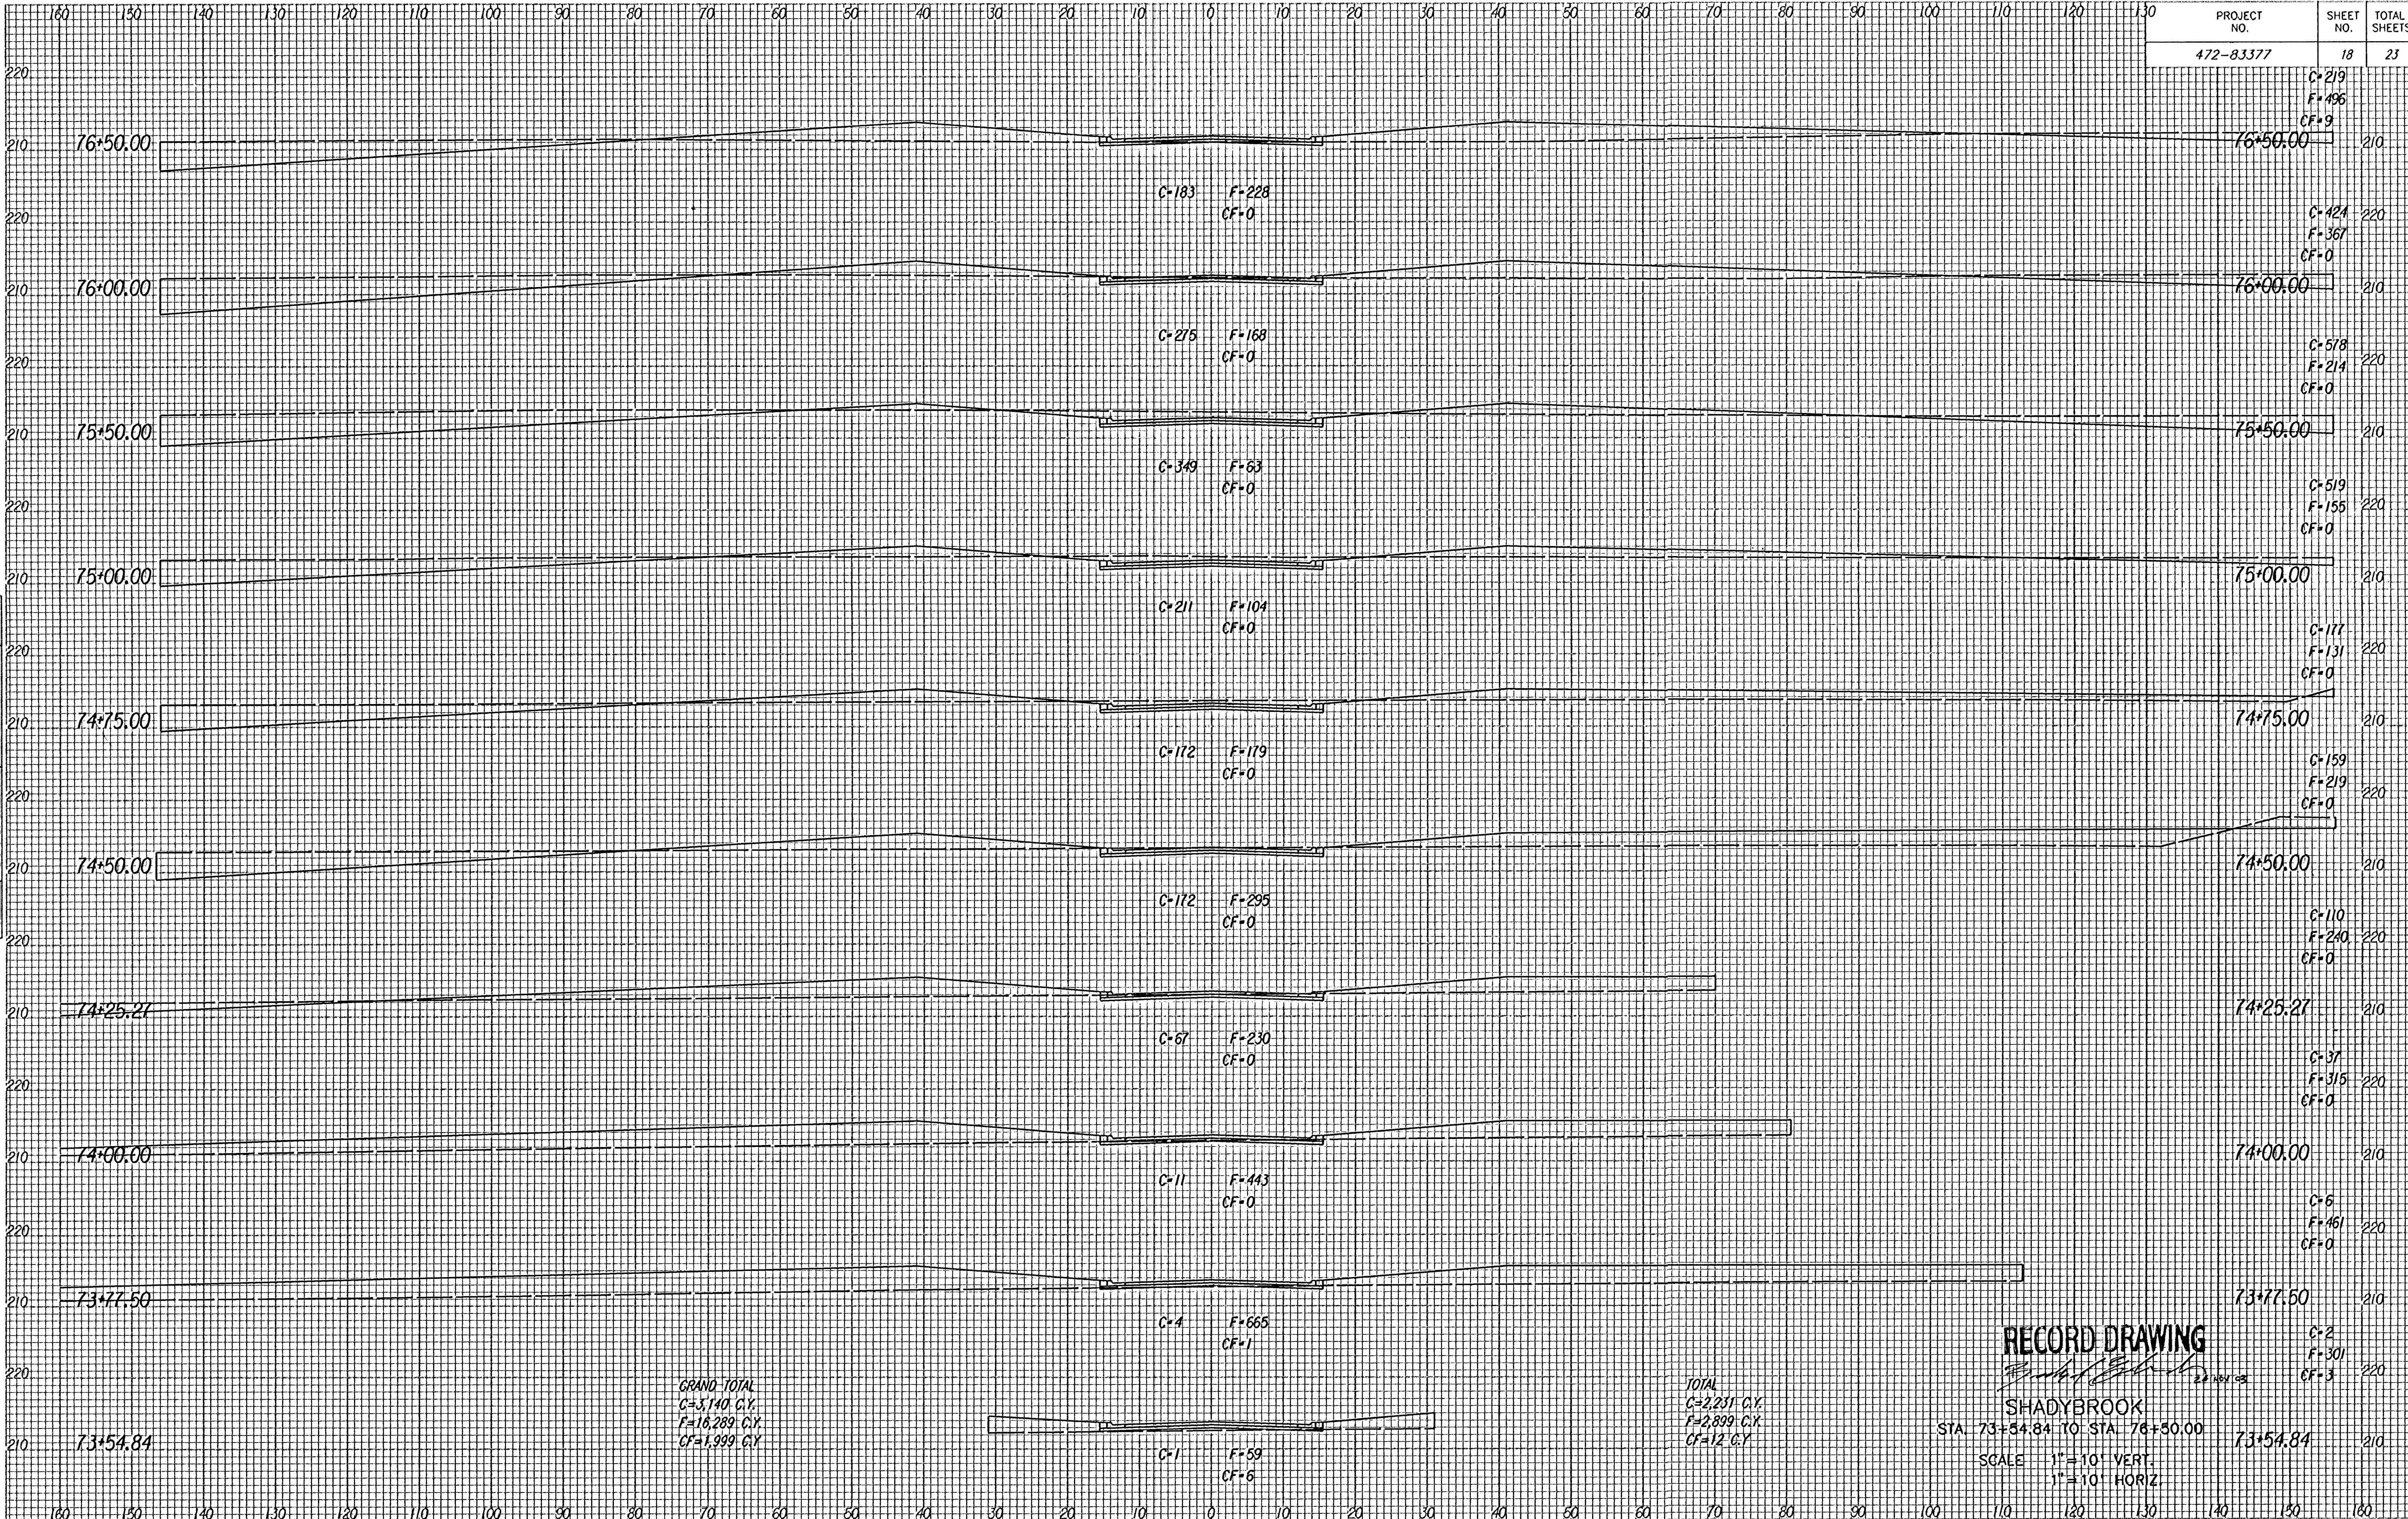

RECORD DRAWING

SHADYBROOK

STA. 73+54.84 TO STA. 76+50.00

SCALE 1"=10' VERT.
1"=10' HORIZ

PROJECT NO.	SHEET NO.	TOTAL SHEETS
472-83377	18	23
C=219 F=496 CF=9	210	
C=424 F=367 CF=0	220	
C=578 F=214 CF=0	220	
C=519 F=155 CF=0	220	
C=177 F=131 CF=0	220	
C=159 F=219 CF=0	220	
C=110 F=240 CF=0	220	
C=37 F=315 CF=0	220	
C=6 F=461 CF=0	220	
C=2 F=301 CF=3	220	