


NOTE BOOK	TEMPLATE	AREAS	CHECKED
NO.			

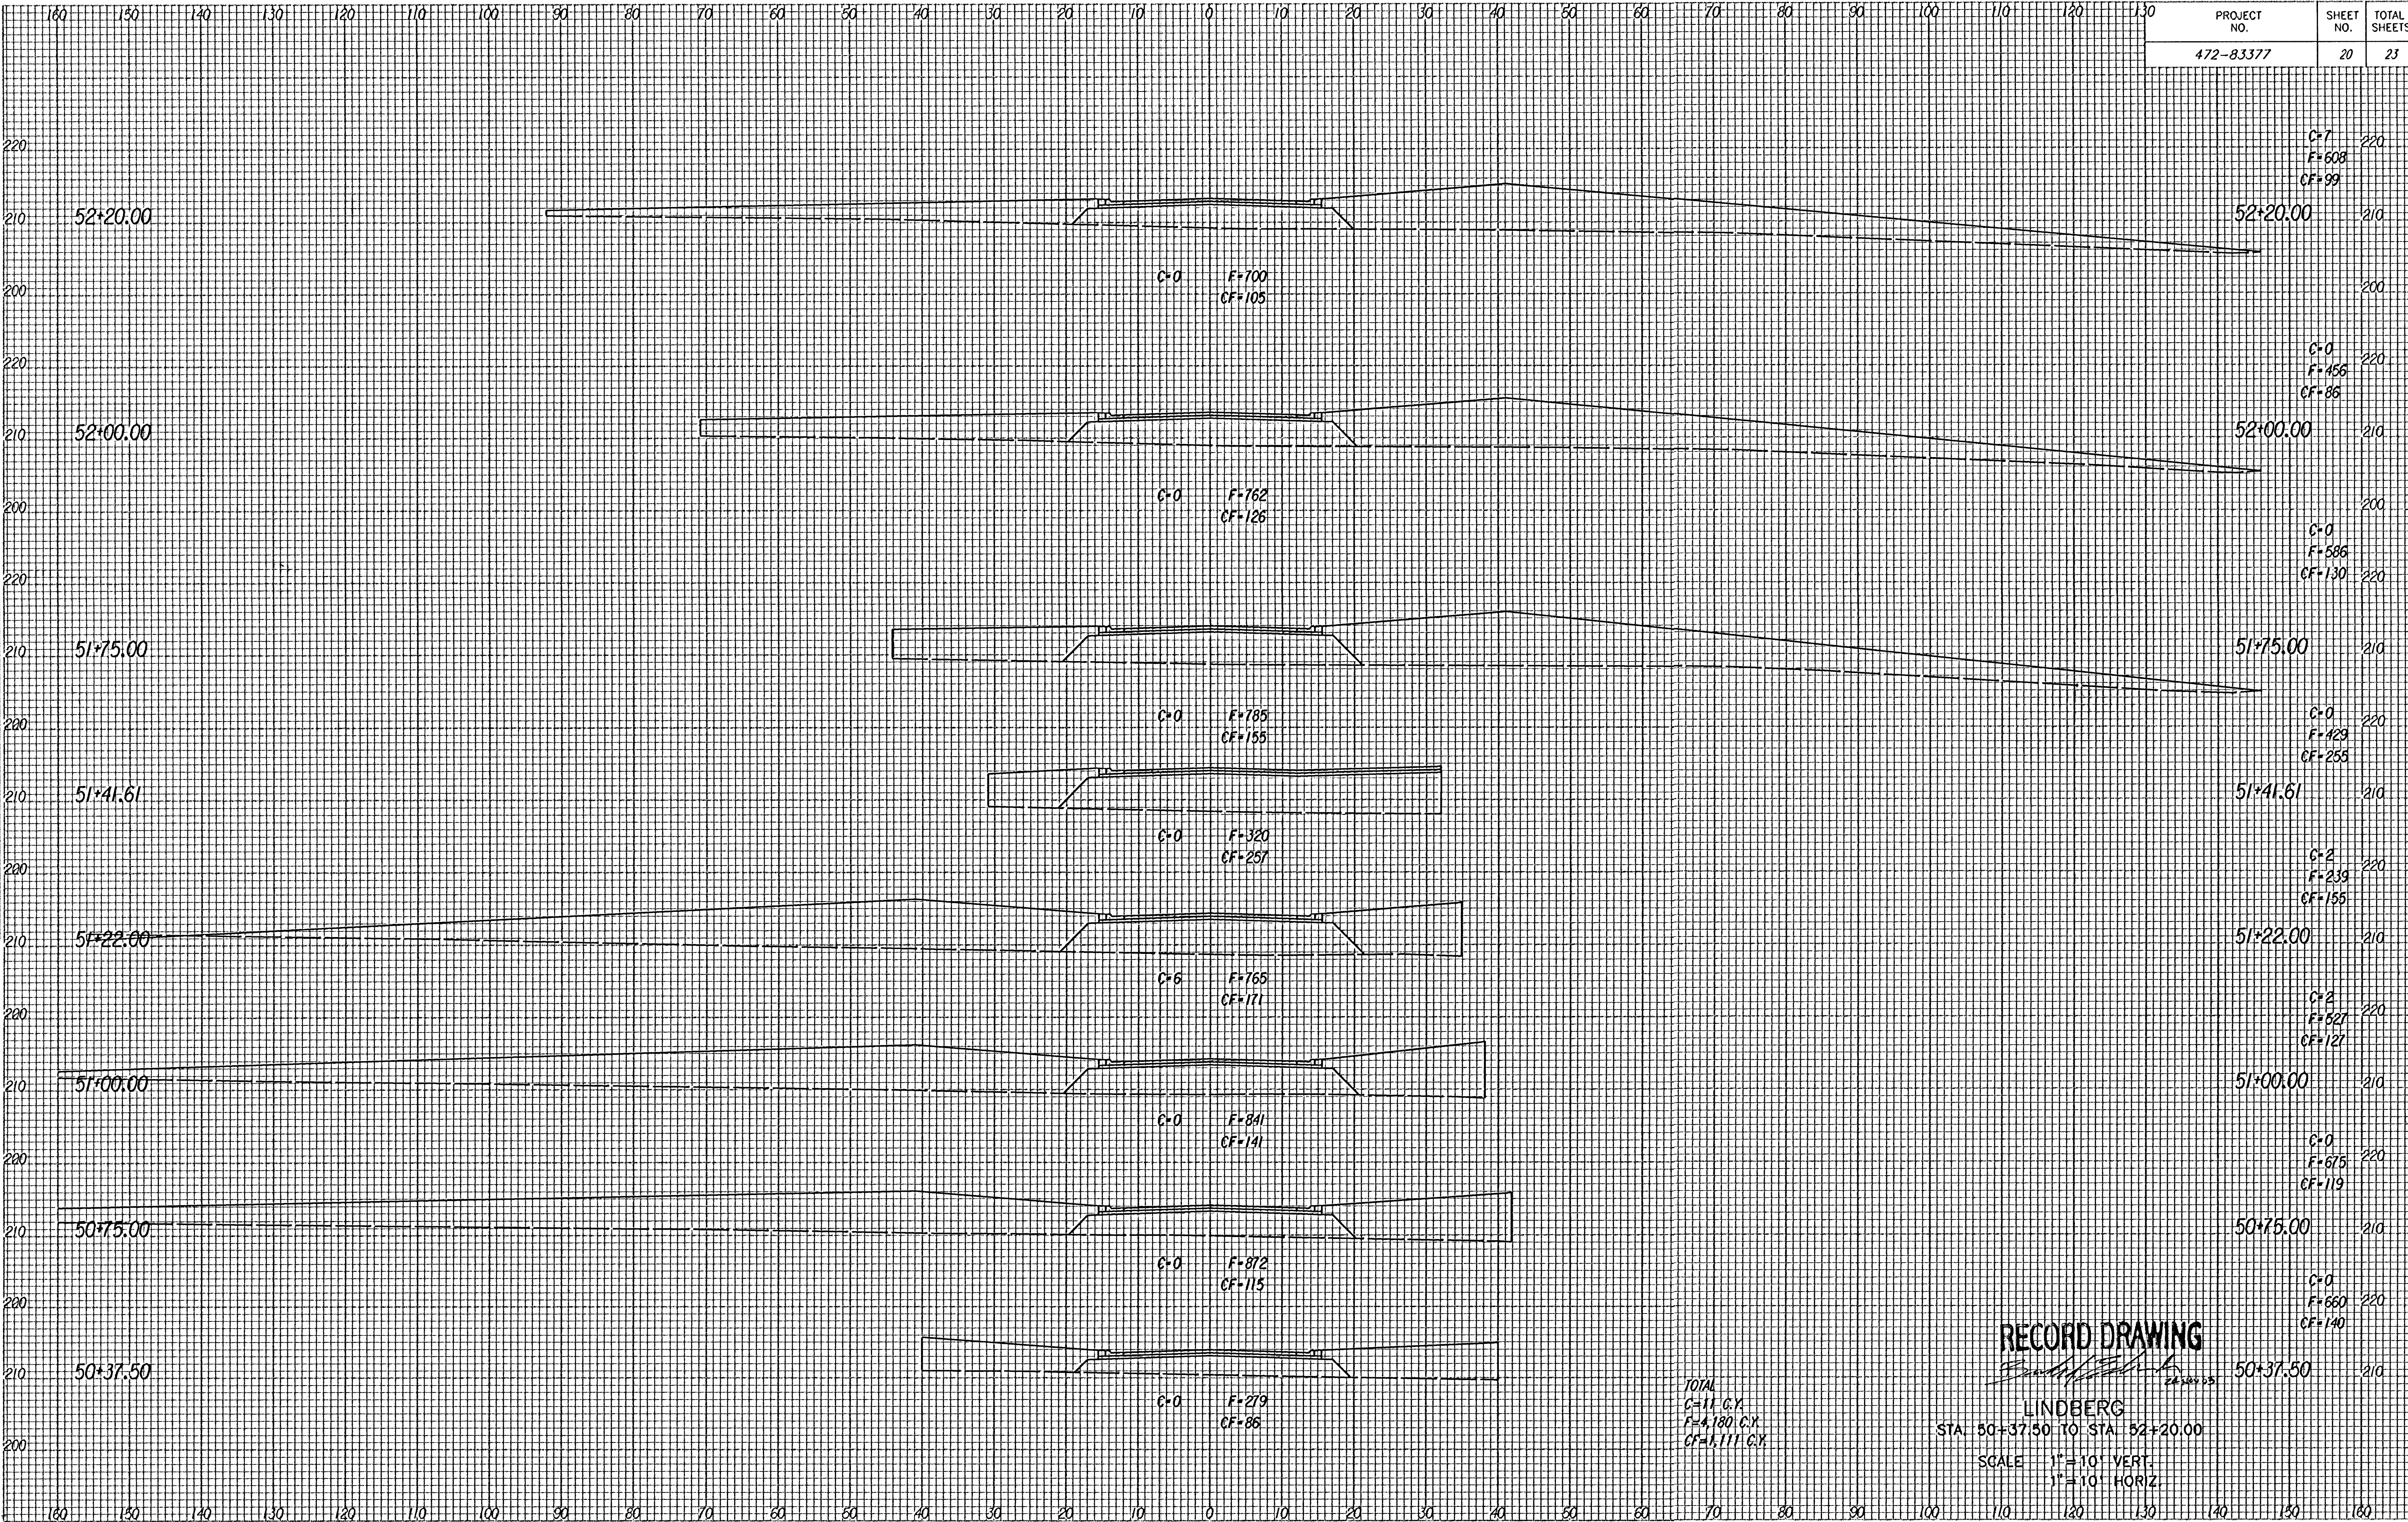

PROJECT NO.	SHEET NO.	TOTAL SHEETS
472-83377	20	23

TOTAL
C=11 C.Y.
F=4,180 C.Y.
CF=5,111 C.Y.

RECORD DRAWING

[Signature] 22 JUN 55

LINDBERG

STA. 50+37.50 TO STA. 52+20.00

SCALE 1"=10' VERT.
1"=10' HORIZ.