


NOTE BOOK	TEMPLATE	AREAS	CHECKED
NO.			

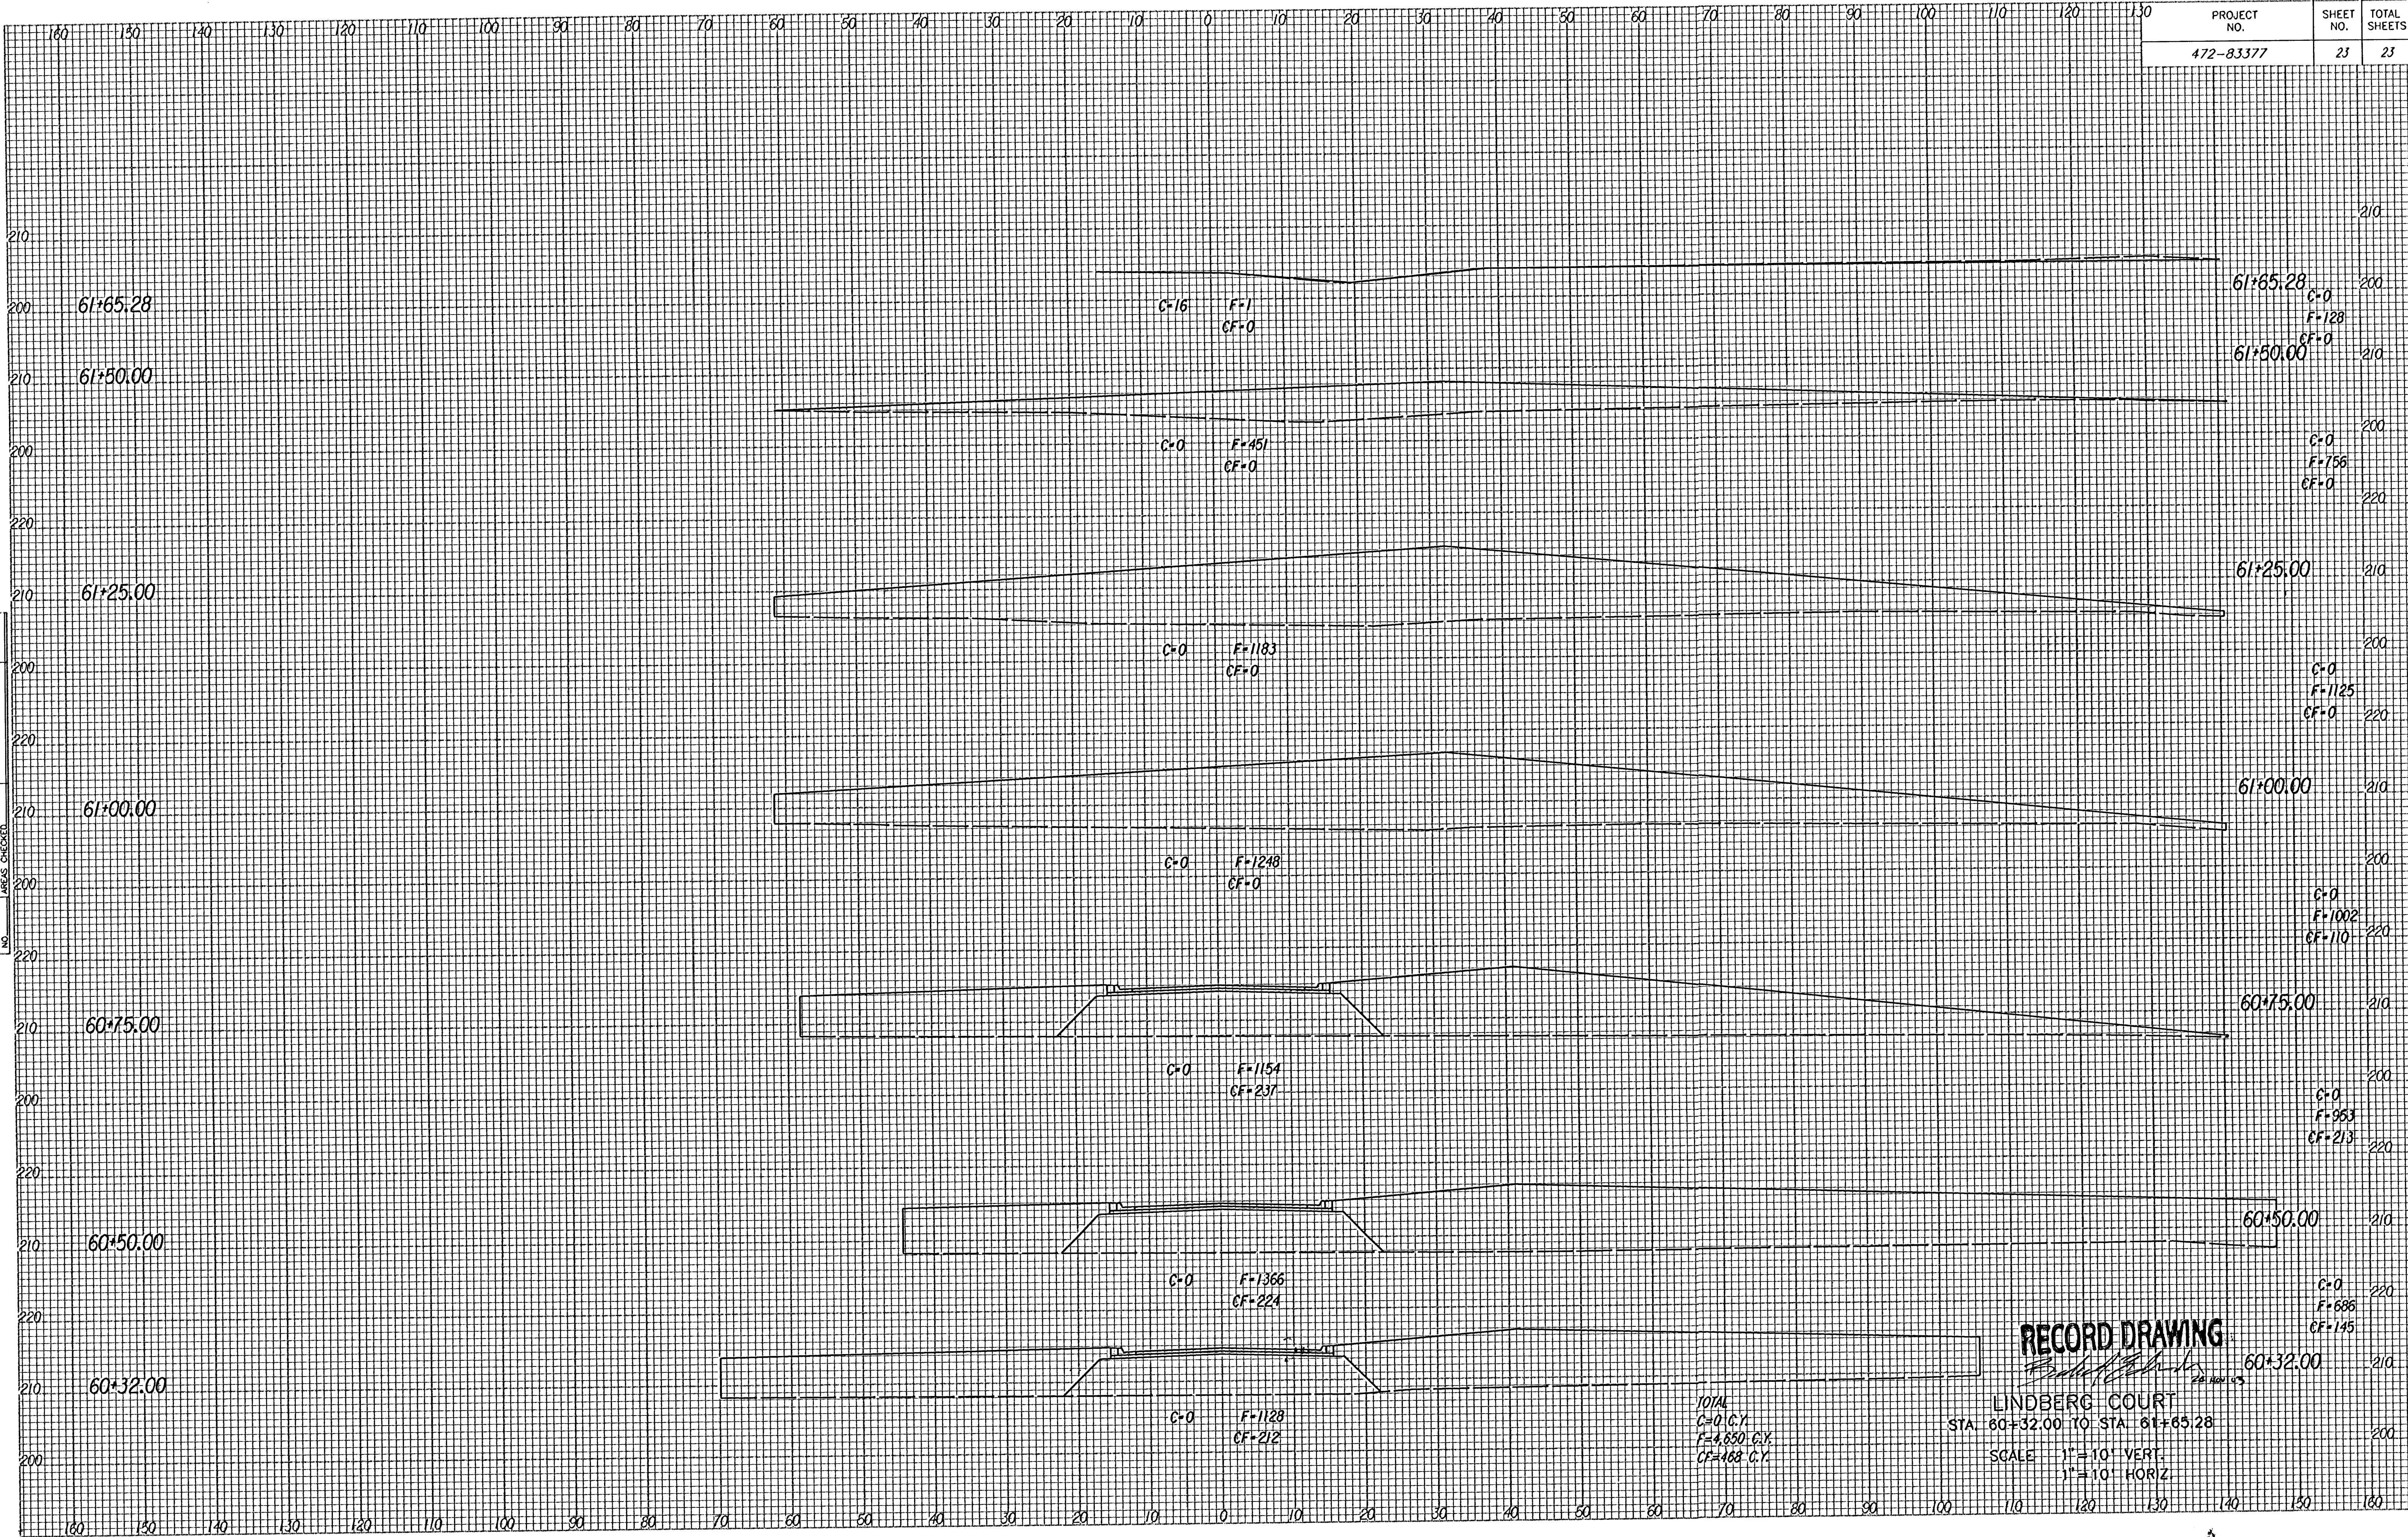

RECORD DRAWING

LINDBERG COURT
 STA. 60+32.00 TO STA. 61+65.28
 SCALE 1"=10' VERT.
 1"=10' HORIZ.