



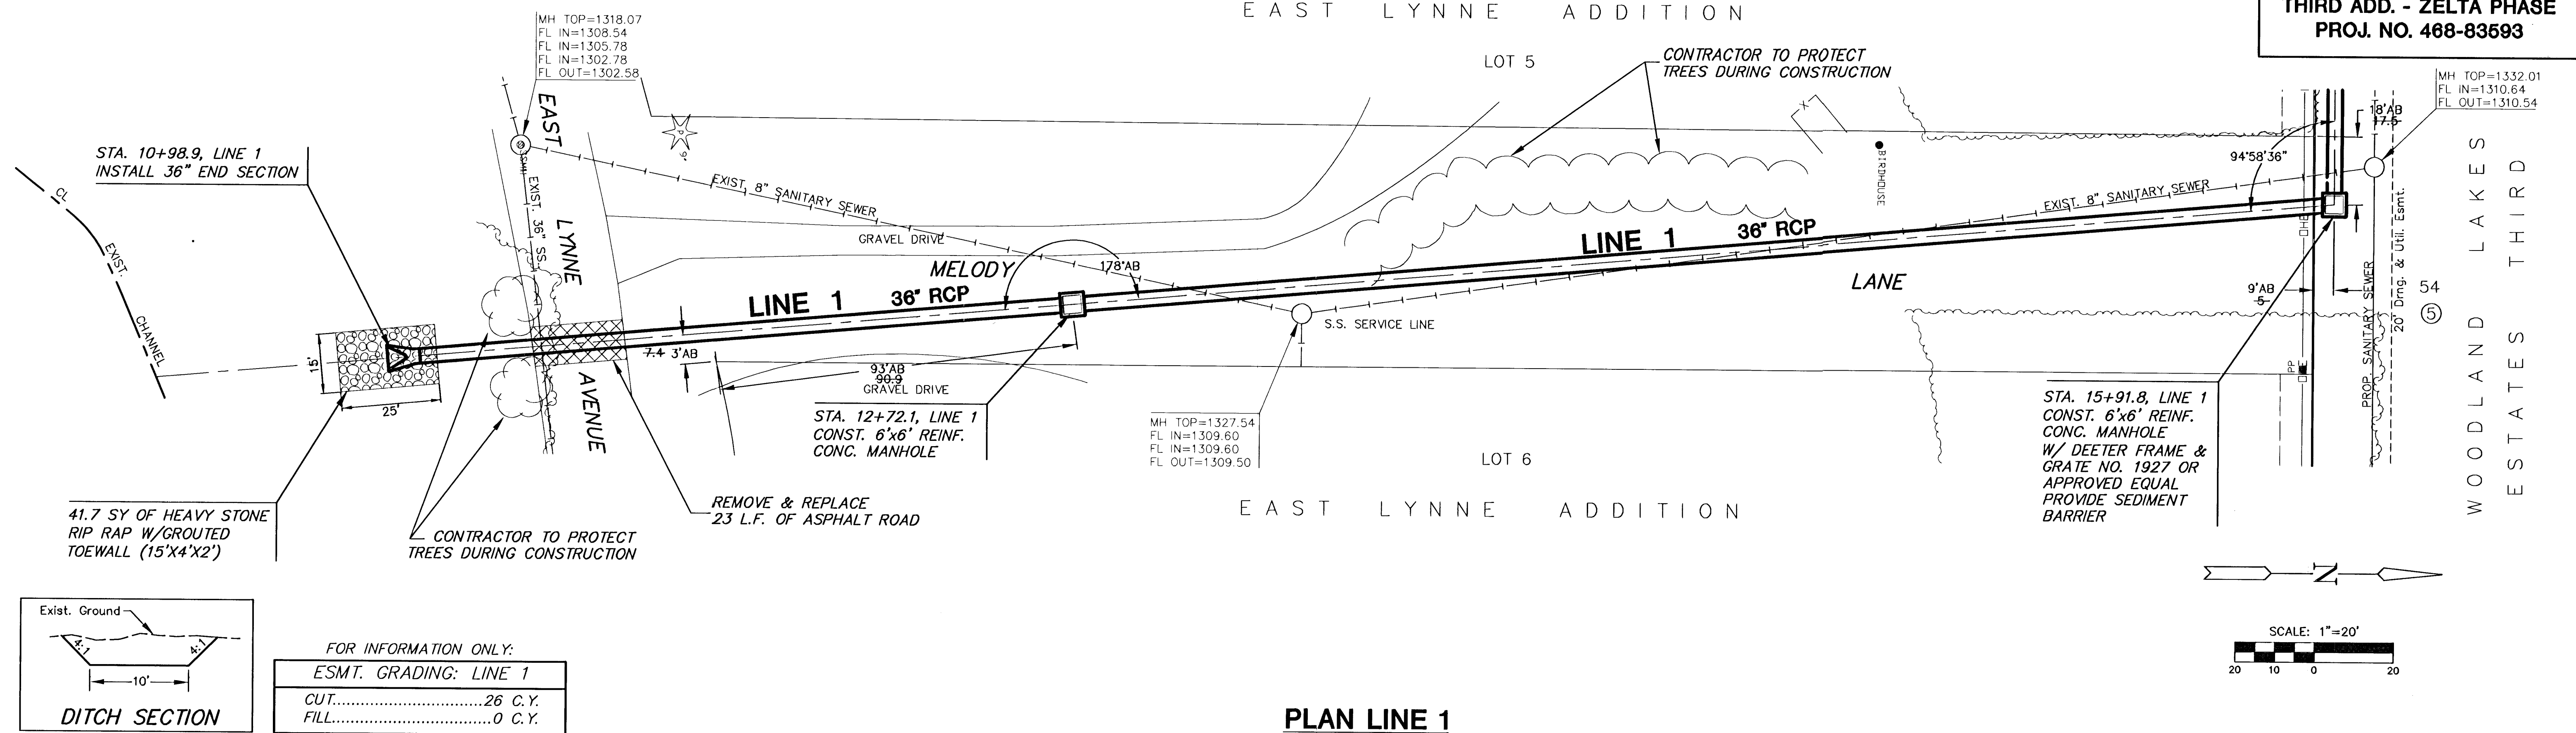

PLAN LINE 1

PROFILE LINE 1

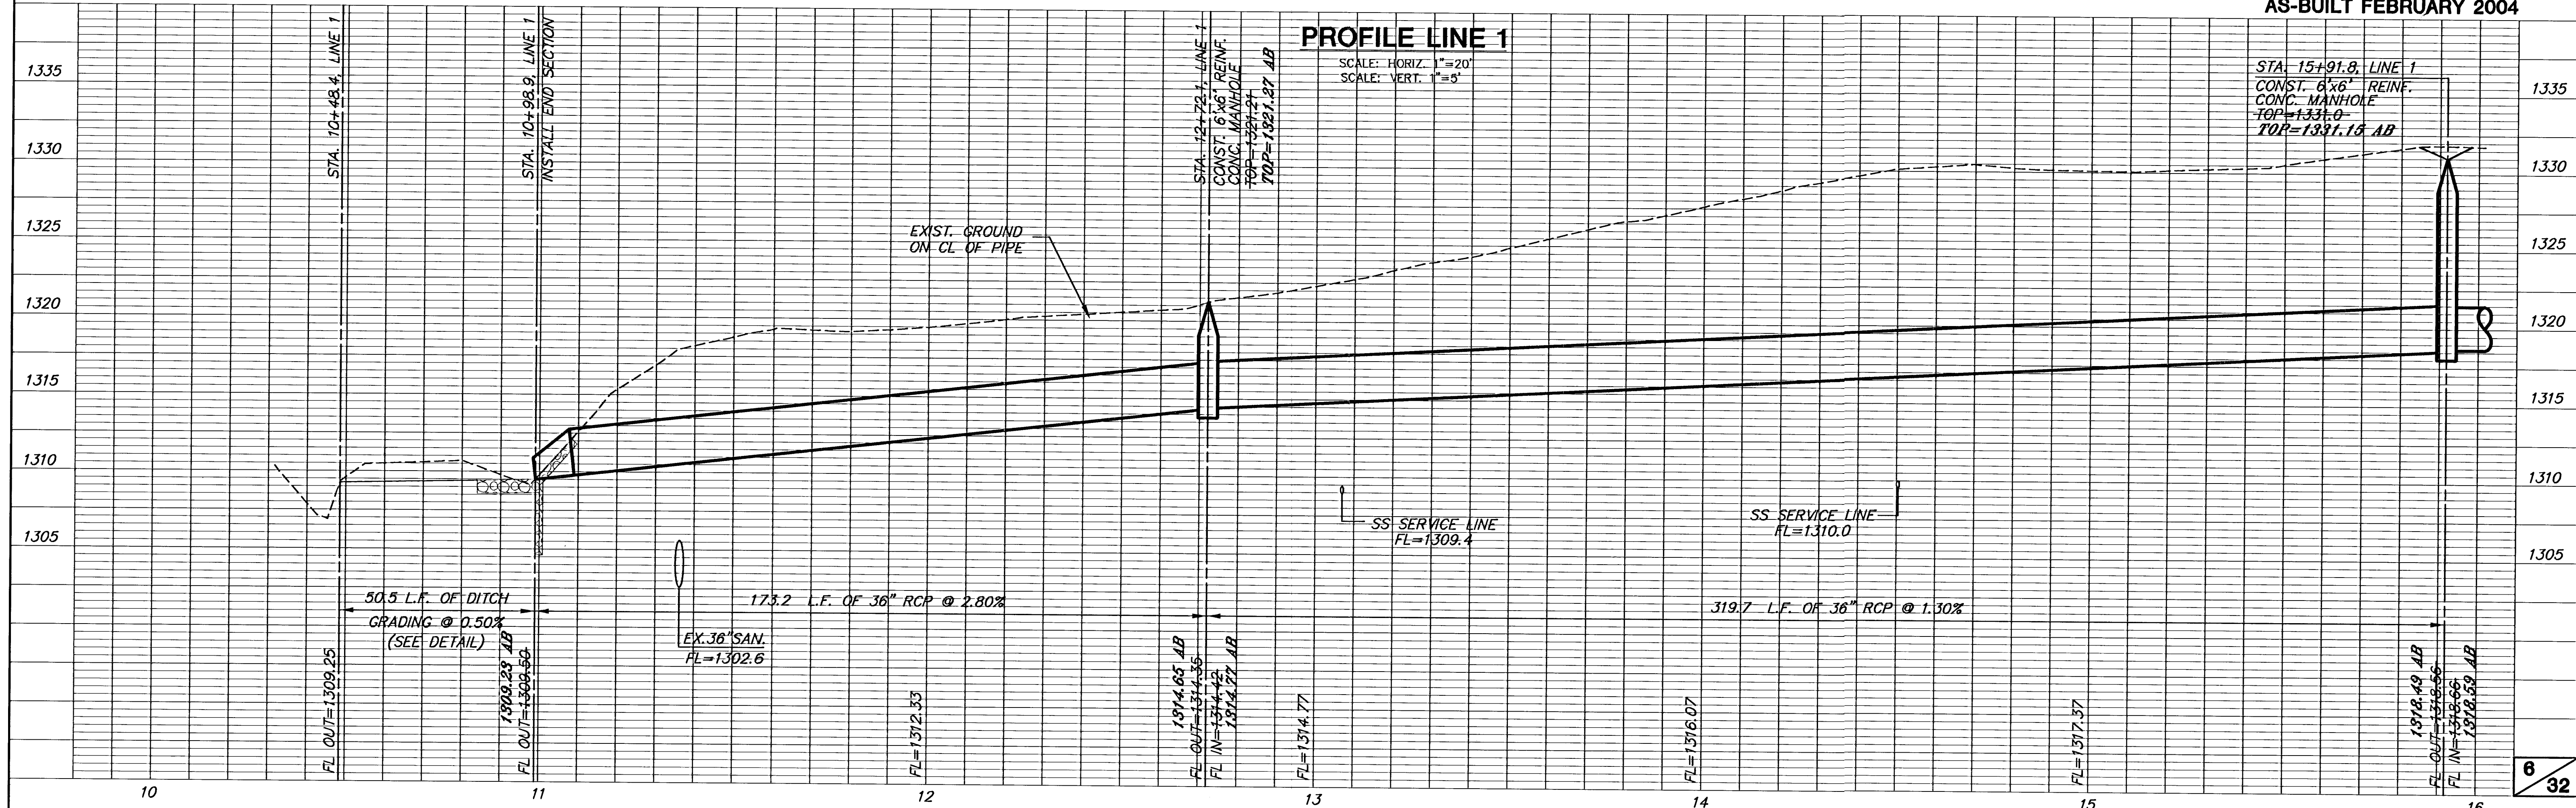

AS-BUILT FEBRUARY 2004