


**PLAN LINE 2**

**PLAN LINE 3**

AS-BUILT FEBRUARY 2004

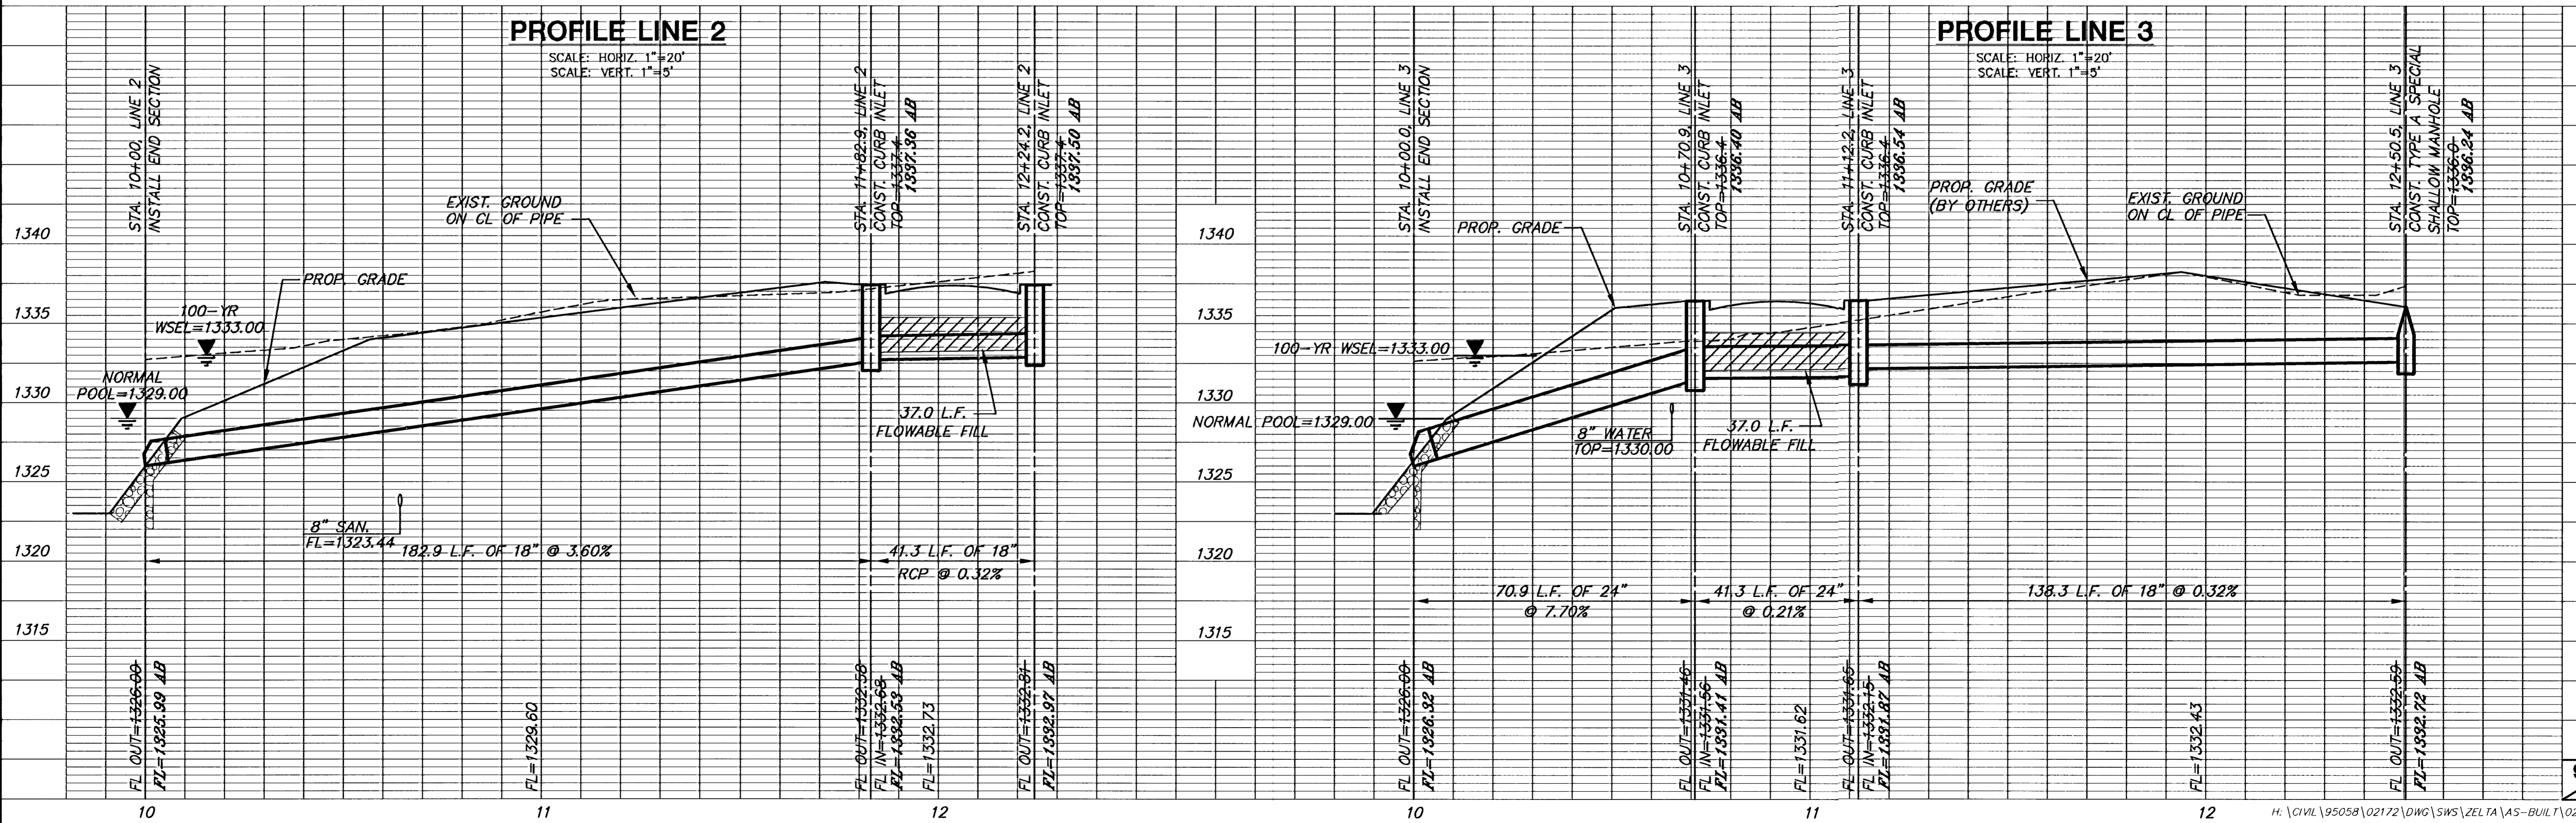

**PROFILE LINE 2**

**PROFILE LINE 3**