

MH TOP=1334.77
FL IN=1323.30
FL OUT=1323.20


MH TOP=1328.63
FL IN=1318.28
FL OUT=1318.18

MH TOP=13XX.XX
FL IN=
FL OUT=

Install 55.5 S.Y. of North American
Green C-350 Erosion Mat (or
Approved Equal) (Install per
Manufacturer's Recommendations)

NORMAL POOL=1329.00
100 YR=1332.00

LEGEND

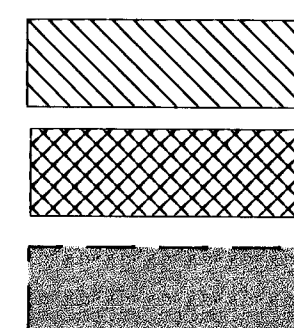

=LIMIT OF TREE REMOVAL

=PROPOSED WETLANDS MITIGATION
(SEE DETAIL ON SHEET 2)

=NORMAL POOL

--- = LIMITS OF GRADING


--- 1335 --- = EXIST. CONTOUR

--- 1335 --- = PROP. CONTOUR

--- 1335 --- = AS-BUILT CONTOUR

--- 1335 --- = AS-BUILT SPOT ELV.

PLAN VIEW

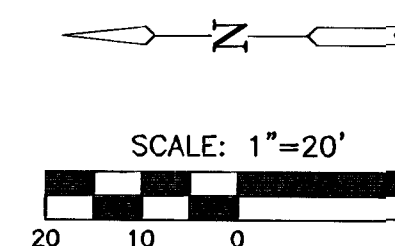

SCALE: 1"=20'

AS-BUILT FEBRUARY 2004



WOODLAND LAKES ESTATES
THIRD ADDITION - ZELTA PHASE
PROJECT NAME

POND GRADING
SHEET TITLE

BSH
DESIGN BY:

JAS/DMU
DRAWN BY:

ASH
CHECKED BY:

JULY 2003
DATE

02172
JOB NO.

18 / 32
SHEET/OF