



G:\APPS\UCC\AP\748\base.dwg Mon Apr 05 11:55:15 2004 Bernard Kulla, Poe & Associates Inc.

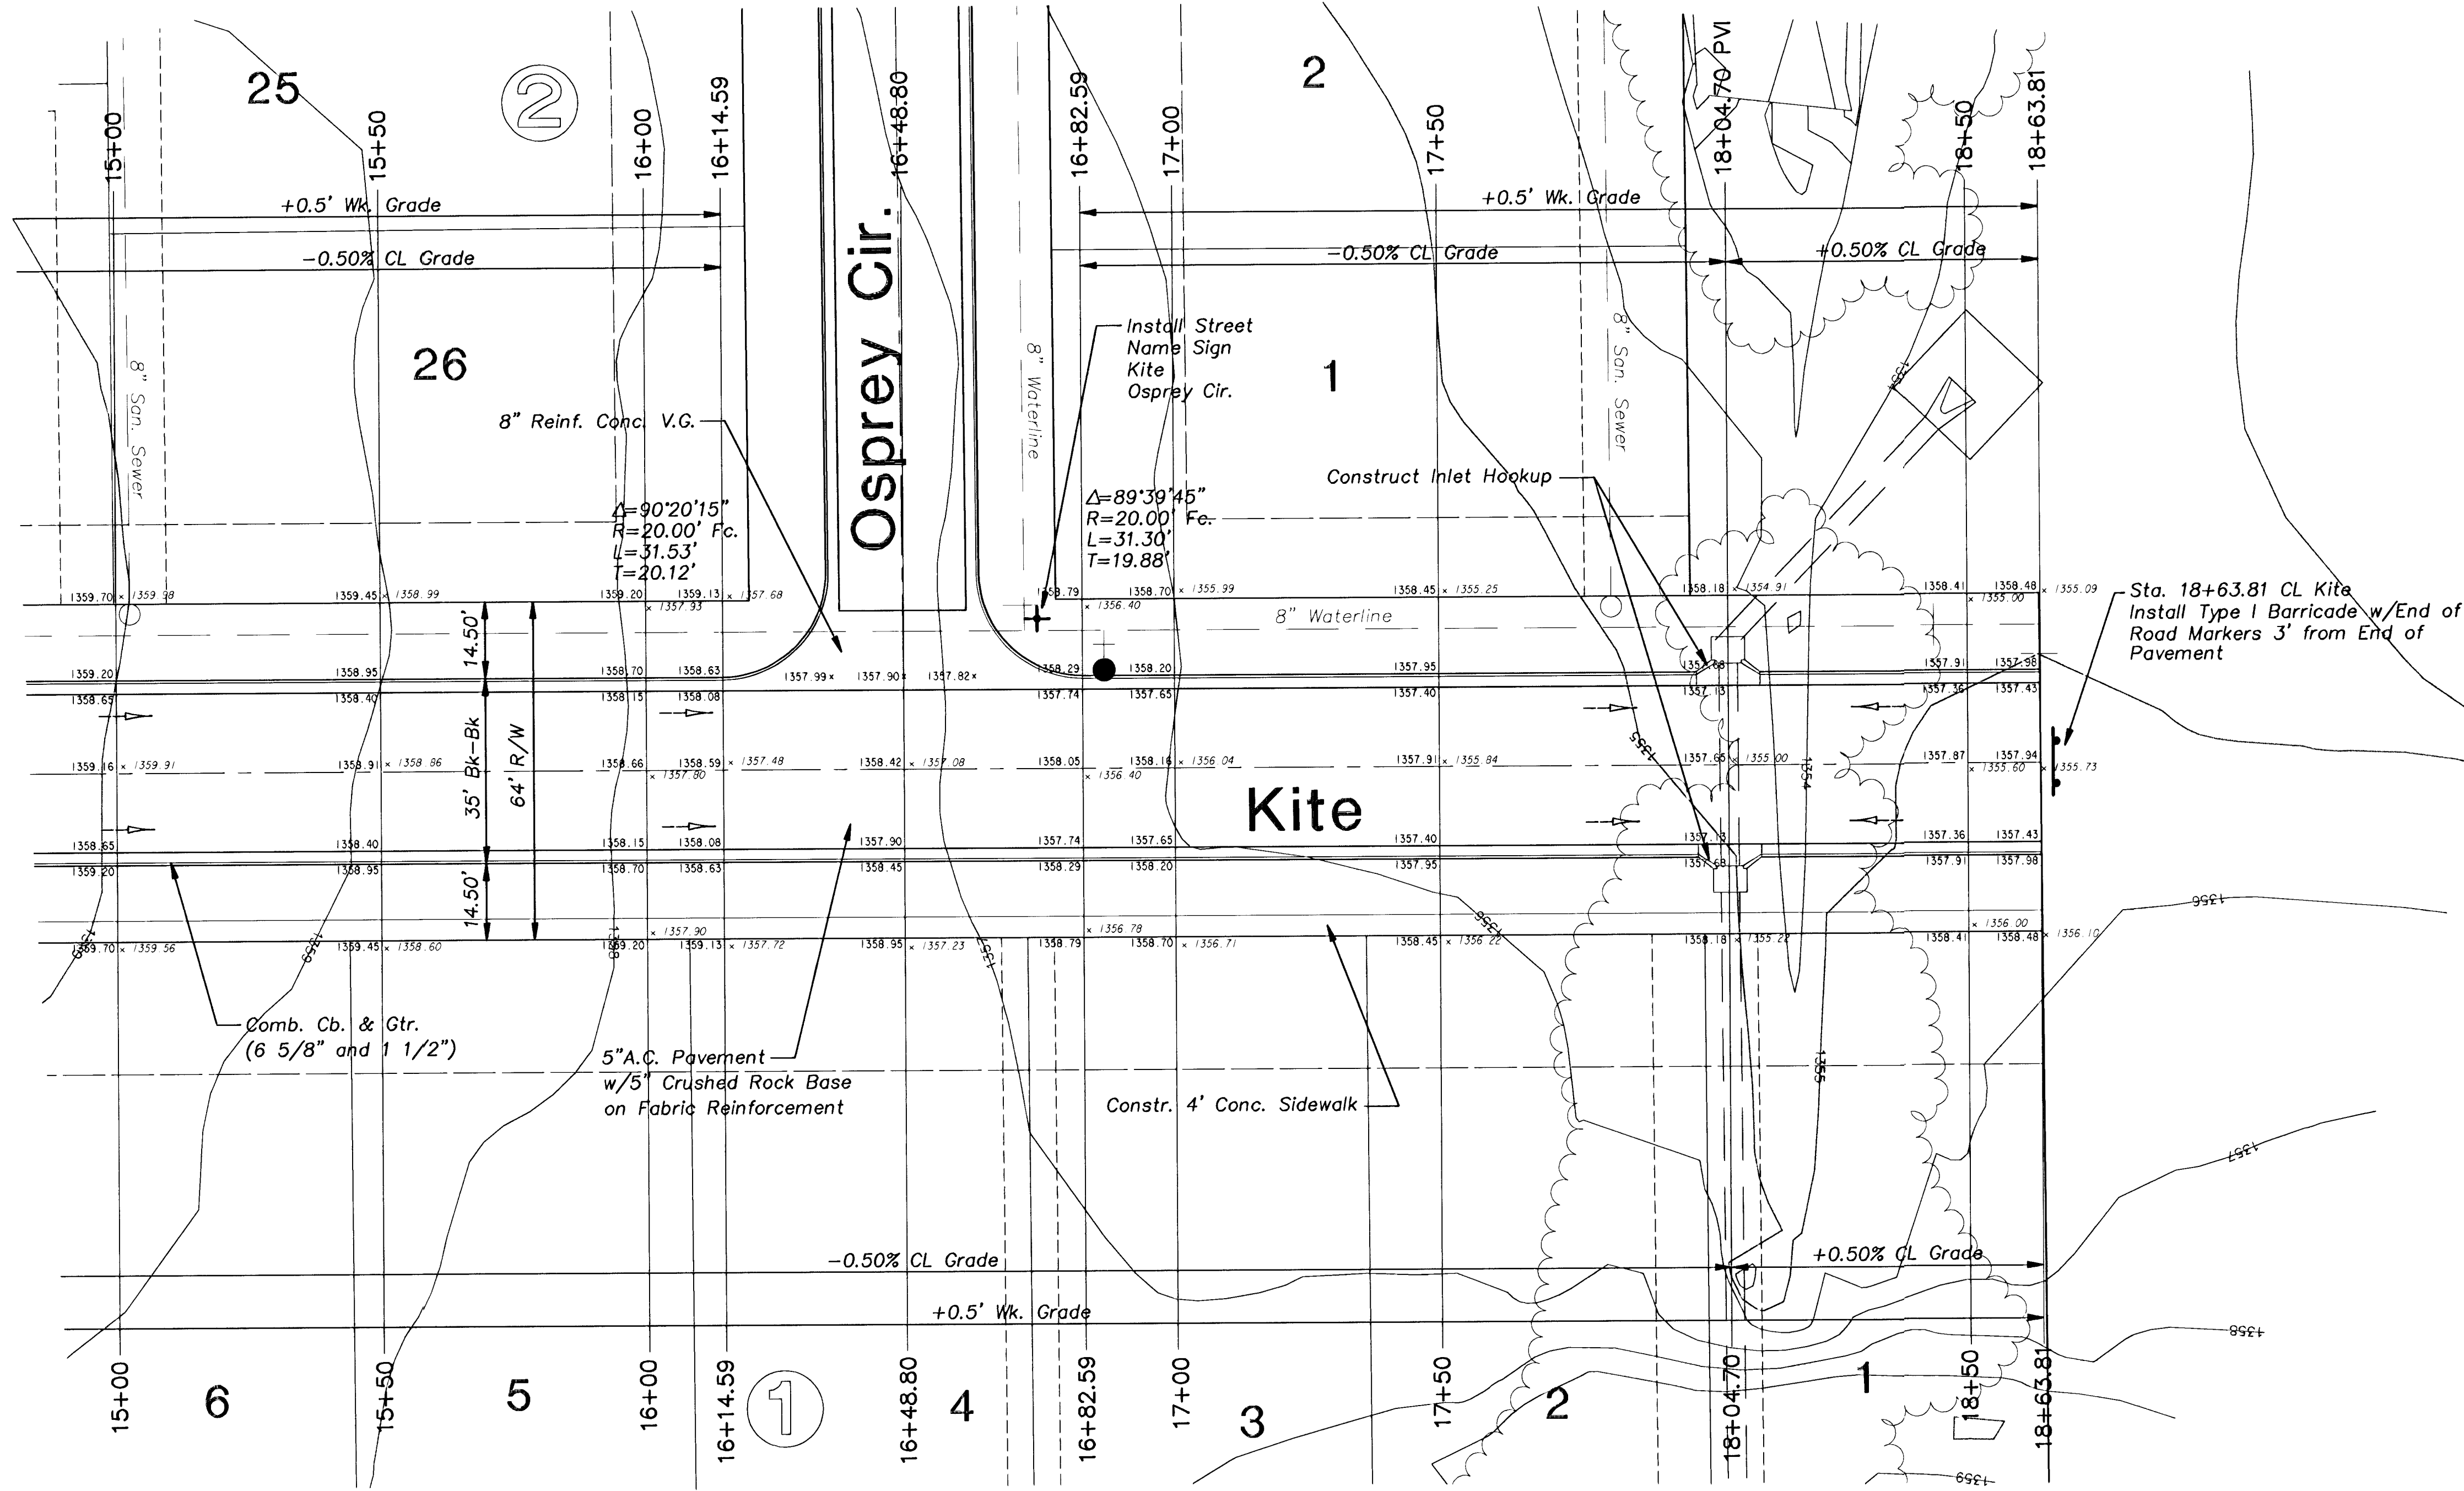

RECORD DRAWINGS
4/4/04
J.W./B.K.

No.	Street and Station	From CL	Description	Elevation
3	Peregrine, 16+86.65	17.50' S.	Top of Curb (S), in front of Fire Hydrant, at Northeast corner of Lot 1, Block 2	1358.36

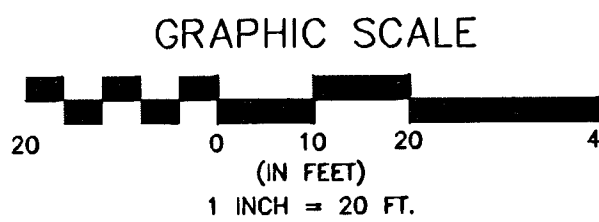

FINAL

Designed By: J. Ubert / B. Kulla
Drawn By: B. Kulla
Poe Job No.: 1748A
Date: May 2003

Sheet
7 of 88

POE & ASSOCIATES OF KANSAS, INC.
CONSULTING ENGINEERS
5840 E. Central, Suite 200 • Wichita, KS 67208-4202
Phone 316665-4114 • FAX 316665-4444

FALCON FALLS - PHASE 1
STREET IMPROVEMENTS

KITE
CITY OF WICHITA, KANSAS
NELL D. CABLE, P.E. - CITY ENGINEER
C.O.W. Project # 472-63687 O.C.A. # 765782

No.	Date	By	Approved	Revision
1				
2				
3				
4				