

G:\APPS\DOCA\PI\748\base.dwg Mon Apr 05 11:56:40 2004 Bernard Kulla, Poe & Associates Inc.

1360




1355

1354

1354

1354

1353

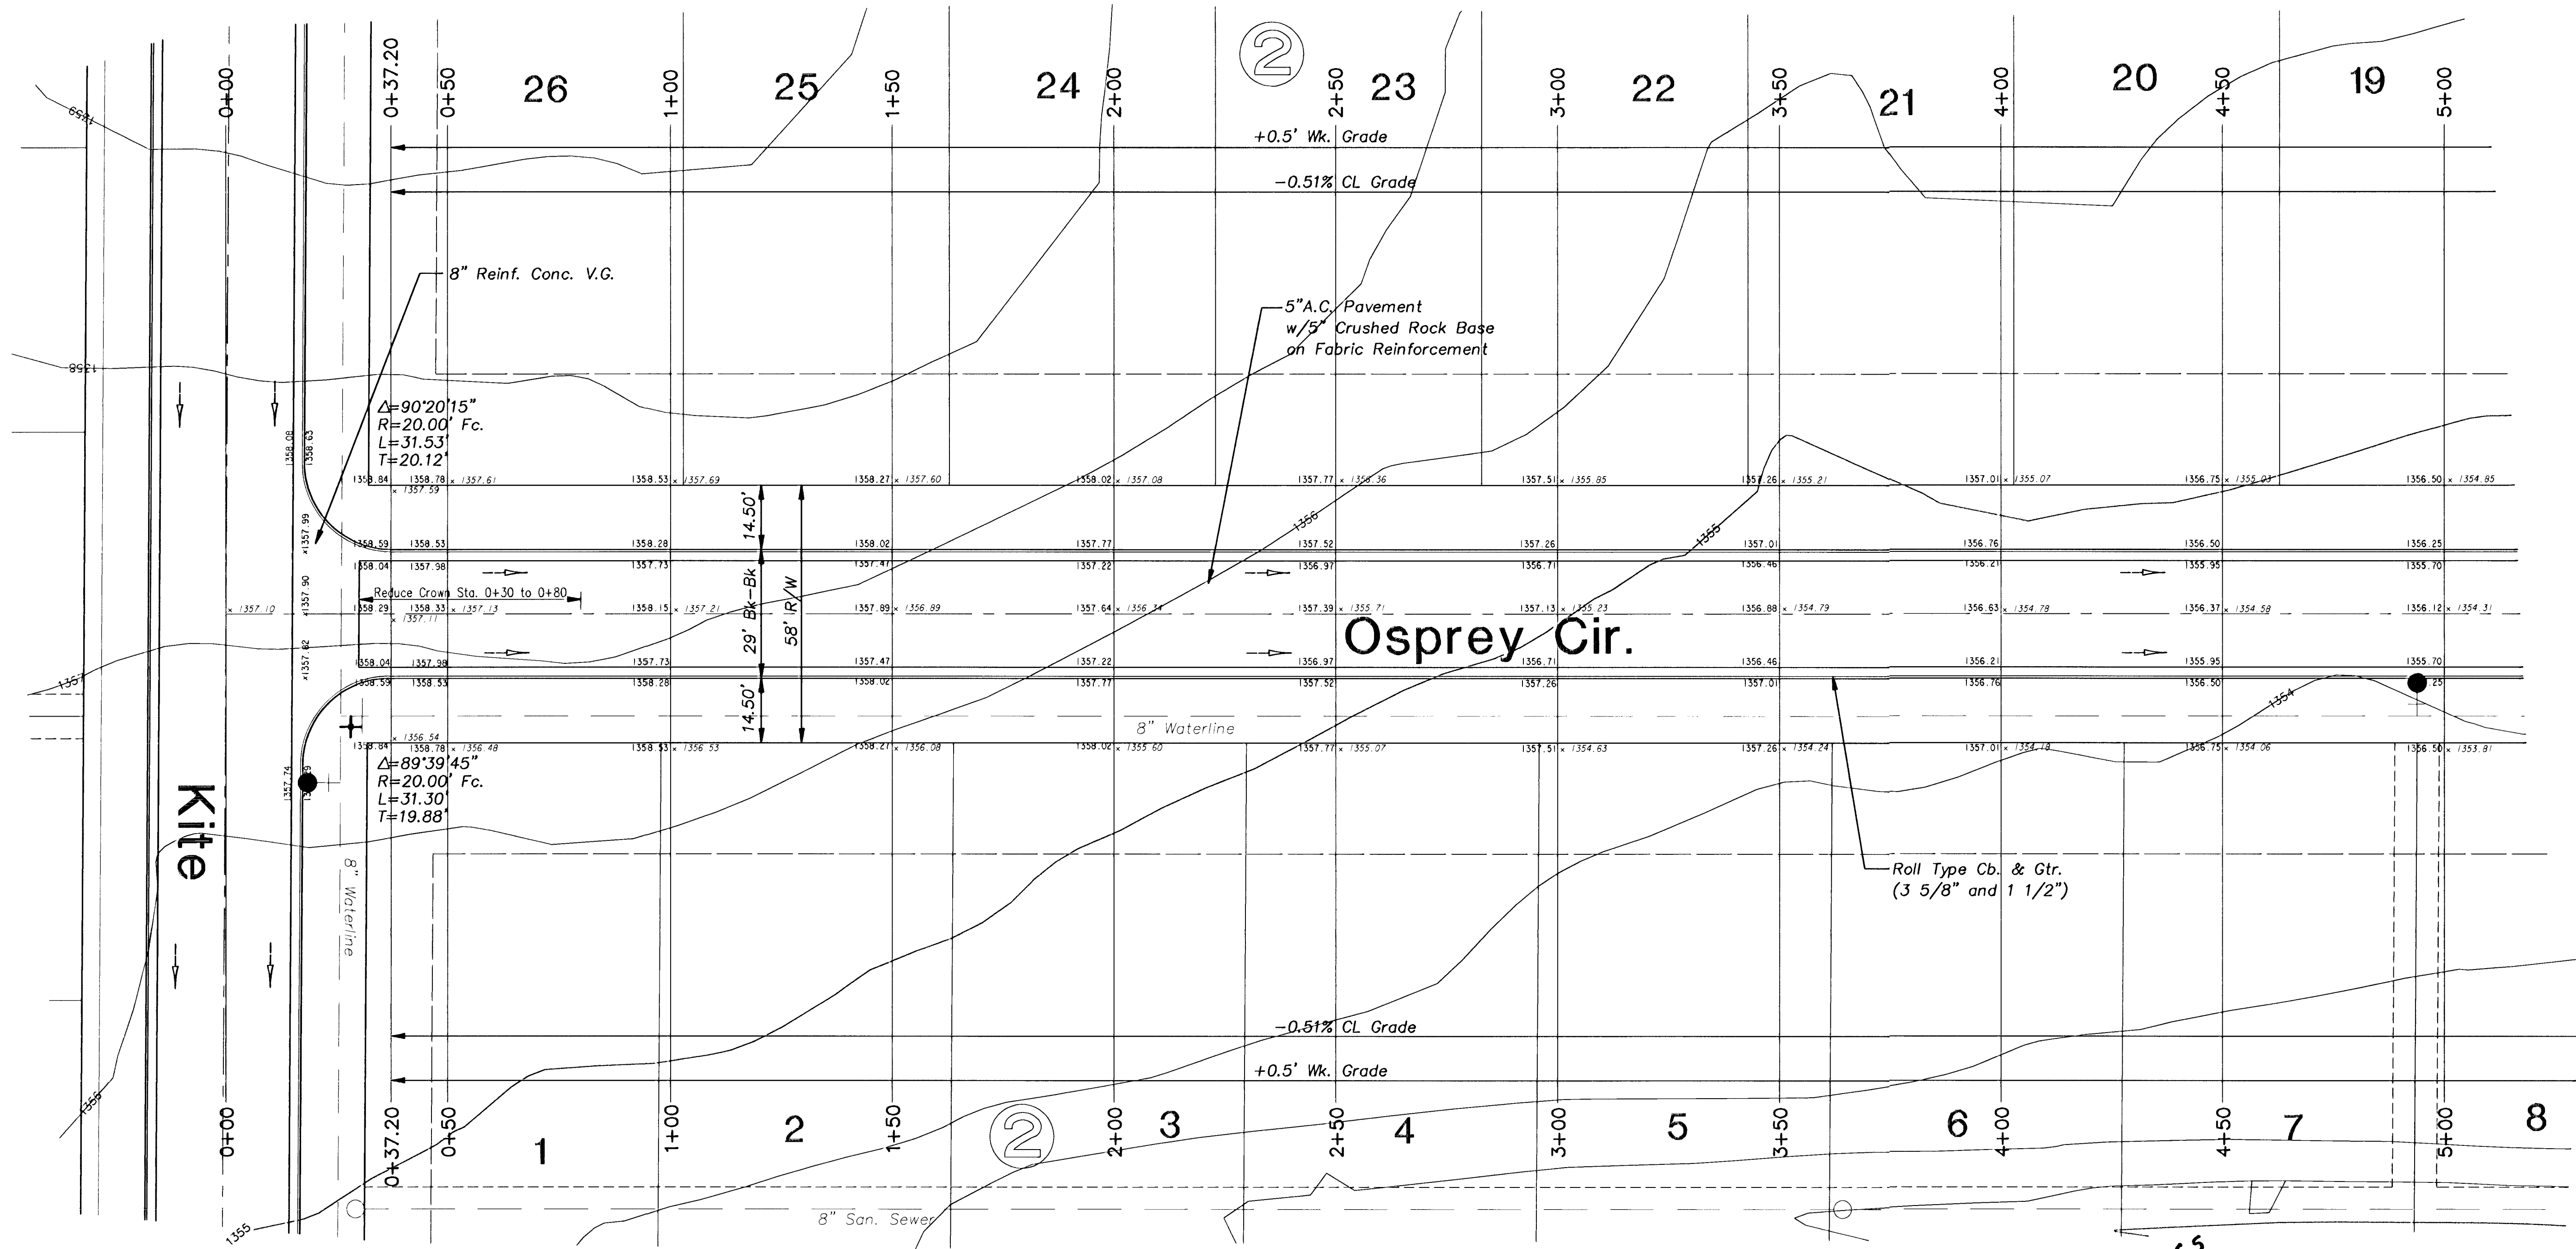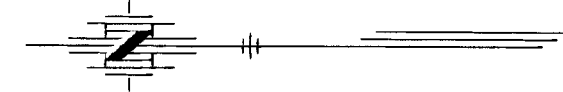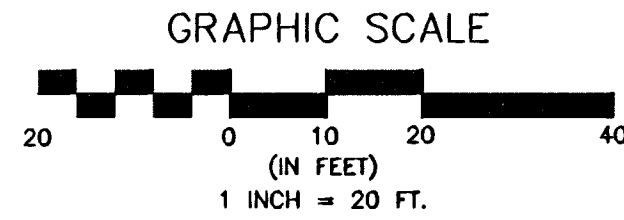

RECORD DRAWINGS
4/4/04
J.U./B.K.

NOTE:
All top of curb grades are to top of combined curb and gutter. 0.25' must be subtracted from top of curb elevations to top of roll curb.

No.	Street and Station	From CL	Description	Elevation
5	Osprey Cir., 4+93.87	17.50' W.	Top of Curb (W), in front of Fire Hydrant, at Southeast corner of Lot 7, Block 2	1355.90

FINAL

Designed By: J. Ubert / B. Kulla
Drawn By: B. Kulla
Poe Job No.: 1748A
Date: May 2003

FALCON FALLS - PHASE 1
STREET IMPROVEMENTS
OSPREY CIR.
CITY OF WICHITA, KANSAS
NEIL D. CABLE, P.E. - CITY ENGINEER
C.O.W. Project # 472-83687 O.C.A. # 765782

POE & ASSOCIATES OF KANSAS, INC.
CONSULTING ENGINEERS
5940 E. Central, Suite 200 Wichita, KS 67208-2020
Phone 316/685-4114 FAX 316/685-4444

52