


13TH STREET N. DECEL LANE IMPROVEMENTS

TO SERVE
THE GATEWAY CENTER 2ND ADDITION
 (LOT 10, BLOCK 1)
 PRIVATE PROJECT NO. 175 PPP (607879)

CITY OF WICHITA, KANSAS
 JAMES L. ARMOUR, P.E. - CITY ENGINEER

INDEX OF SHEETS

1.	TITLE SHEET
2.	KEY MAP AND GENERAL NOTES
3.	PLAT
4.	TYPICAL SECTION
5.	PAVING PLAN
6.	EROSION CONTROL PLAN
7-10.	EROSION CONTROL DETAILS
11-12.	CROSS SECTIONS

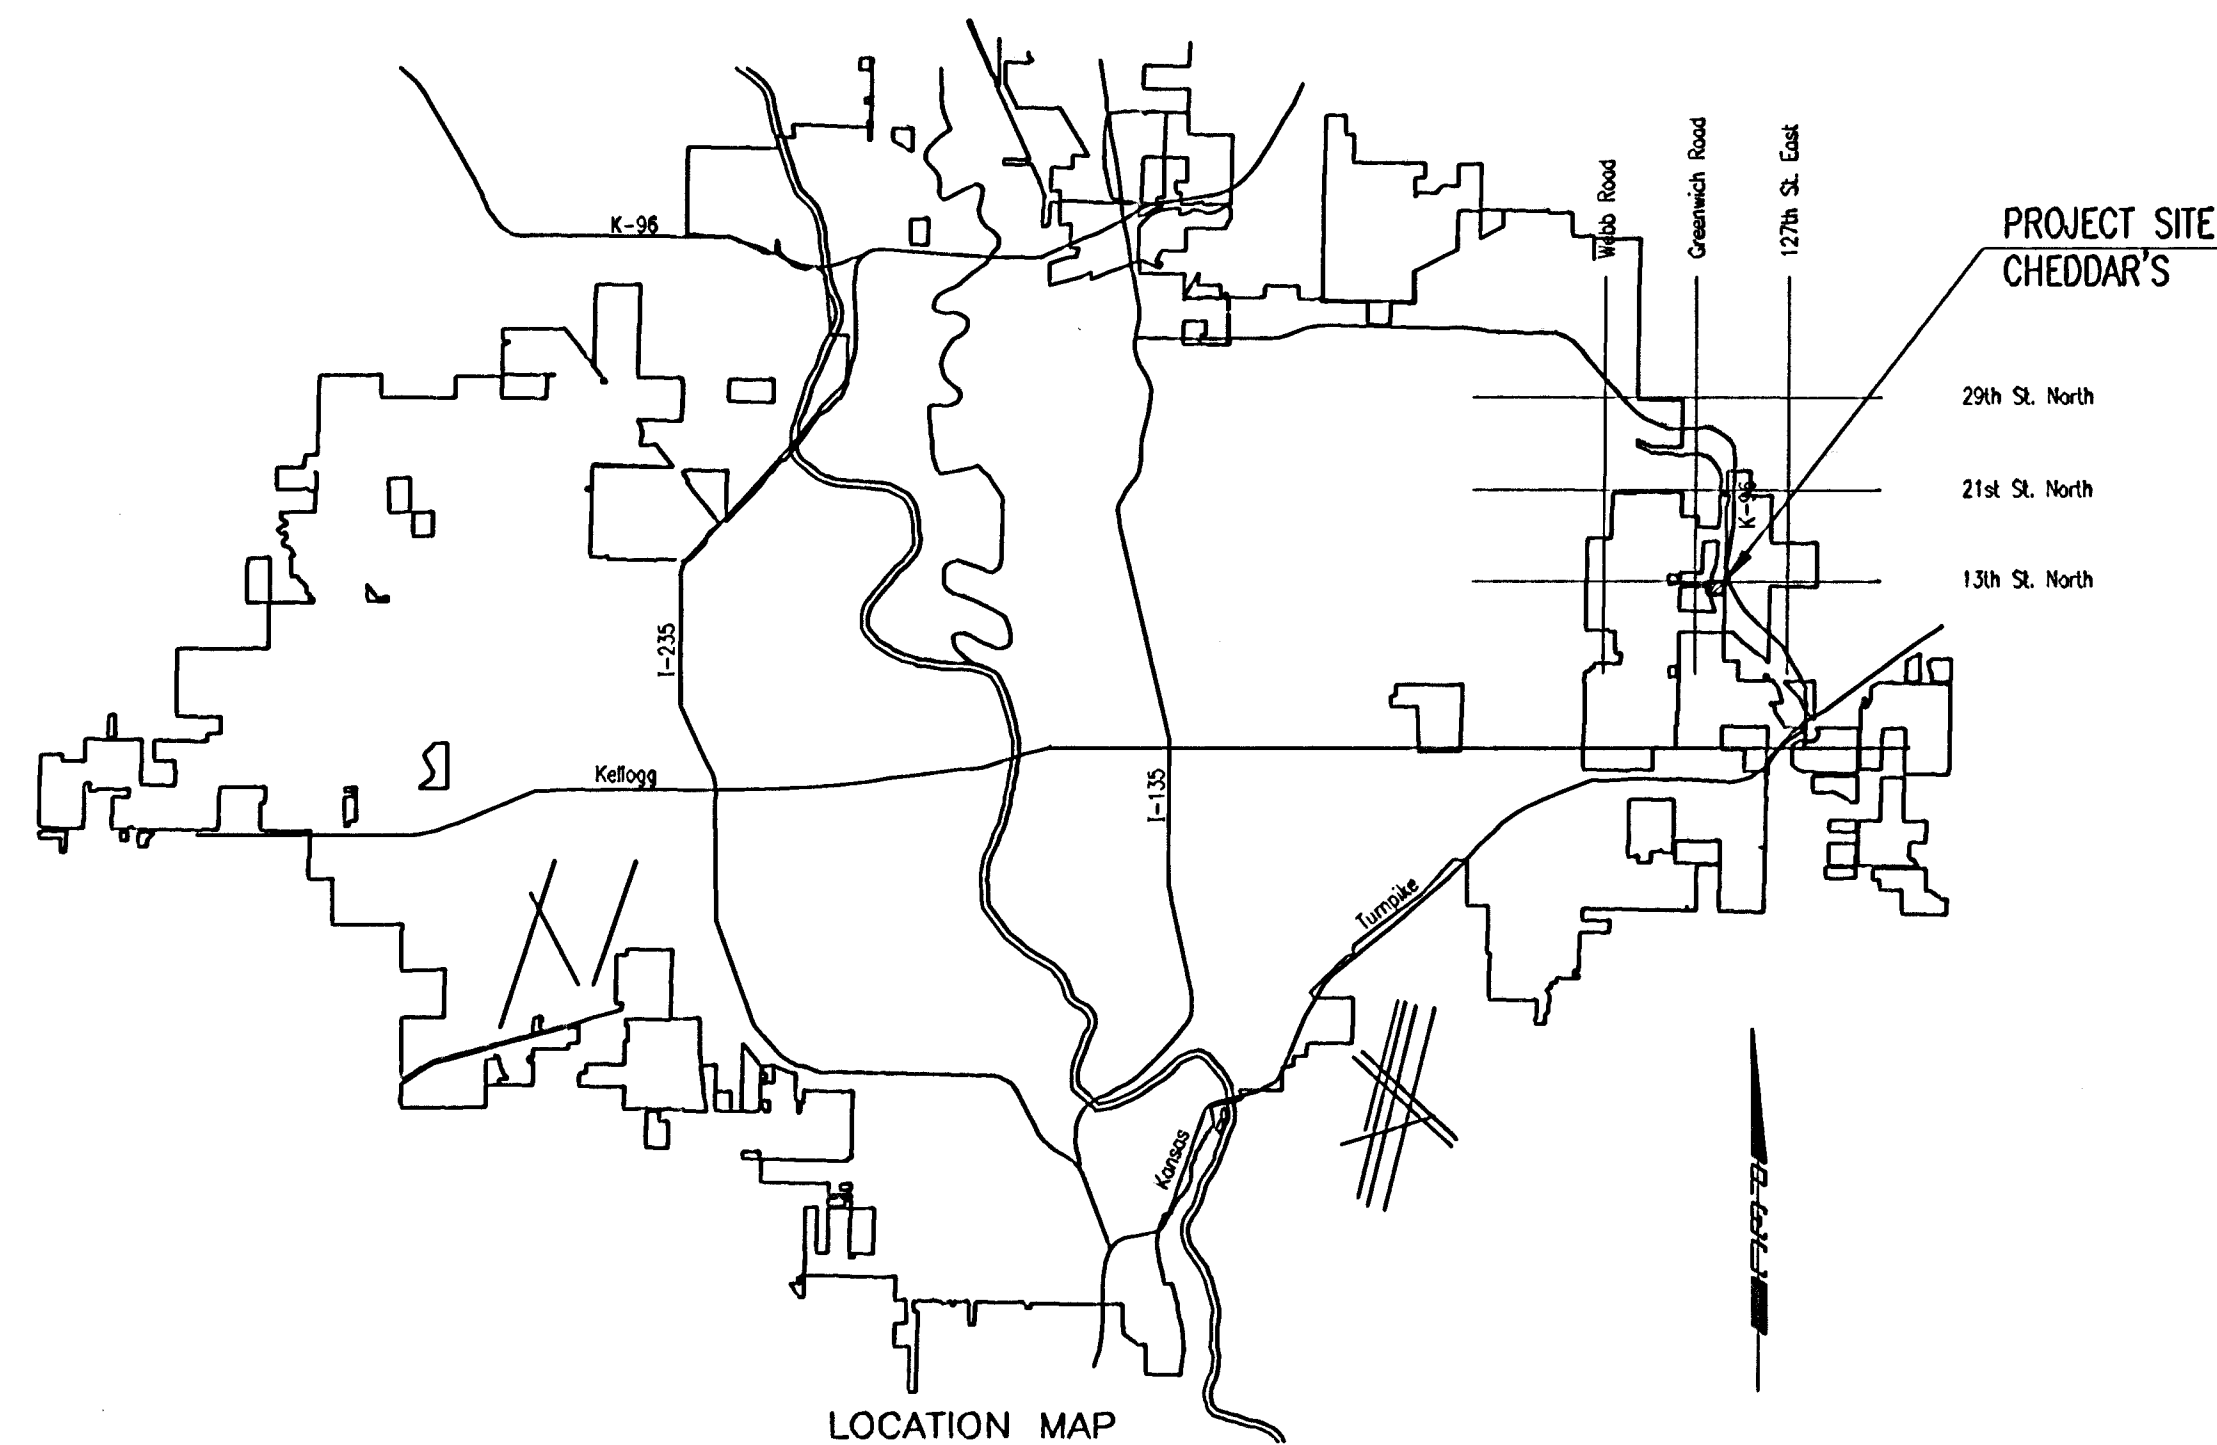

PROJECT LENGTH = 145 LIN. FT.

EARTHWORK

EXCAVATION 155 CU. YDS.*
 * SEE NOTE 5, SHEET NO. 4.

EXCESS EXCAVATED MATERIAL SHALL BE
 DISPOSED OF ON A SITE PROVIDED BY THE
 CONTRACTOR AND APPROVED BY THE ENGINEER.

APPROVED AS NOTED
 By CITY ENGINEER OF WICHITA

Sanitary Sewers _____
 Storm Sewers _____
 Driveway Approaches _____
 Paving VRH 10/13/06


NOTE TO CONTRACTOR

INSPECTION AND TESTING FOR THIS PROJECT IS TO BE PROVIDED BY A LICENSED CONSULTING ENGINEERING FIRM CONTRACTED BY THE OWNER/DEVELOPER. SAID INSPECTION TO BE IN ACCORDANCE WITH THE CITY OF WICHITA STANDARD CONSTRUCTION ENGINEERING PRACTICES AND CERTIFIED BY A LICENSED PROFESSIONAL ENGINEER. NO WORK SHALL BE PERFORMED IN DEDICATED EASEMENTS OR PUBLIC RIGHT-OF-WAY BY THE CONTRACTOR UNTIL SUCH INSPECTION IS ARRANGED FOR AND REQUIRED BONDS HAVE BEEN SUBMITTED TO AND APPROVED BY THE CITY. NOR SHALL ANY WORK BE COMMENCED IN DEDICATED EASEMENTS OR PUBLIC RIGHT-OF-WAY WITHOUT WRITTEN AUTHORIZATION BY THE CITY ENGINEER. IMPROVEMENTS PERFORMED UNDER THIS PROJECT SHALL NOT BE ACCEPTED BY THE CITY UNTIL ALL APPLICABLE DOCUMENTATION HAS BEEN SUBMITTED TO THE CITY ENGINEER. THIS MAY INCLUDE: RECORD DRAWINGS, INSPECTION LOGS, TEST DOCUMENTATION, TV TAPES, AND A CERTIFICATE OF COMPLETION. THE ABOVE SHALL BE PERFORMED BY THE CONSULTING FIRM CONTRACTED TO INSPECT THIS PROJECT.

OCTOBER 2006

PLANS PREPARED BY
PROFESSIONAL ENGINEERING CONSULTANTS, P.A.
 ENGINEERS
 WICHITA, KANSAS

MKEC AS-BUILT 1-8-07

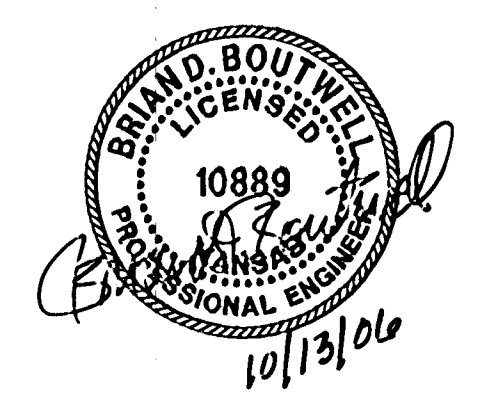

Saved 10-12-2006 5:03:30 PM by BLS
 Plot Scale 1:1 10-12-2006 5:04:11 PM by BLS
 P:\SEN\12006\10889\10889-10-12 City of Wichita\cm\101-Street Title